



See Sheet 61

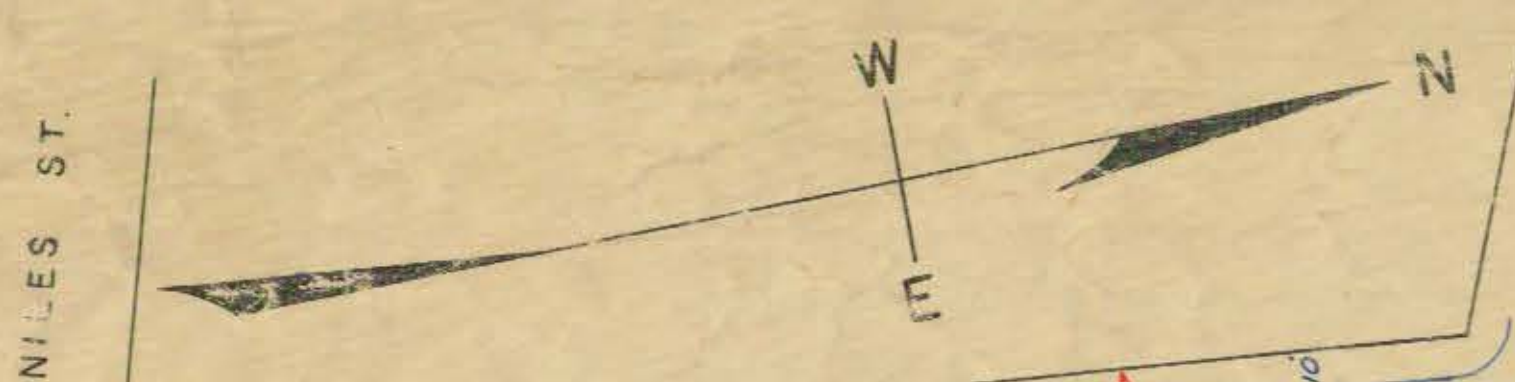


See Sheet 57

See Sheet 59


Street, SIGOURNEY Building & Veranda Lines of April 21, 1902 STREET Vol. 5-55

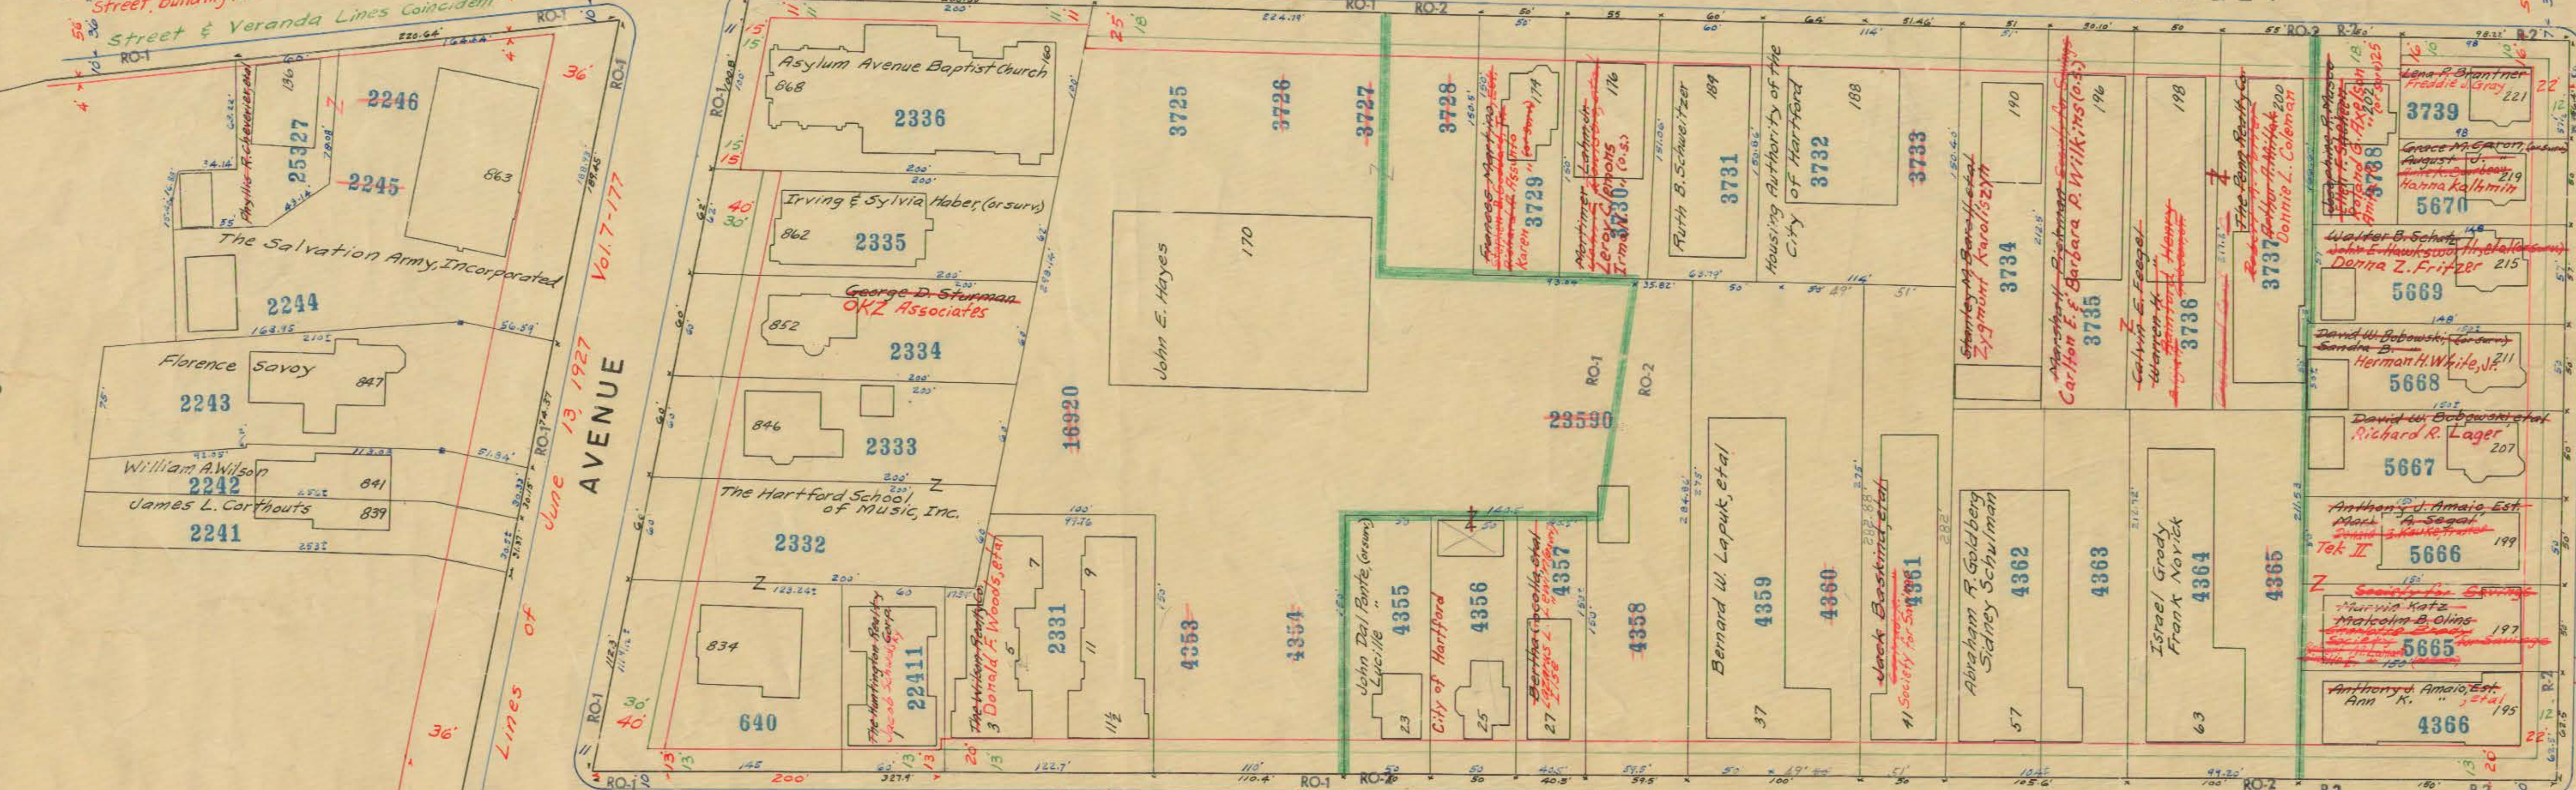

Street, HUNTINGTON Building Lines of November 28, 1881 Vol. 4-114 Veranda Lines of September 26, 1904 Vol. 5-119 Veranda Lines of July 16, 1923 Vol. 7-28 Veranda Lines of July 16, 1923 Vol. 7-28

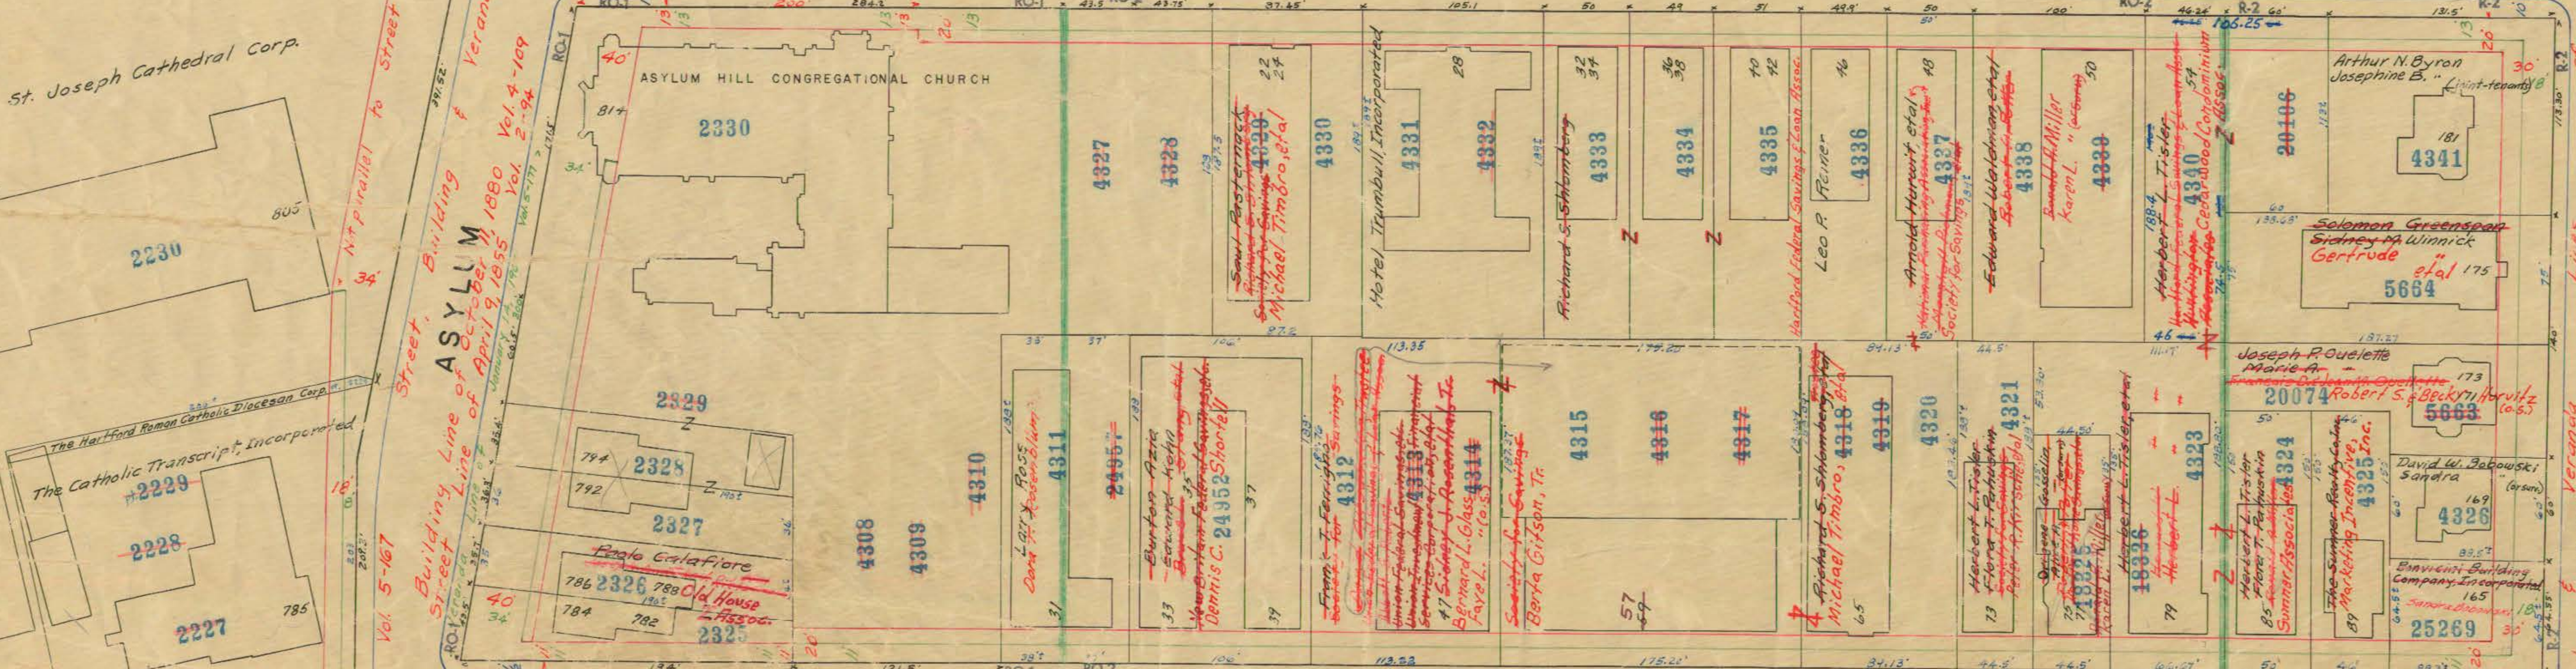


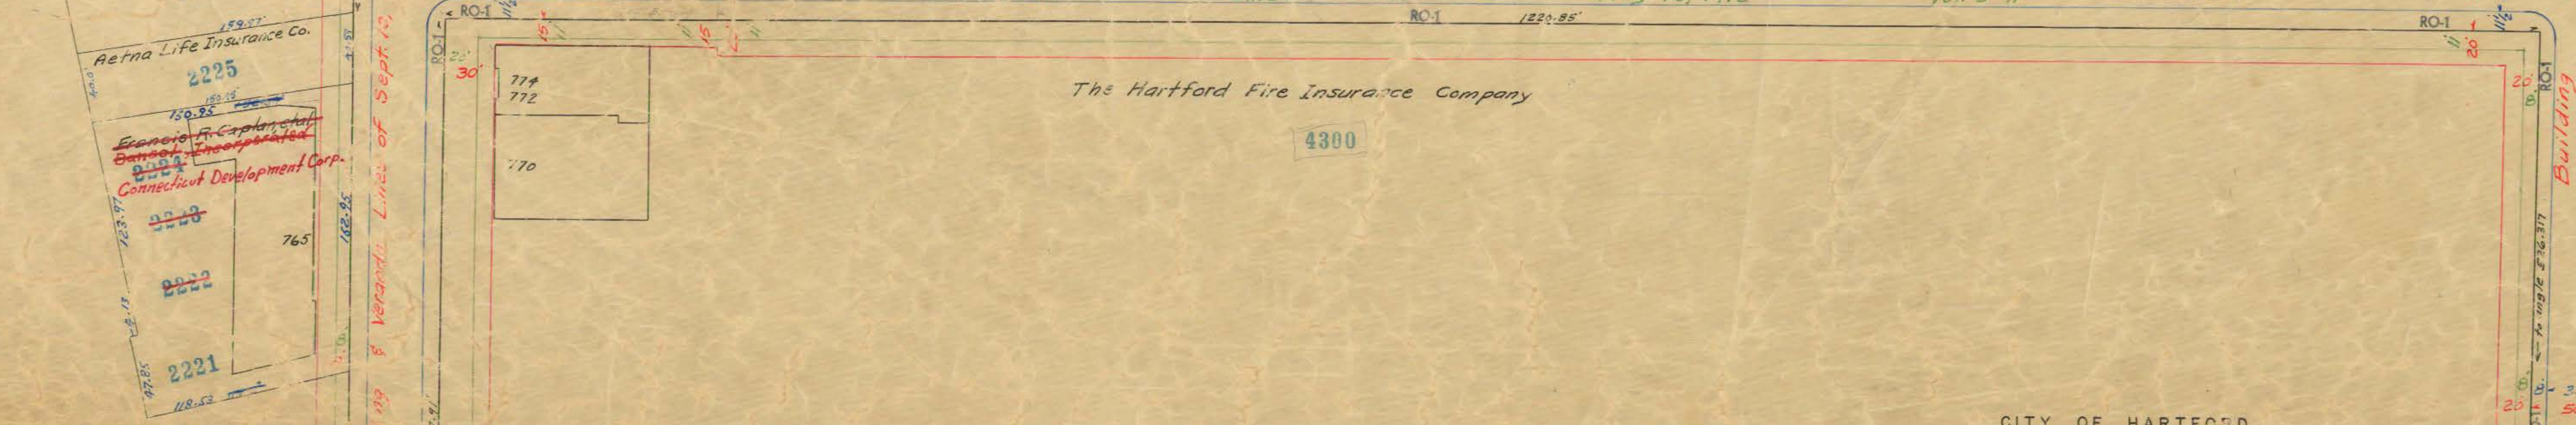

