


NILES ST.


See Sheet 61

SIGOURNEY and STREET

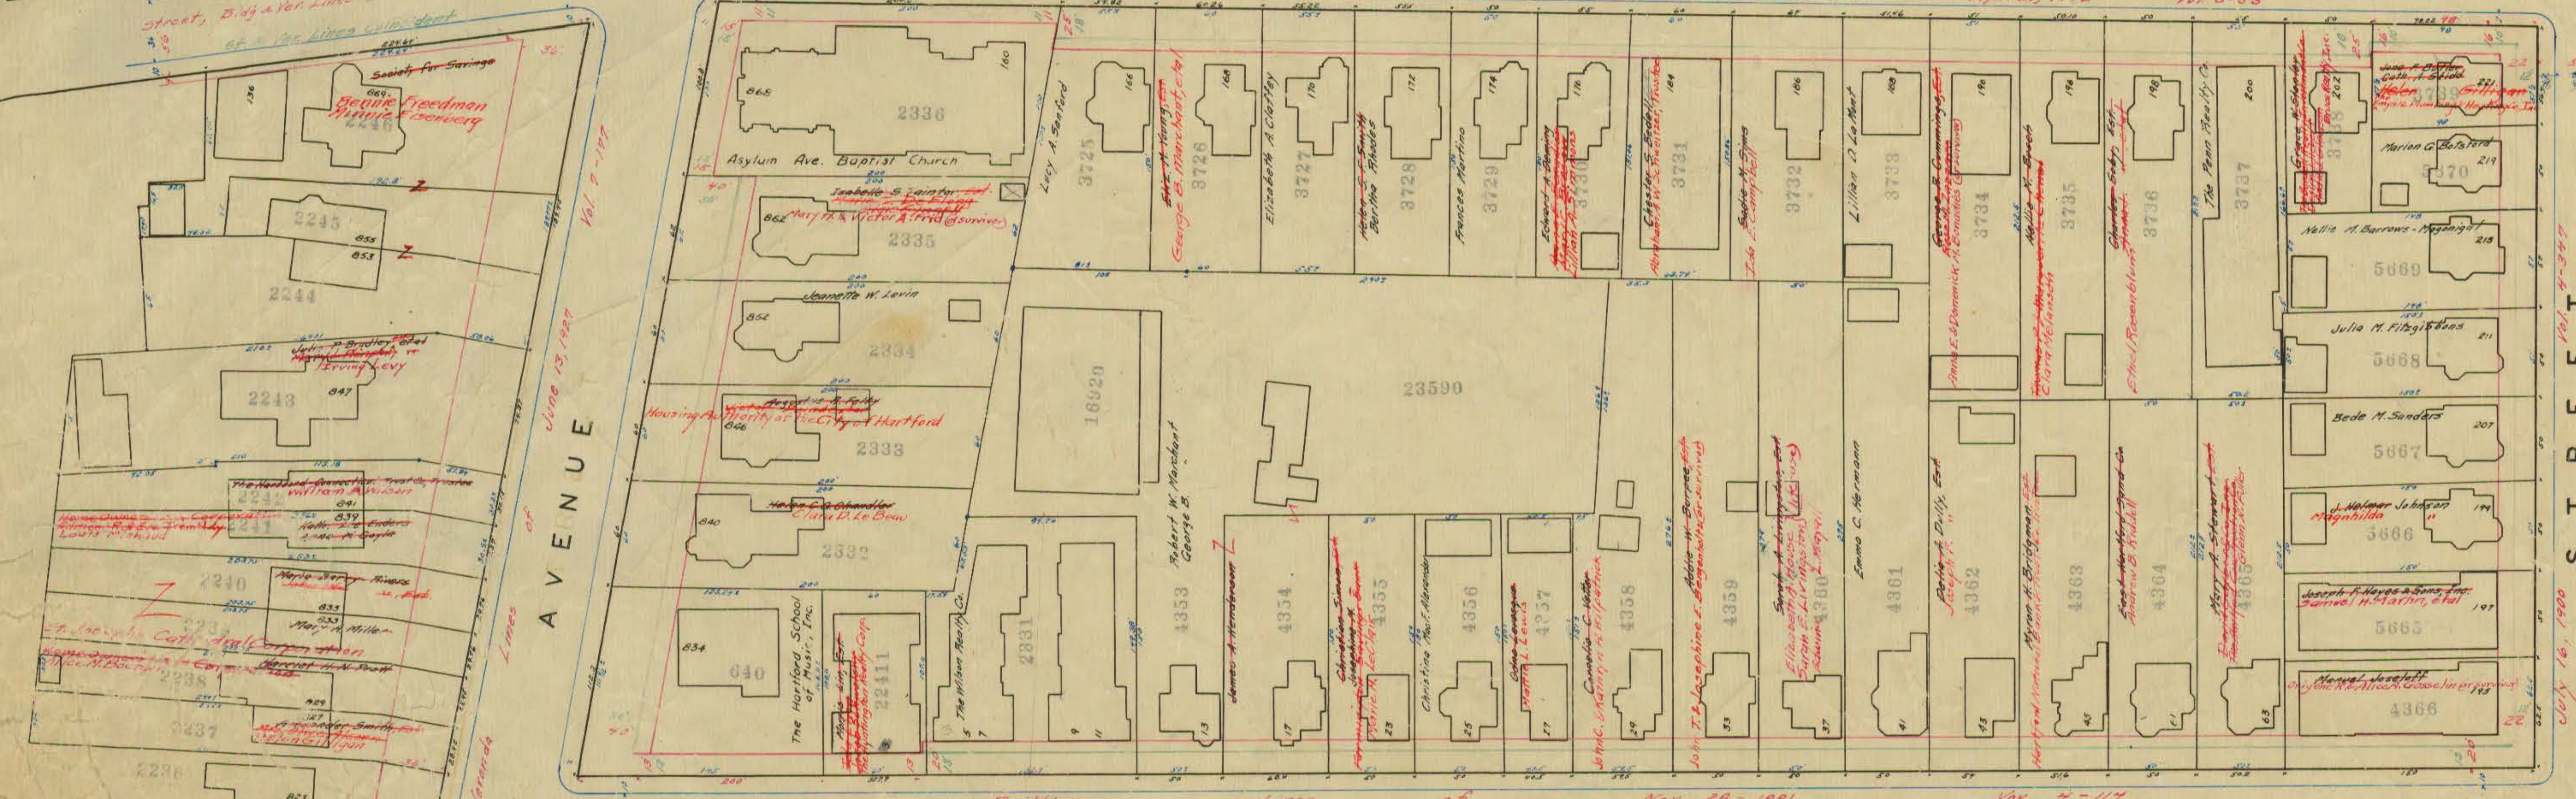


See Sheet 57

HUNTINGTON STREET

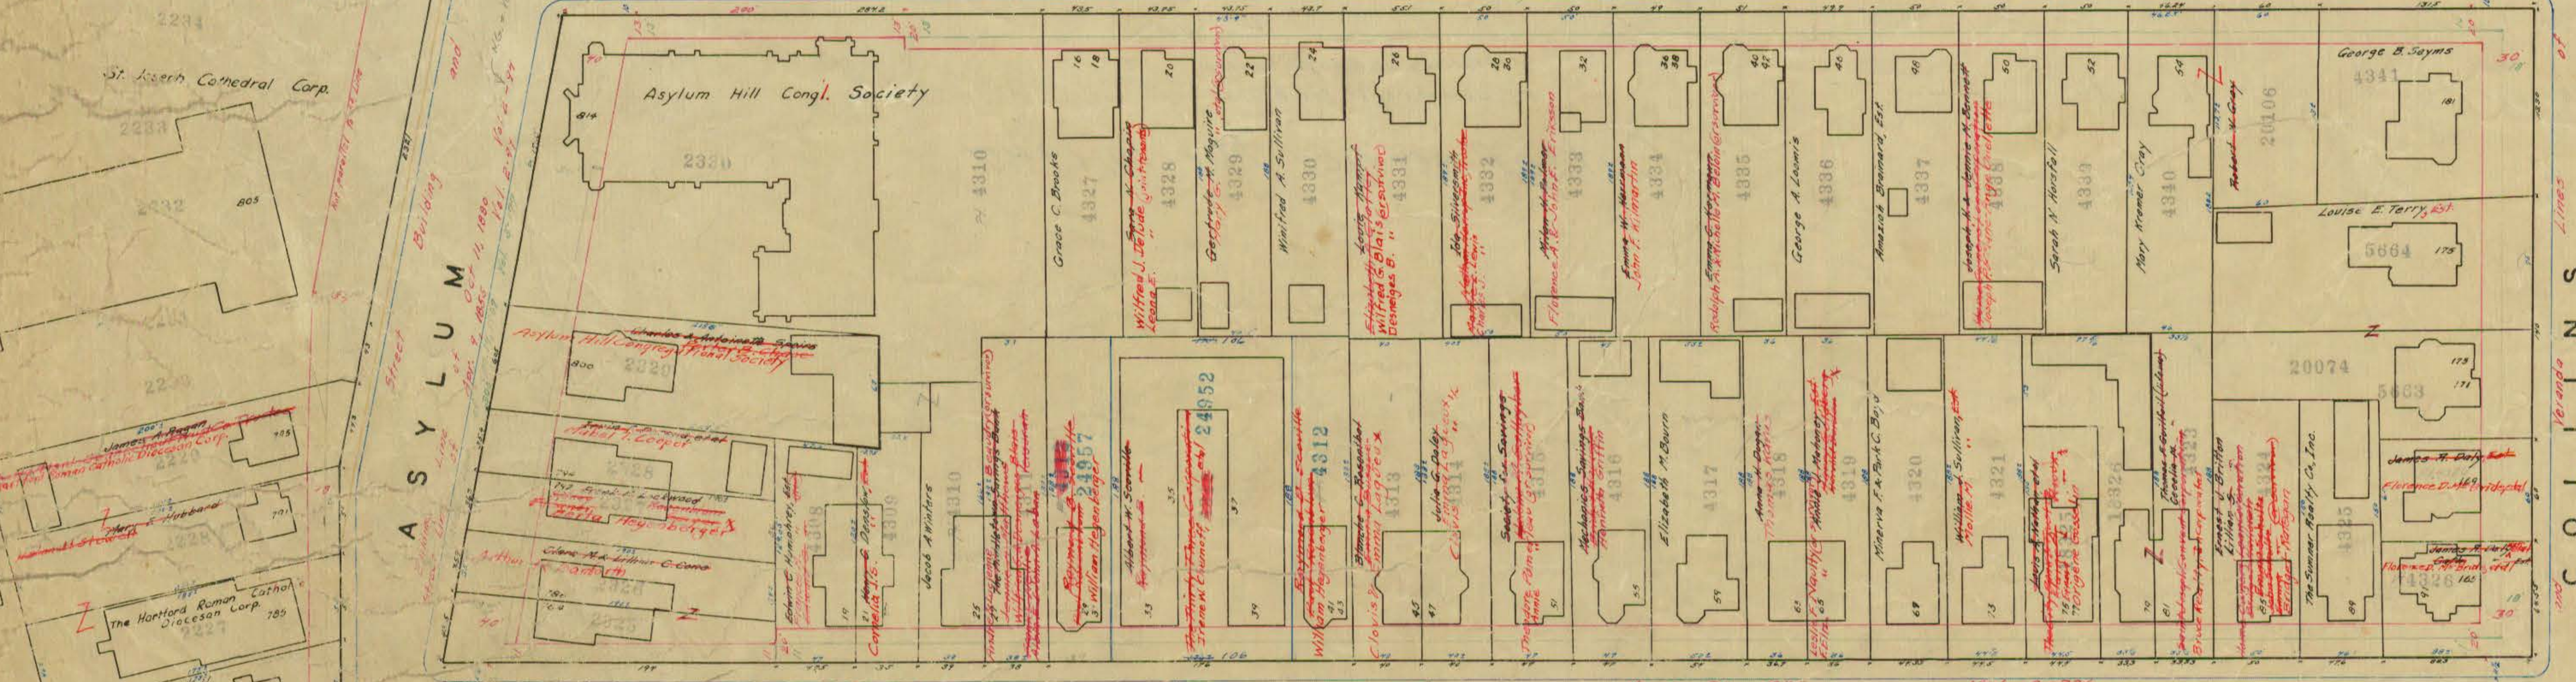

SUMNER STREET

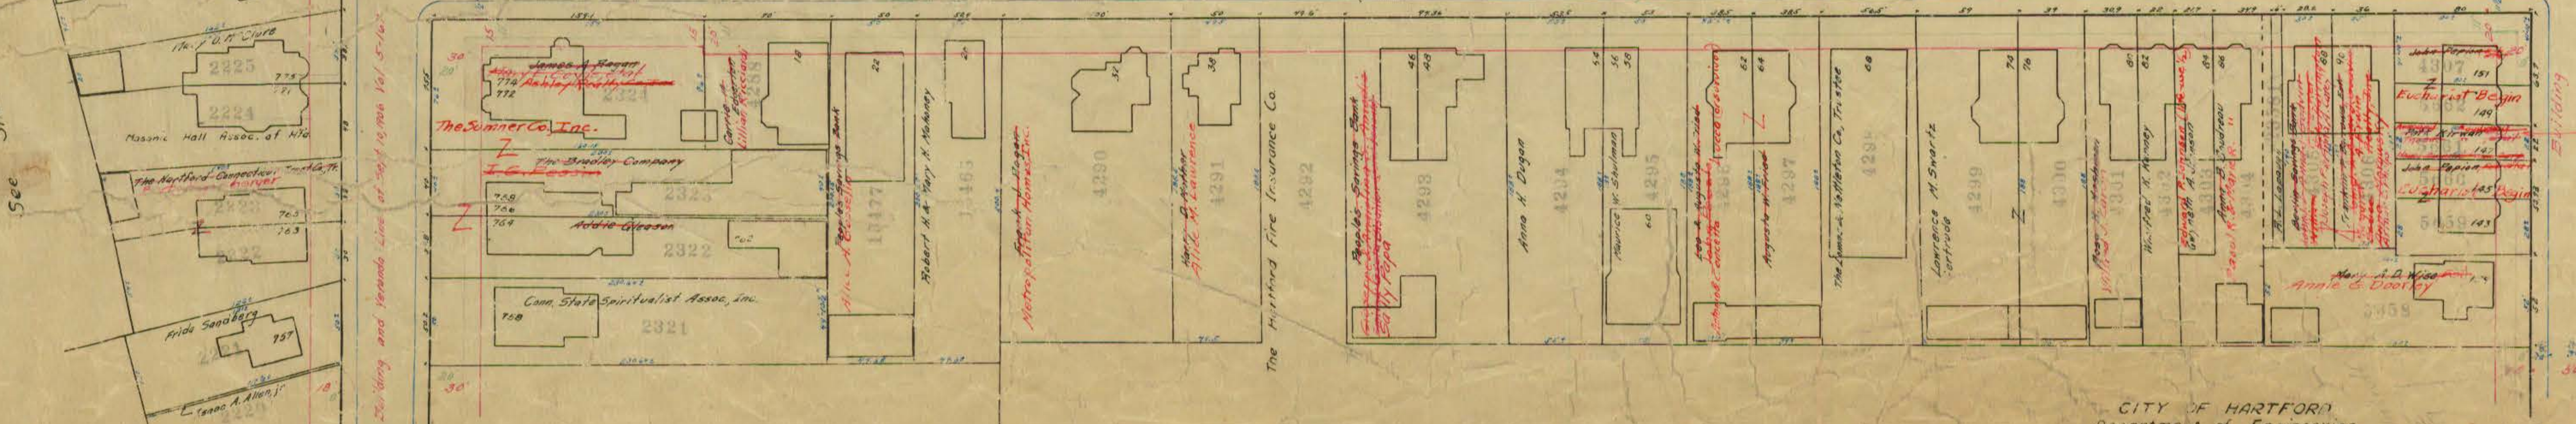

See Sheet 31

CITY OF HARTFORD
Department of Engineering