


Out of Service

See Sheet 31

March 15-1937

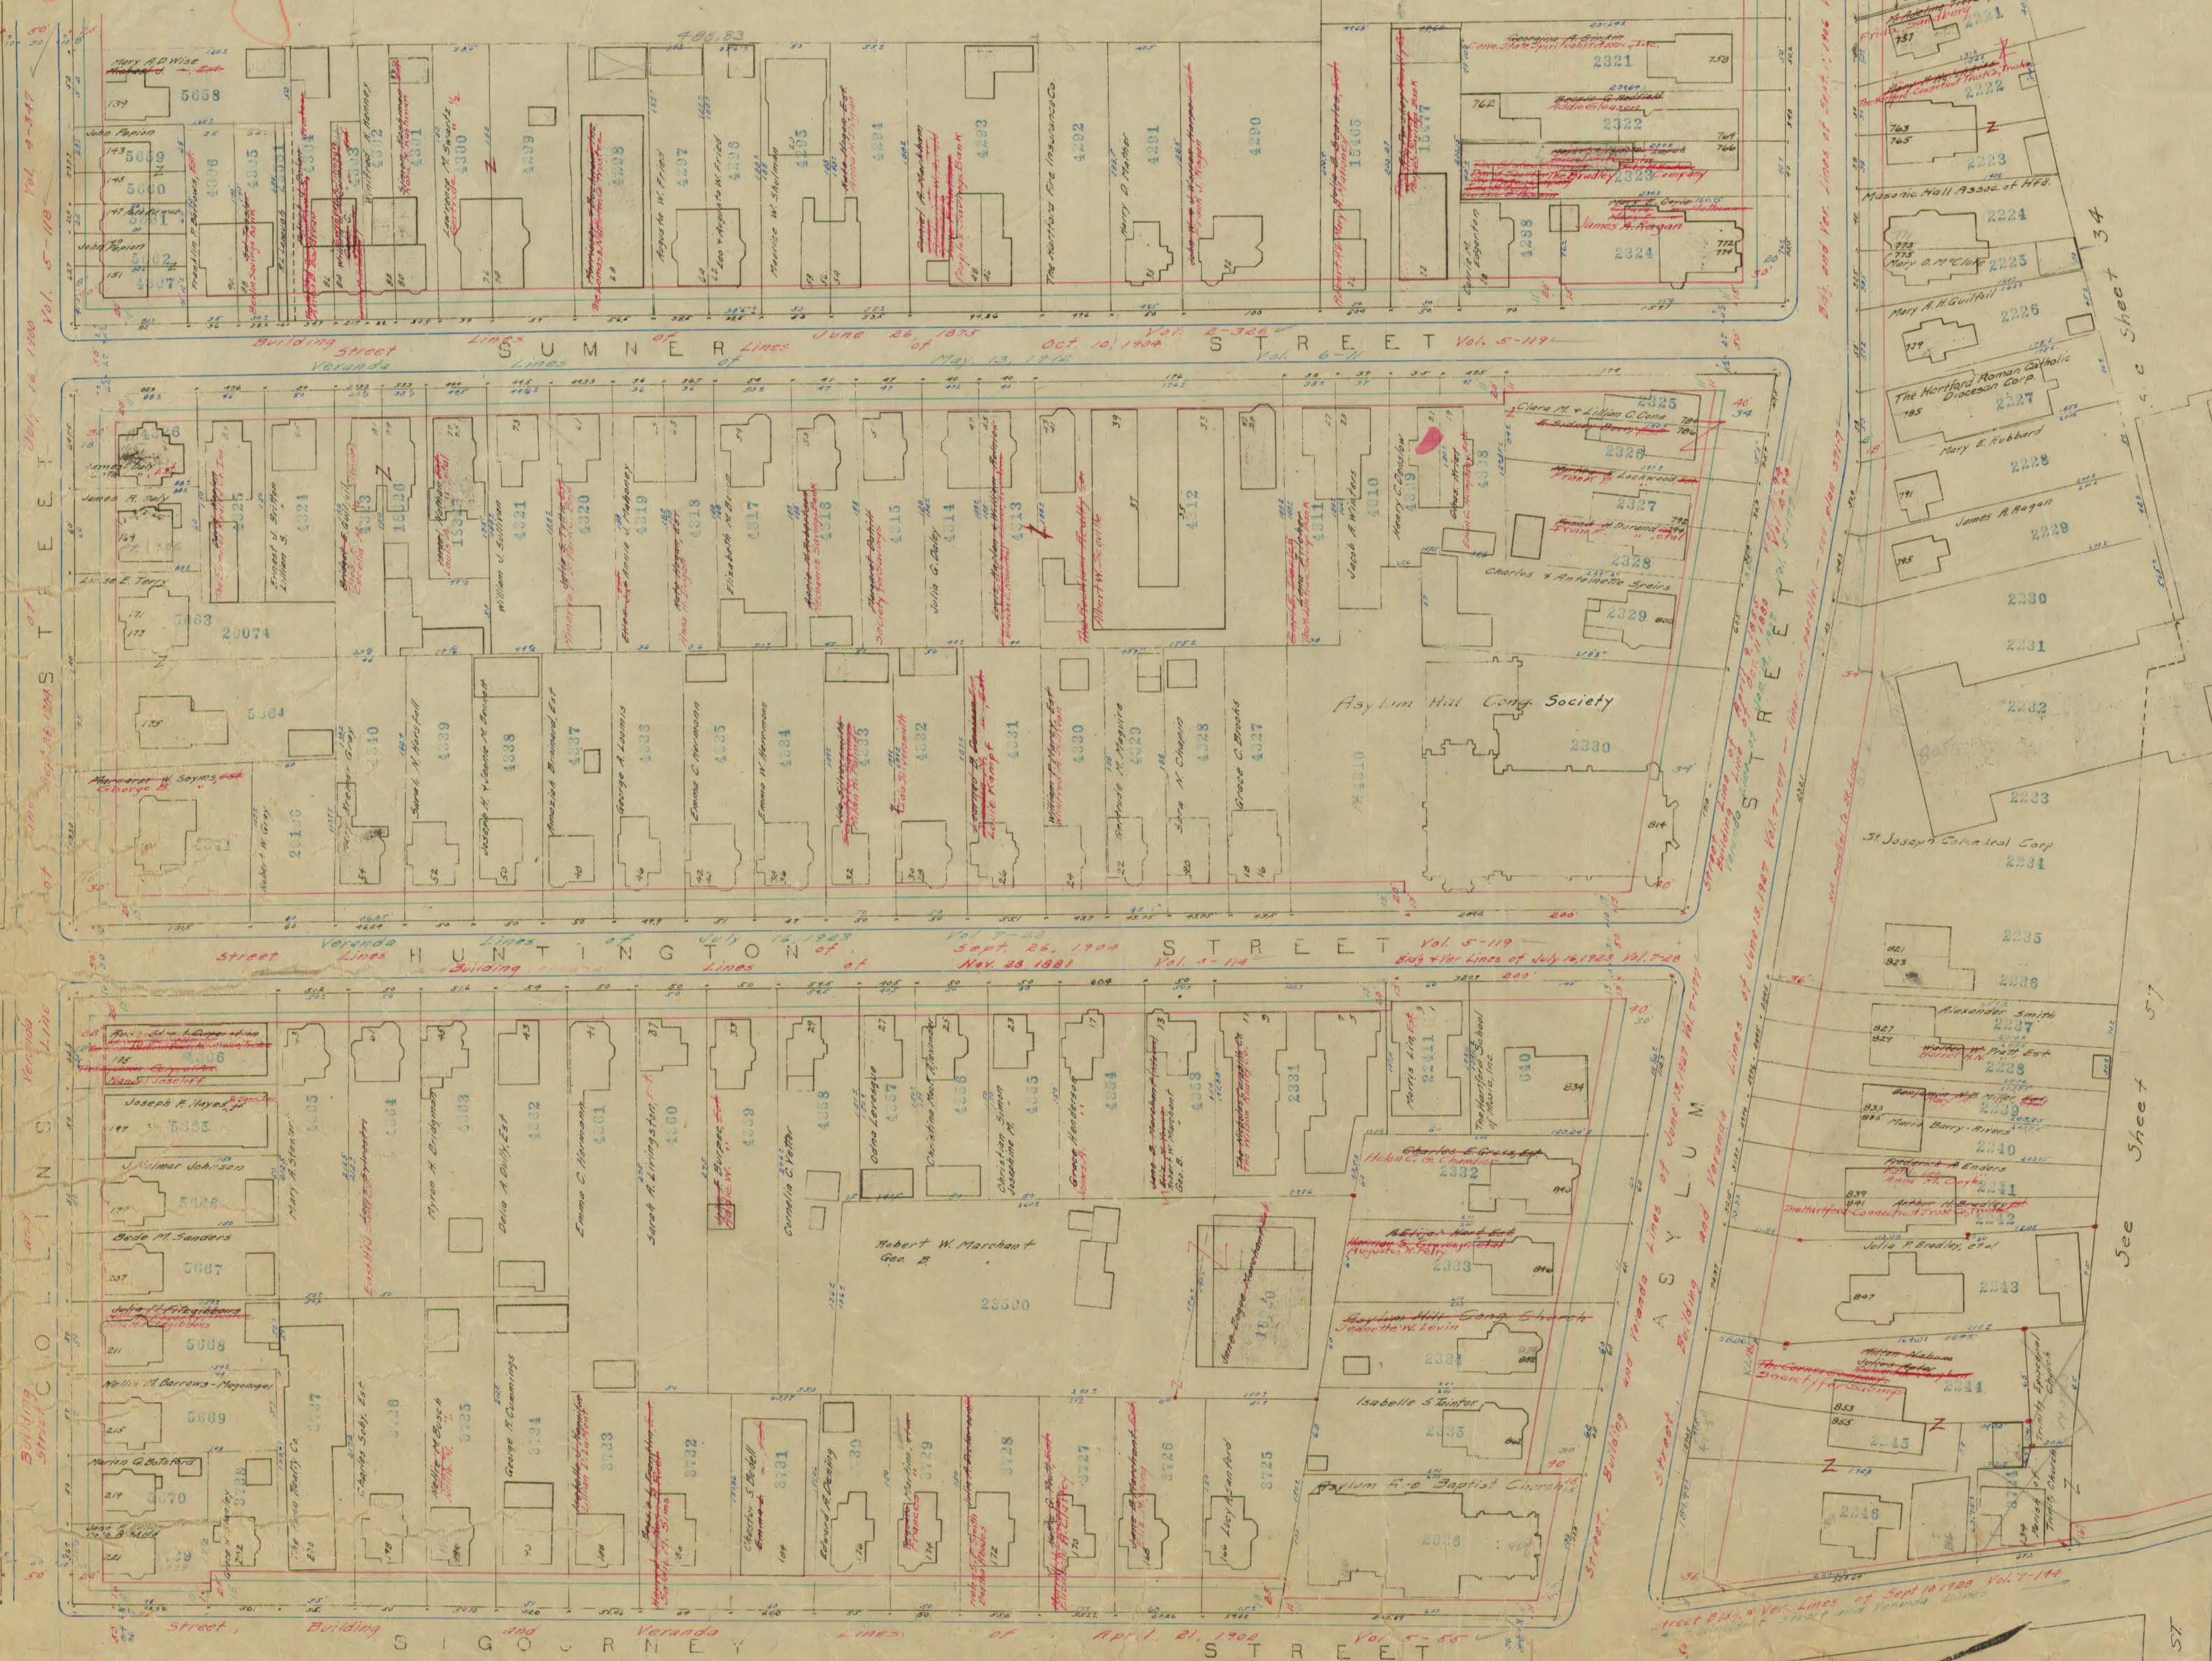

Out of Service March 15-1937

Out of Service March 15-1937

See Sheet 61