


See Sheet 31

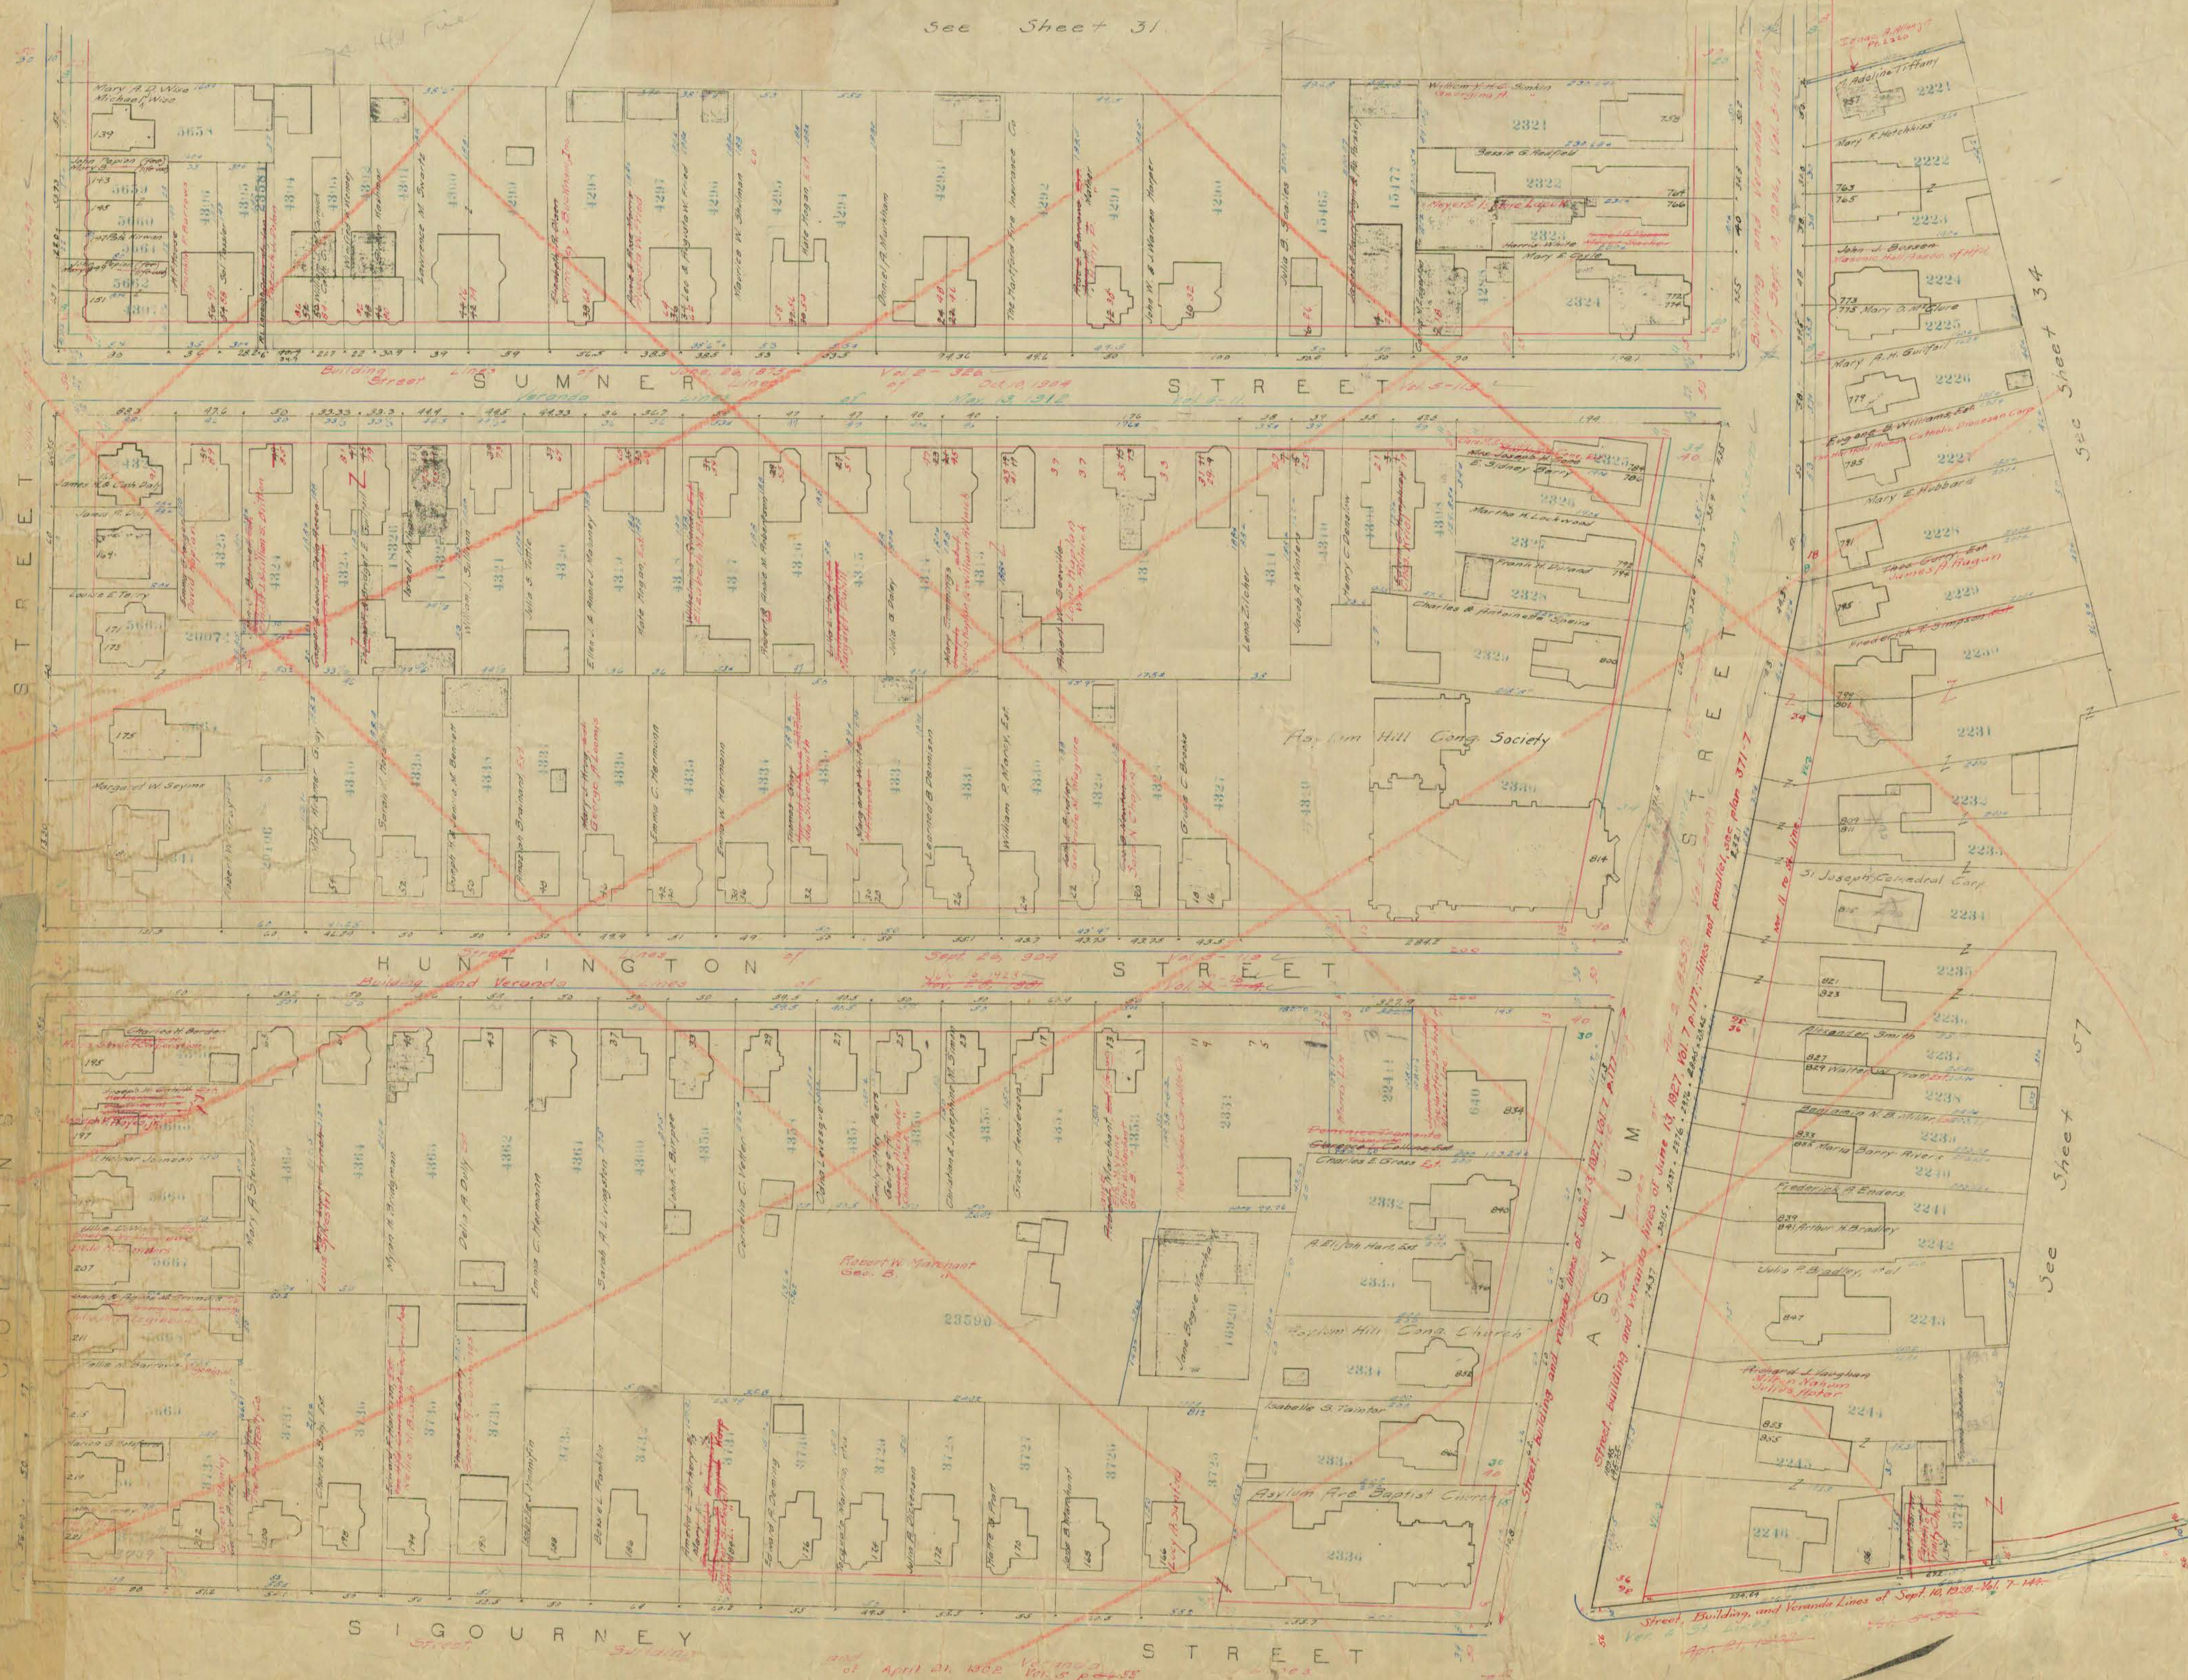

See Sheet 34

See Sheet 57