


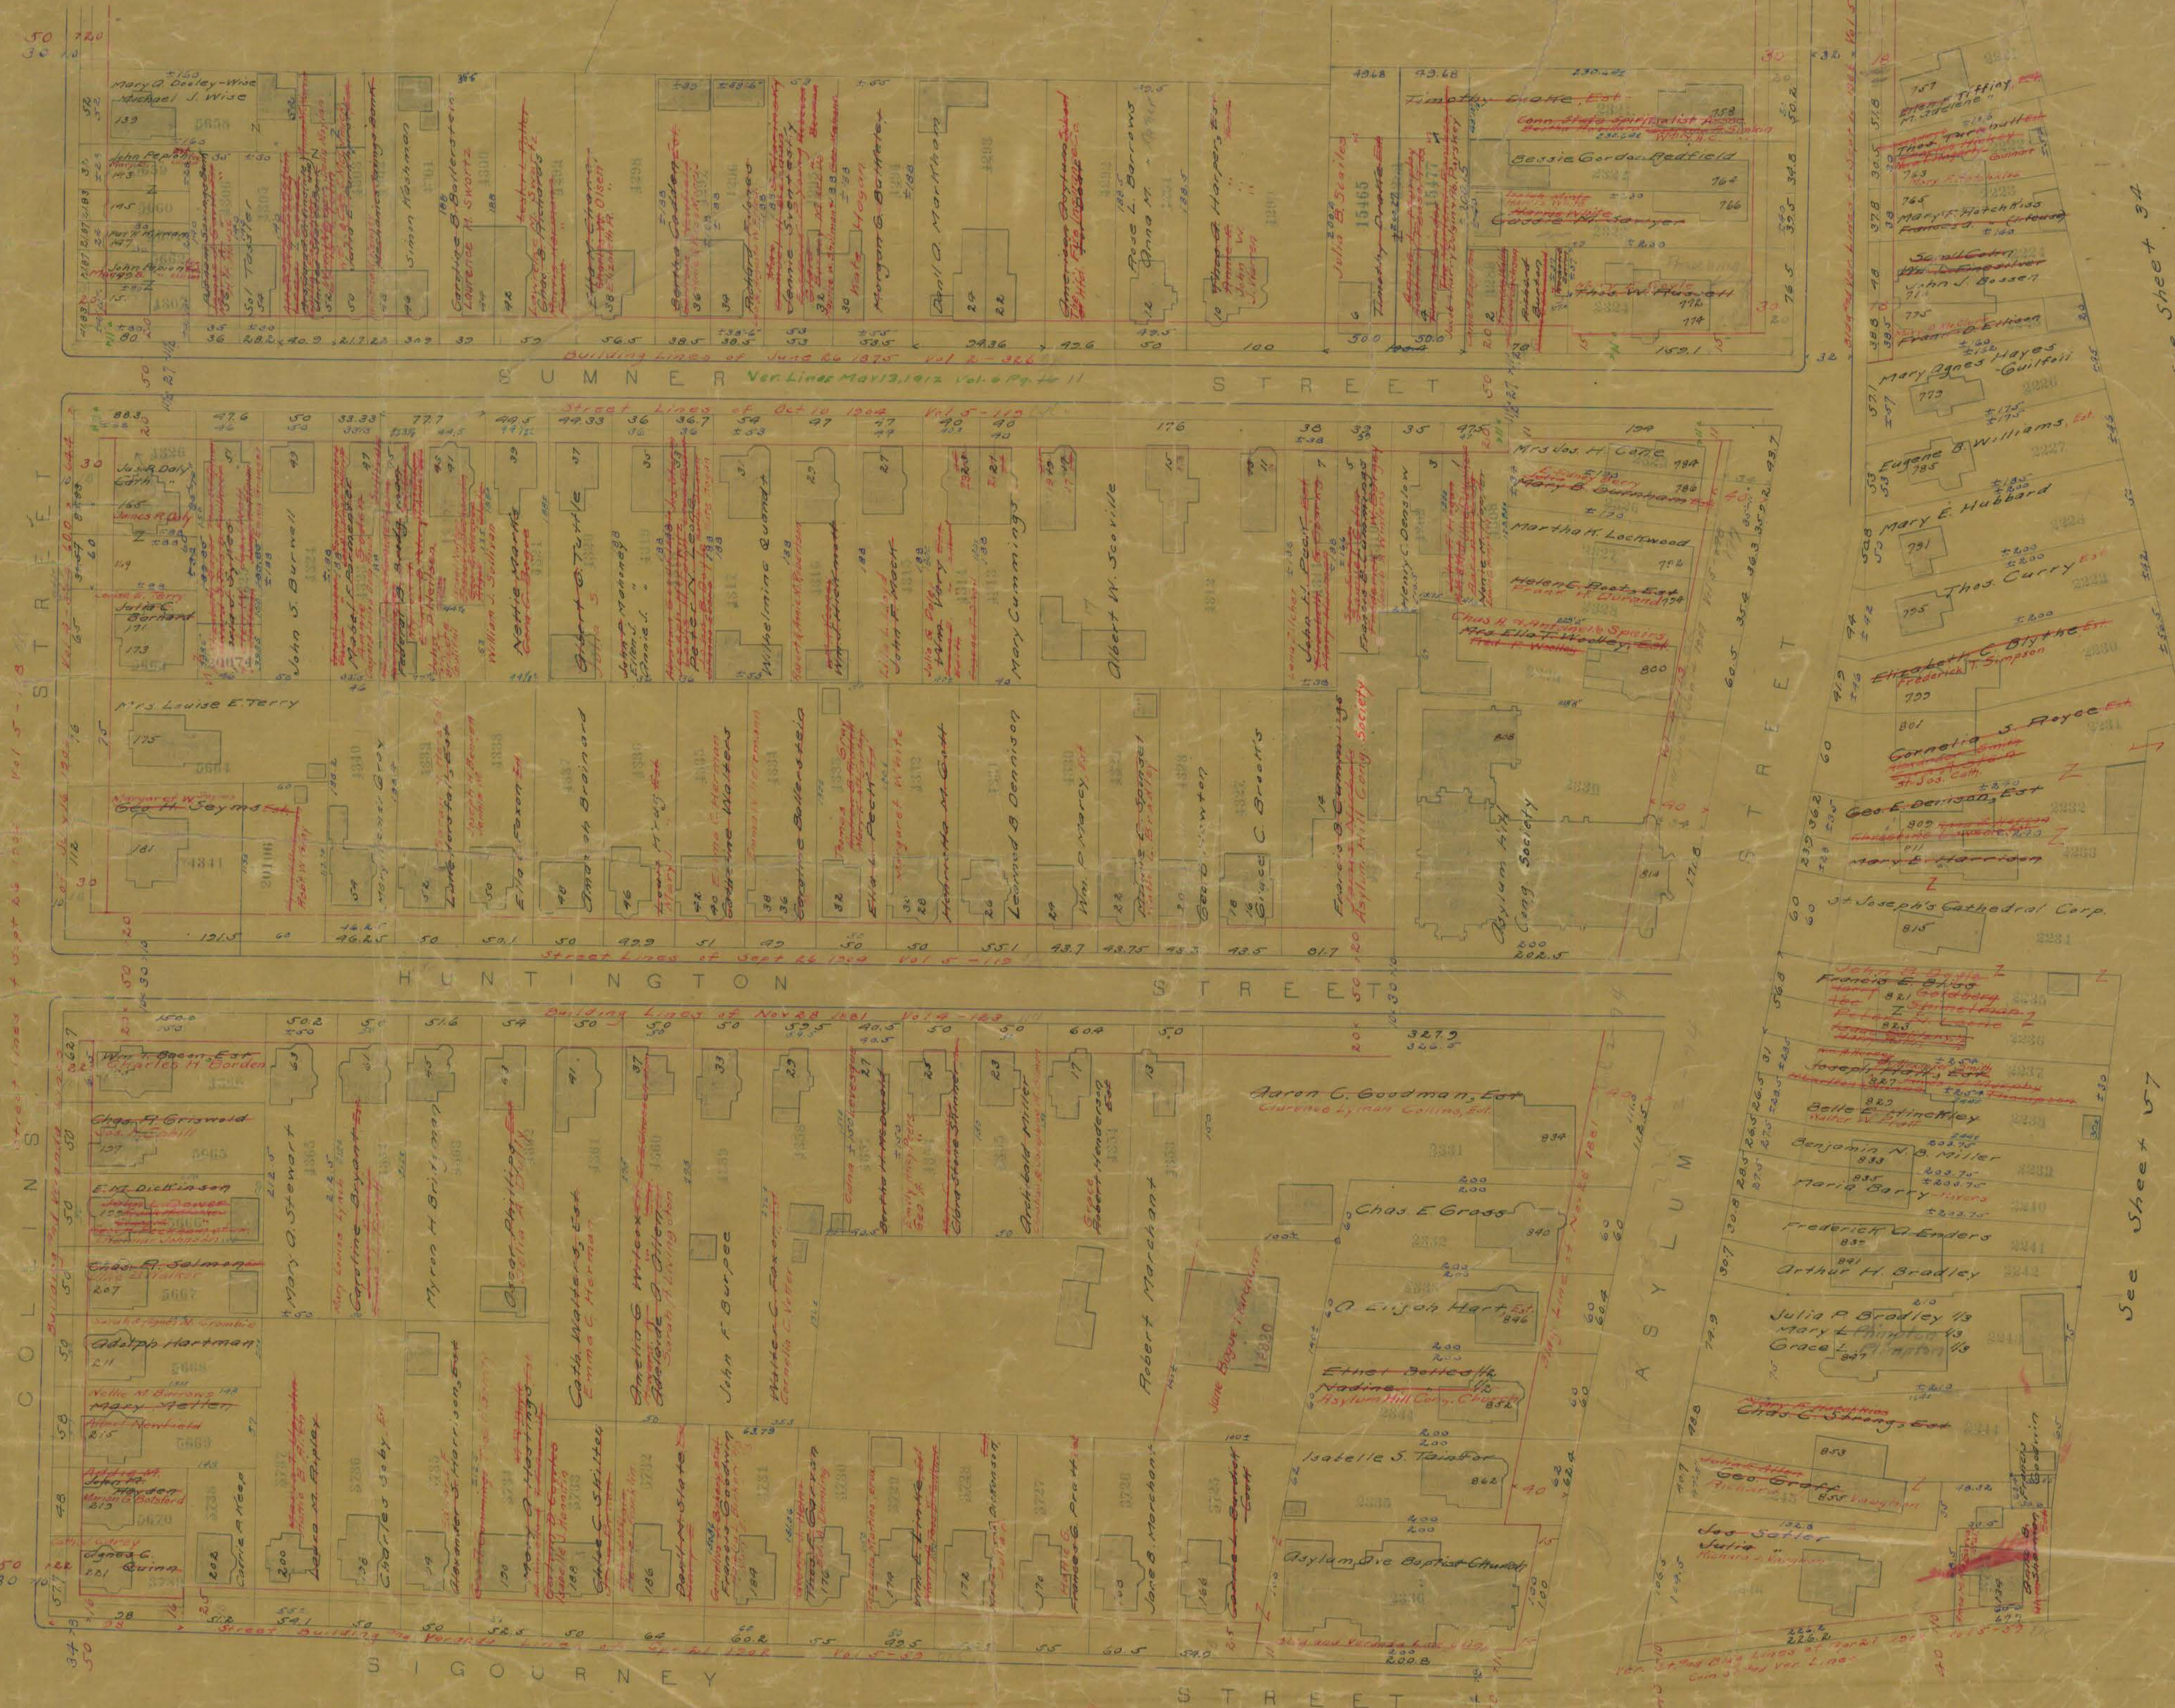

See Sheet 34

See Sheet 57