


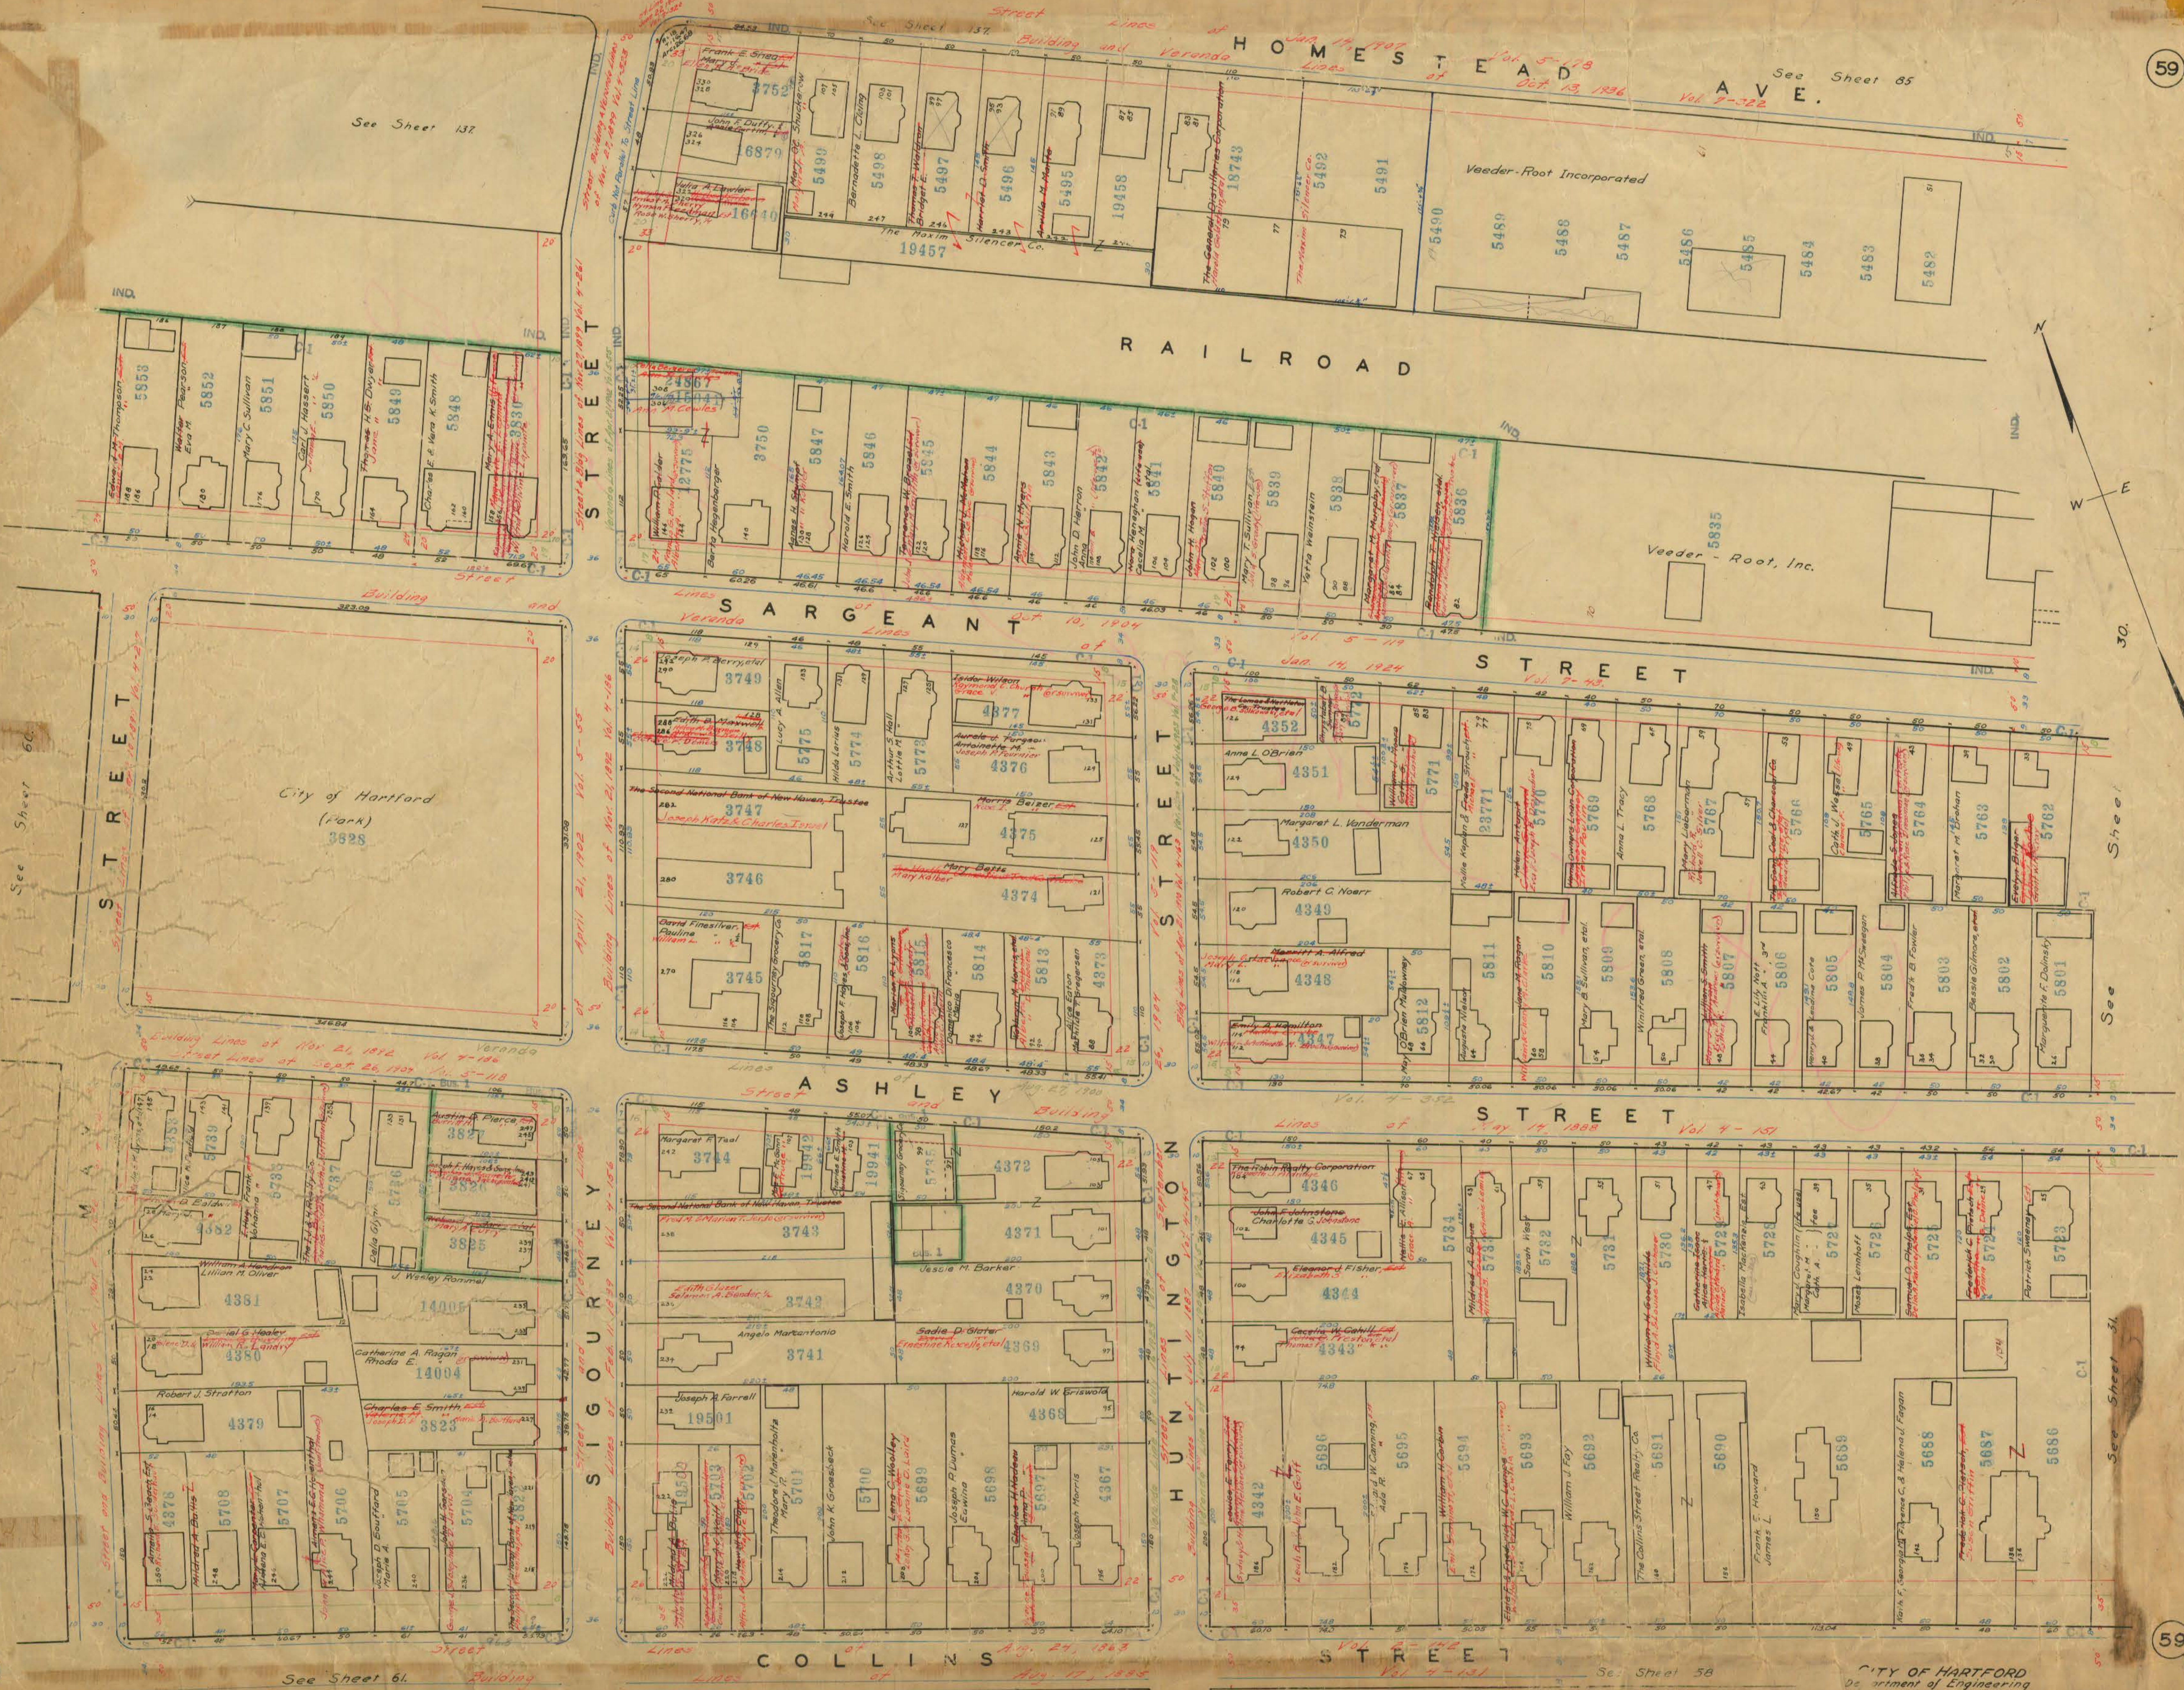

See Sheet 60

See Sheet 31