


—EXHIBIT "B"—
—WEST SIDE PLAN—

SCALE: 1 IN. = 50 FT.
1890 C.E.


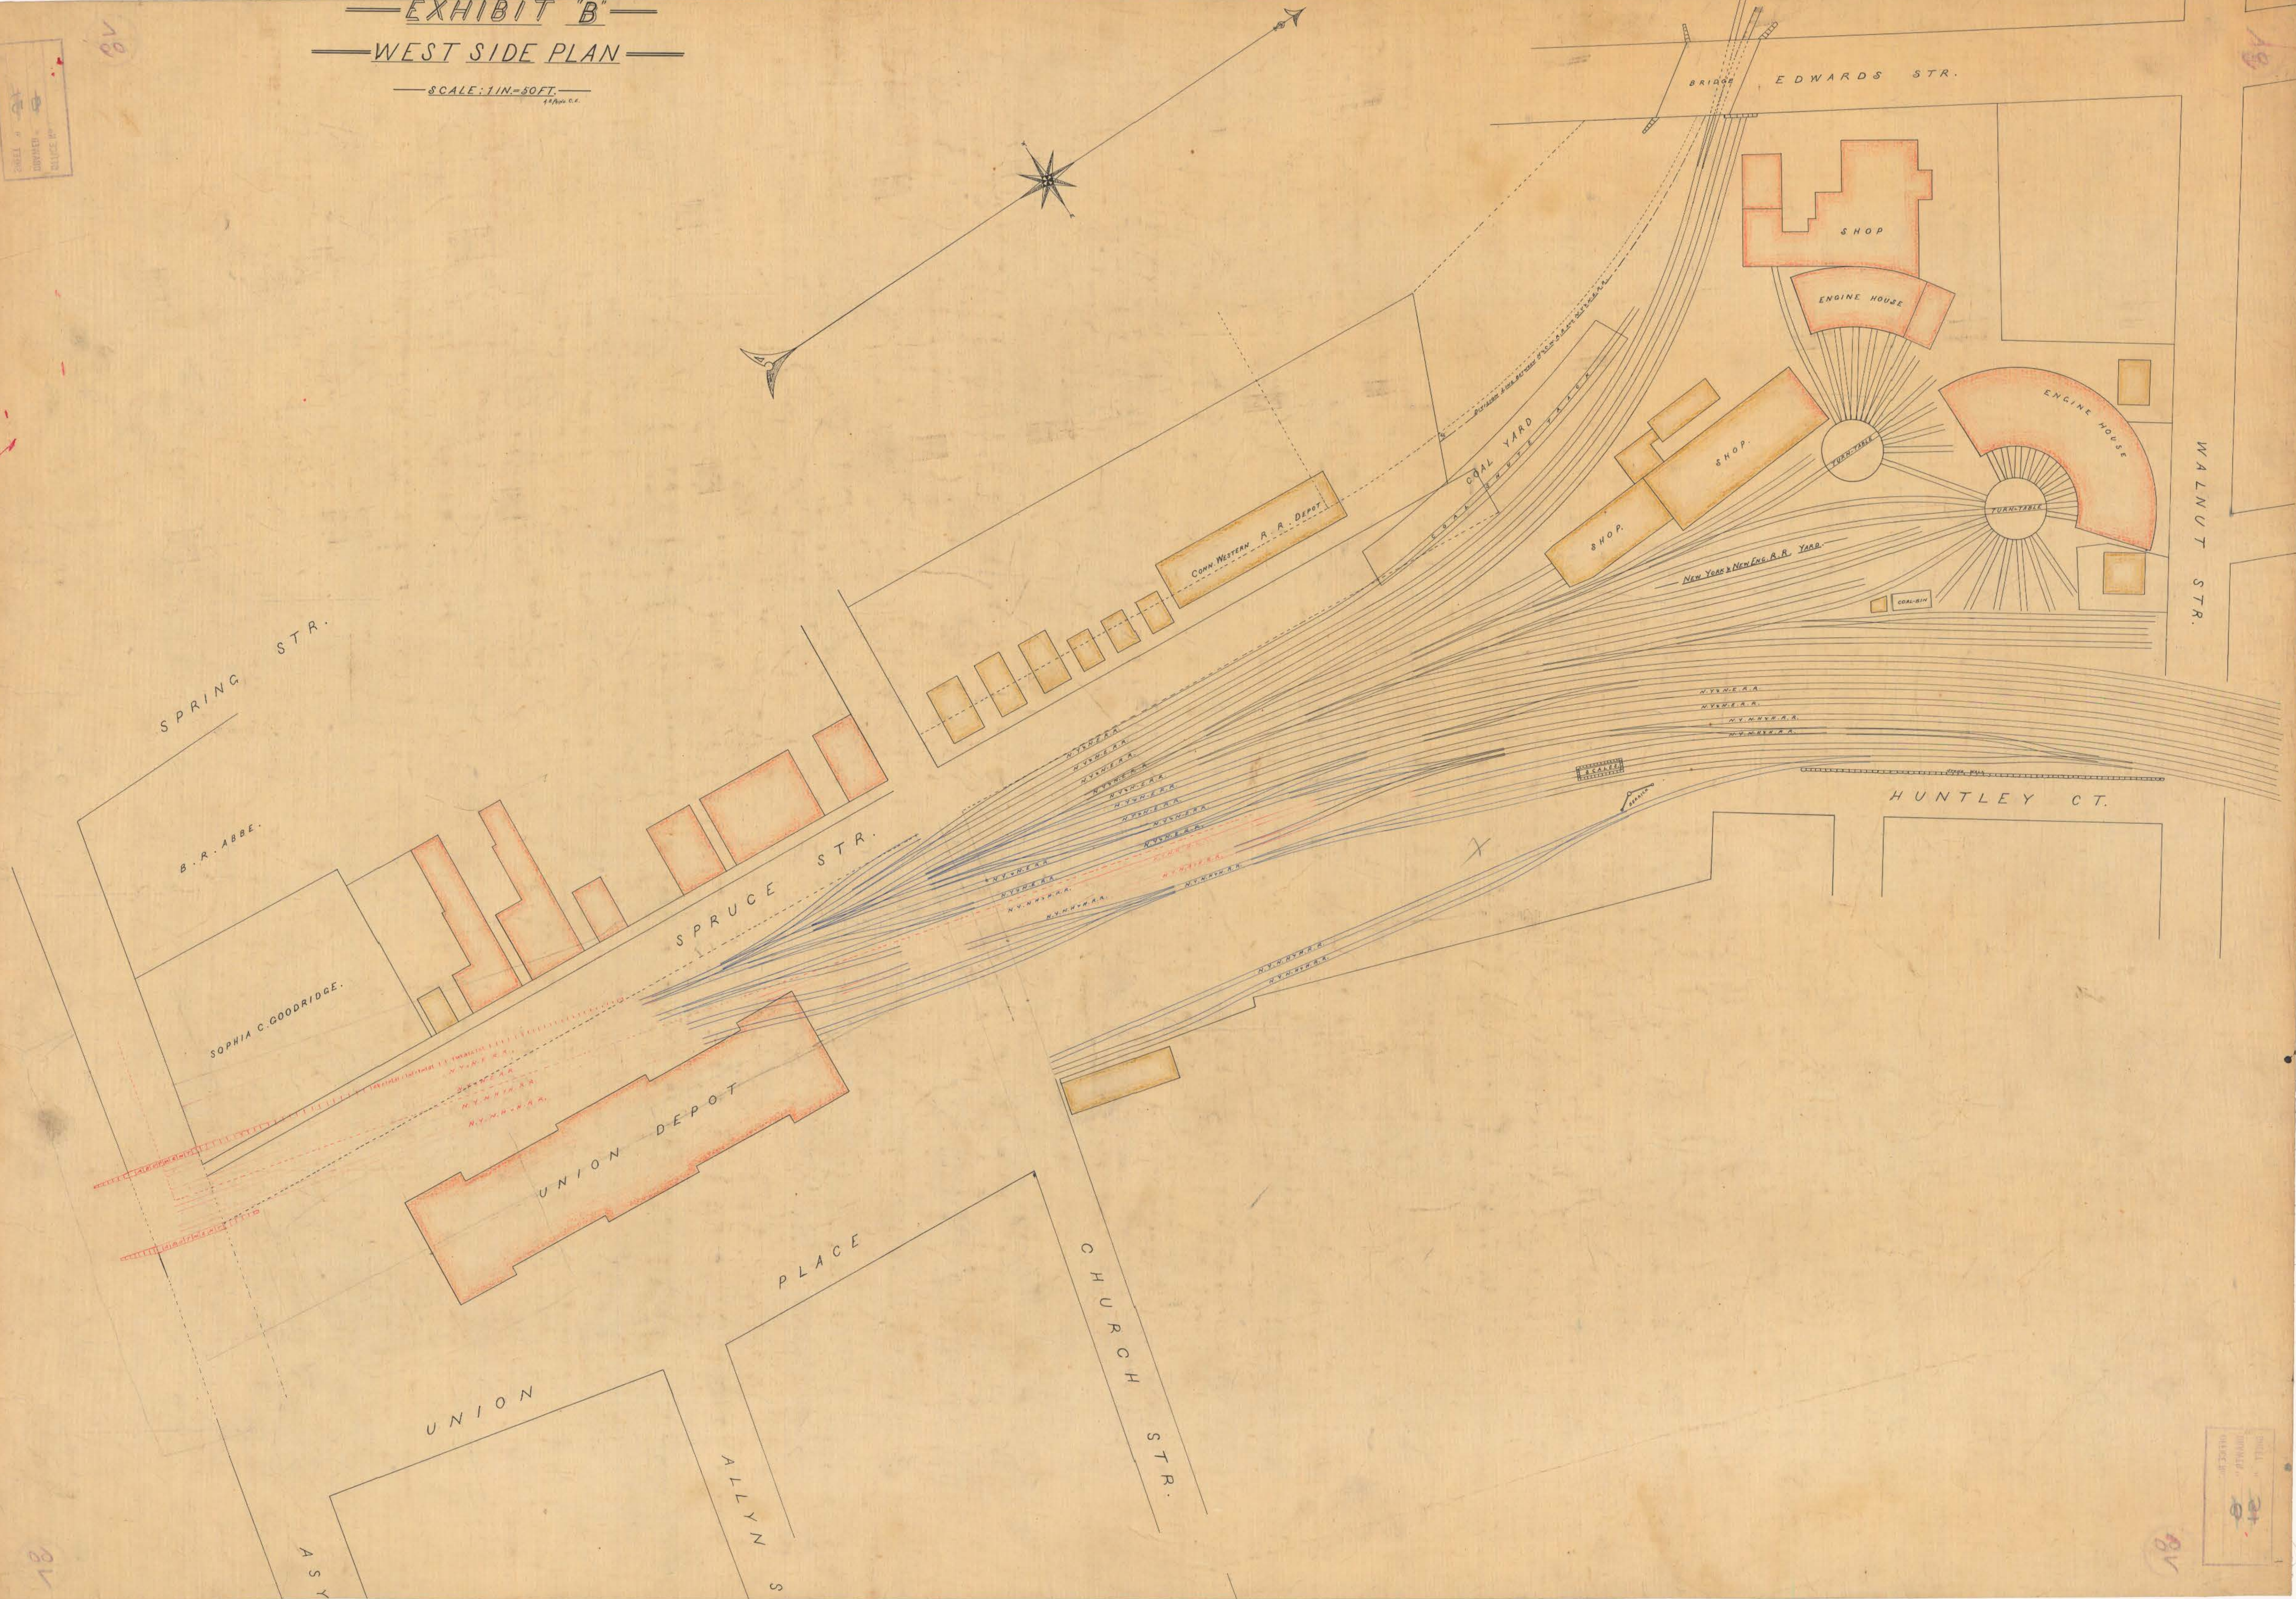

