



Stone Bridge built 1833.  
**MAIN STREET BRIDGE:**


SCALE 10'-1"  
L.W. Reed - City Surveyor.  
1893 - 4.

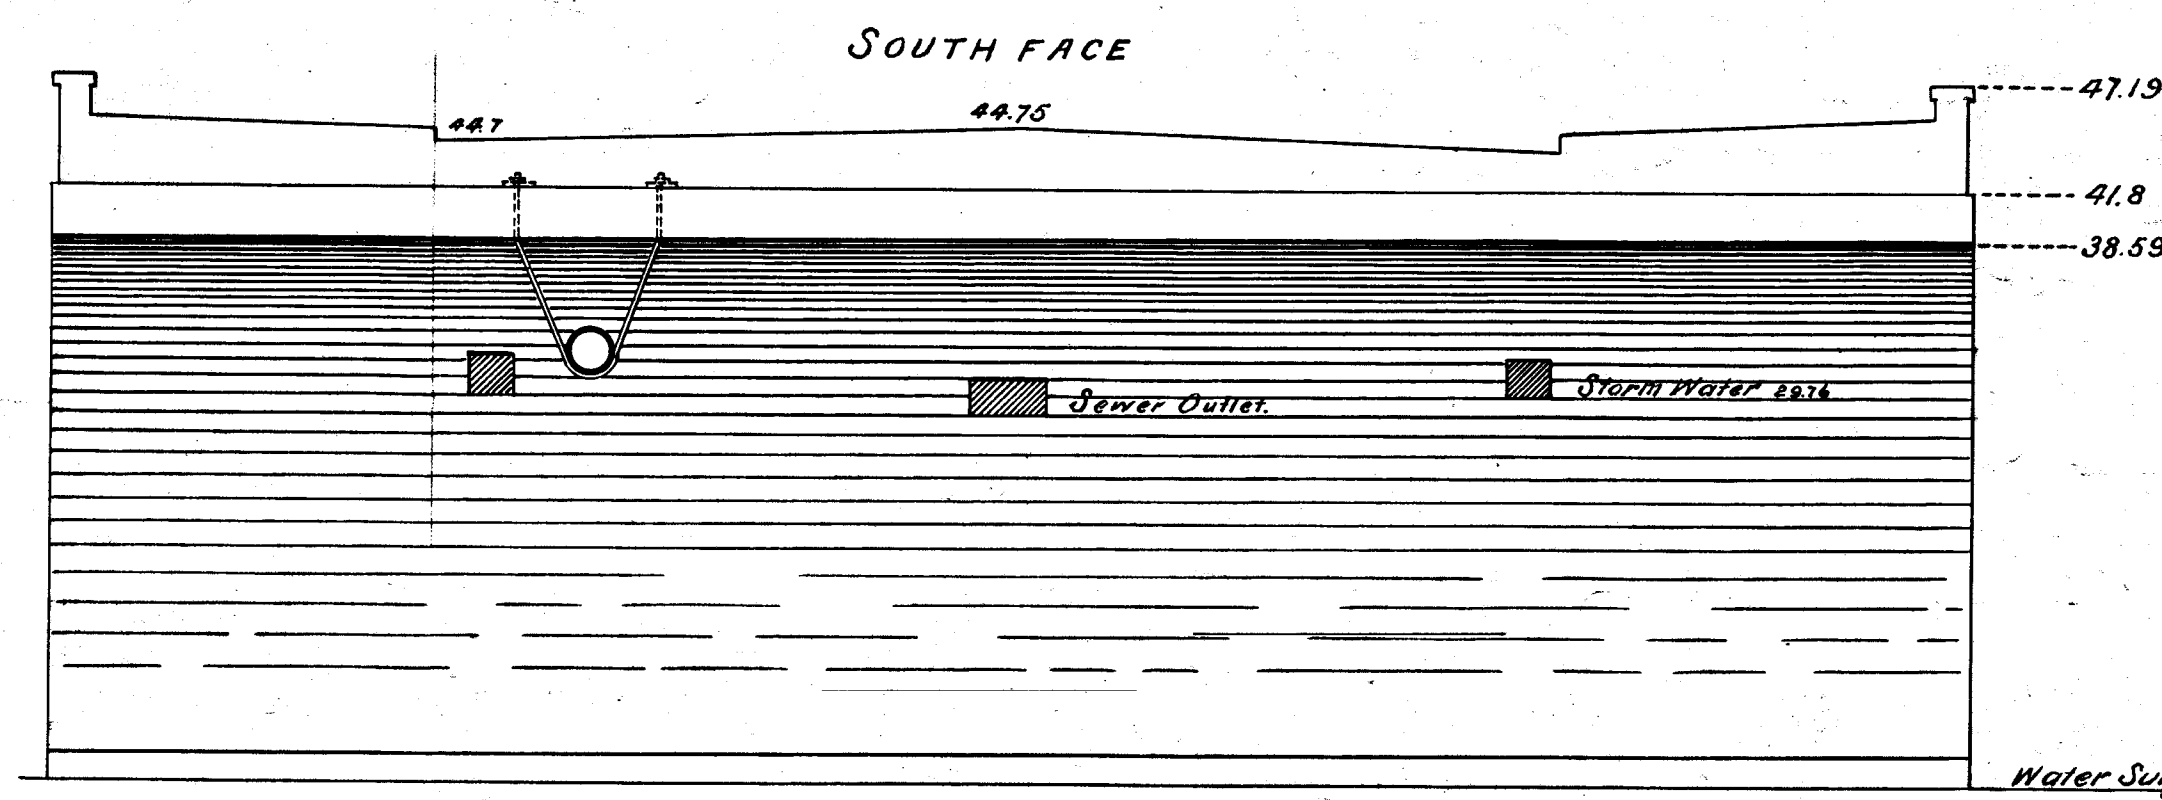

SECTION

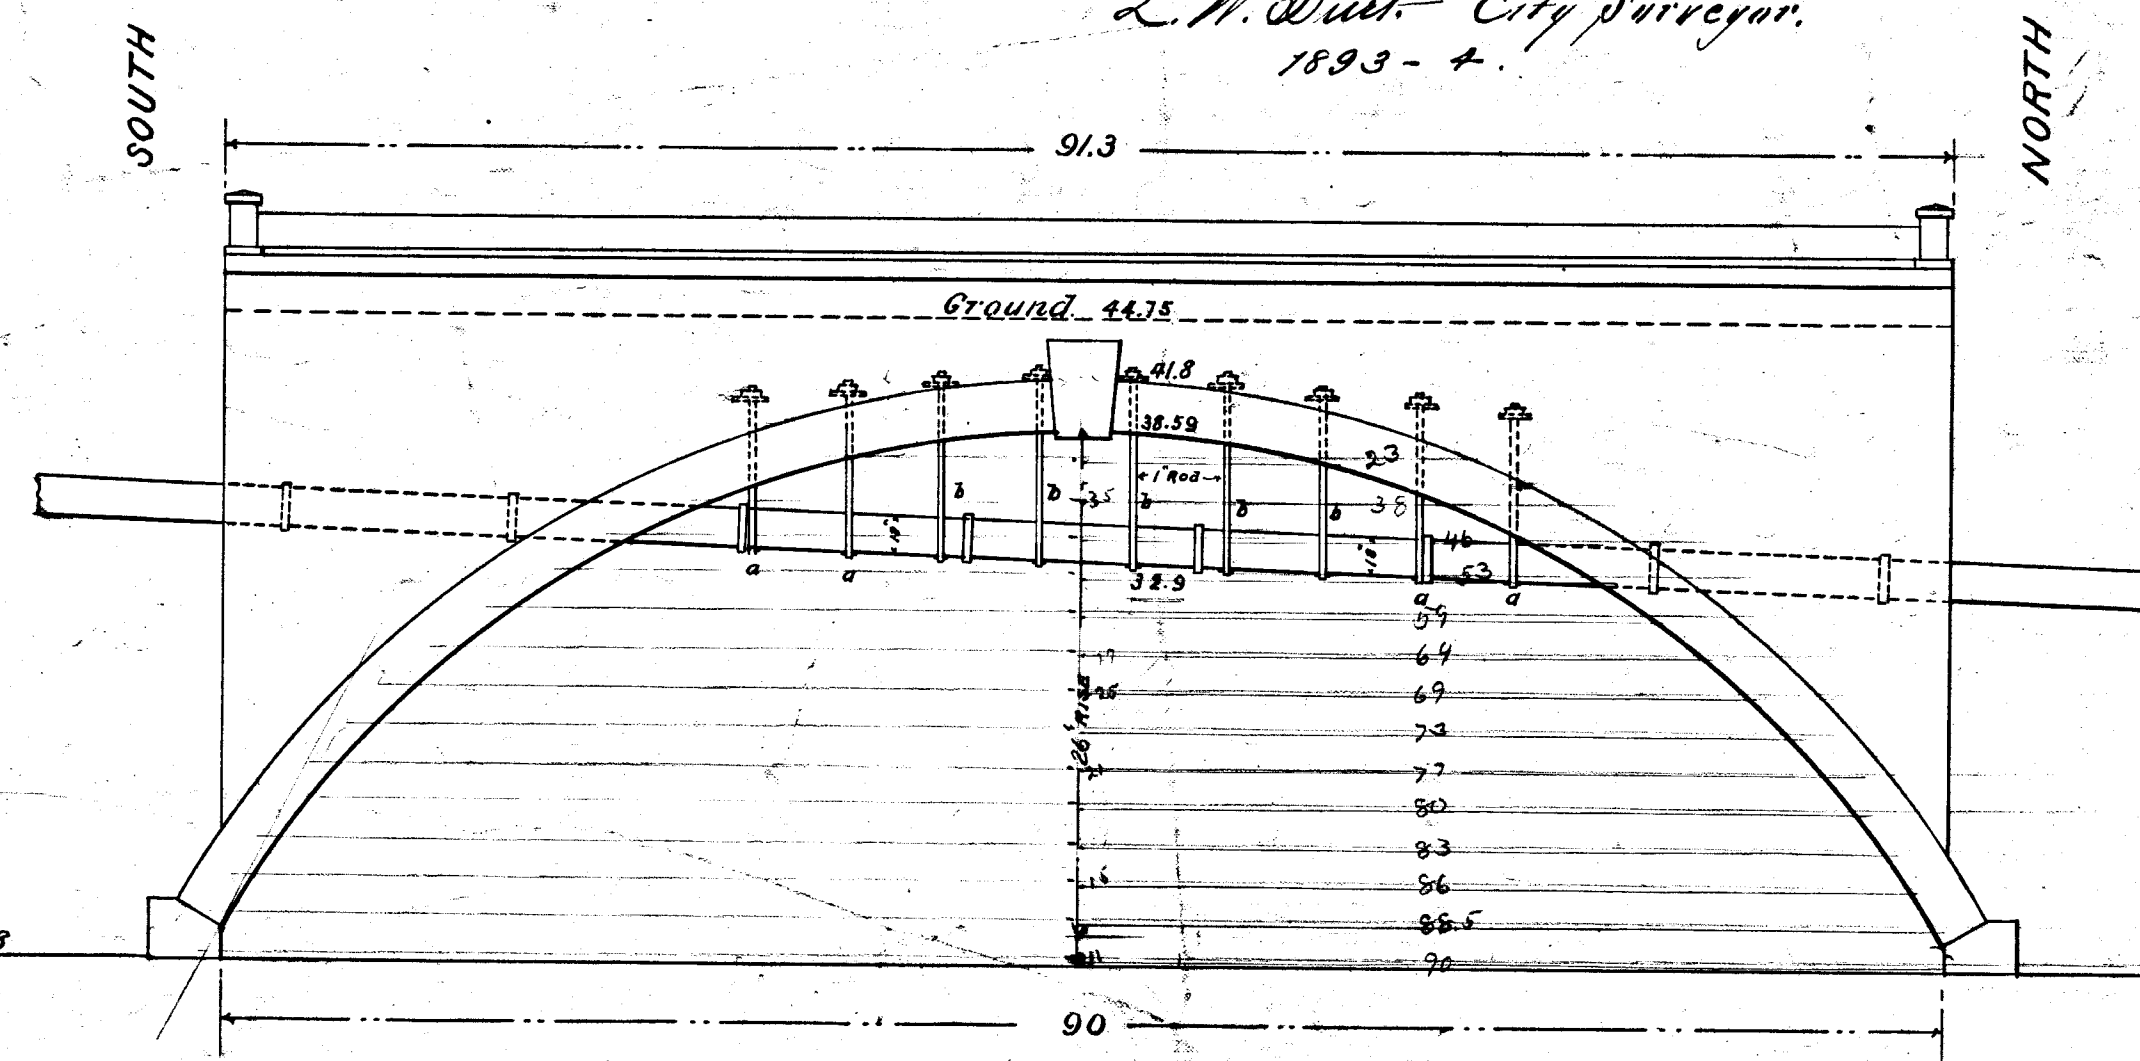


ELEVATION


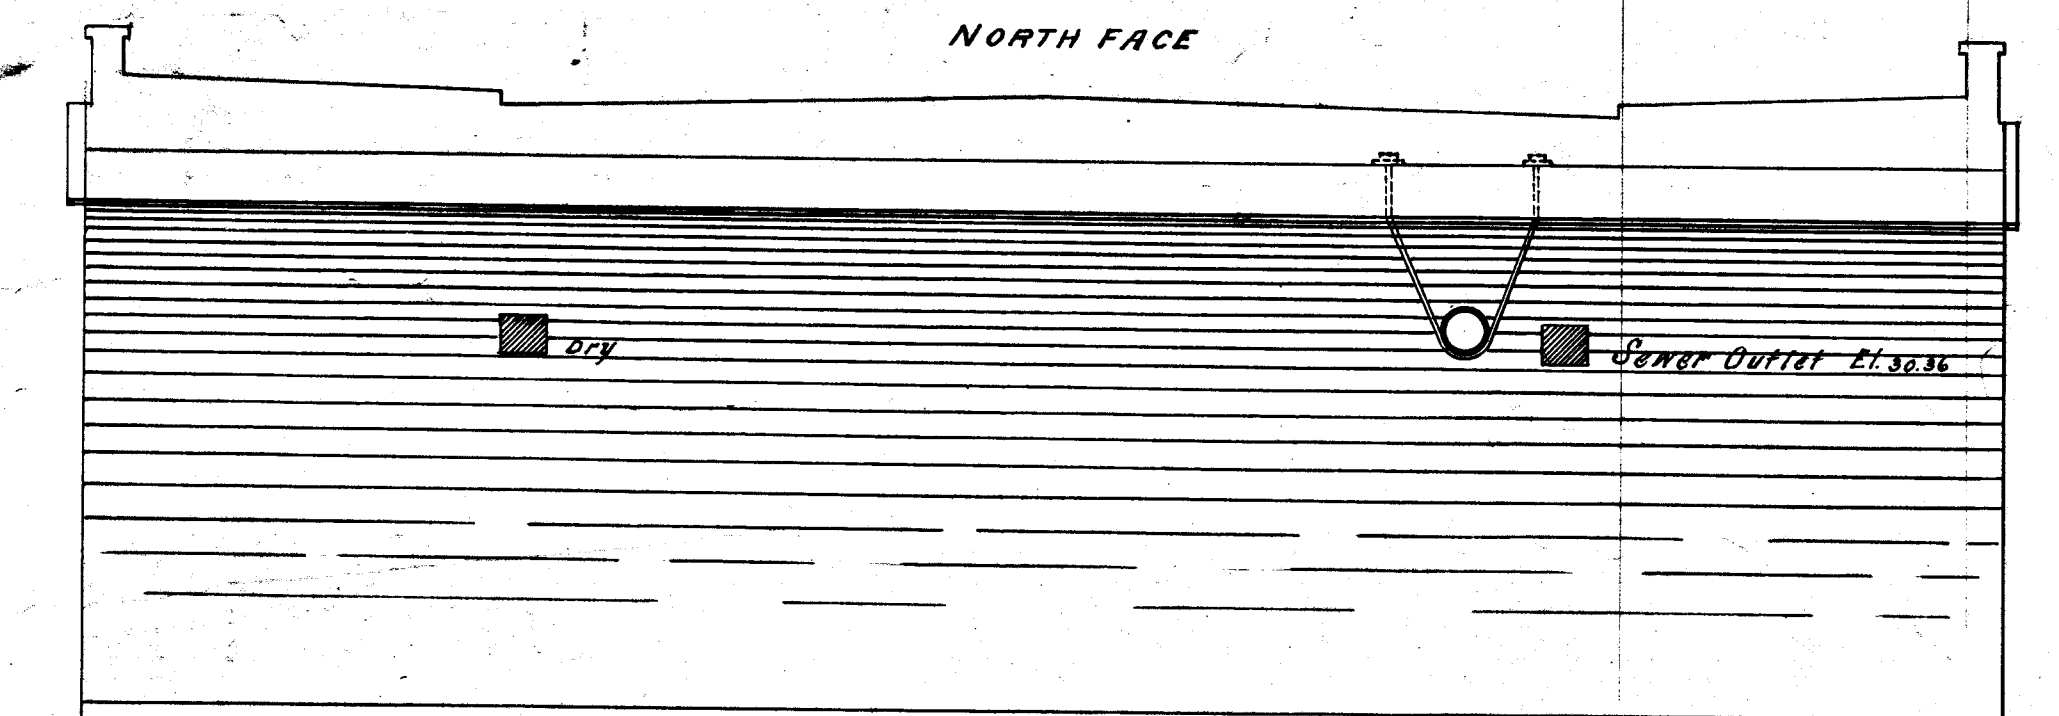


SECTION

PLAN

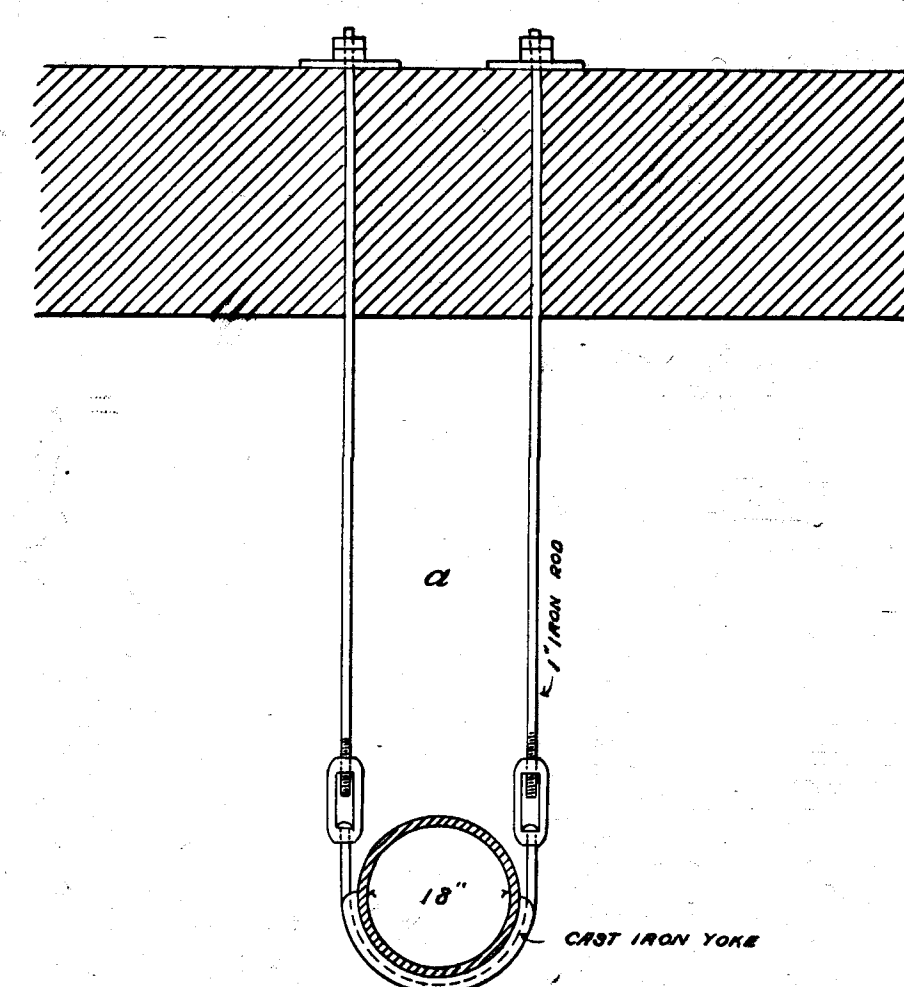

SCALE 1/8" = 1'

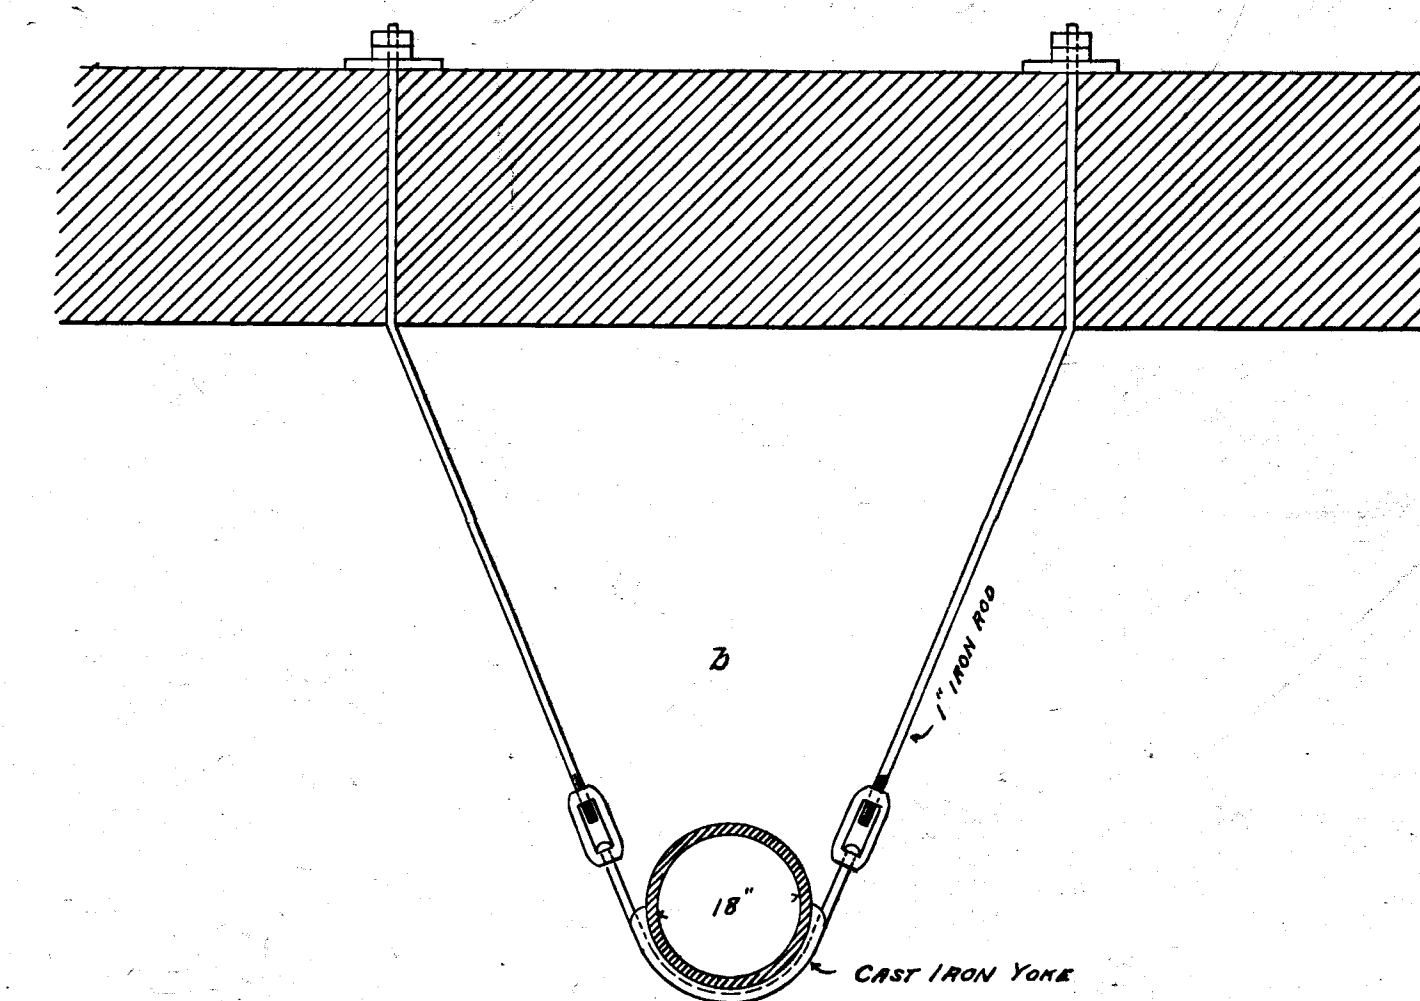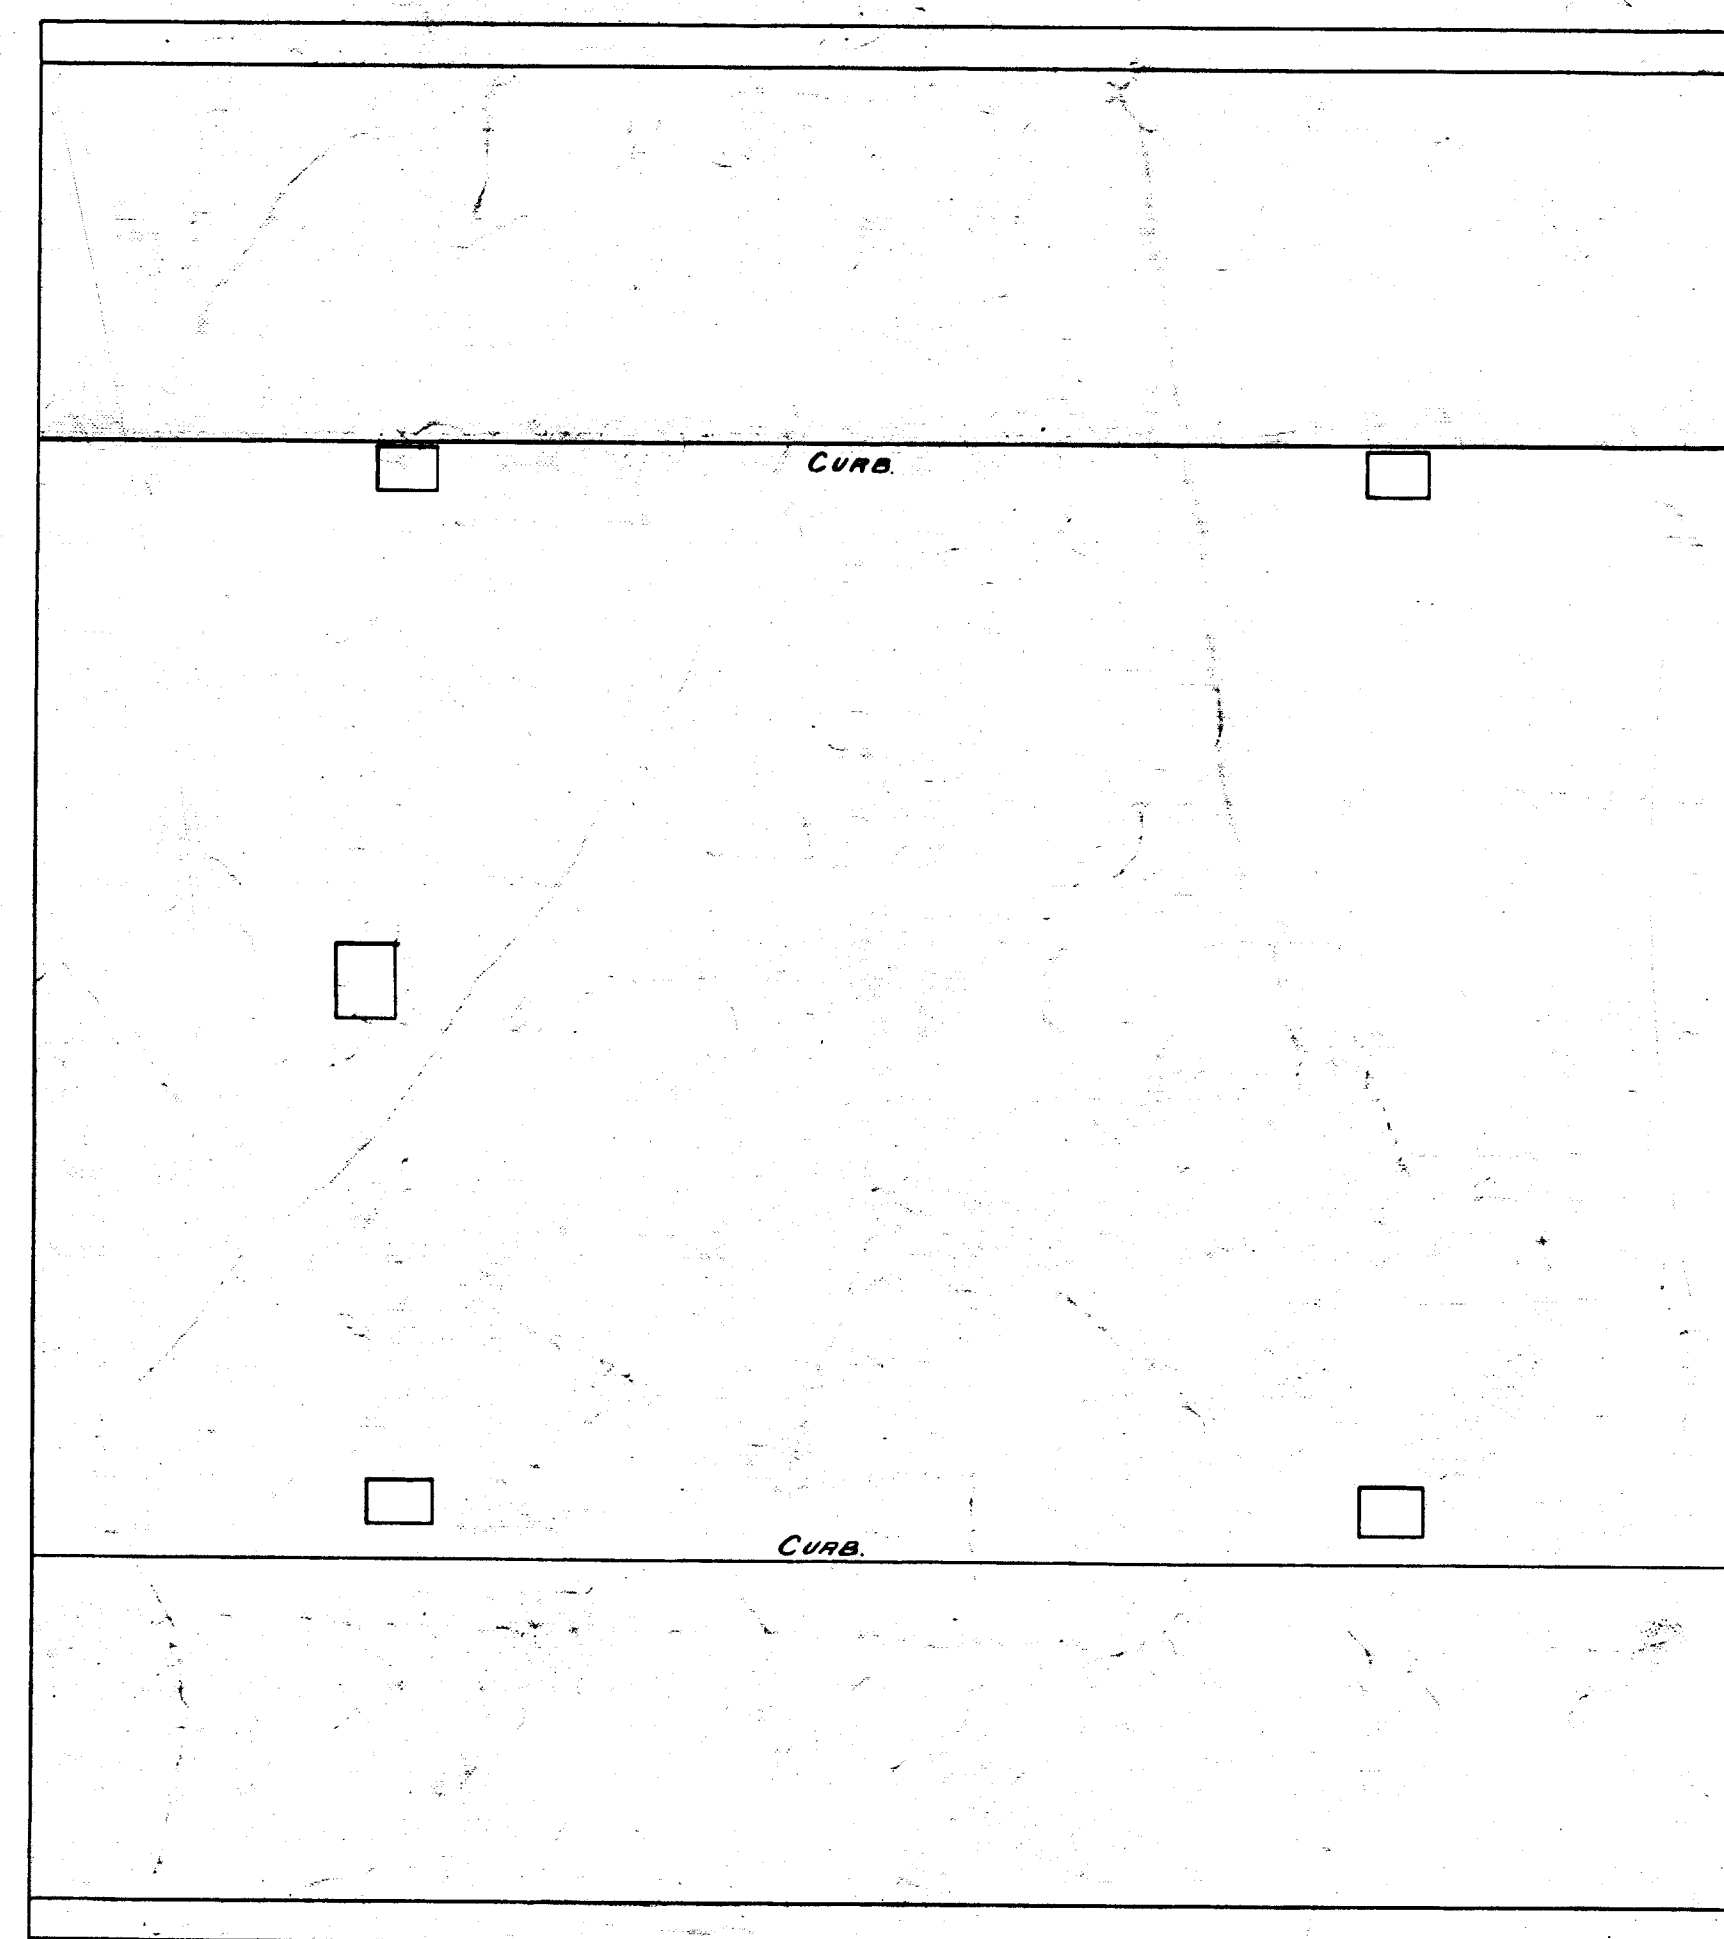

SCALE 1/8" = 1'