
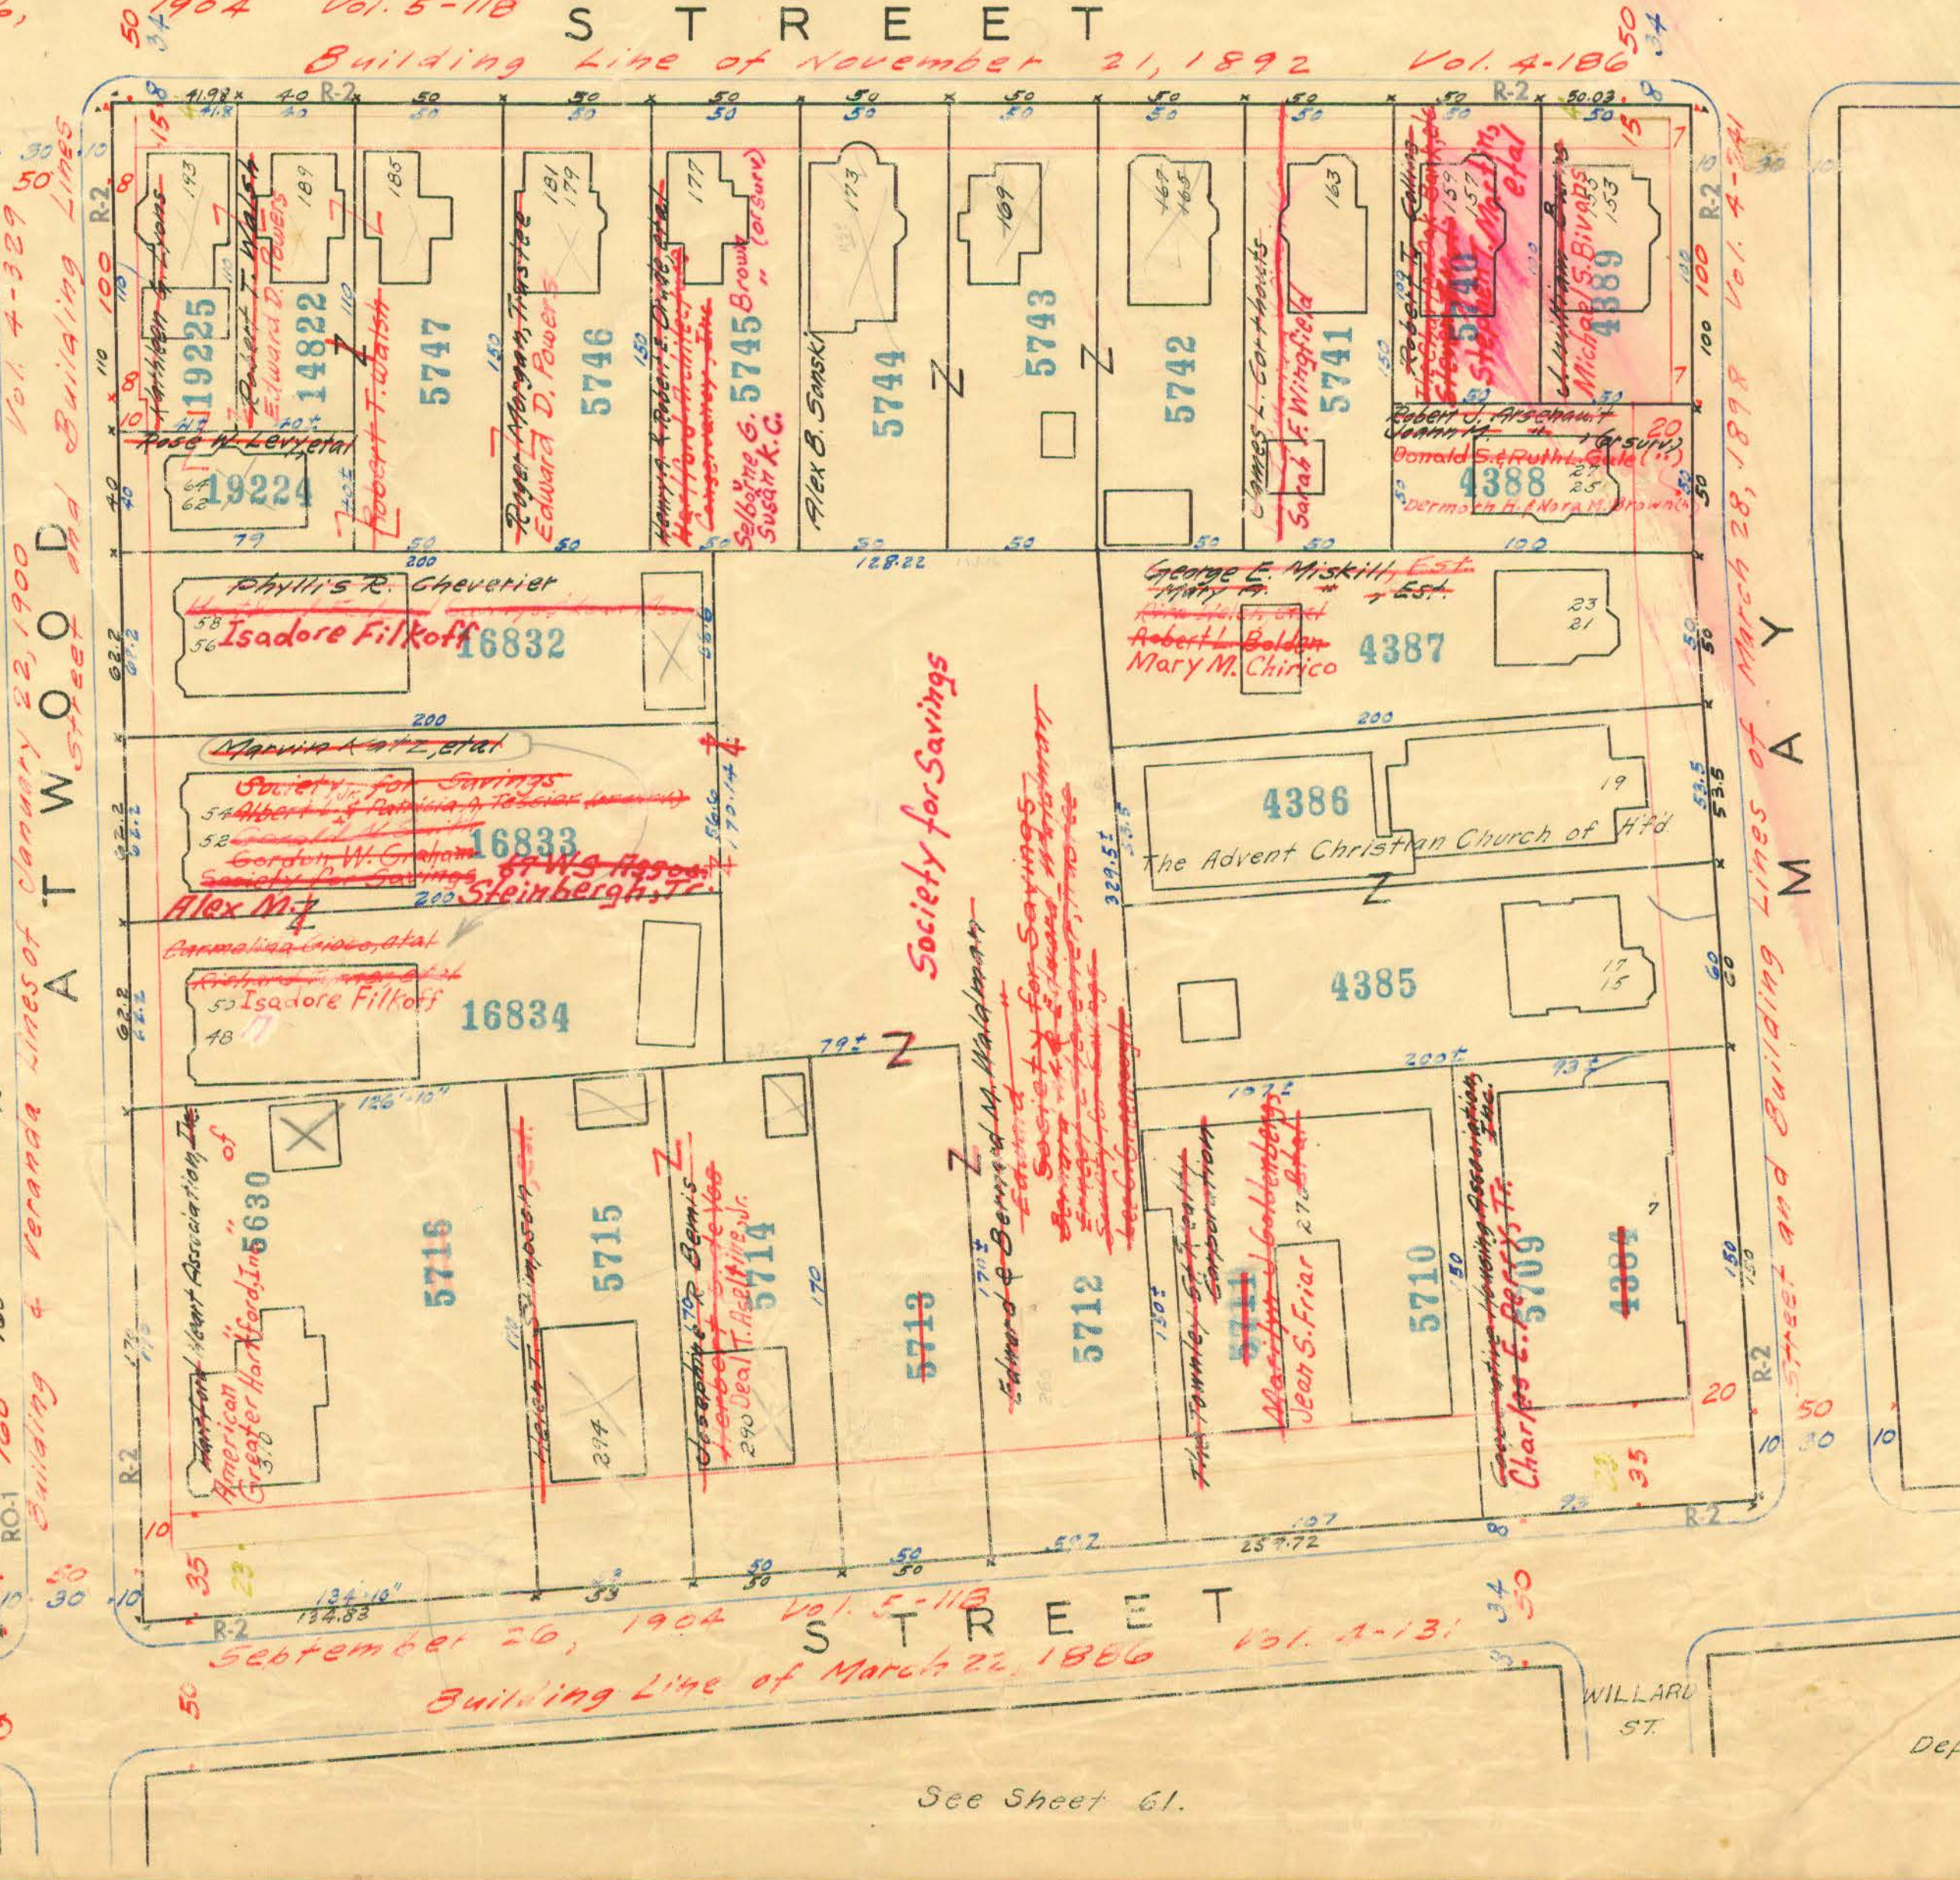
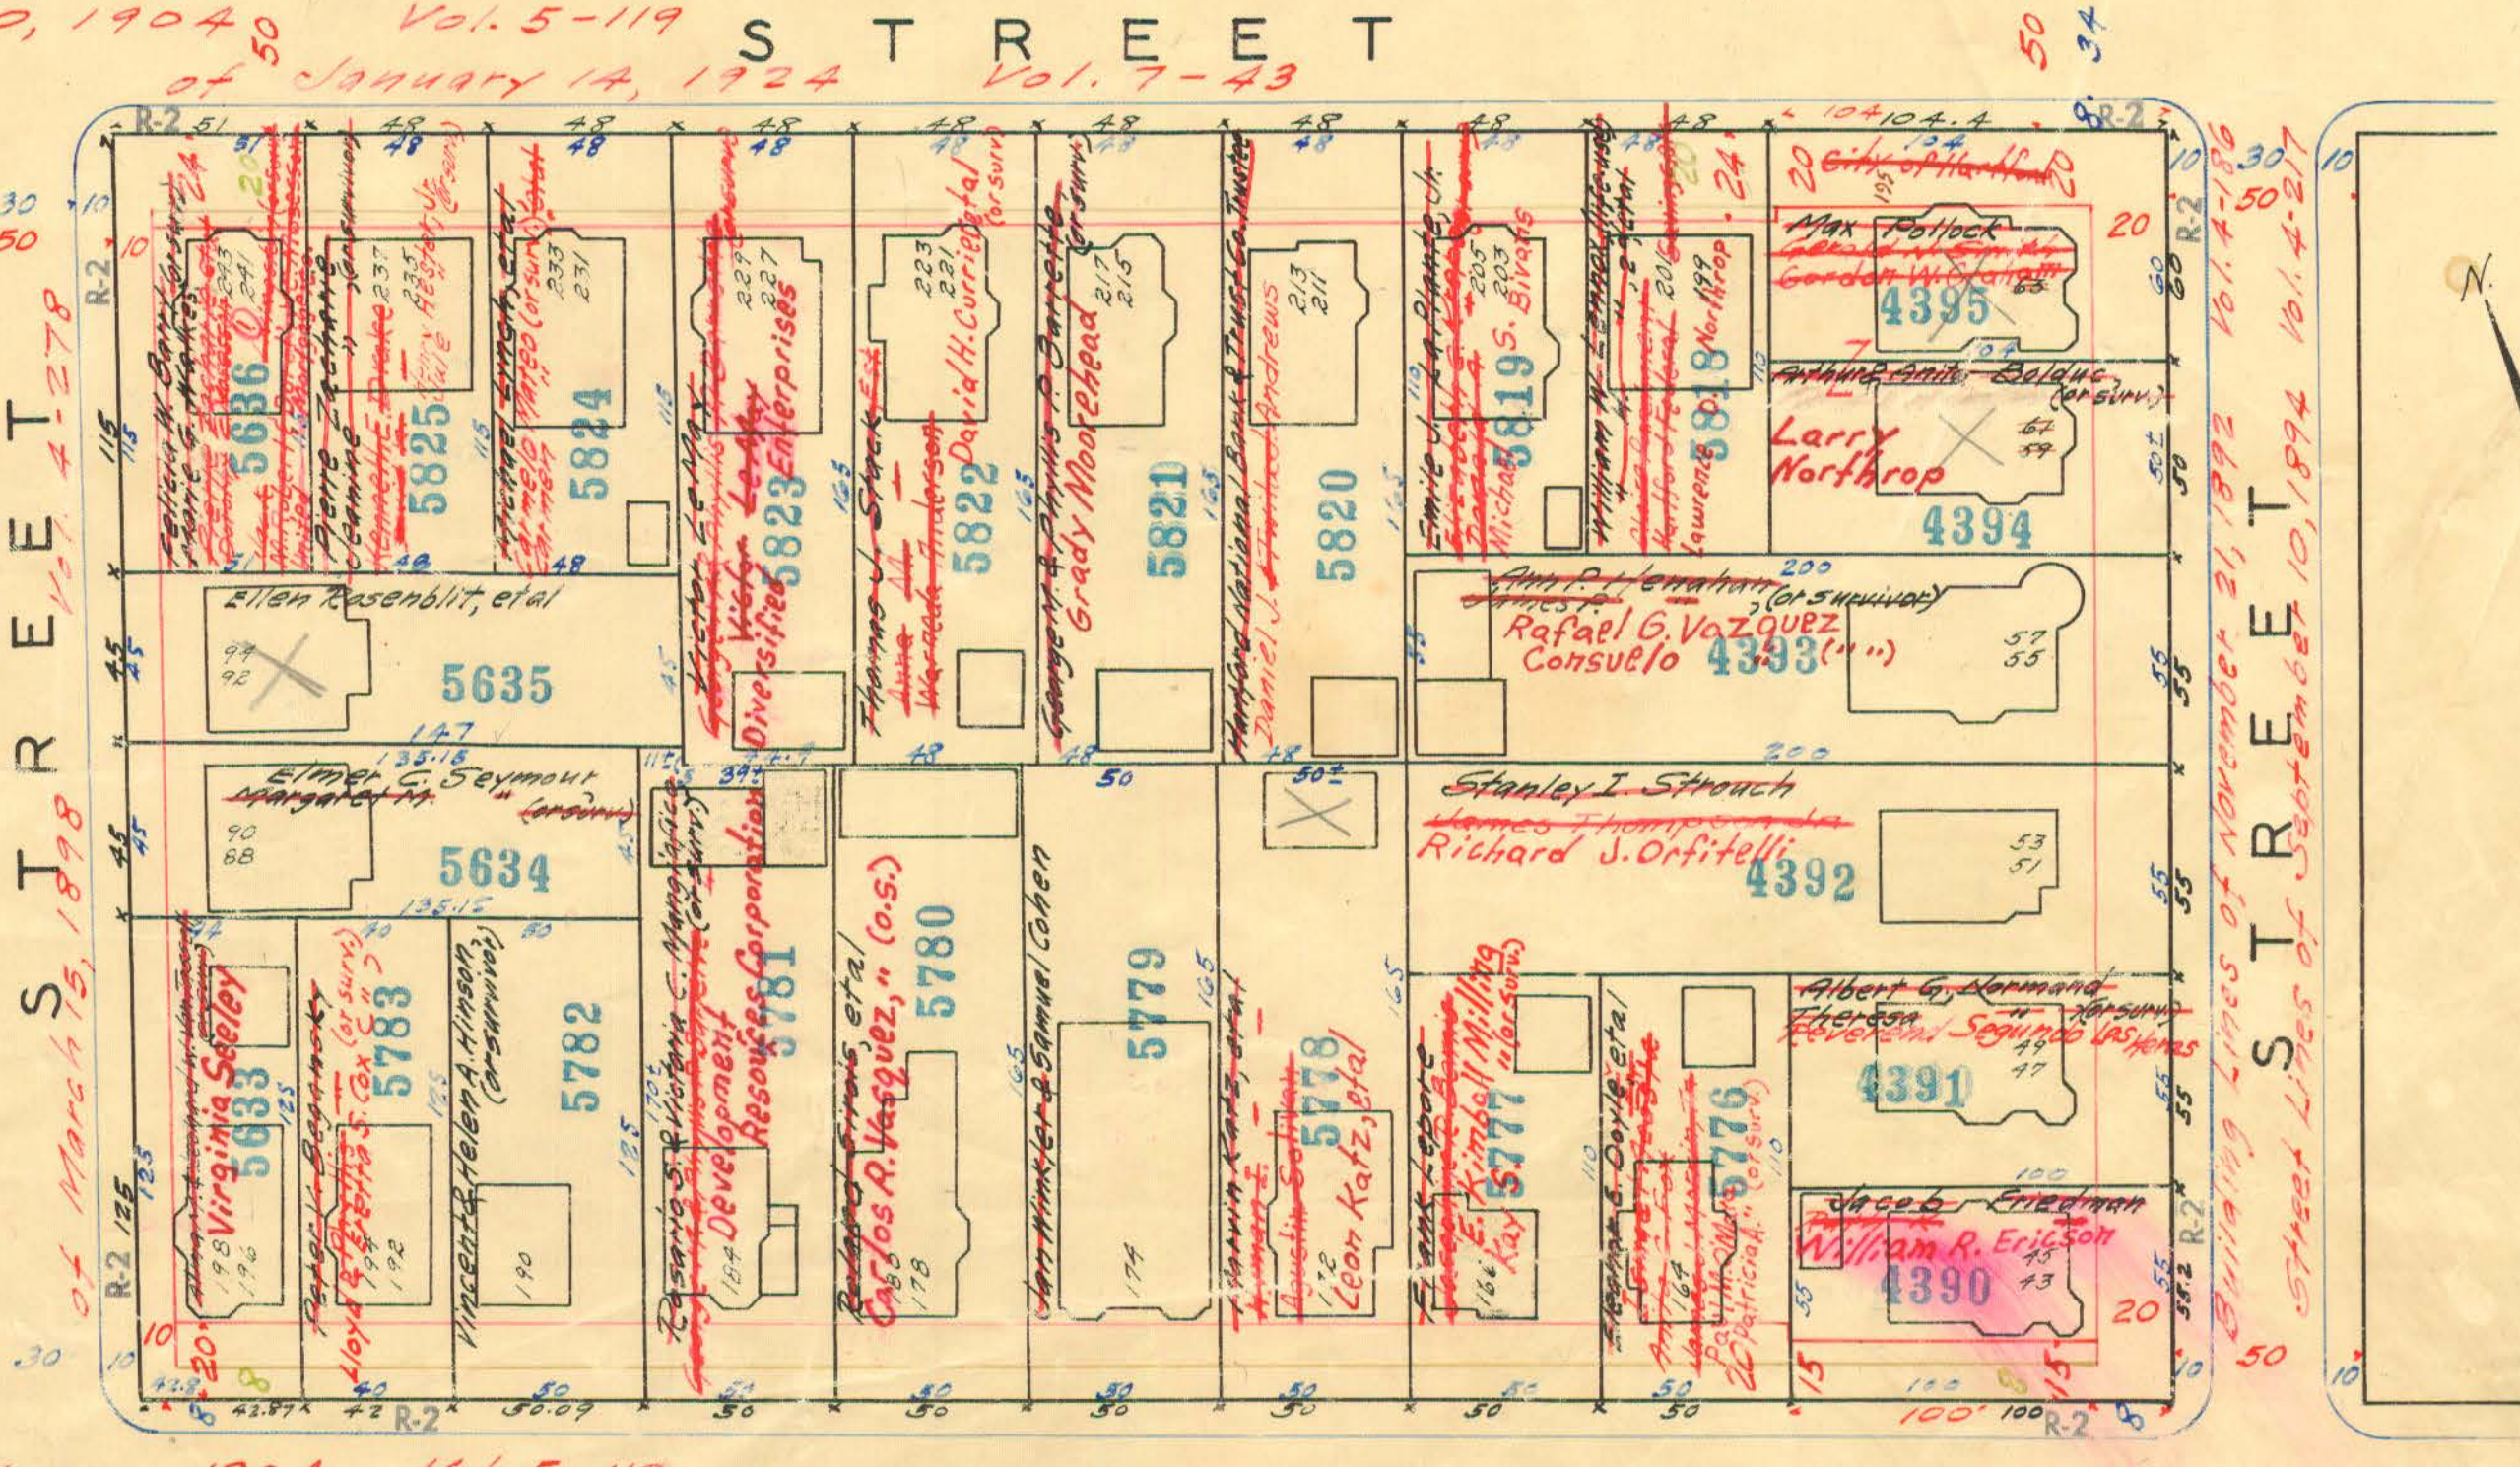
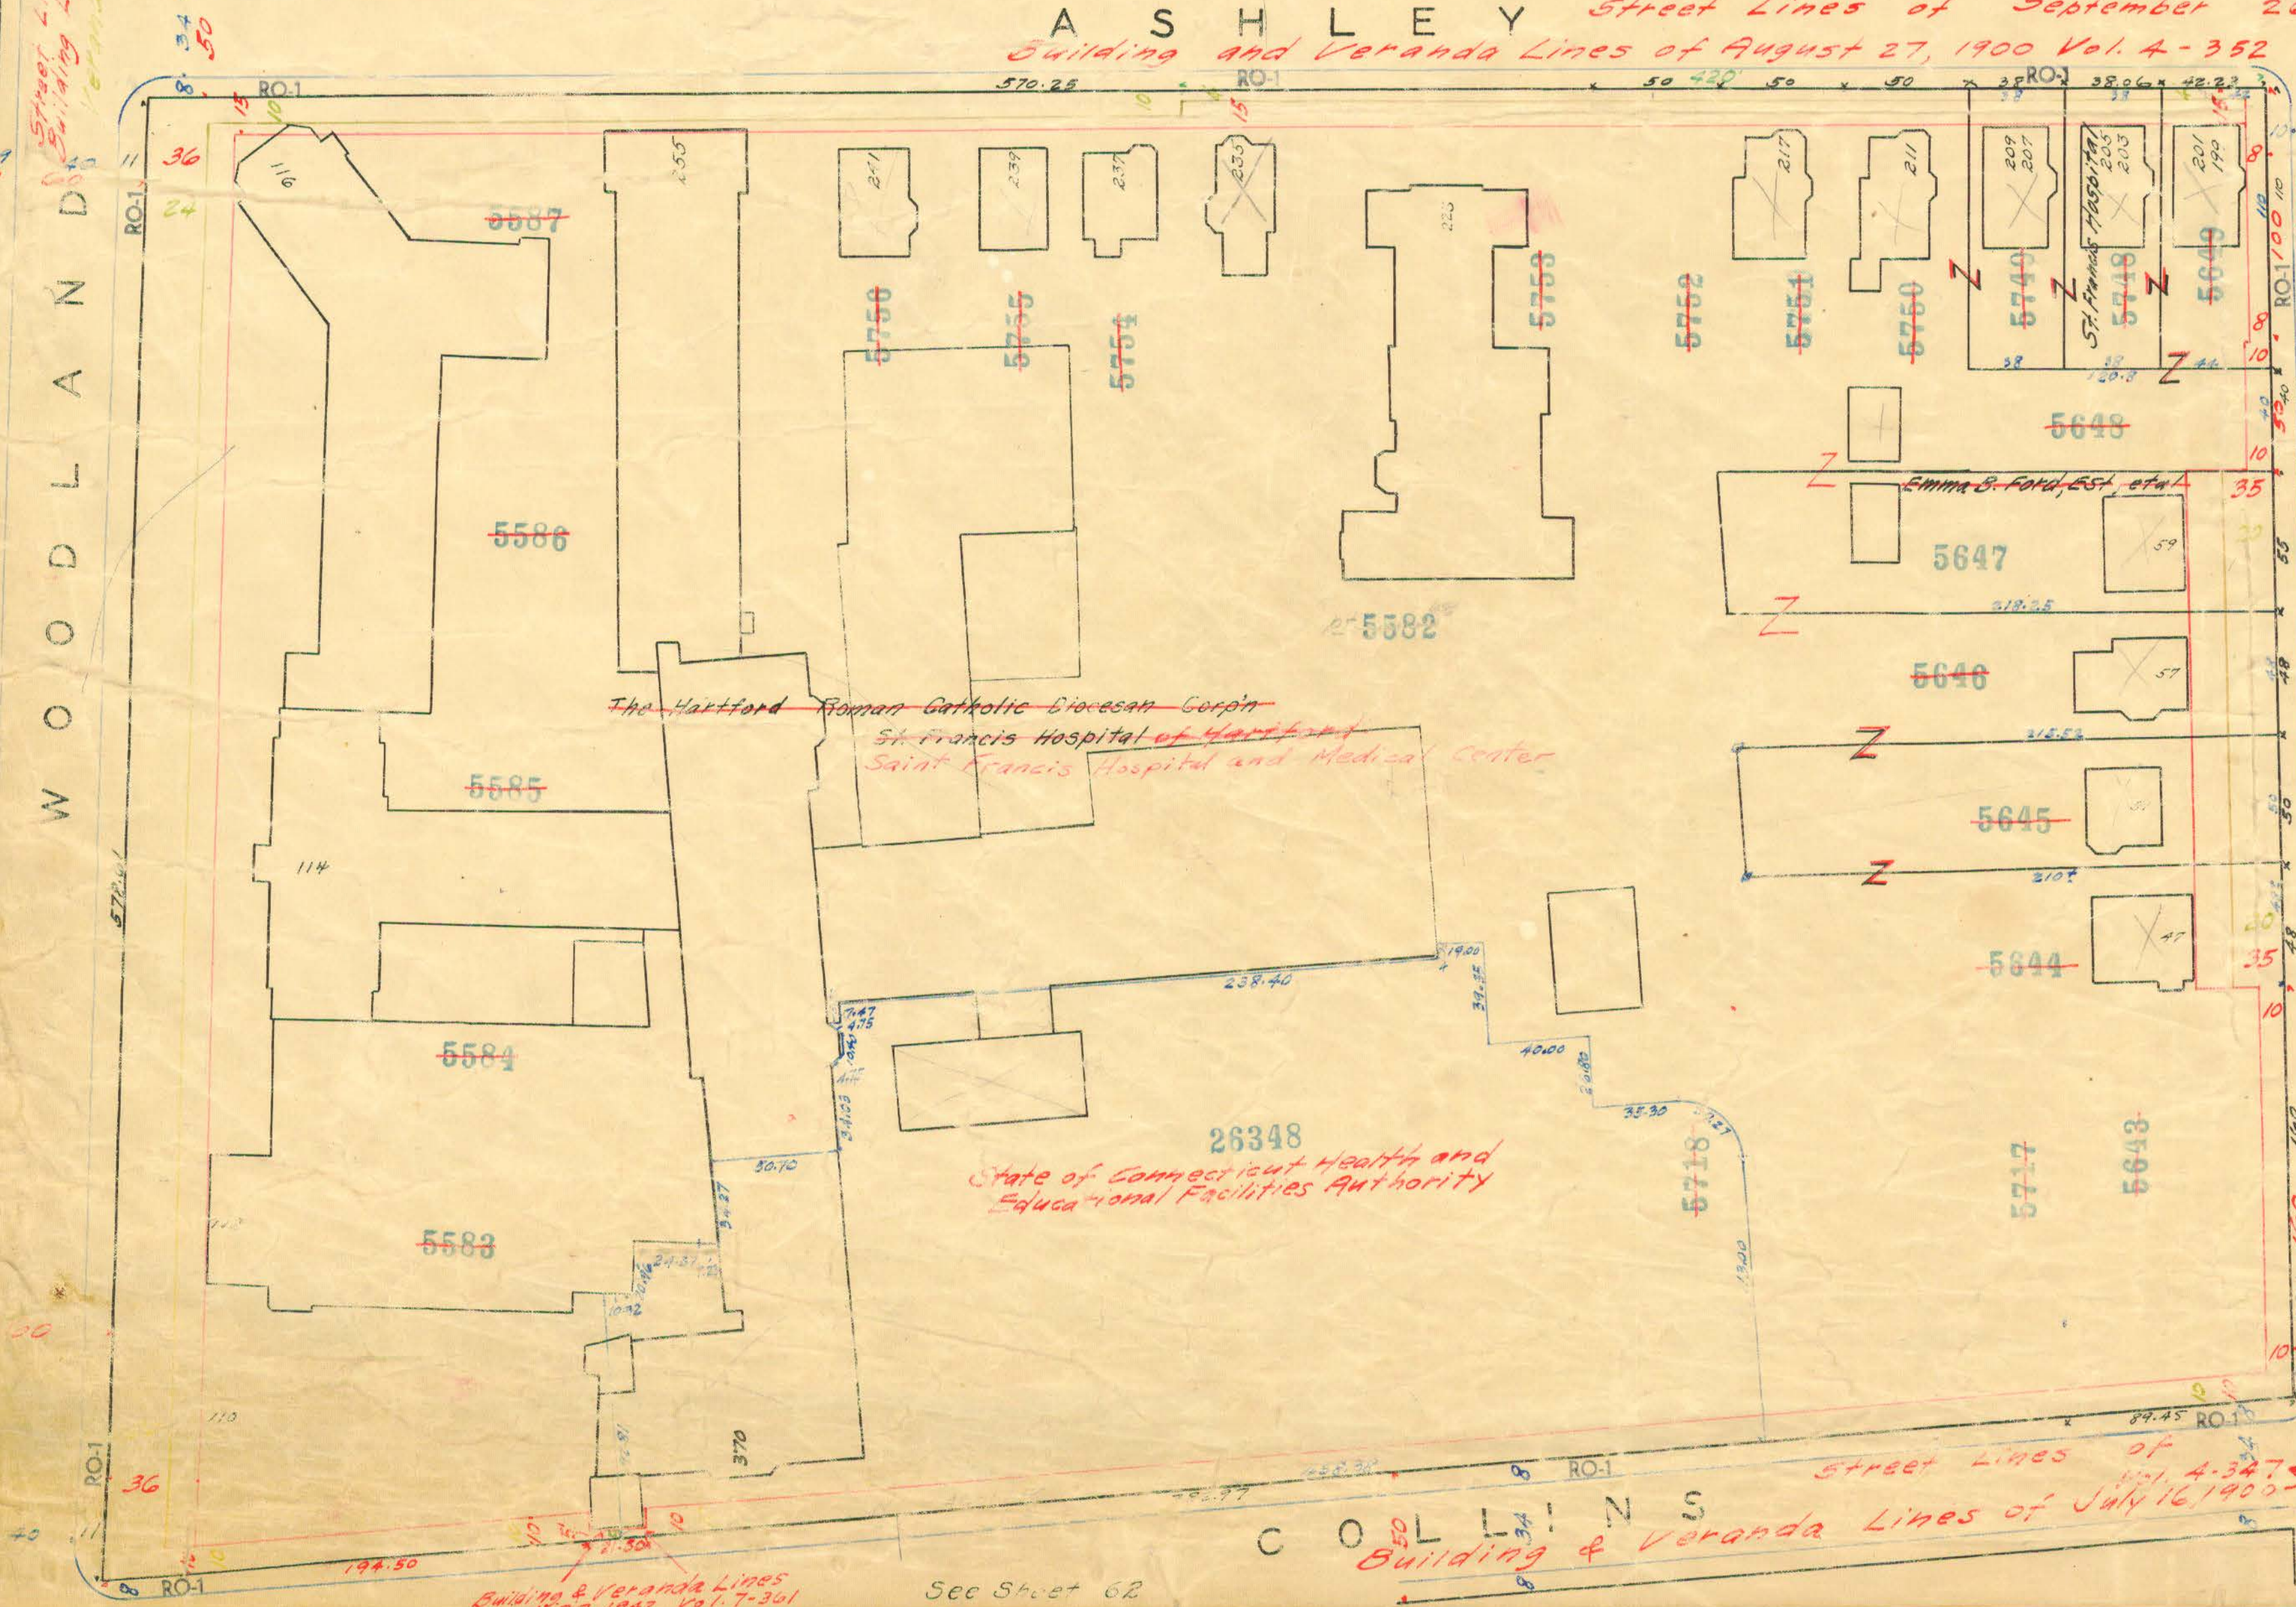
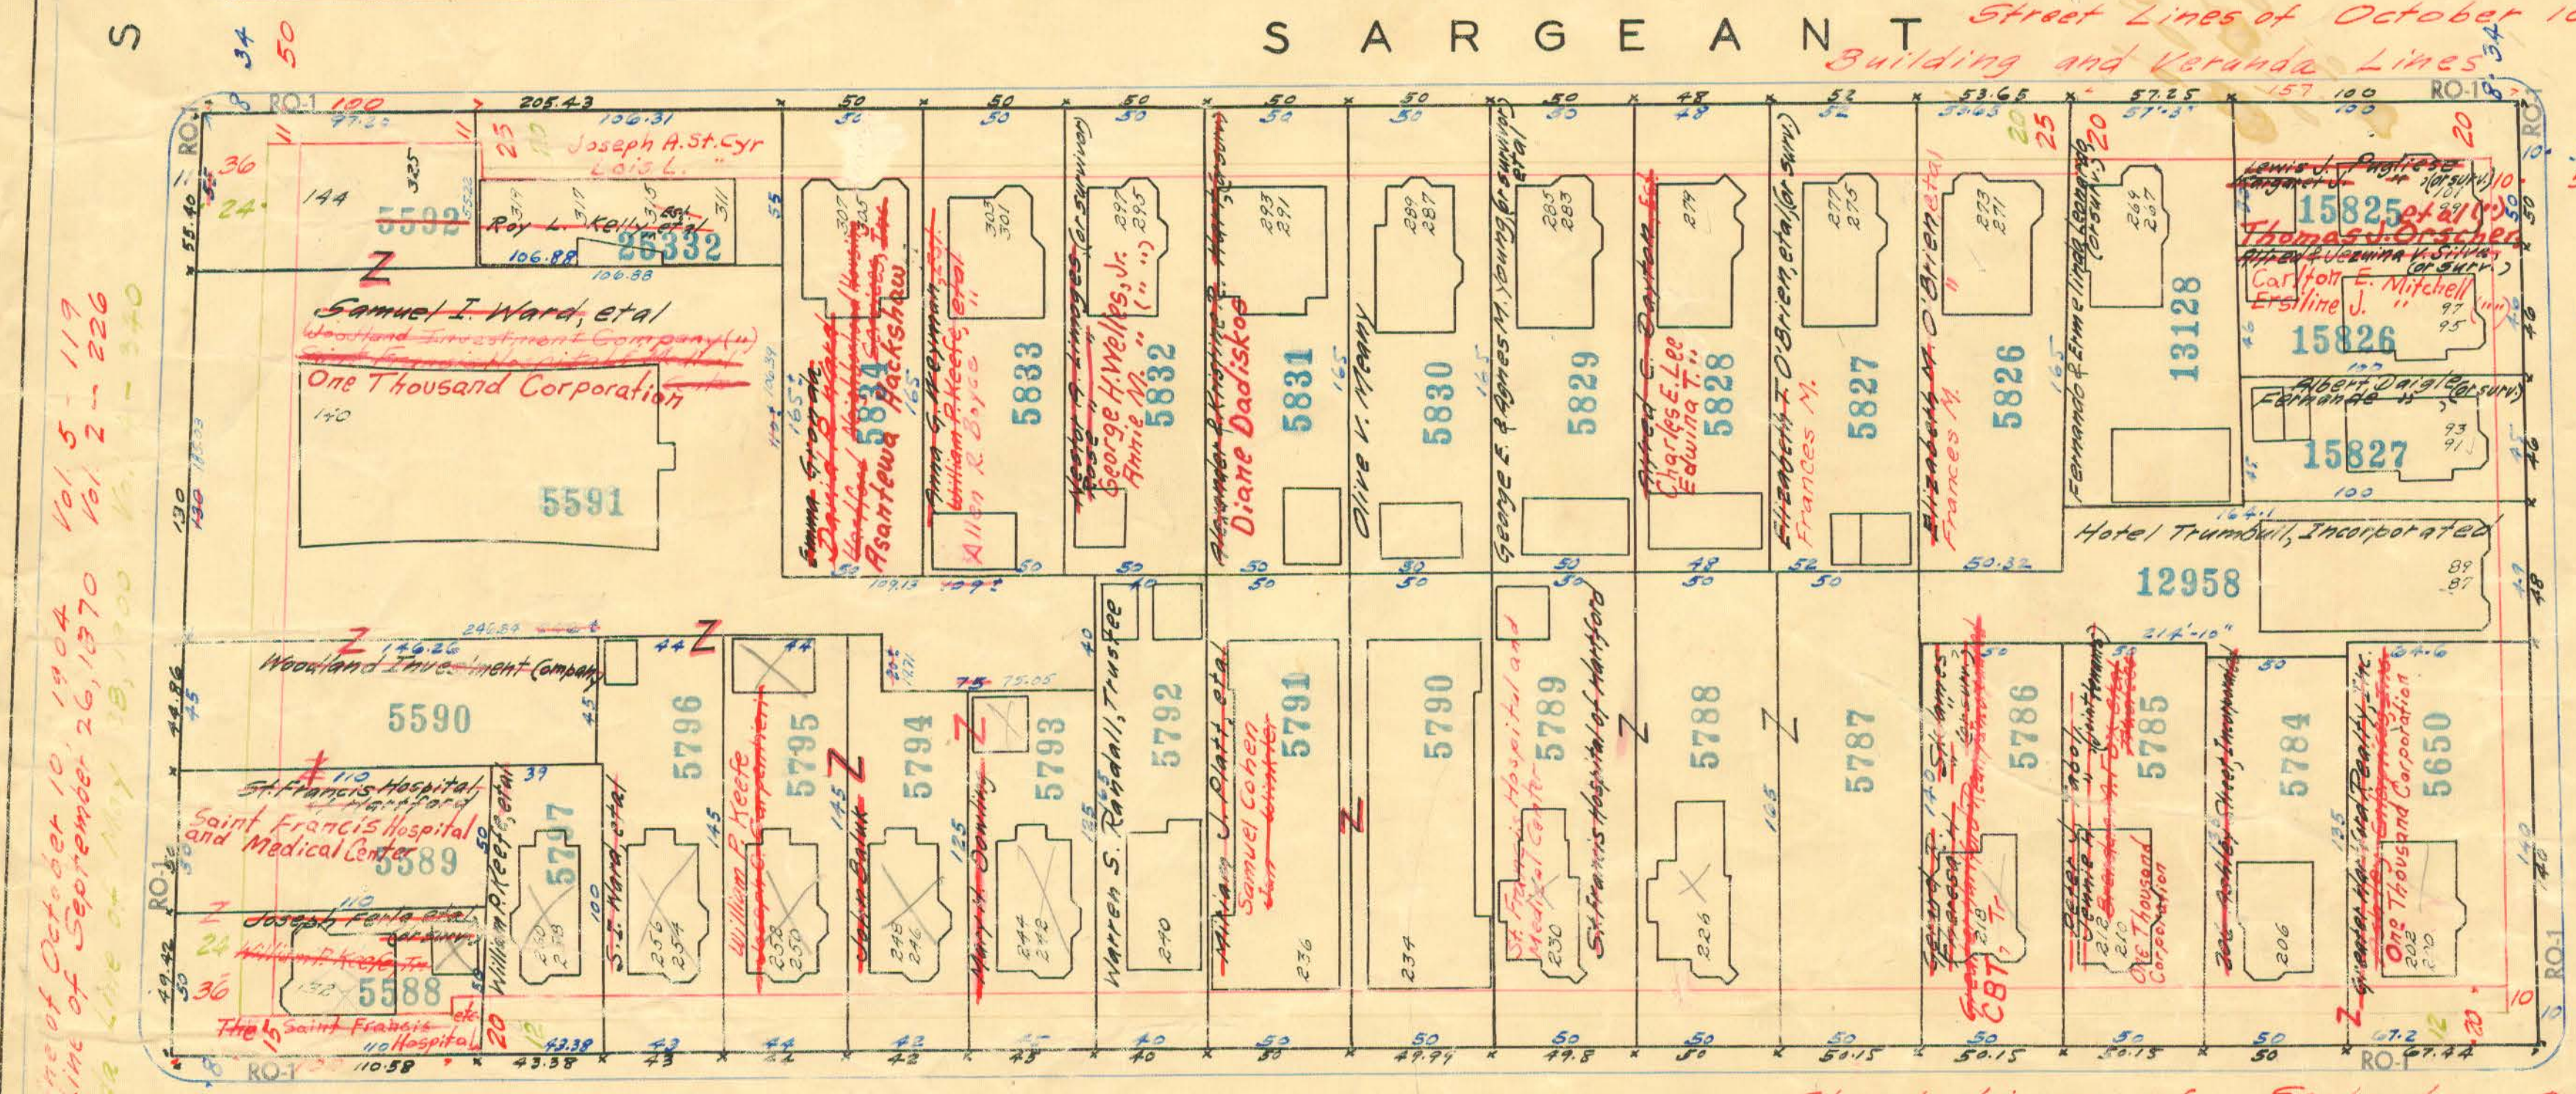


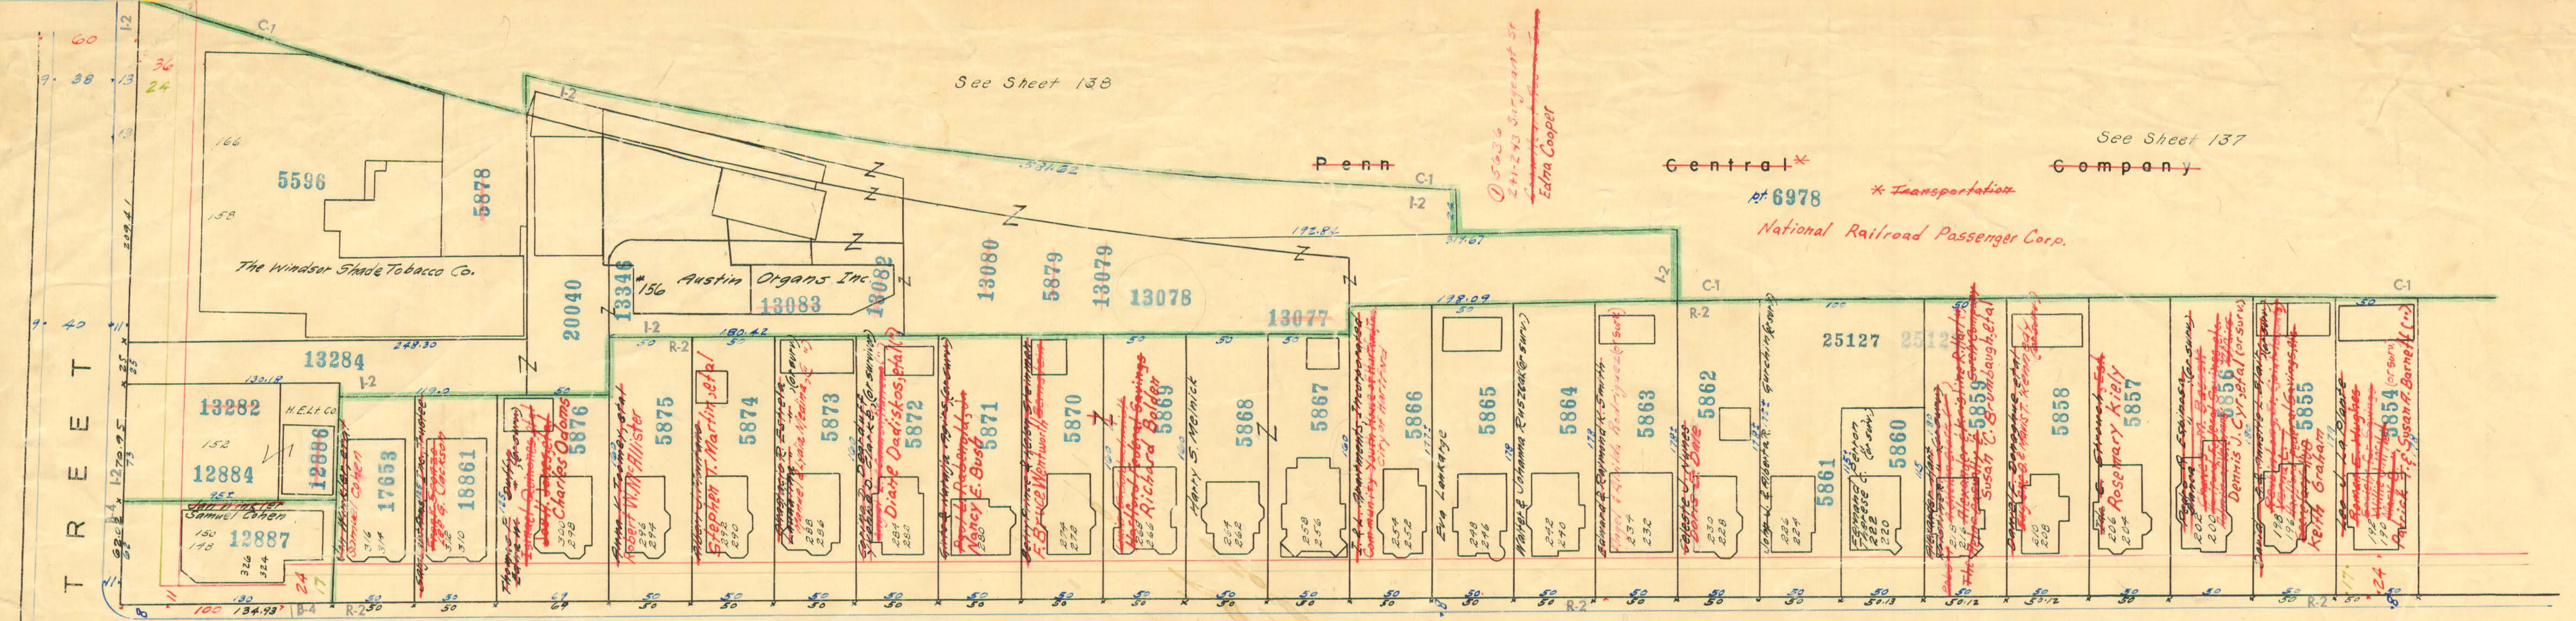

See Sheet 59