


 MAY 5, 1900 Vol. 4-340

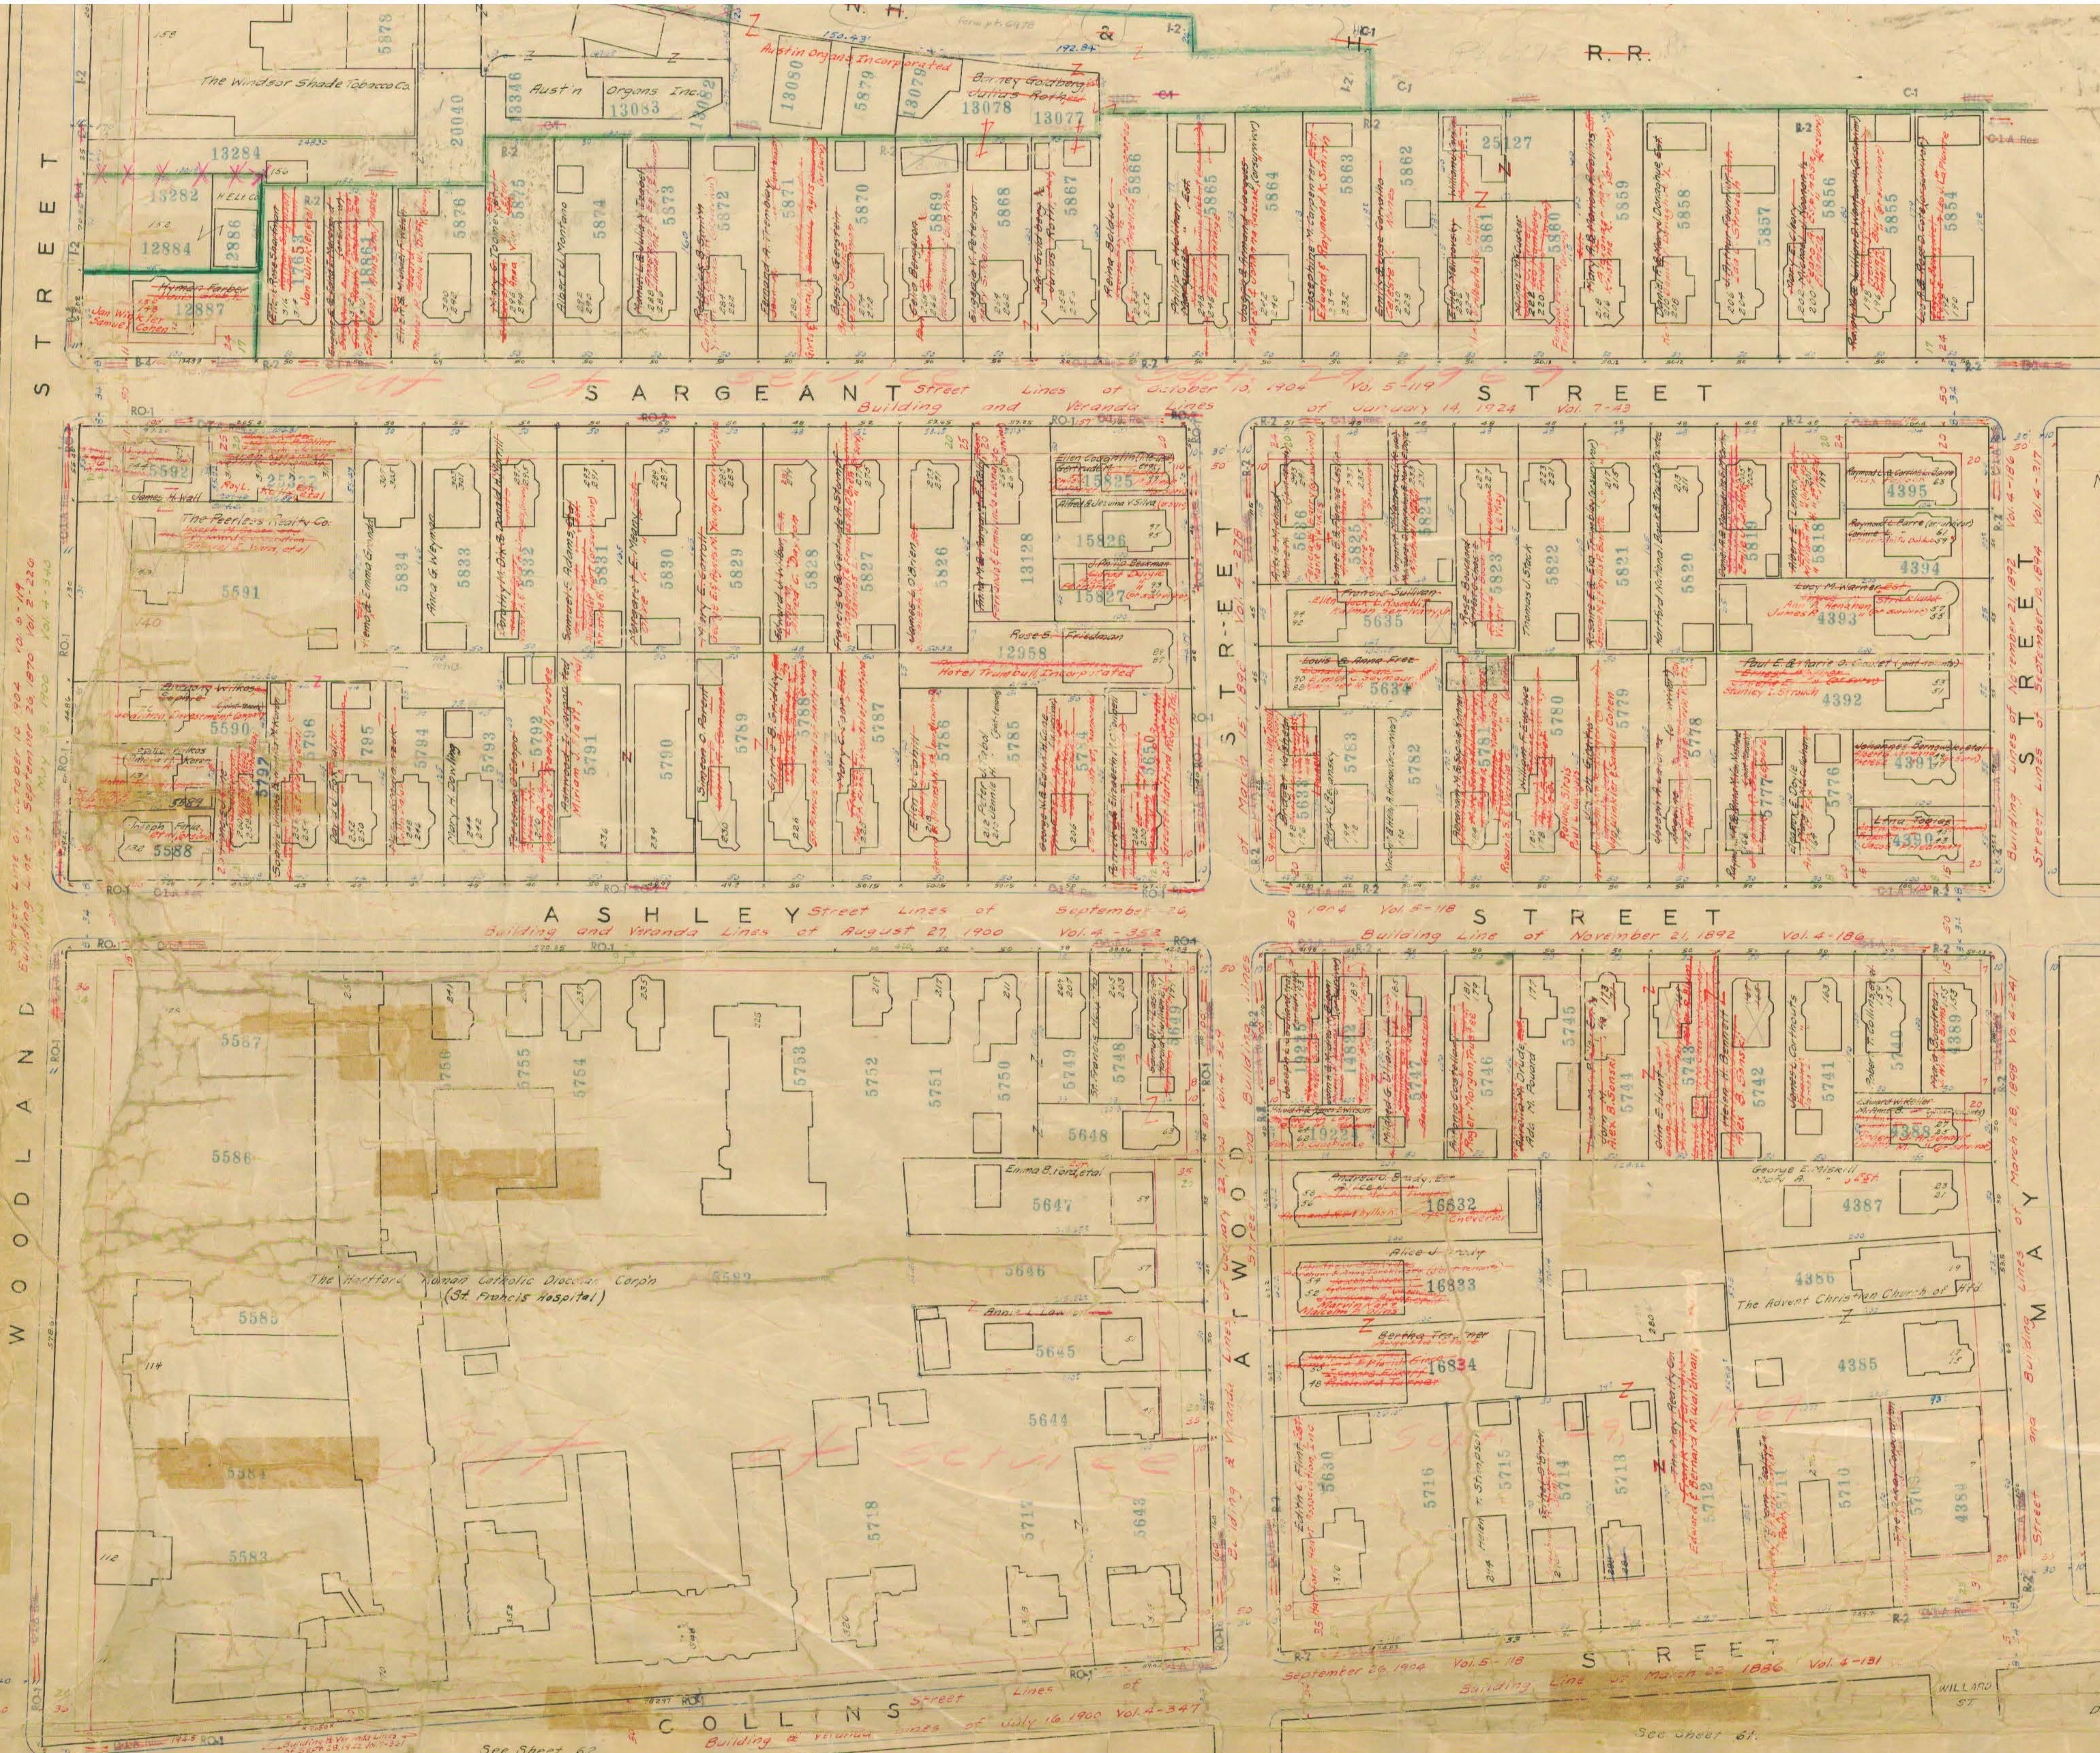

Building Lines of November 21, 1892 Vol. 4 - 186 30
 Street Lines of September 10, 1894 Vol. 4 - 217 10

5000