Out of Service Jan. 11-39

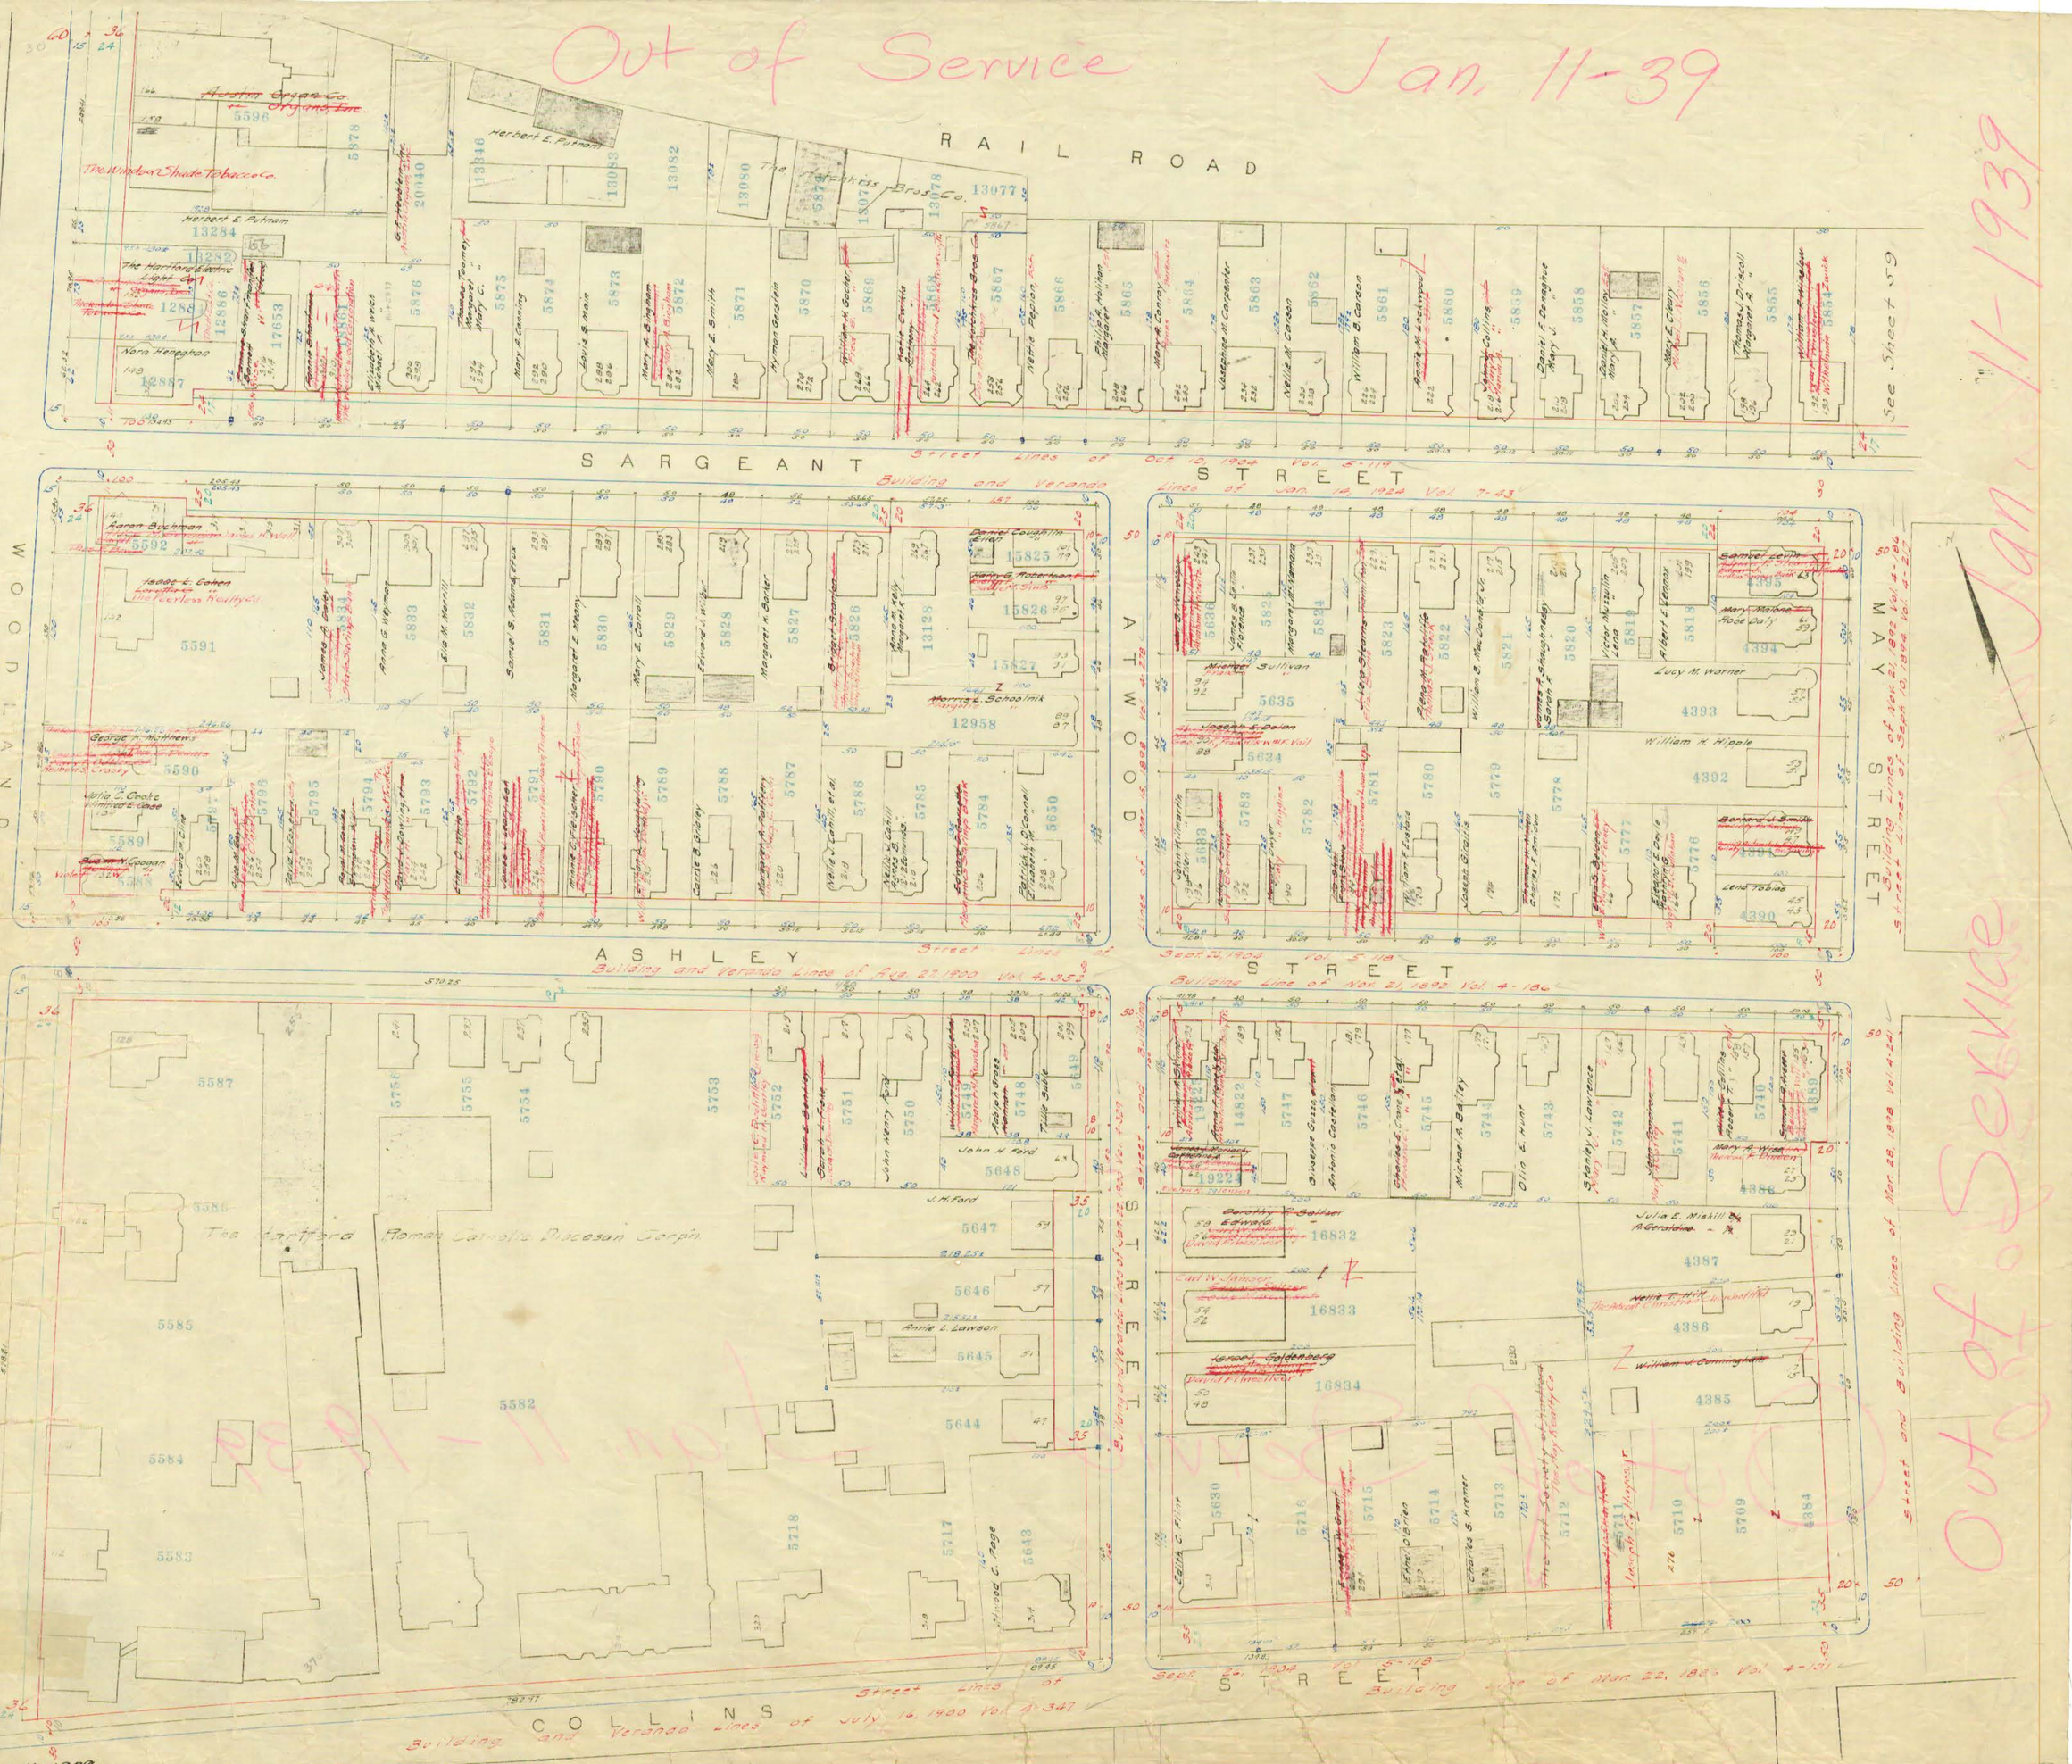


(60) Out of Service Jan. 11-1939

(60)