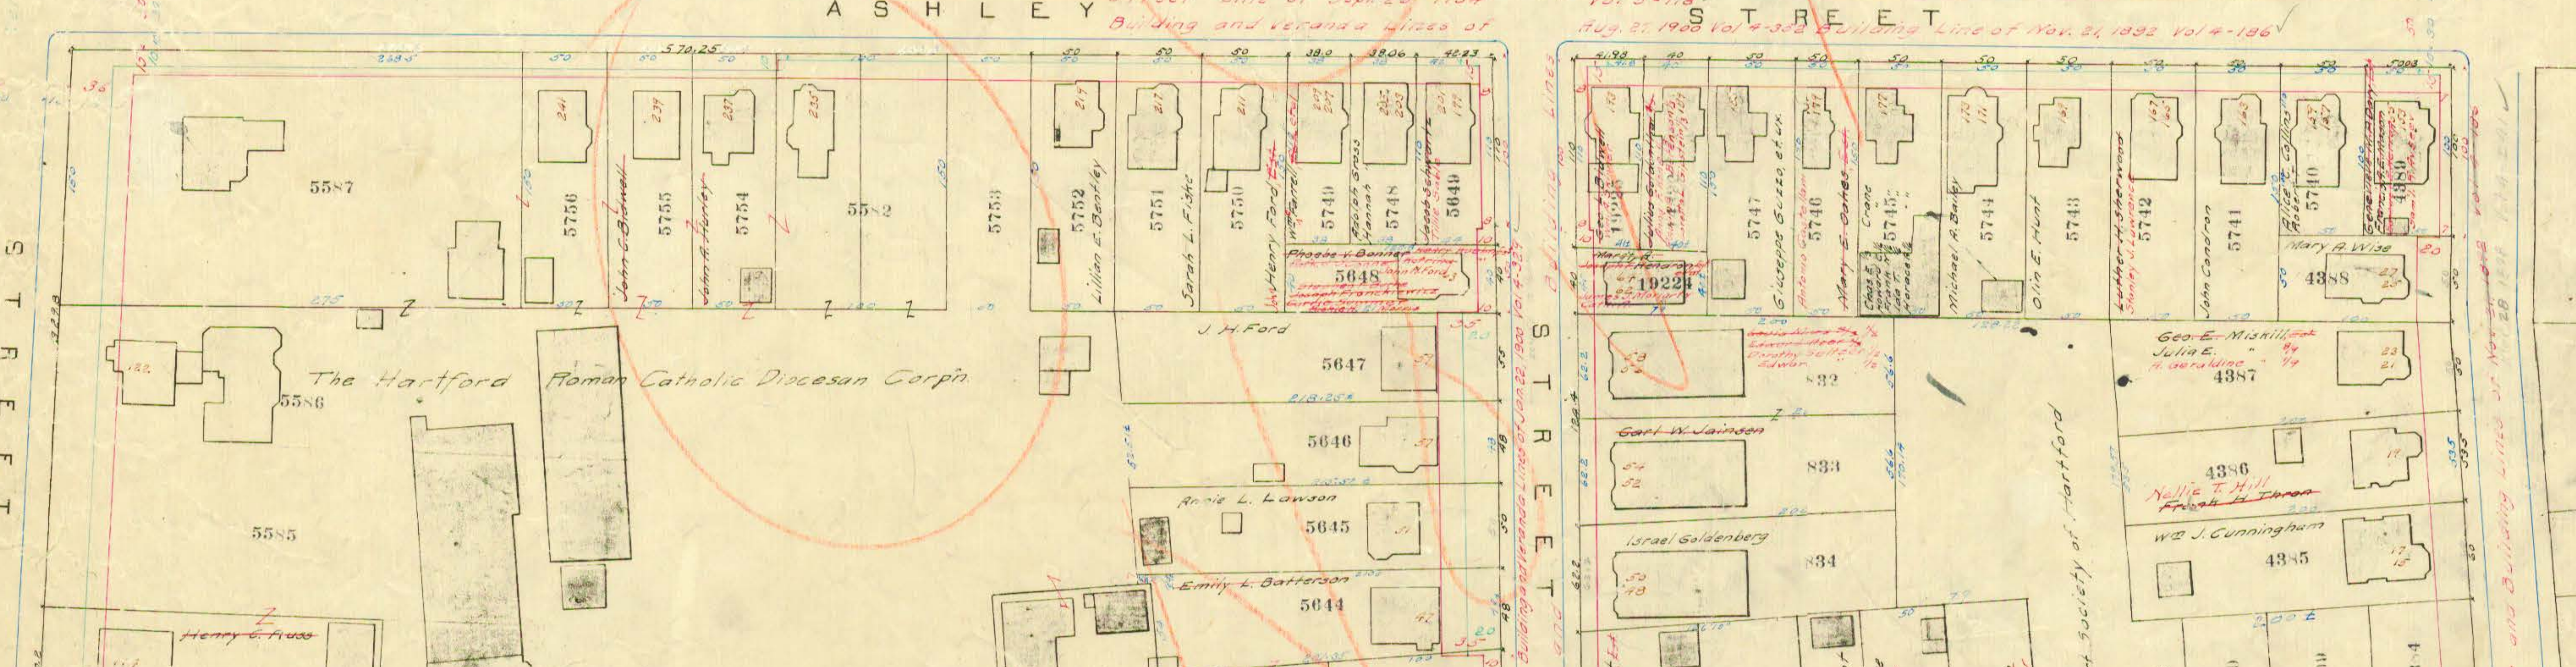
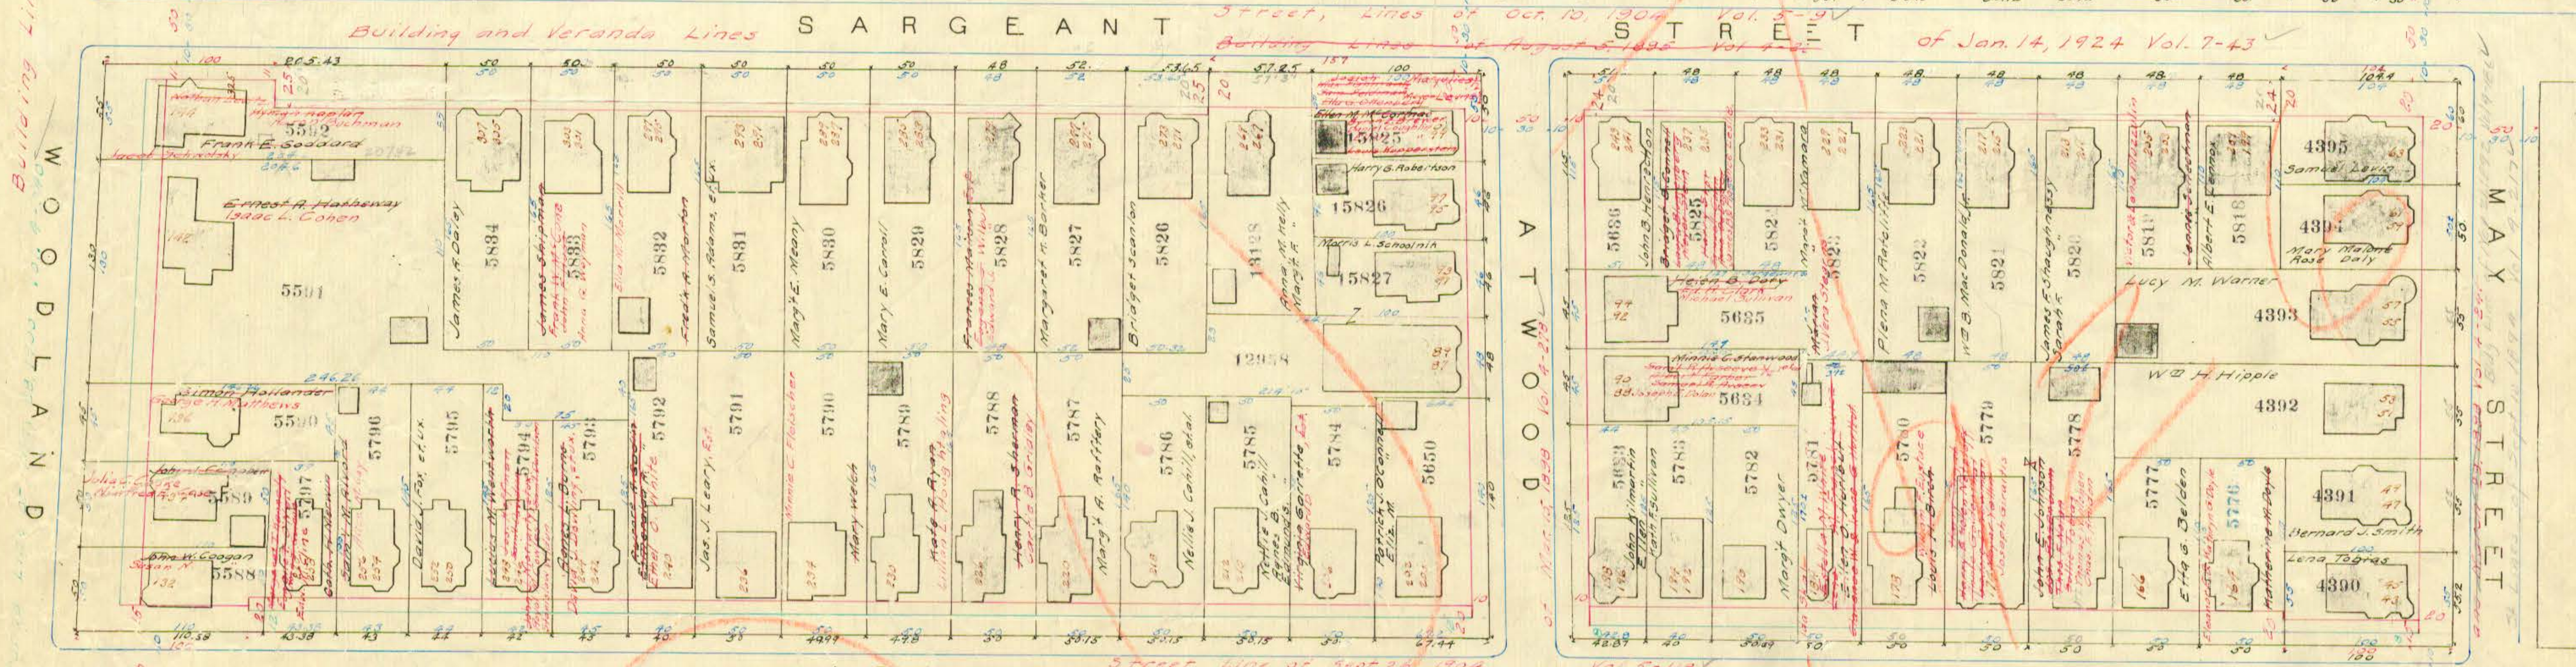
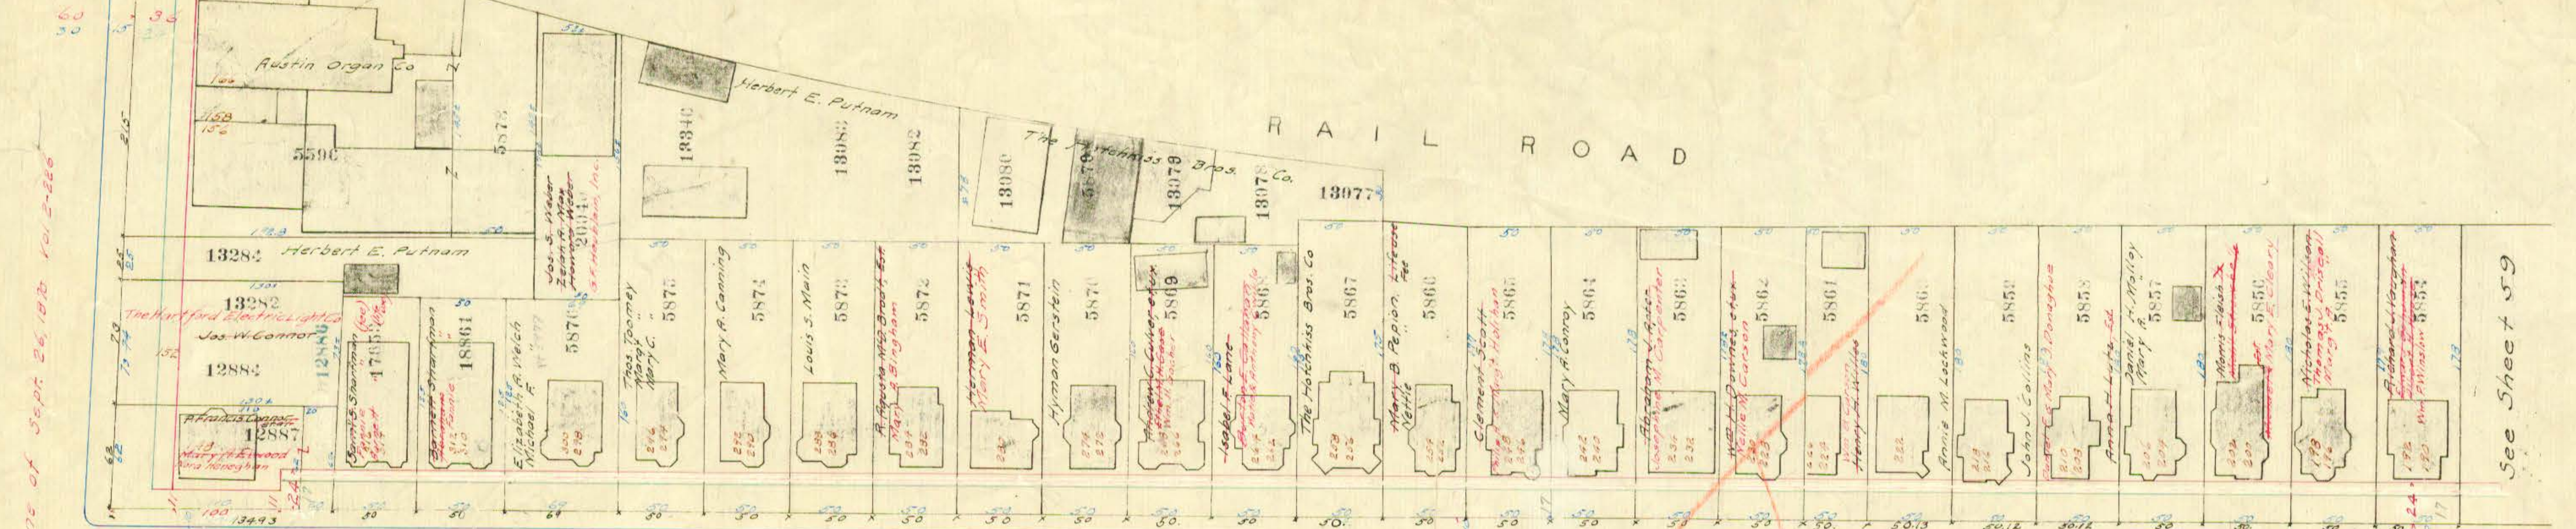


See Sheet 59

MAY STREET



