



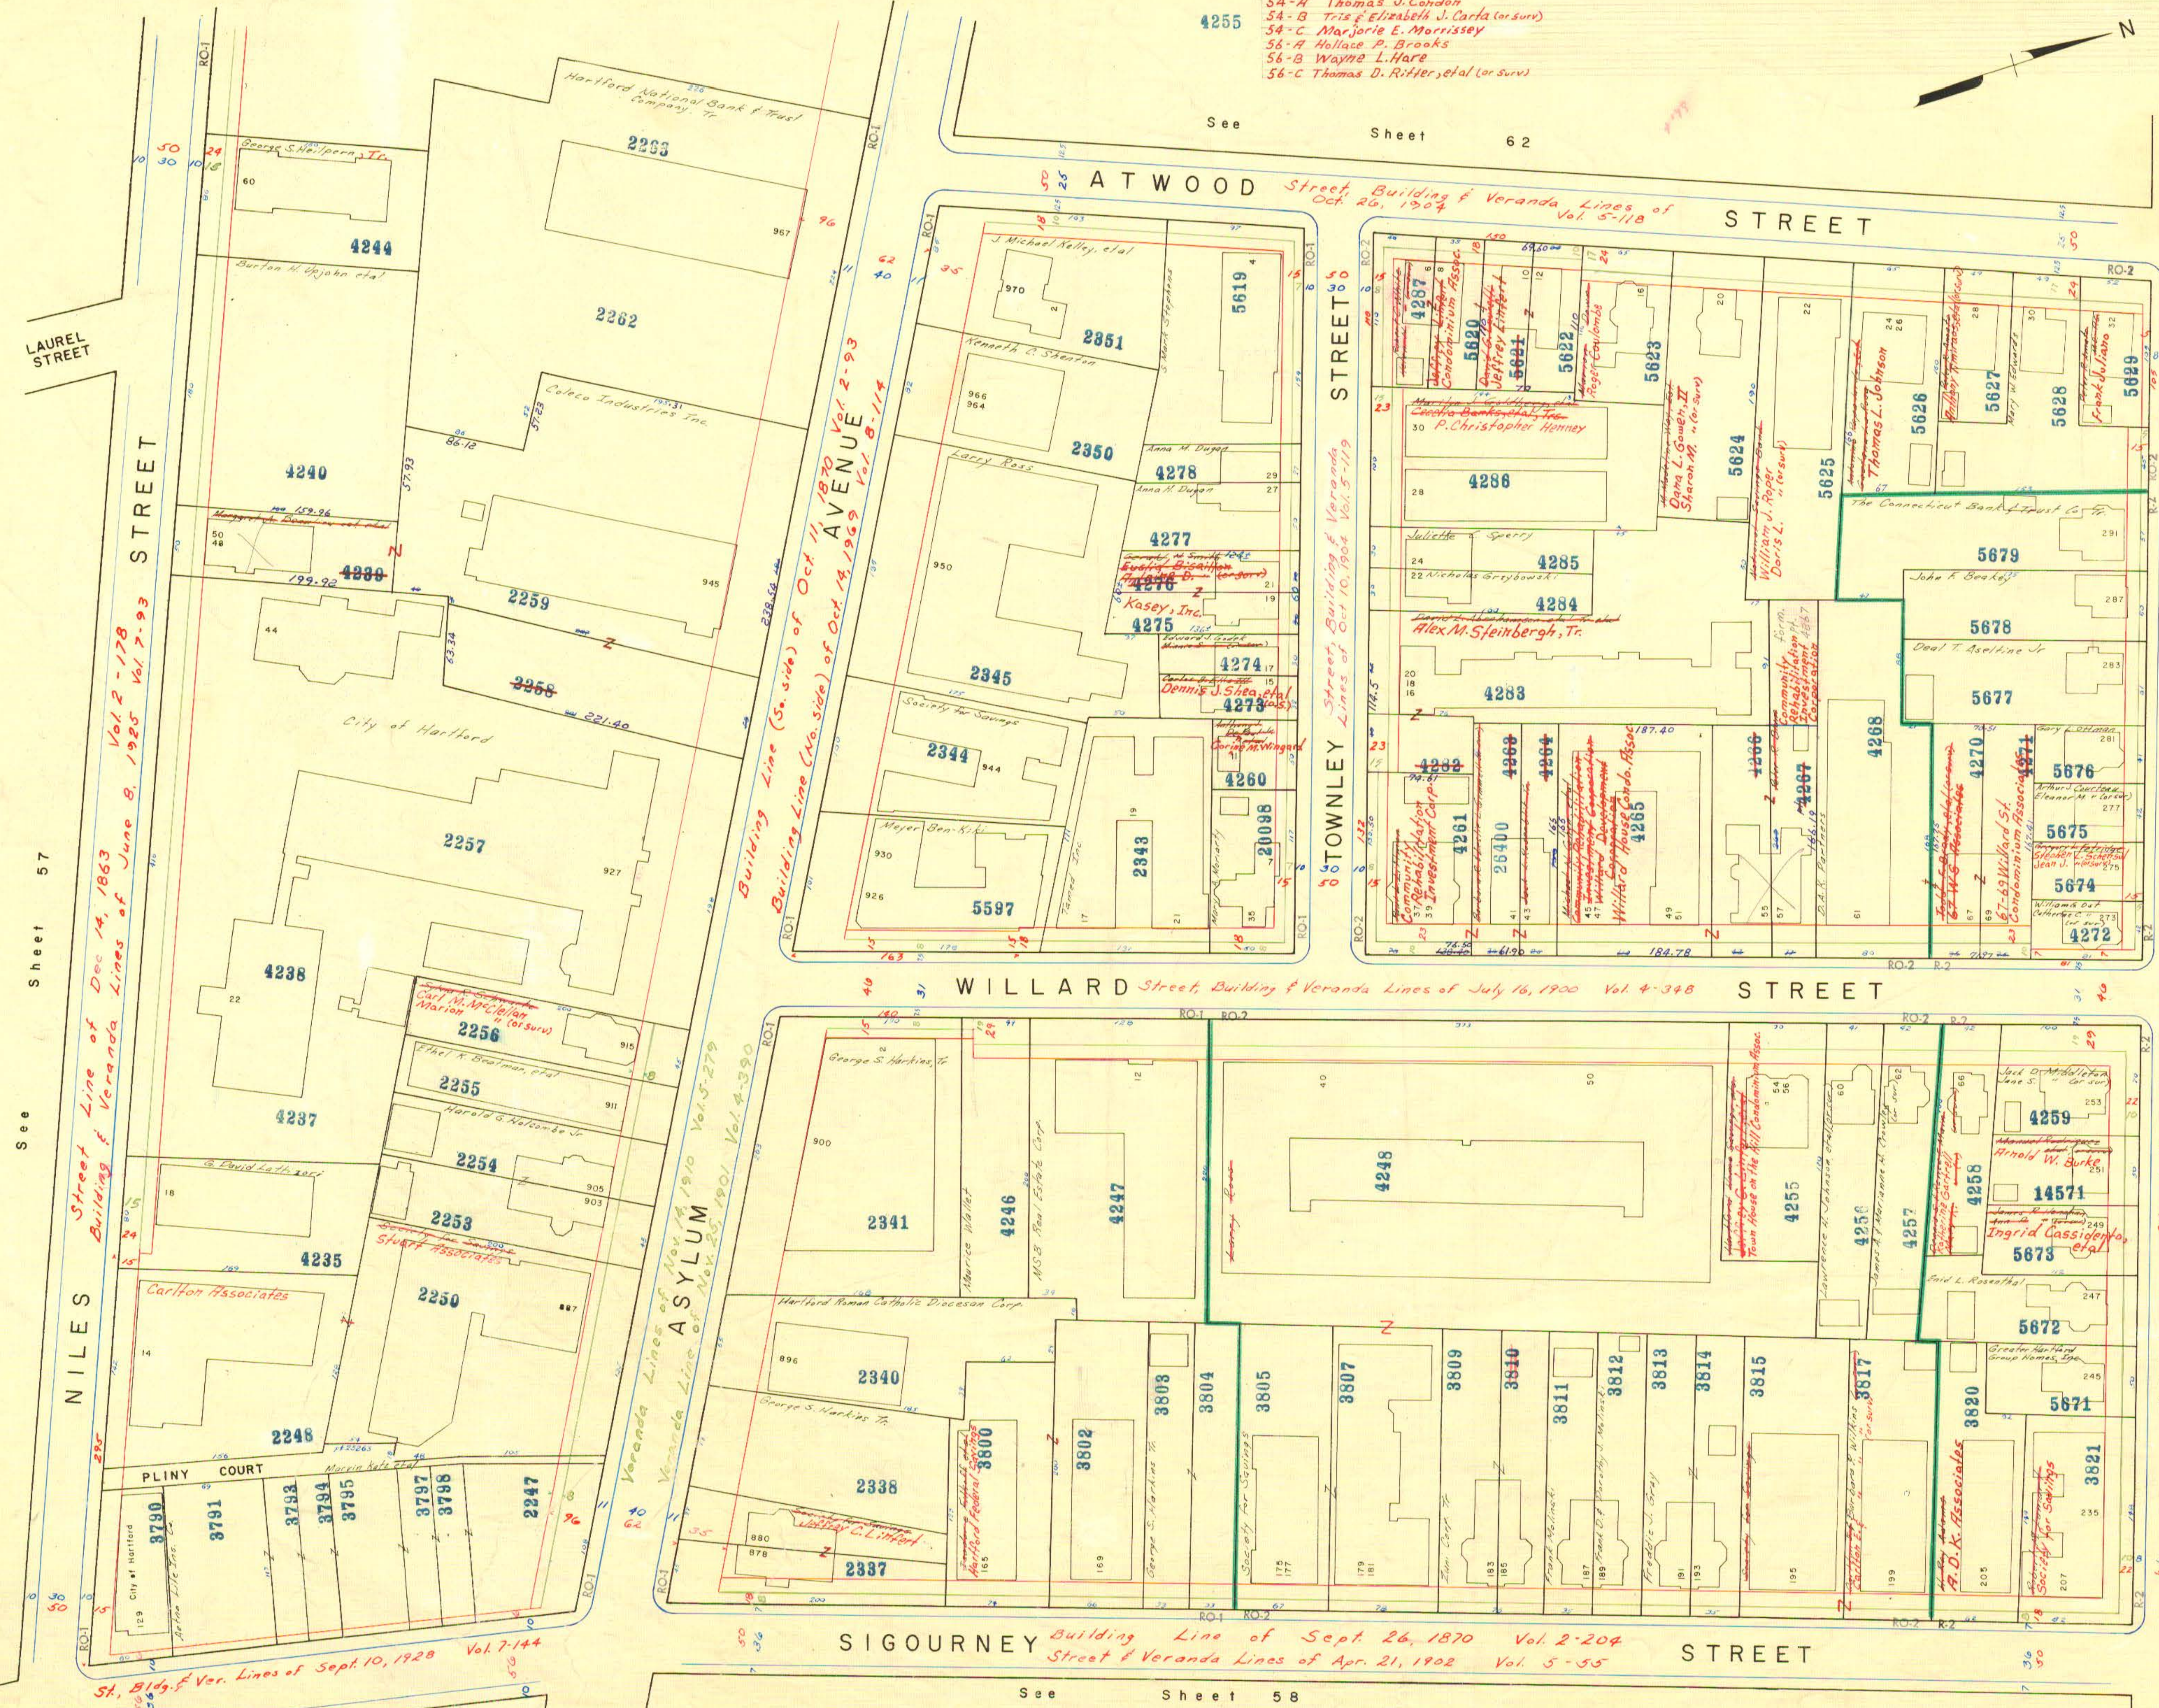

54-A Thomas J. Condon
54-B Tris & Elizabeth J. Carls (or surv)
54-C Marjorie E. Morrissey
56-A Wallace P. Brooks
56-B Wayne L. Hare
56-C Thomas D. Rafter, et al (or surv)

See Sheet 62

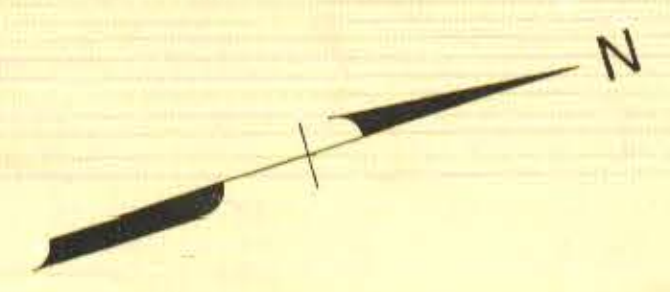

See Sheet 57

See Sheet 60

MAY STREET