


See Sheet 62

See Sheet 62

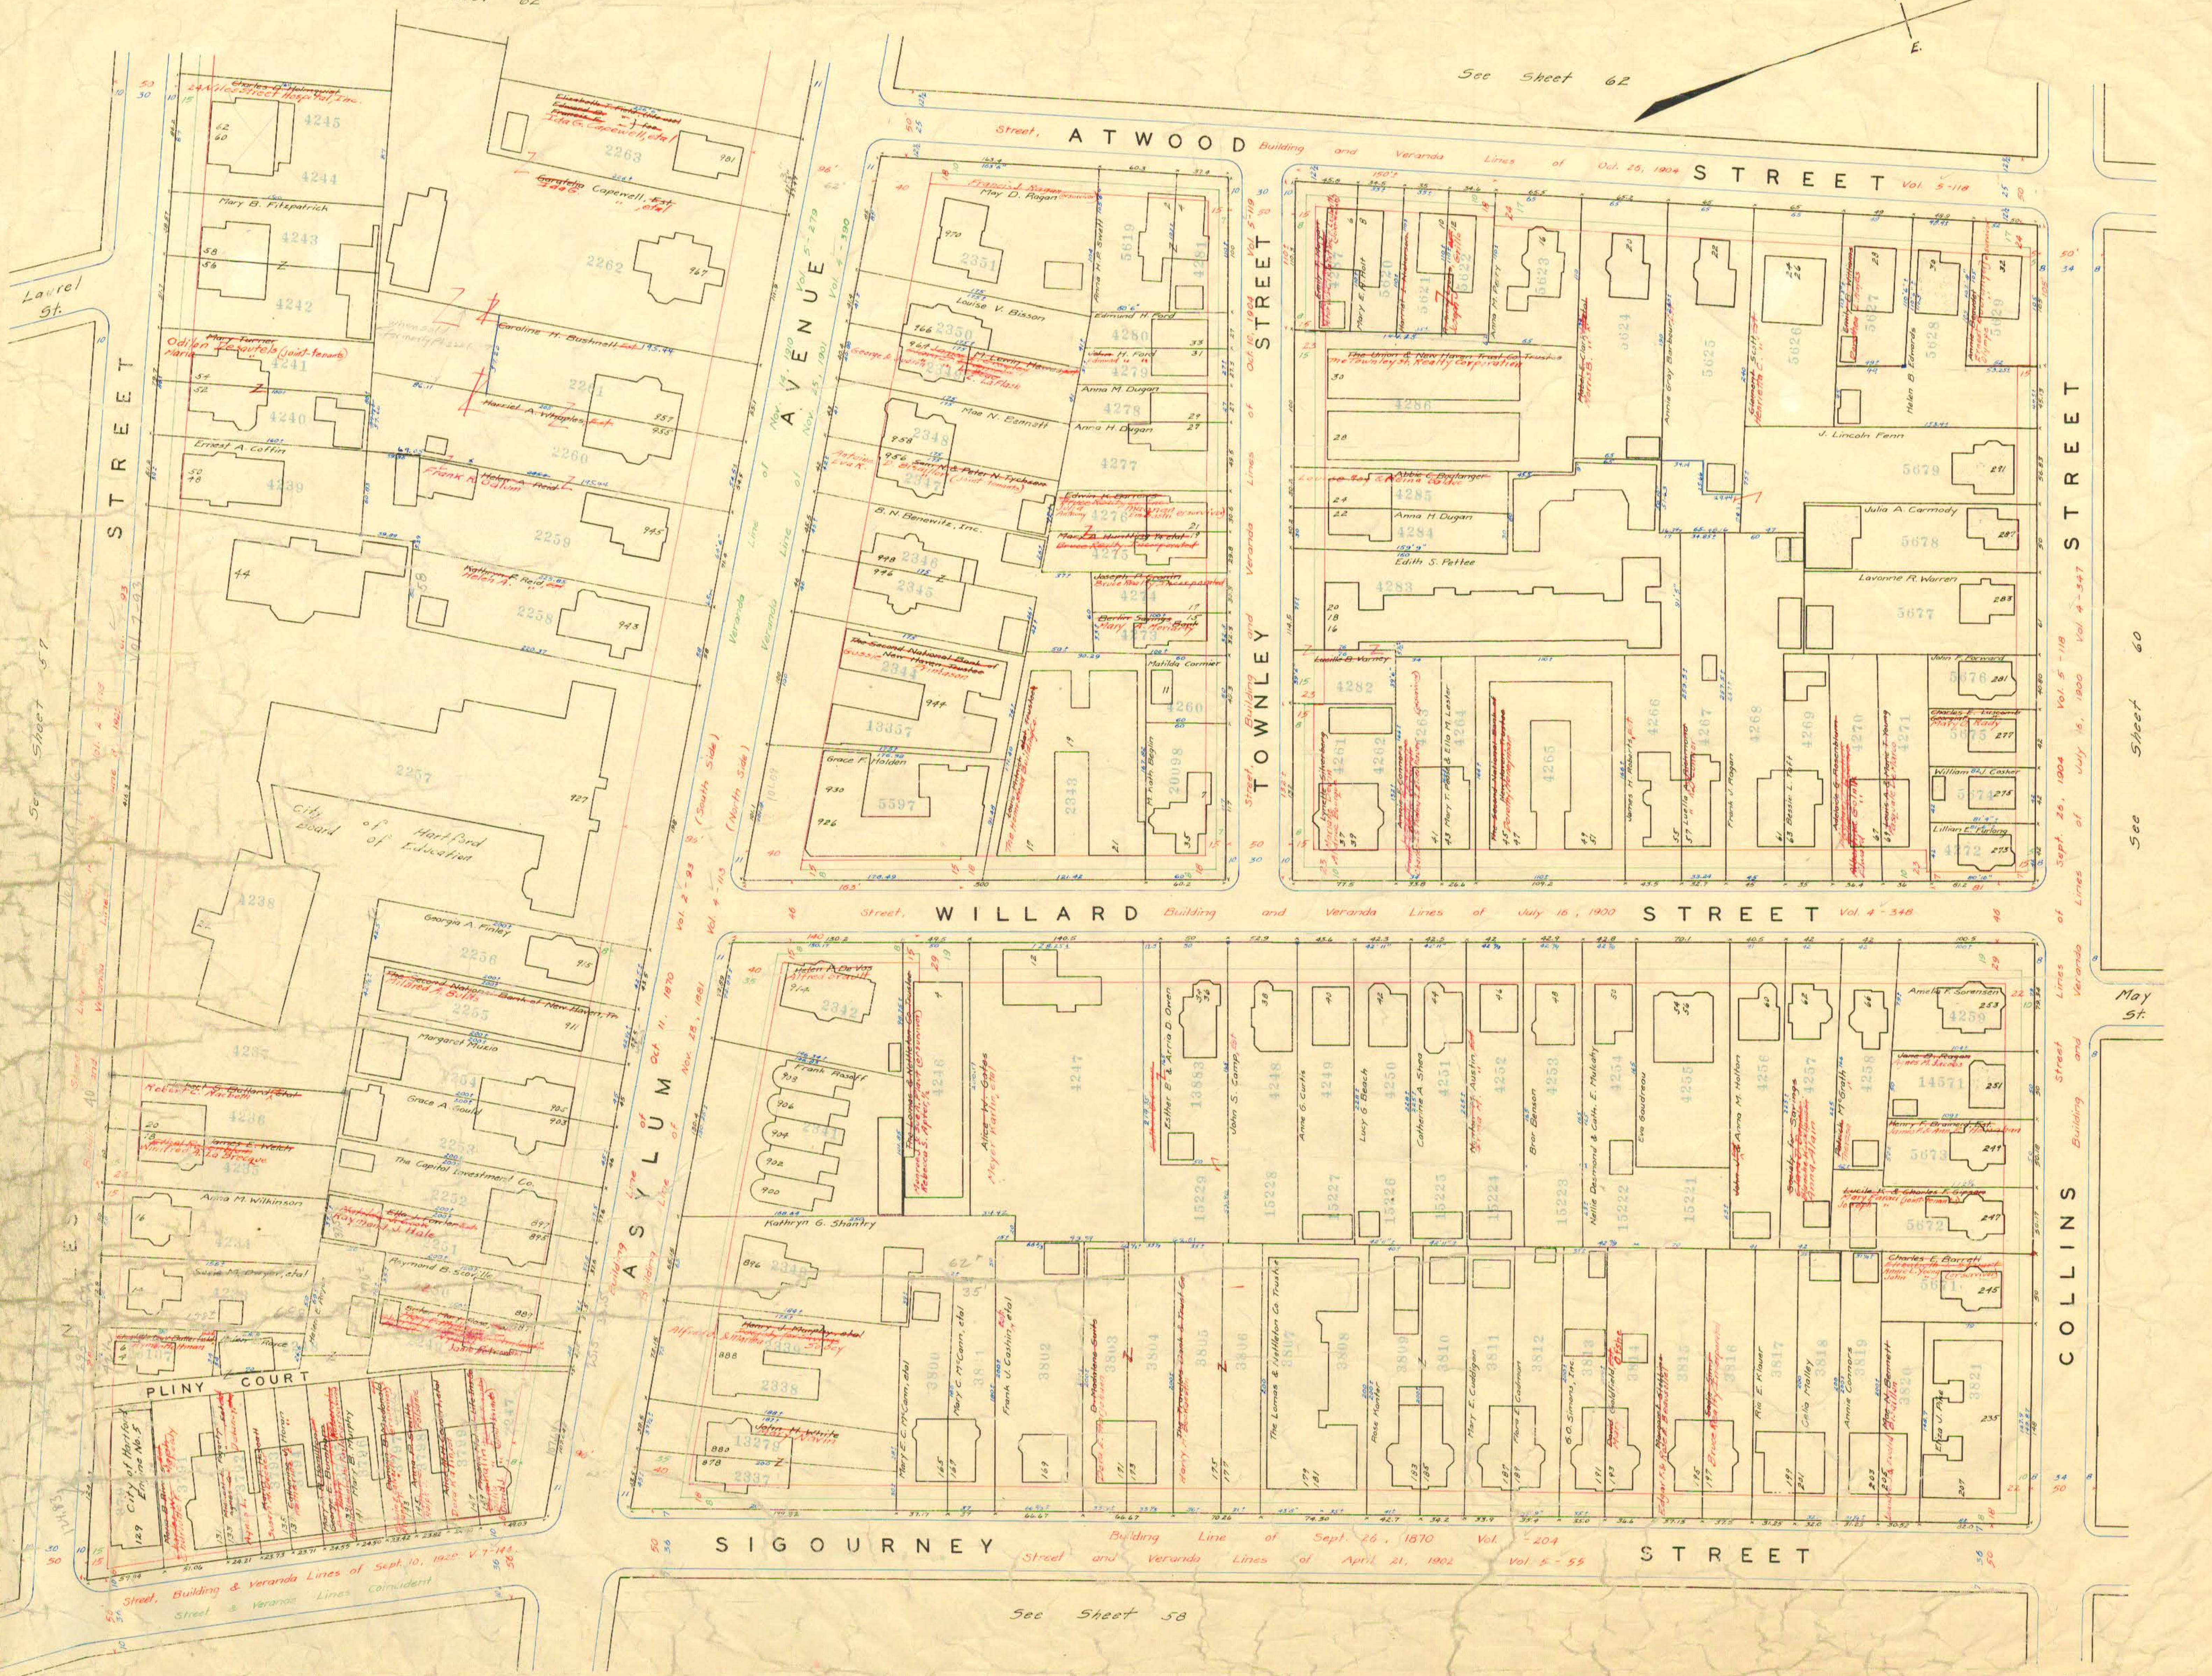

See Sheet 60

May St.