


Out of Service April 17-1940

See Sheet 58.

Service April-17-1940

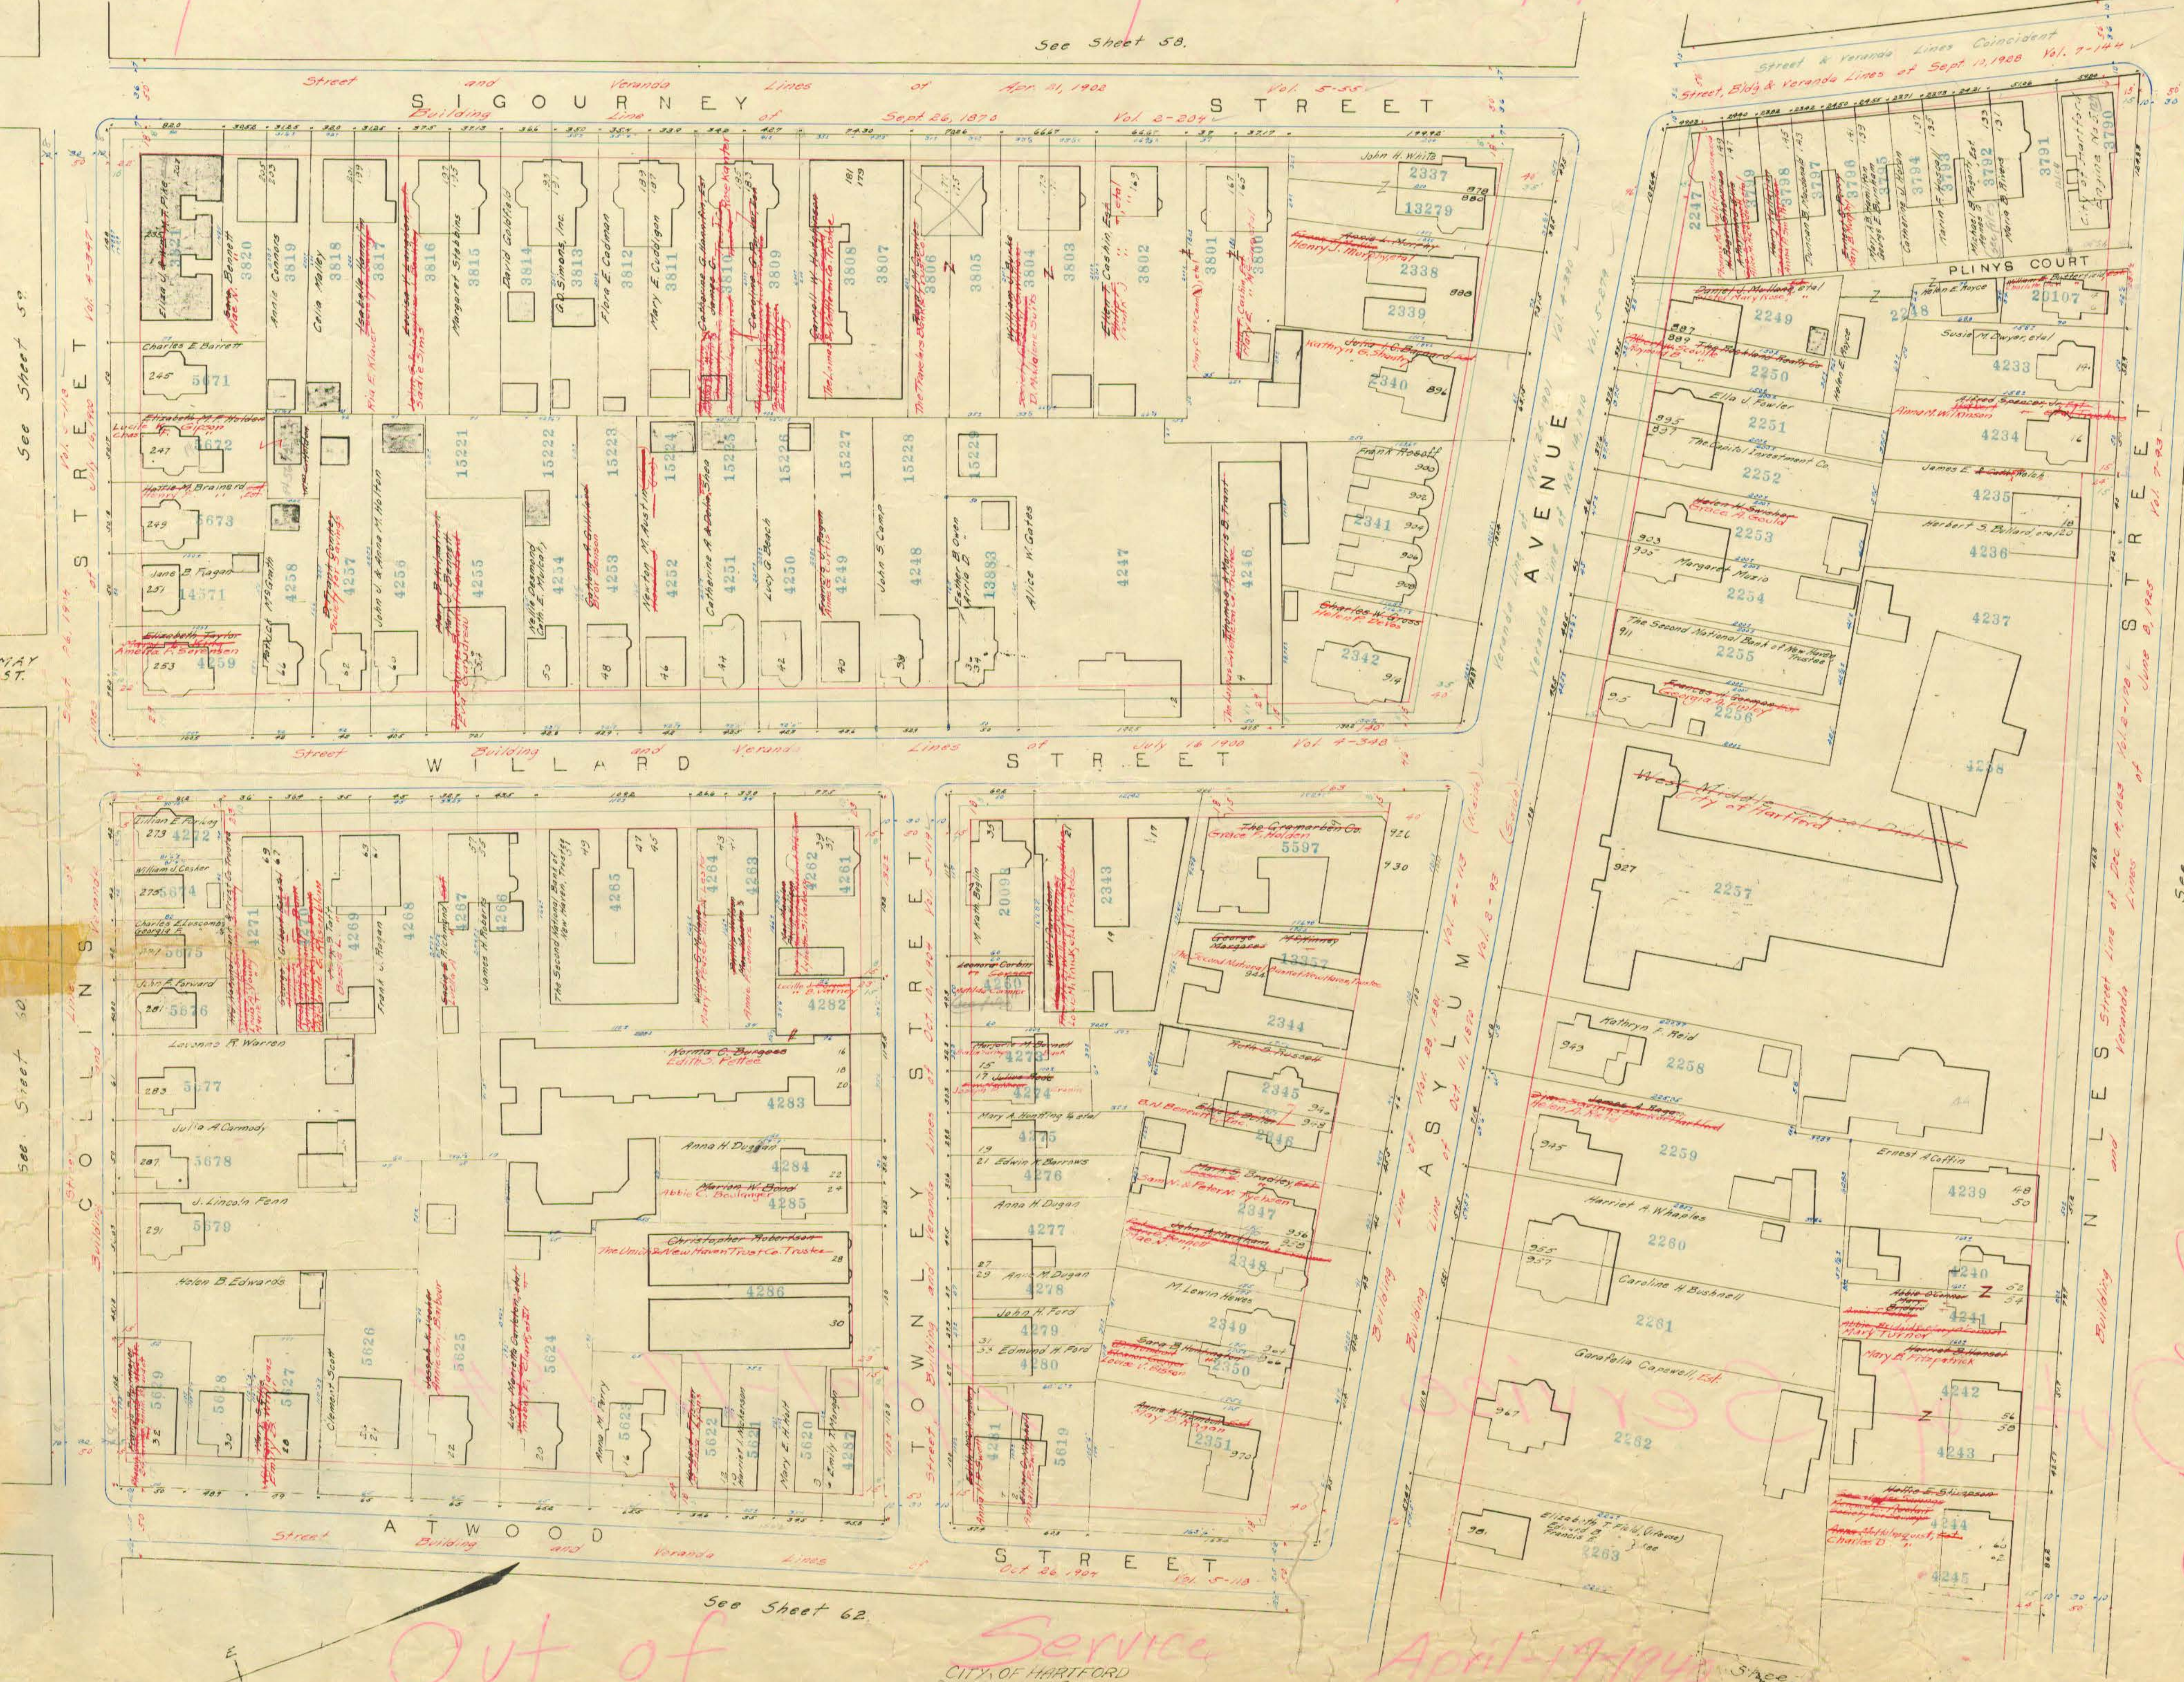

Out of Service April 17-1940