


Sept 26, 1904 Vol 5-118

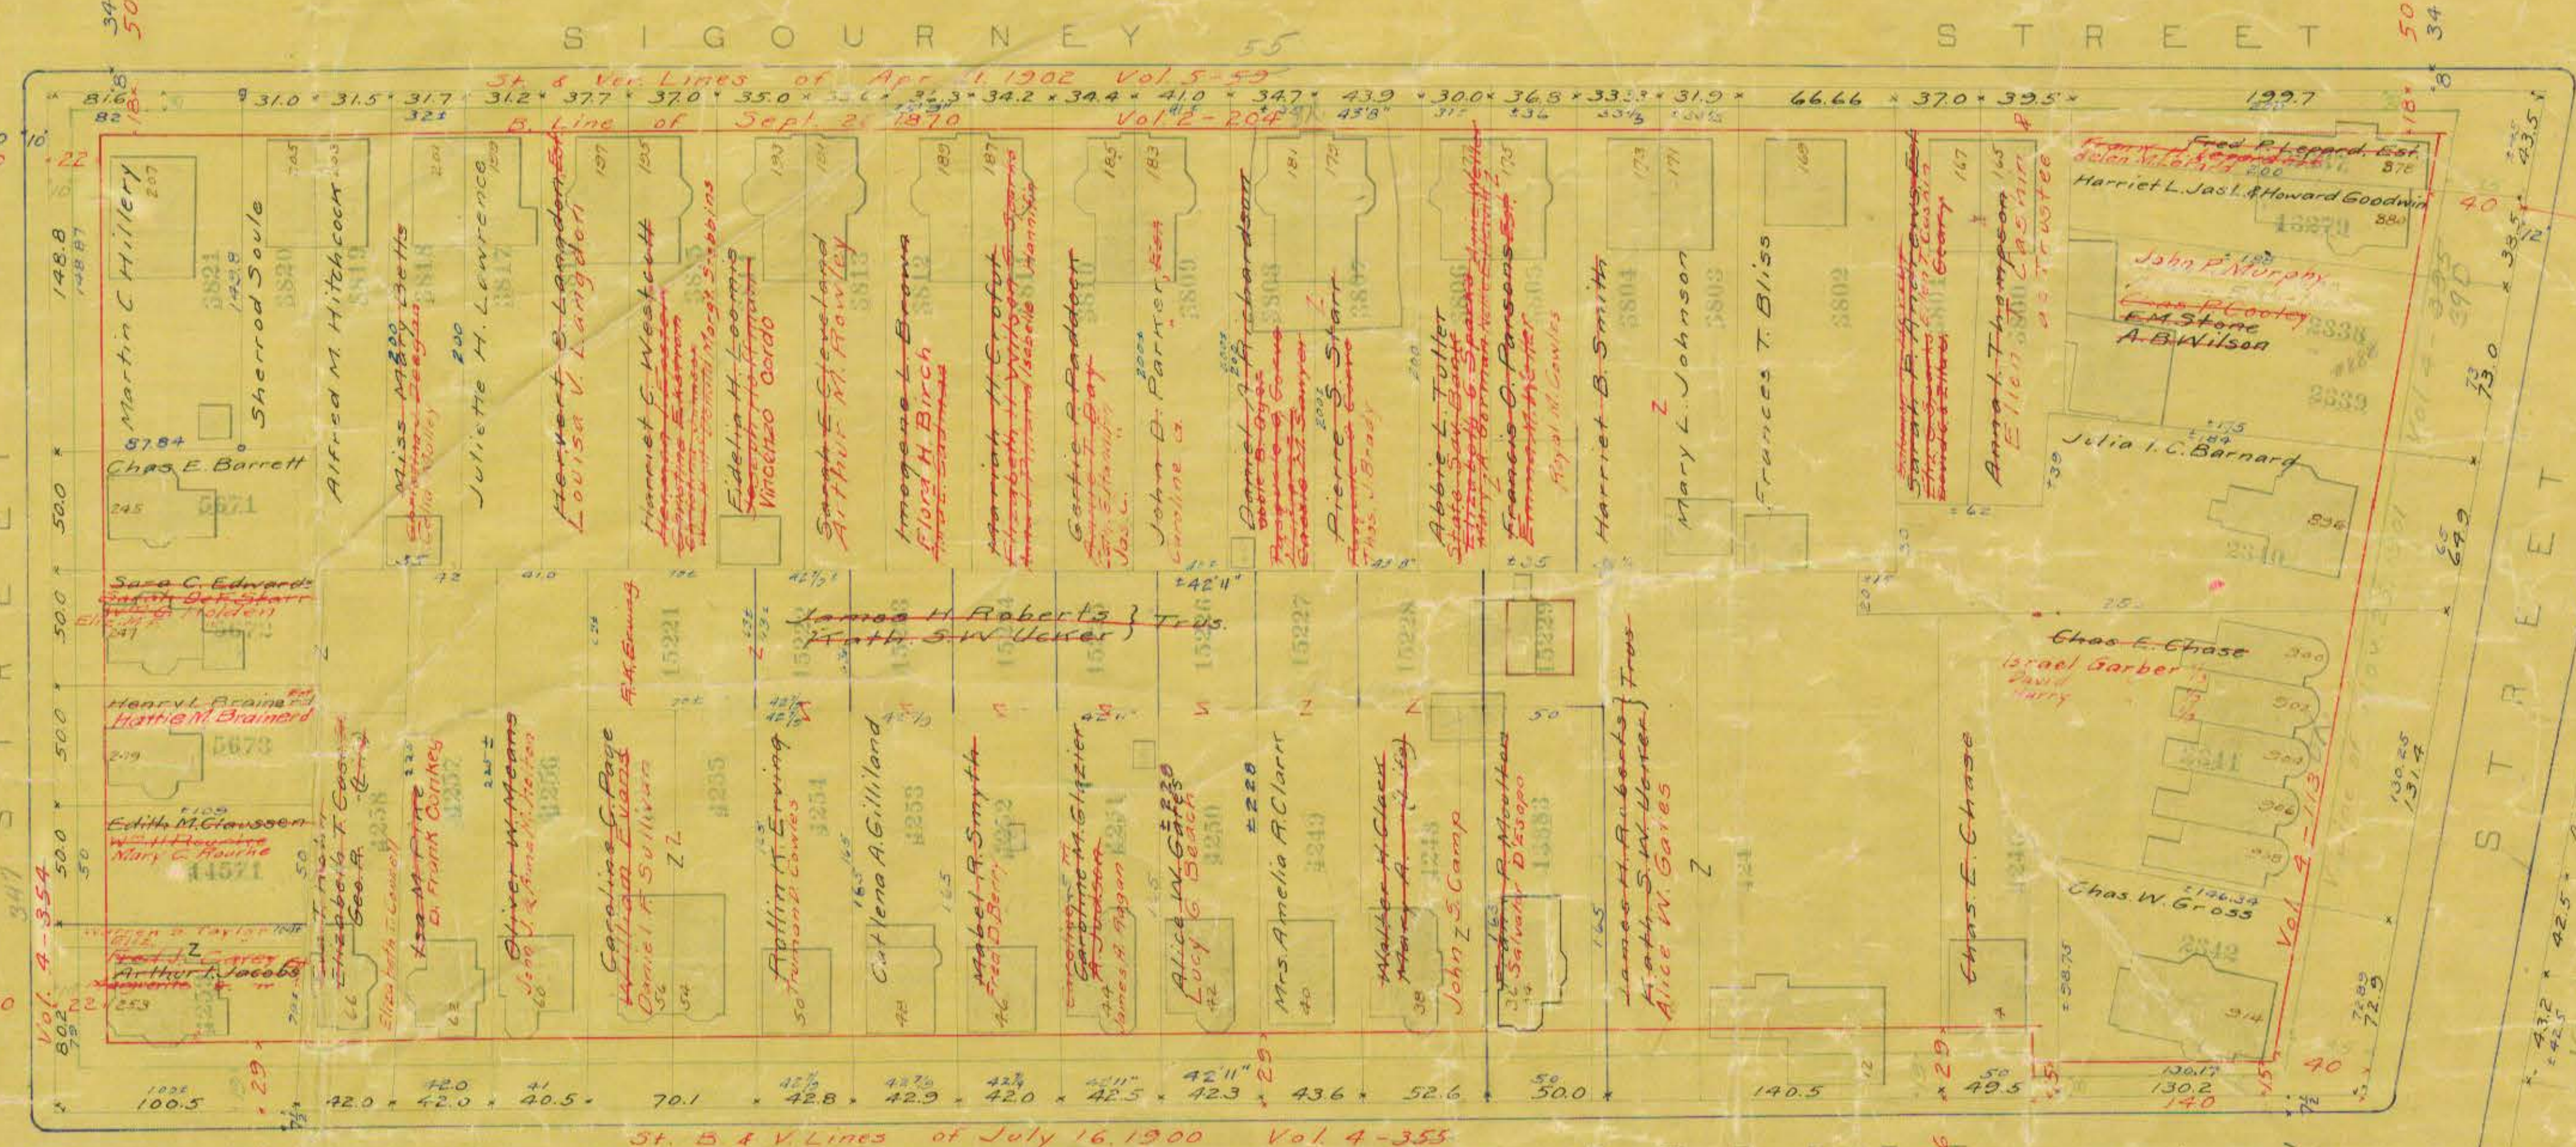

Sept 26, 1904 Vol 5-118



St. B. & V. Lines of Apr. 21, 1902 Vol 5-59

St. B. & V. Lines of June 27, 1900 Vol 2-178