


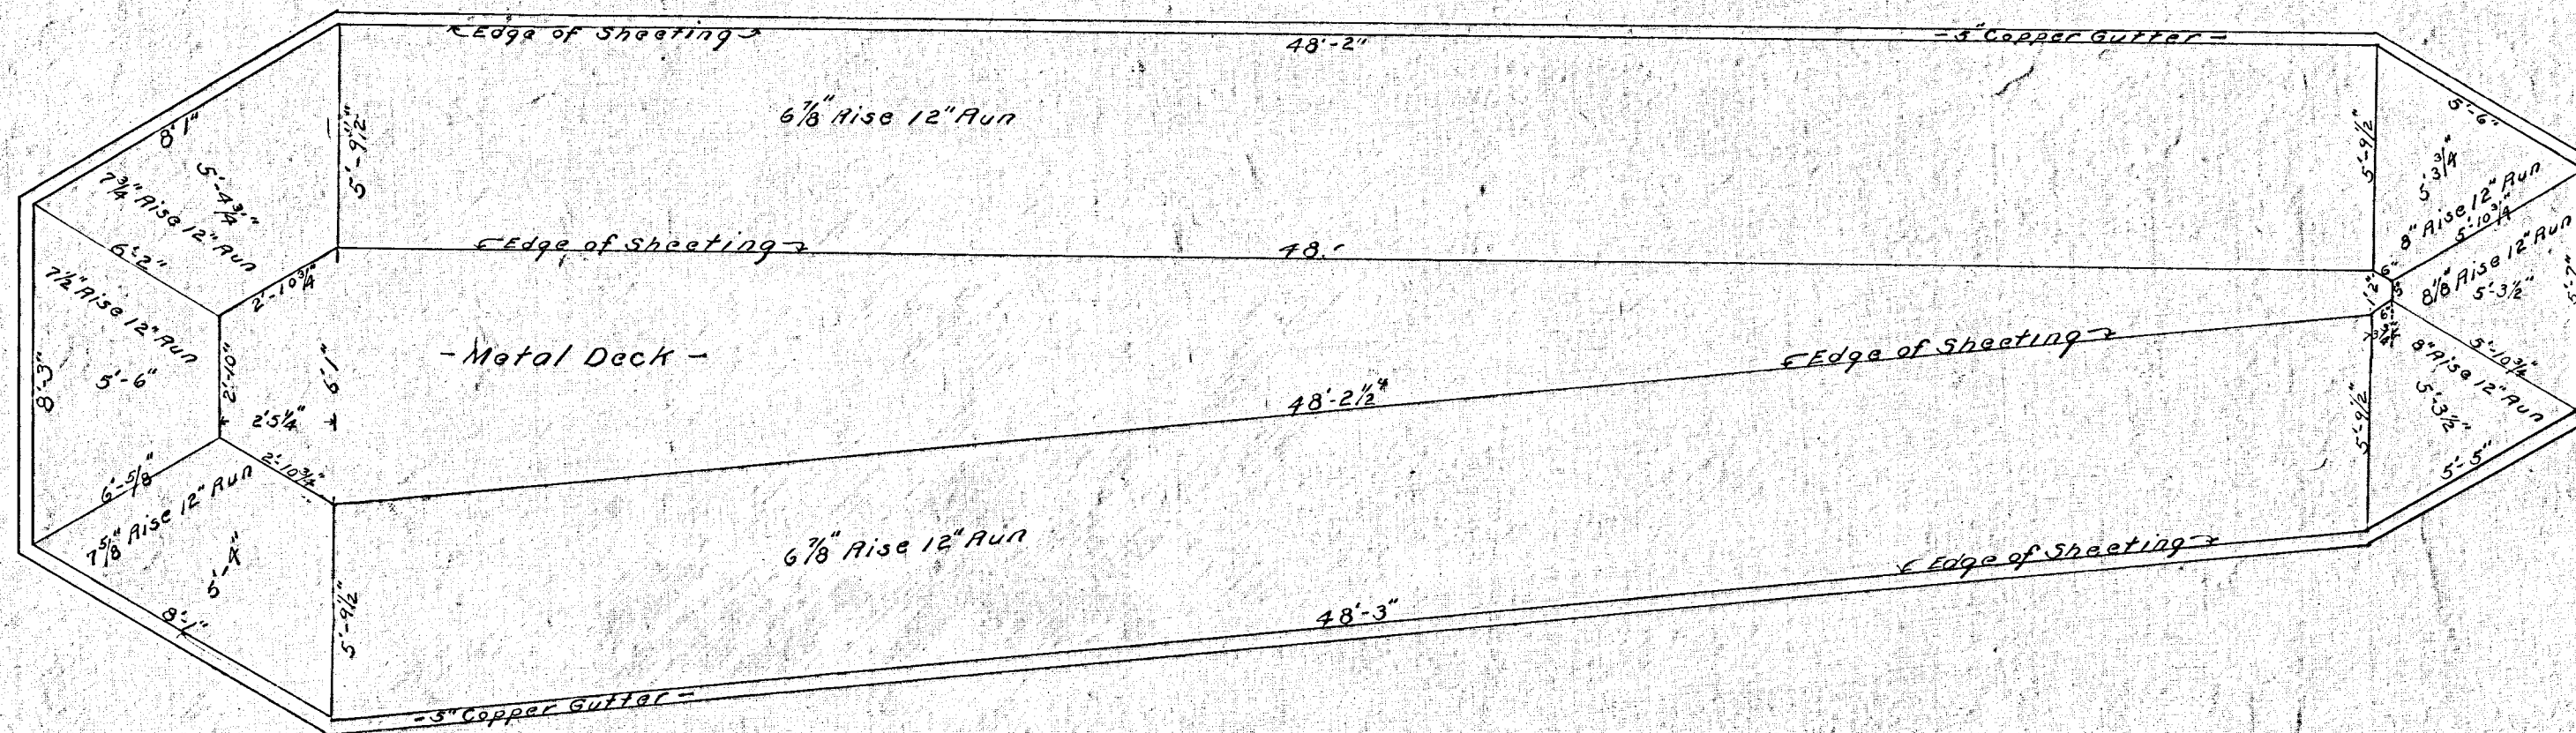

SHELTER FOR WAITING STATION
STATE STREET

Measurements made after construction of roof
All distances are from edges of board sheeting
Deck roof sheeting projects above tile roof sheeting its thickness about $1\frac{1}{8}$ "
Use figures in preference to scaled distances
Scale: $\frac{1}{4}" = 1'$

OFFICE OF CITY ENGINEER
HARTFORD, CONN.
CNOX. 18 1913 Day Book No 03377