
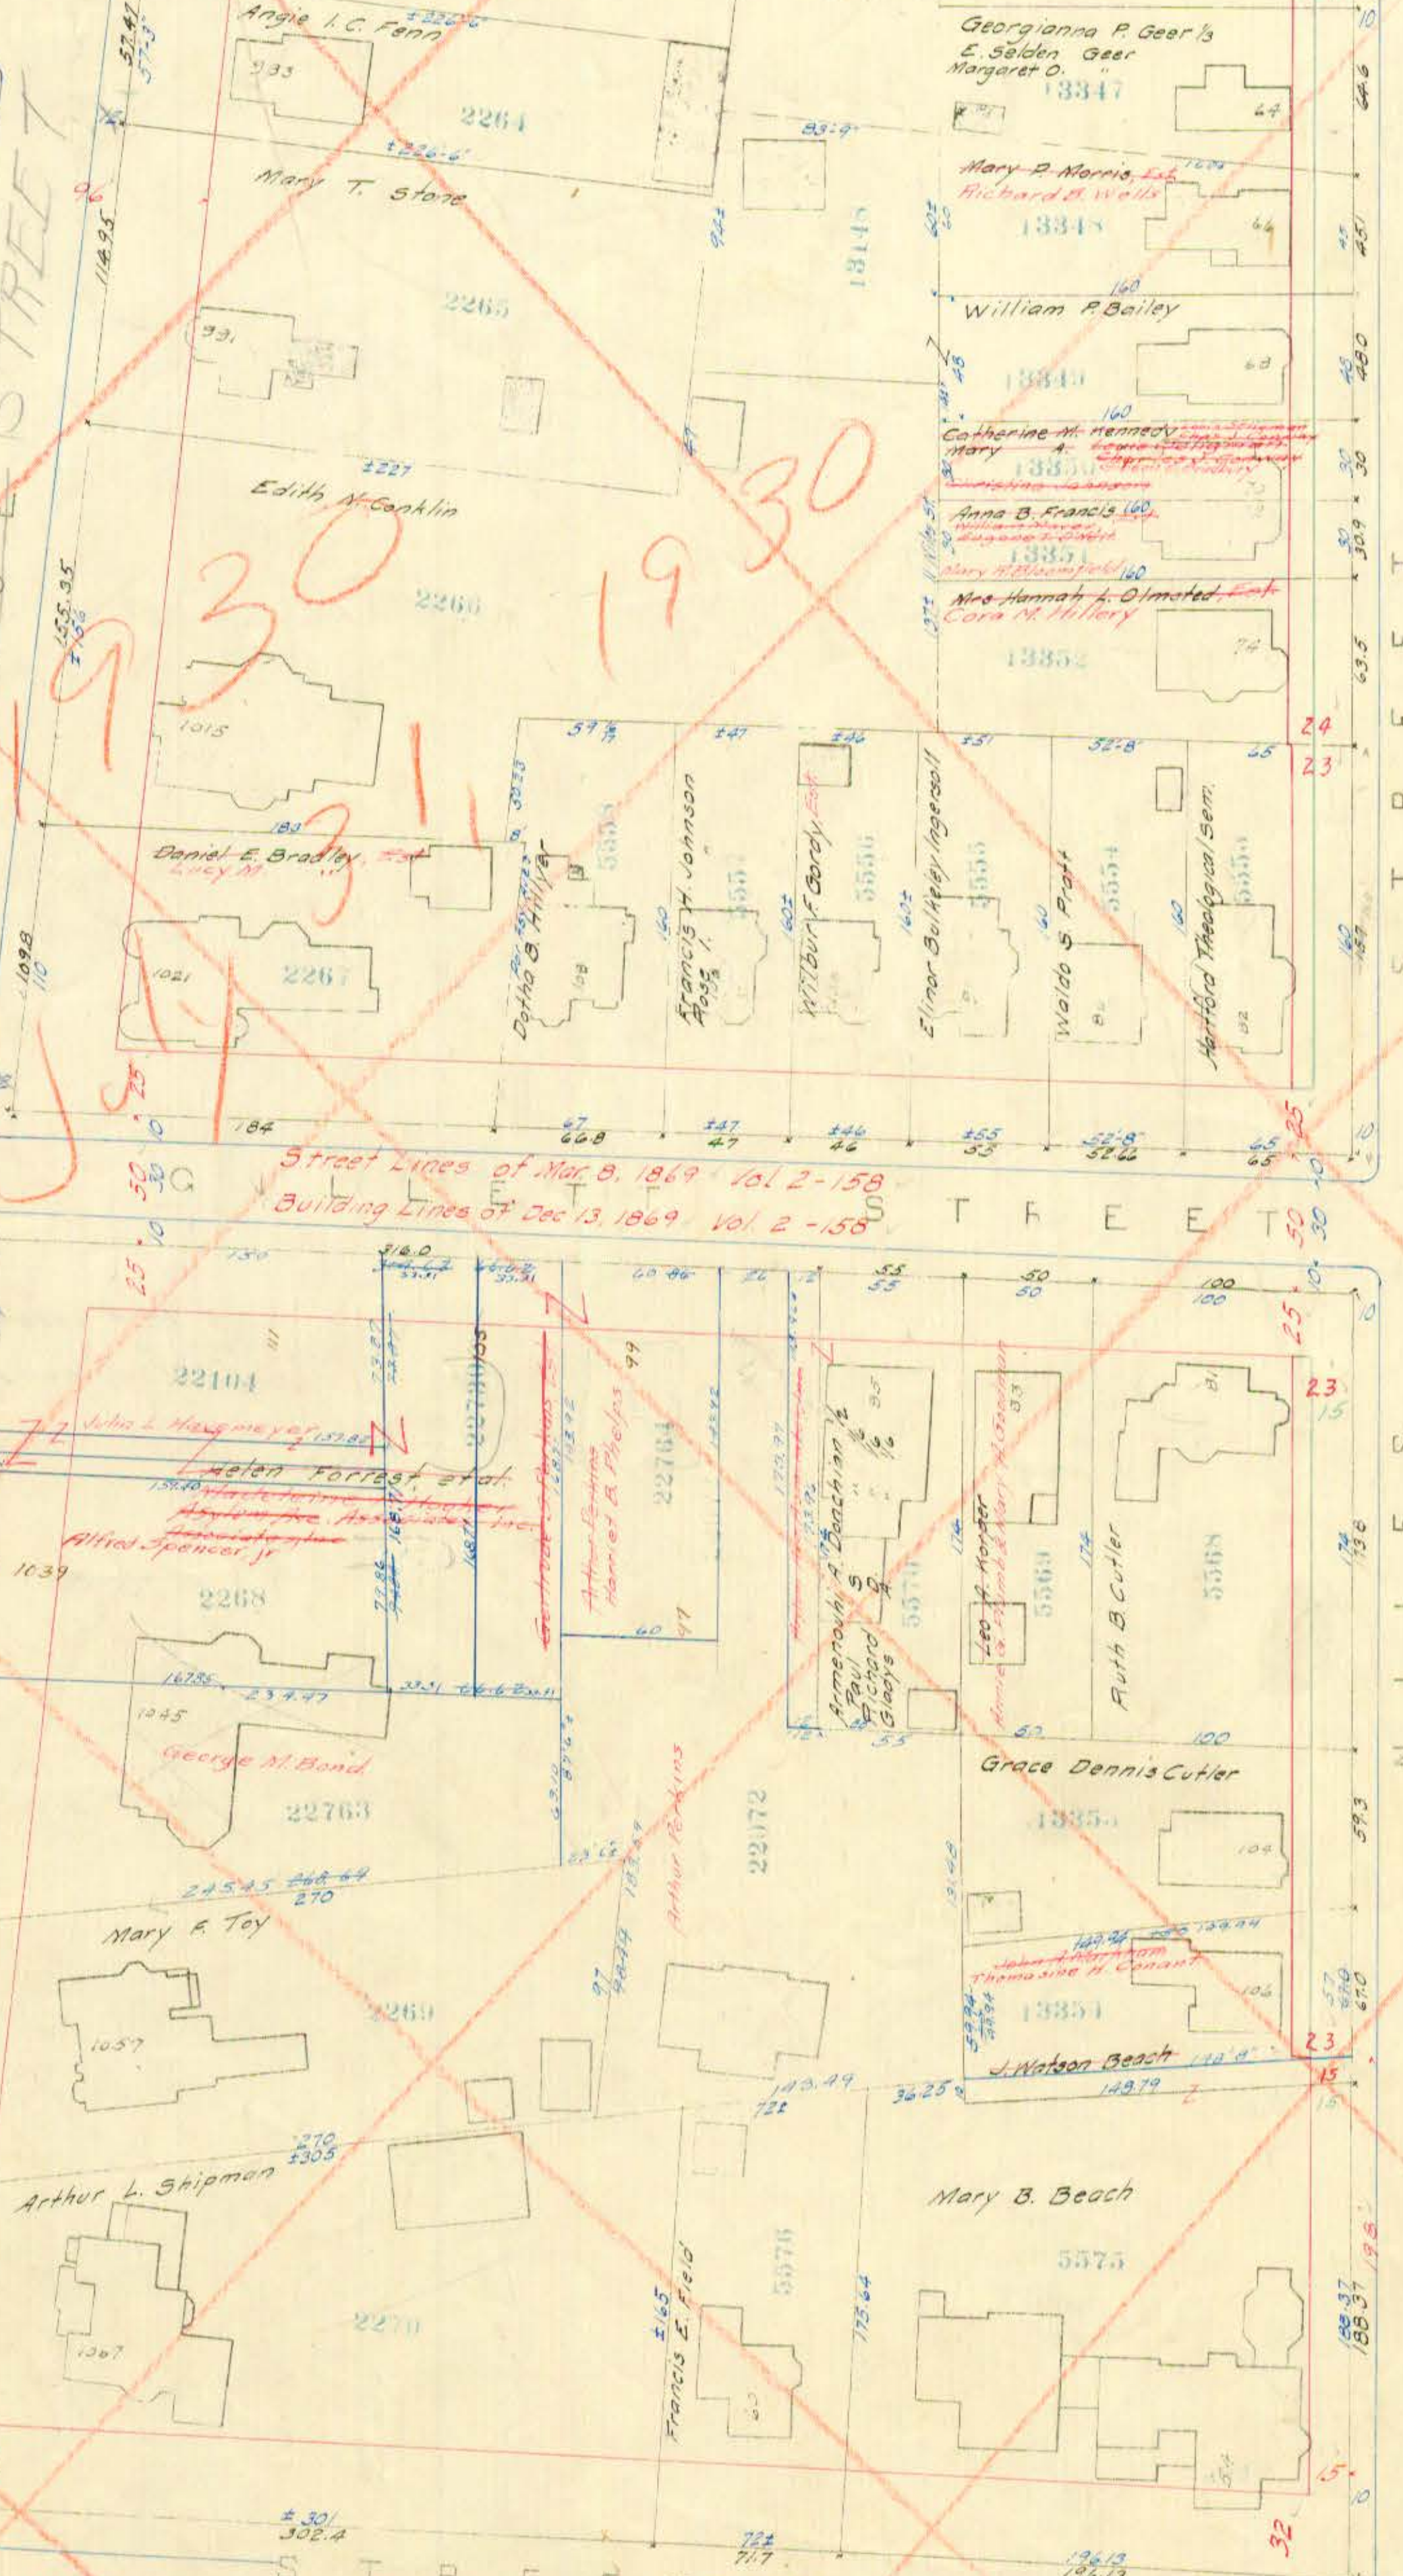


Street Lines of Sept 26, 1910 Vol. 2-226
Building and Veranda Lines of May 28, 1900 Vol. 3-43

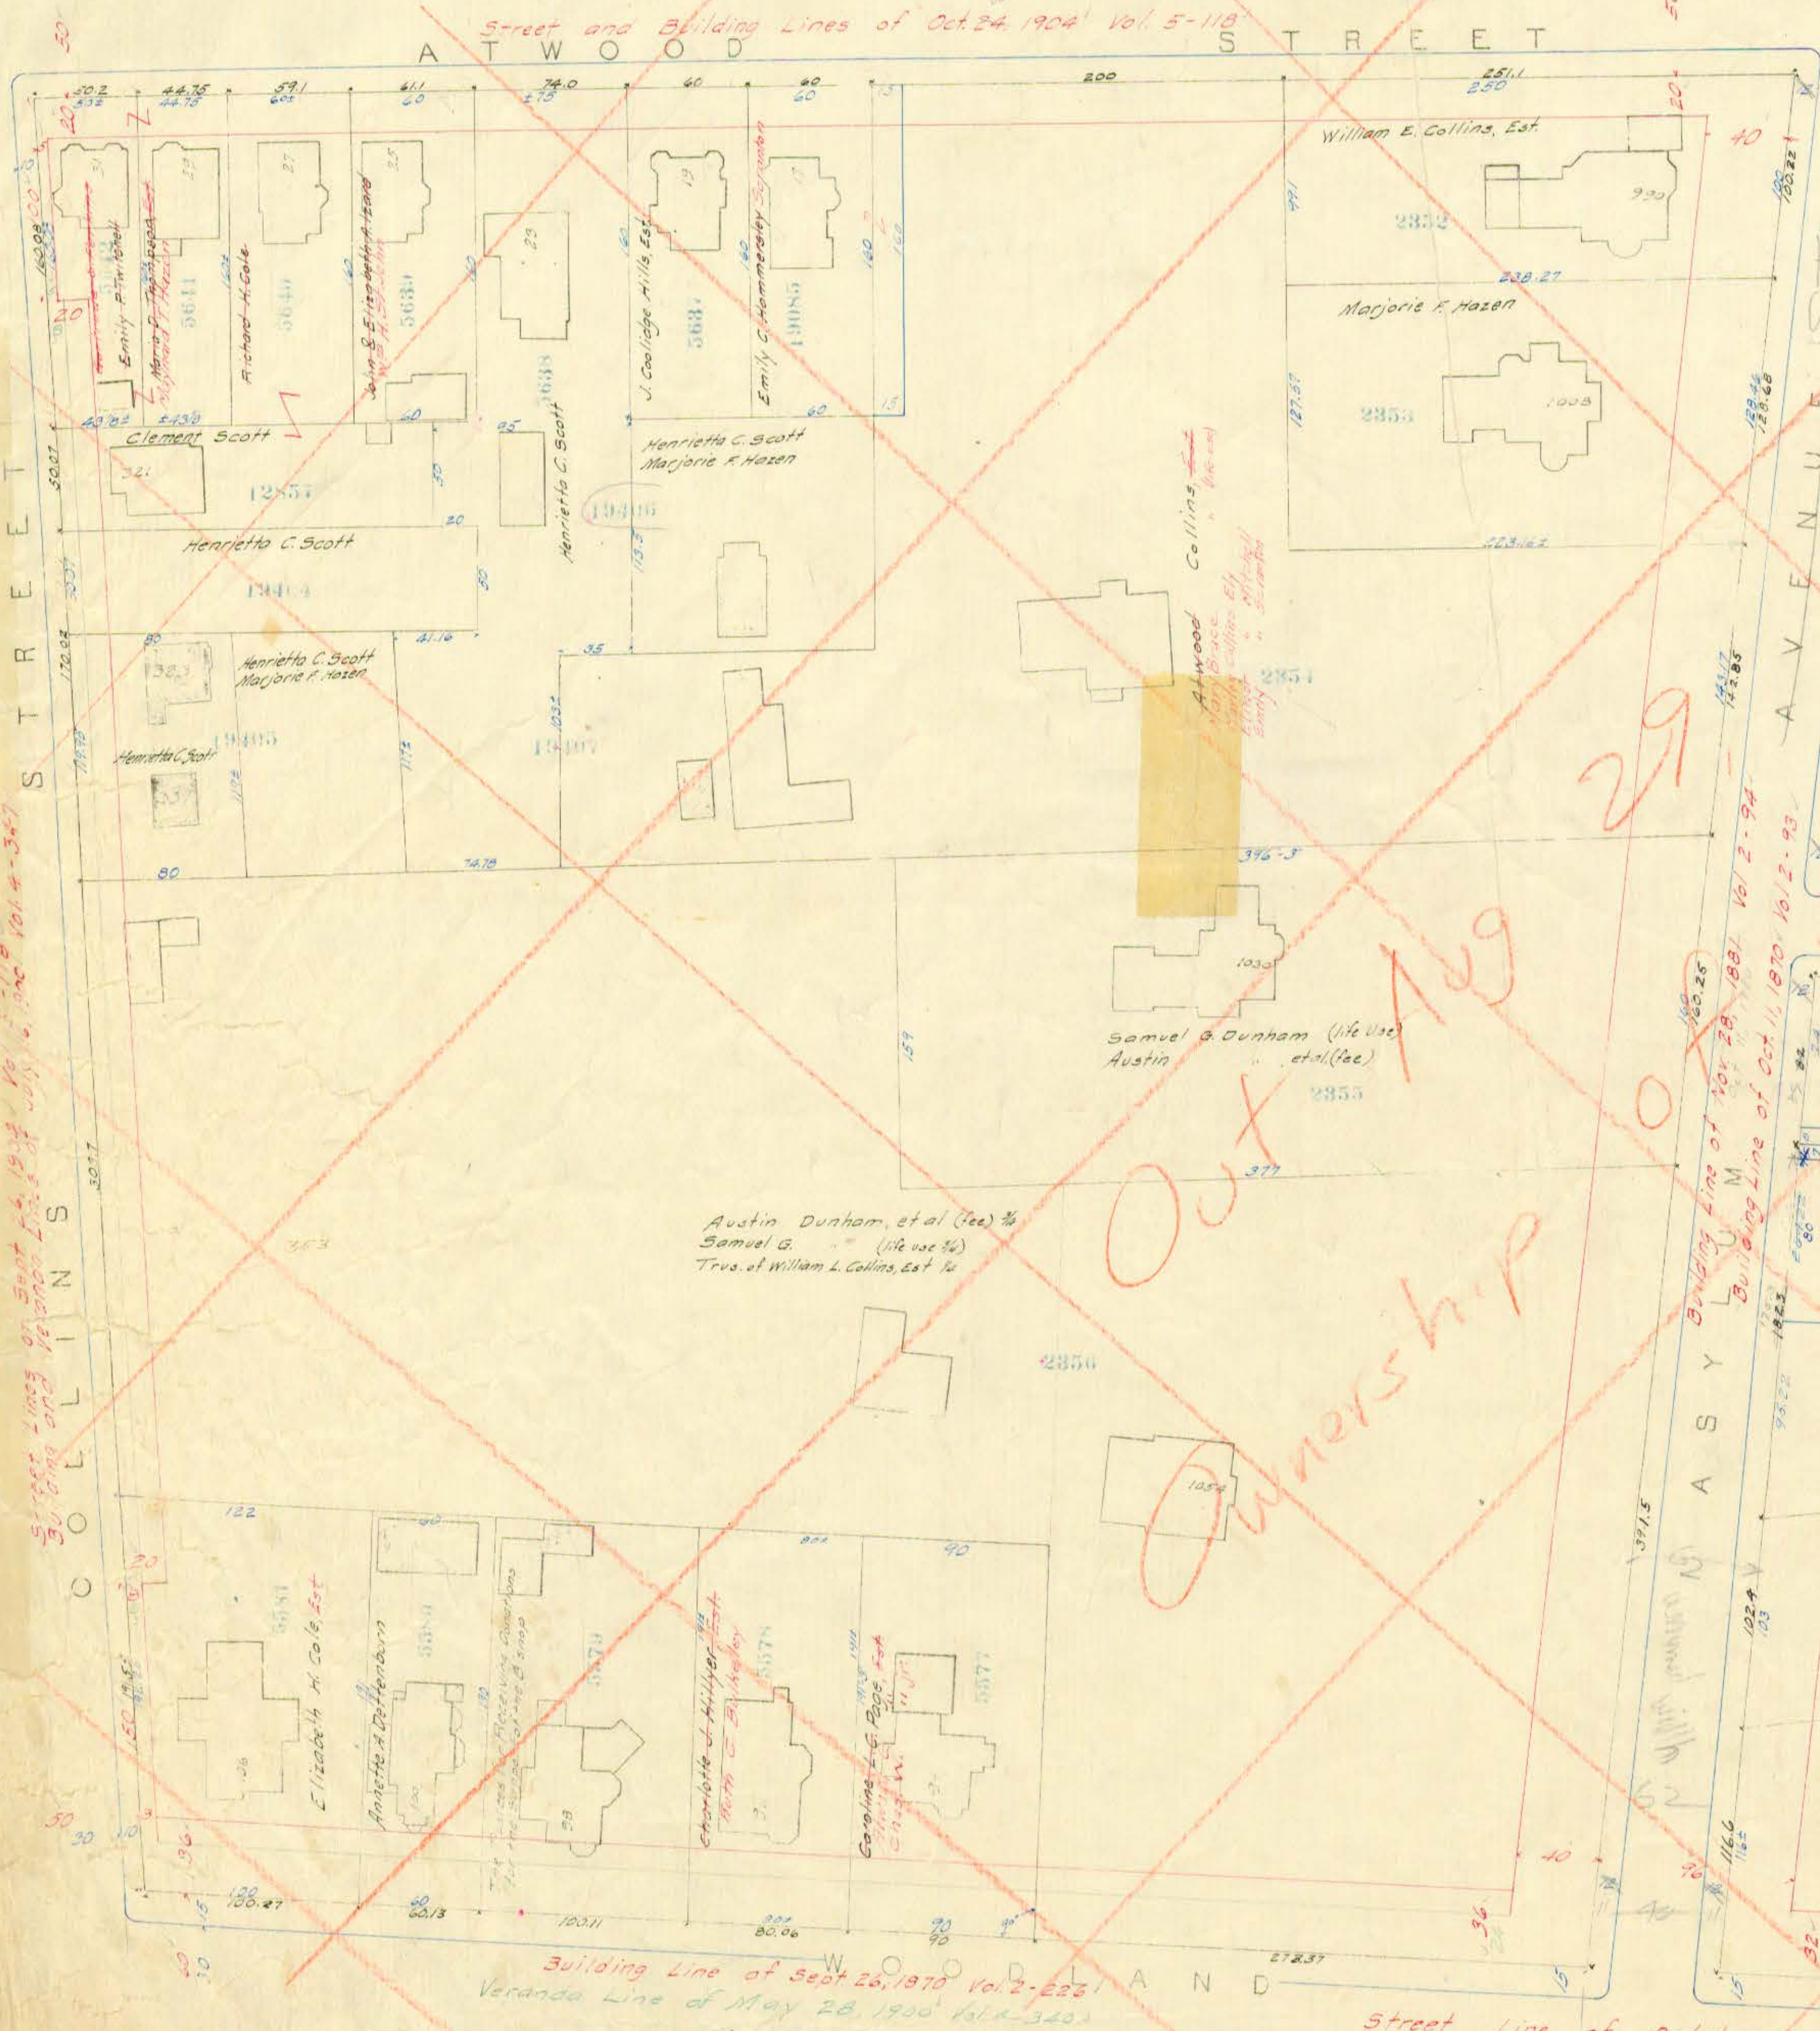

Building Line of Sept 26, 1910 Vol. 2-226
Veranda Line of May 28, 1900 Vol. 3-43

Street Line of October 10, 1904 Vol. 5-119 Building Line of July 28, 1902 Vol. 5-61

Building and Veranda Lines of June 3, 1925 Vol. 7-93