


Out of service May 20-1941

May 20-1941

Service

Out of

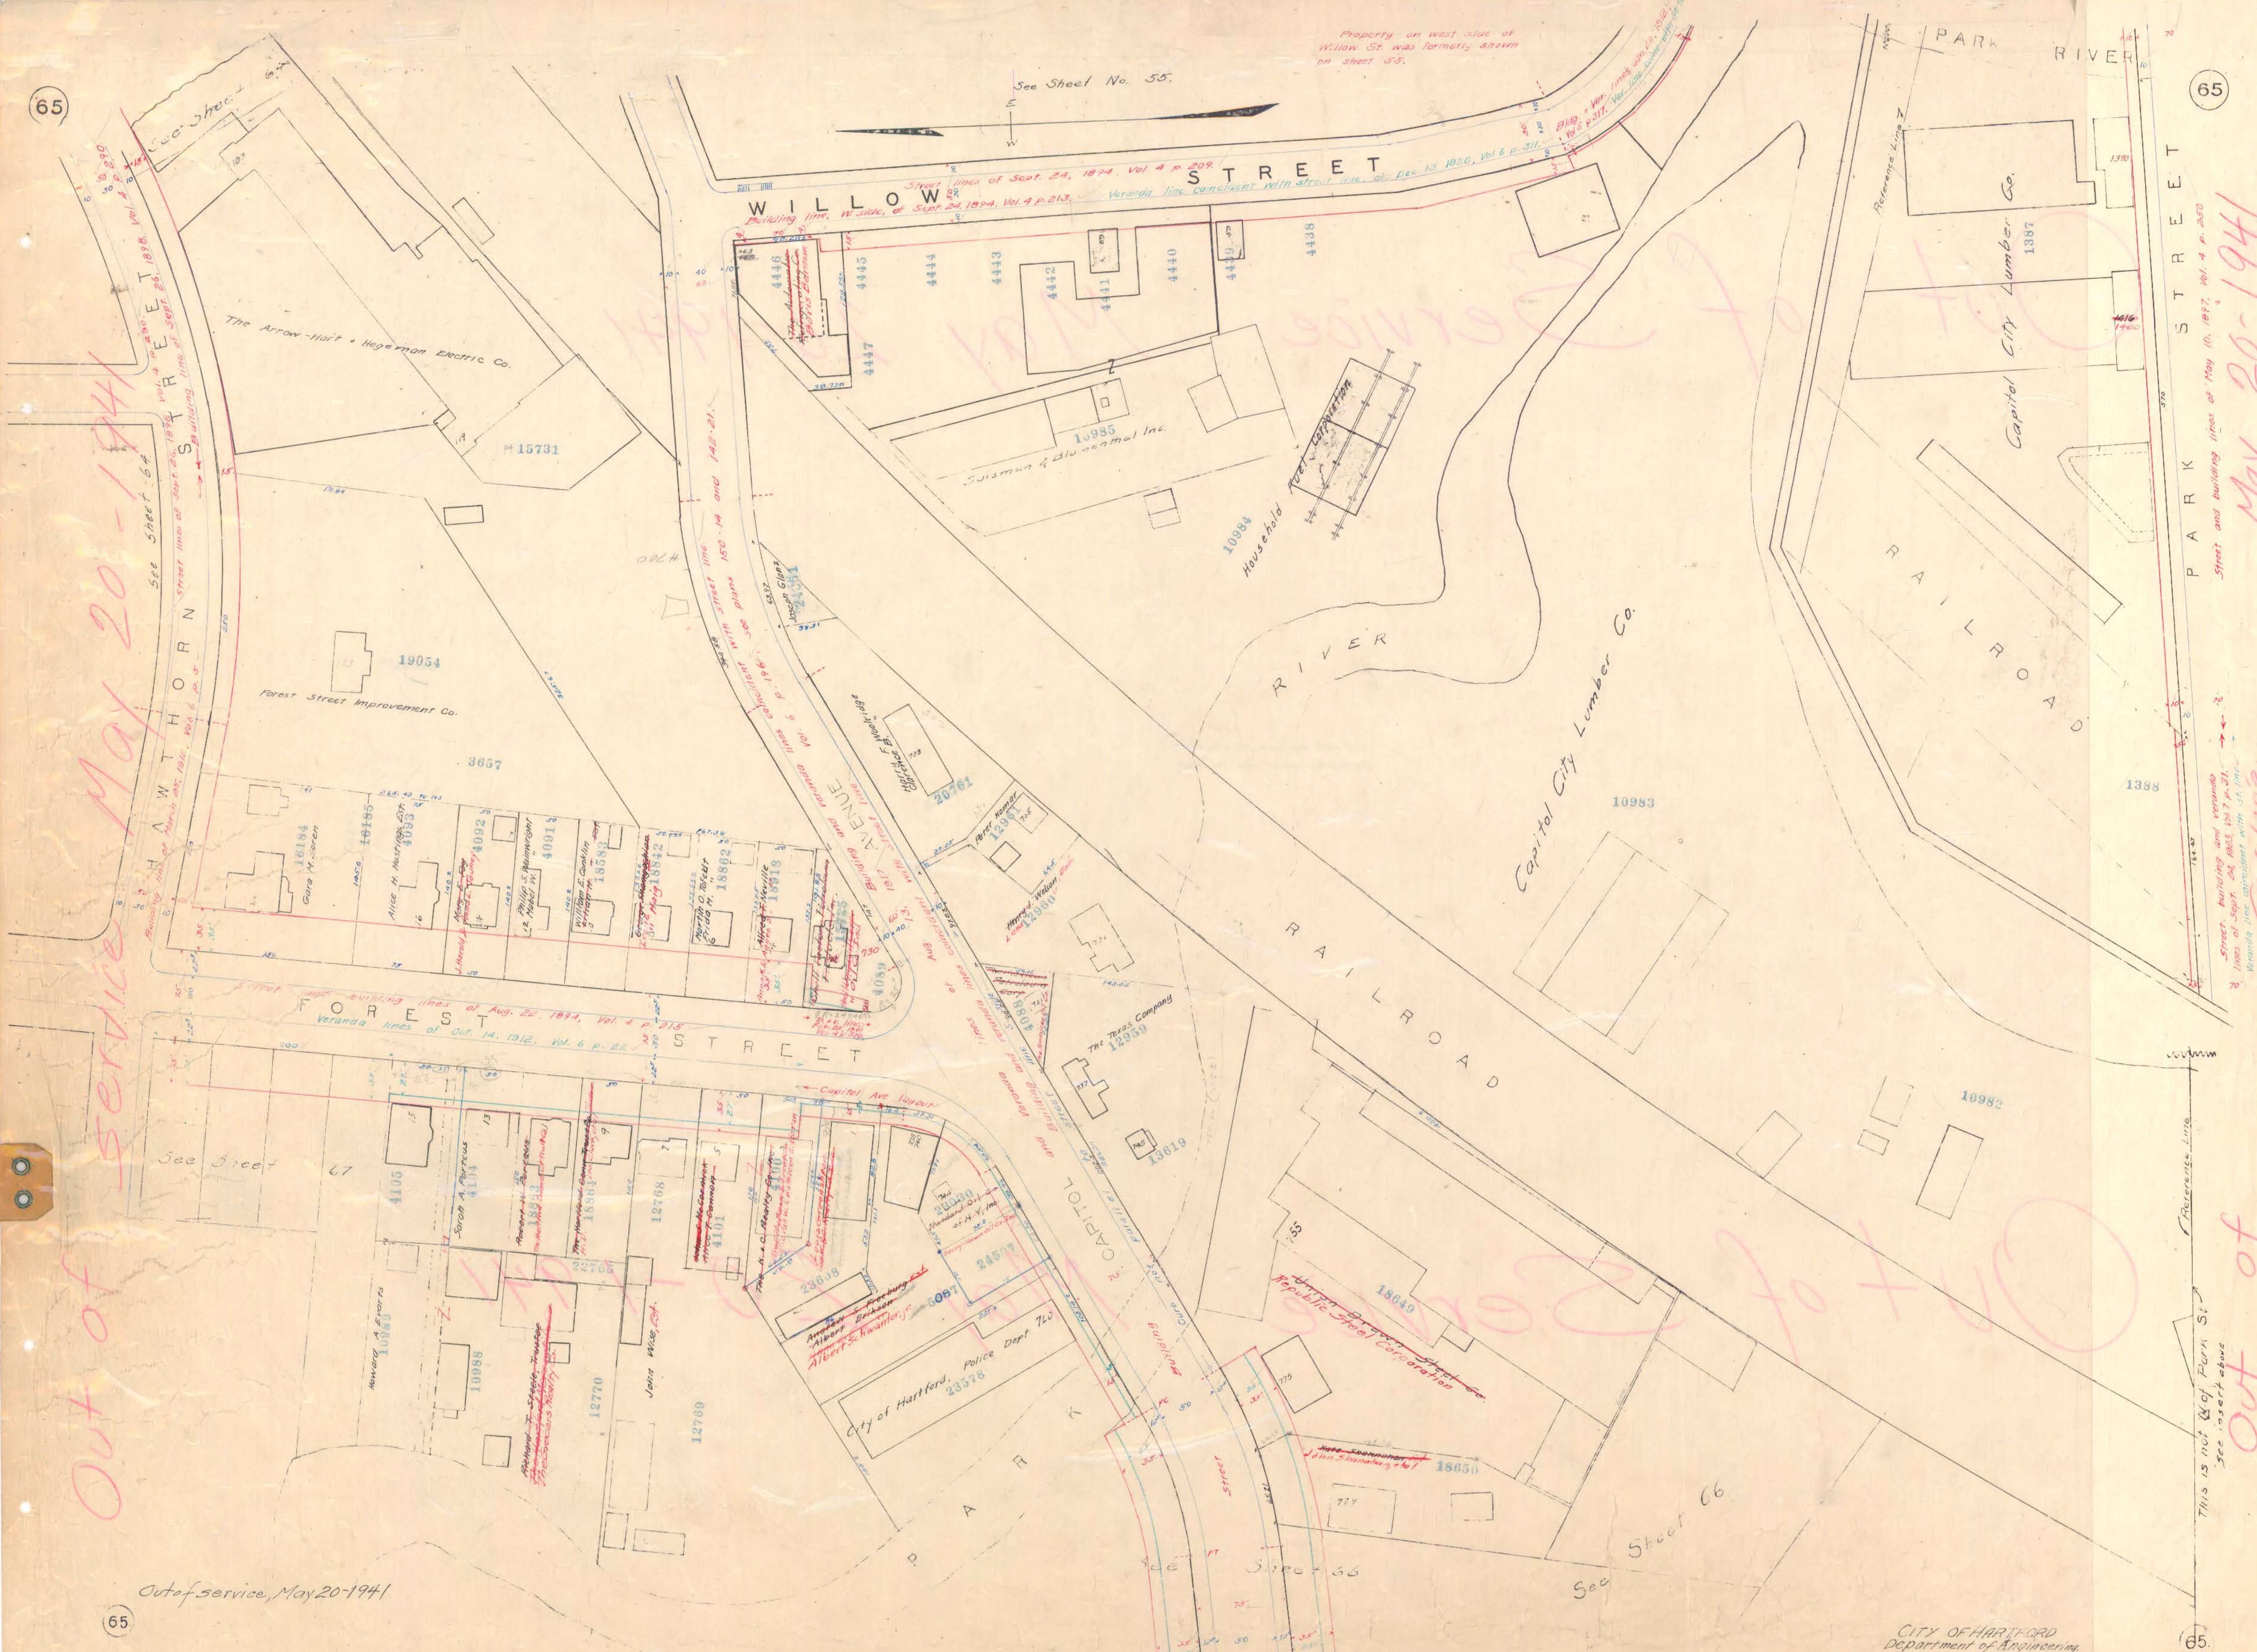

Out of service, May 20-1941