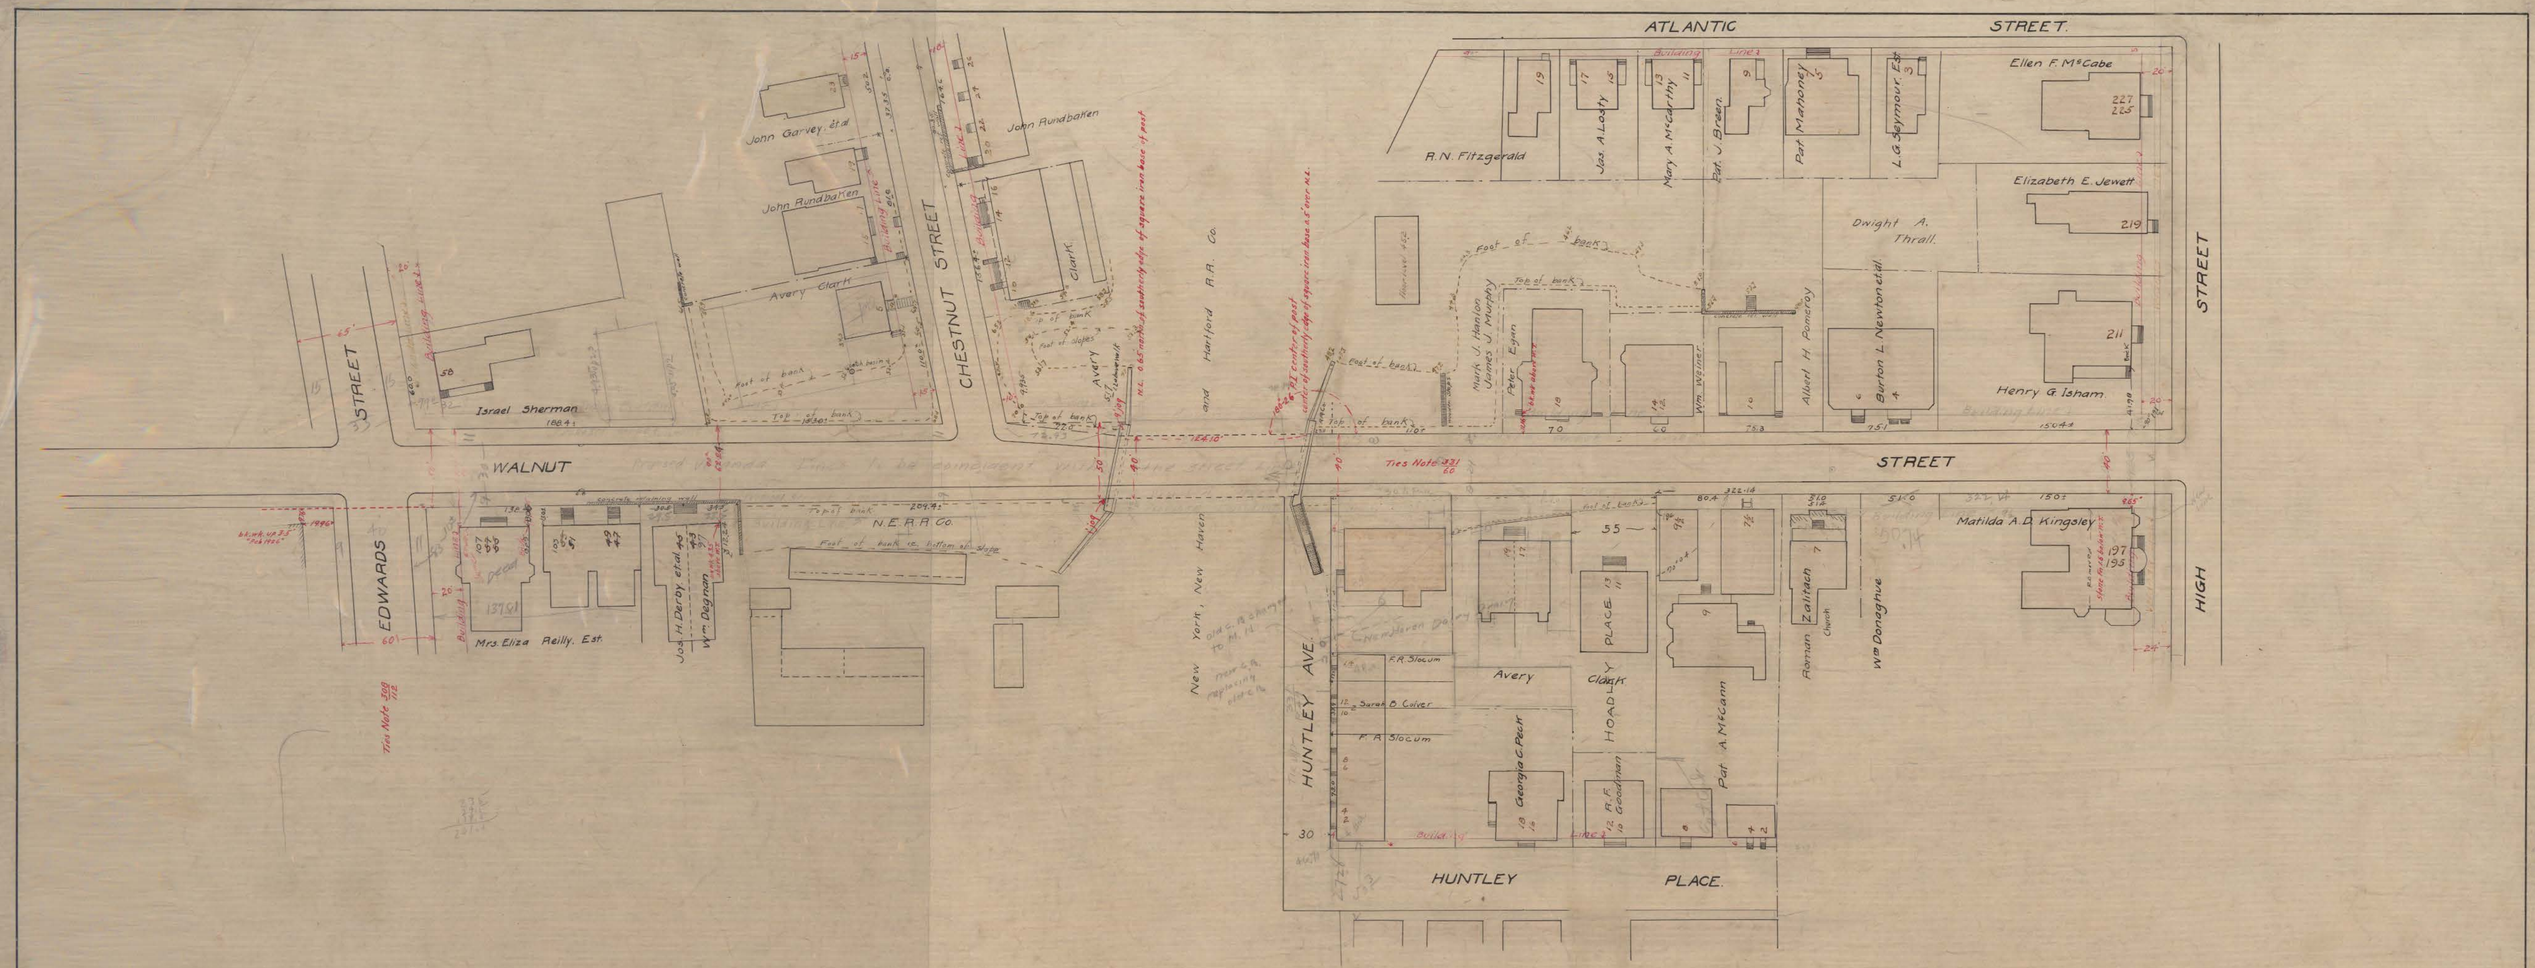

Jan. 1911 02562
TR 331/1934
331/46 TR 331/99
331/88