
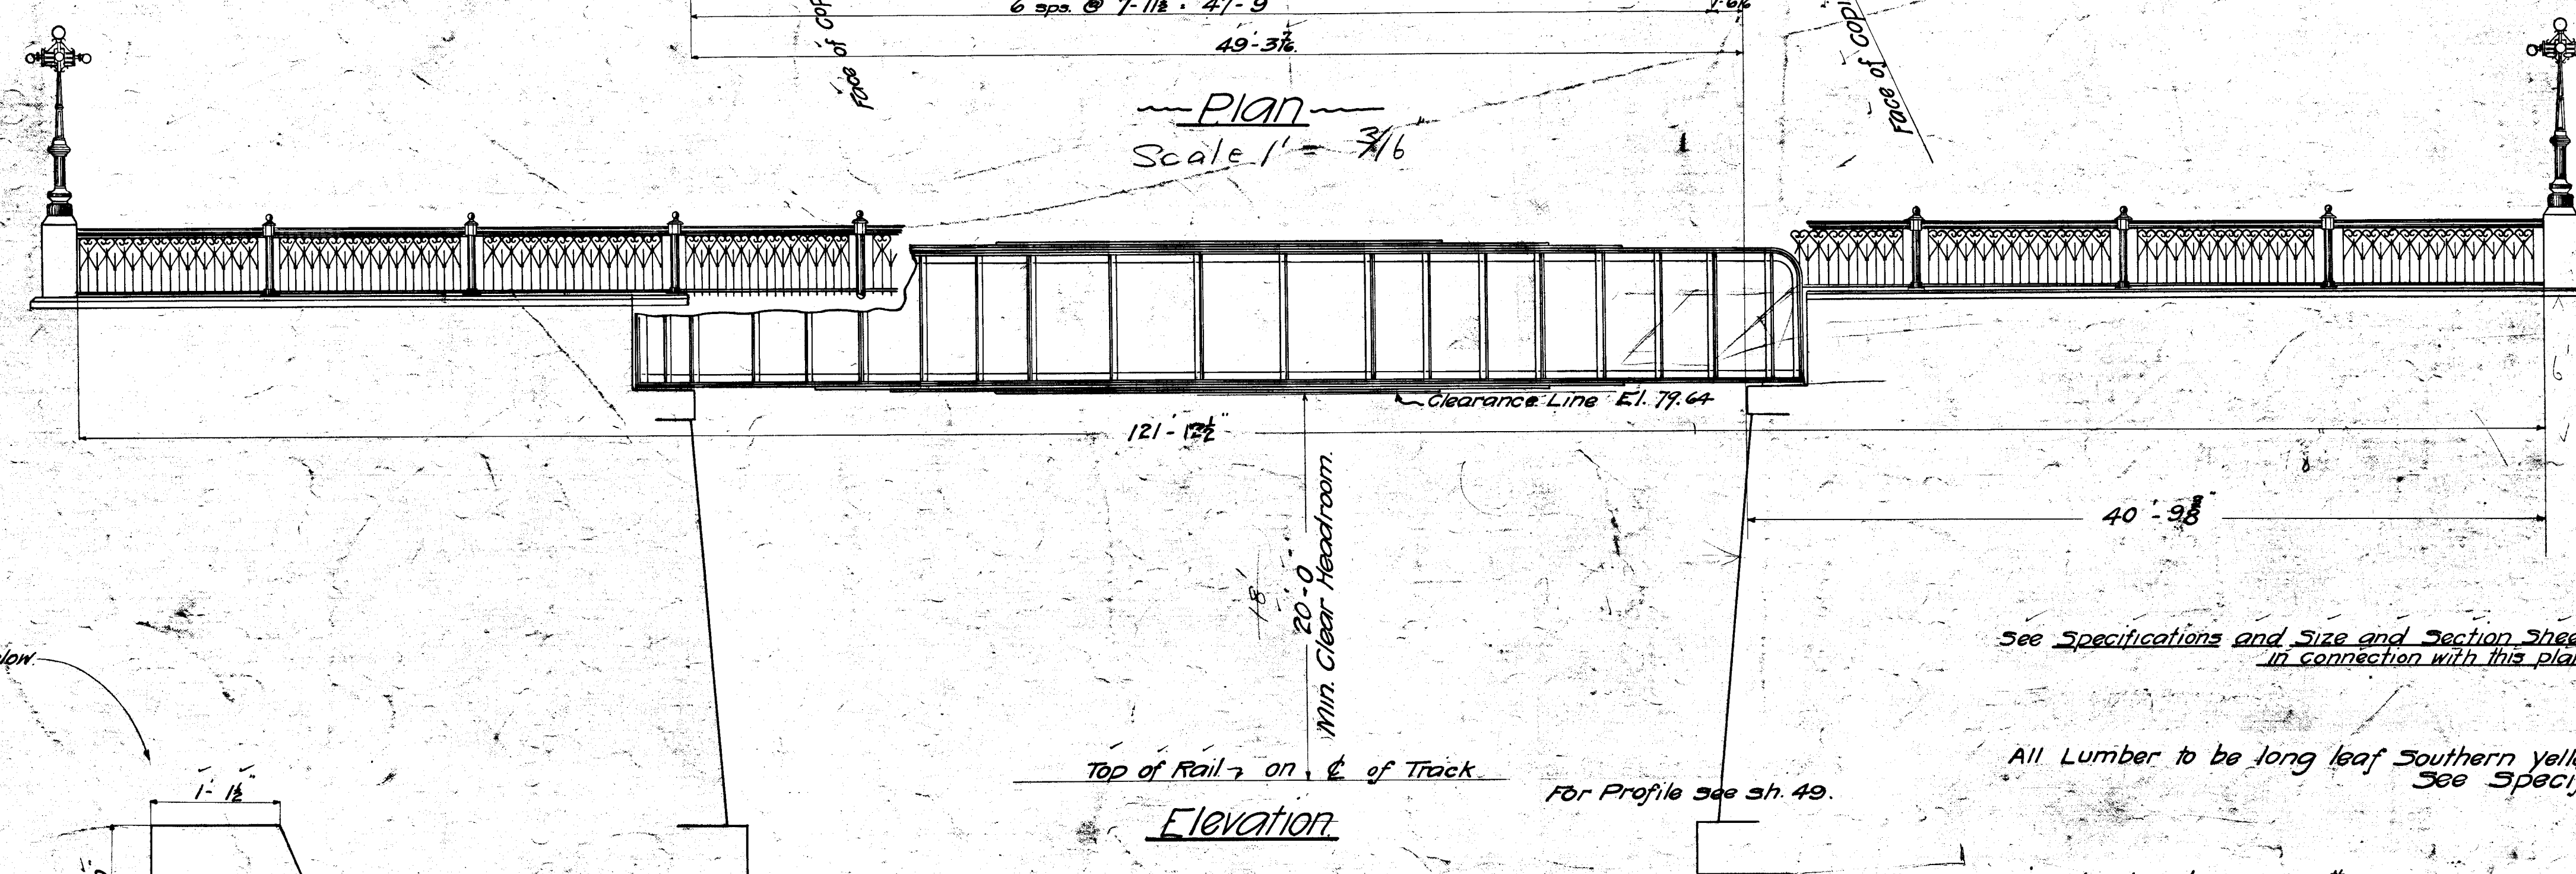
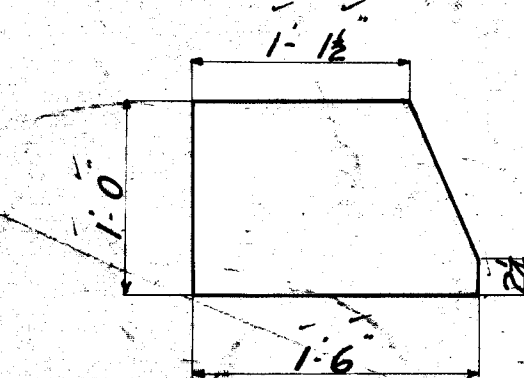
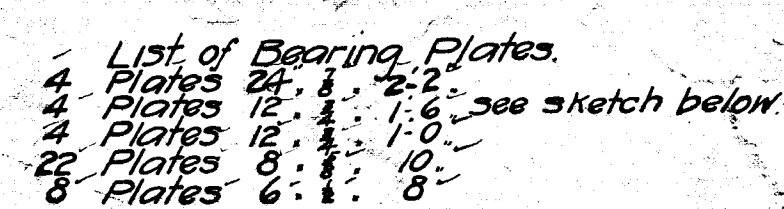
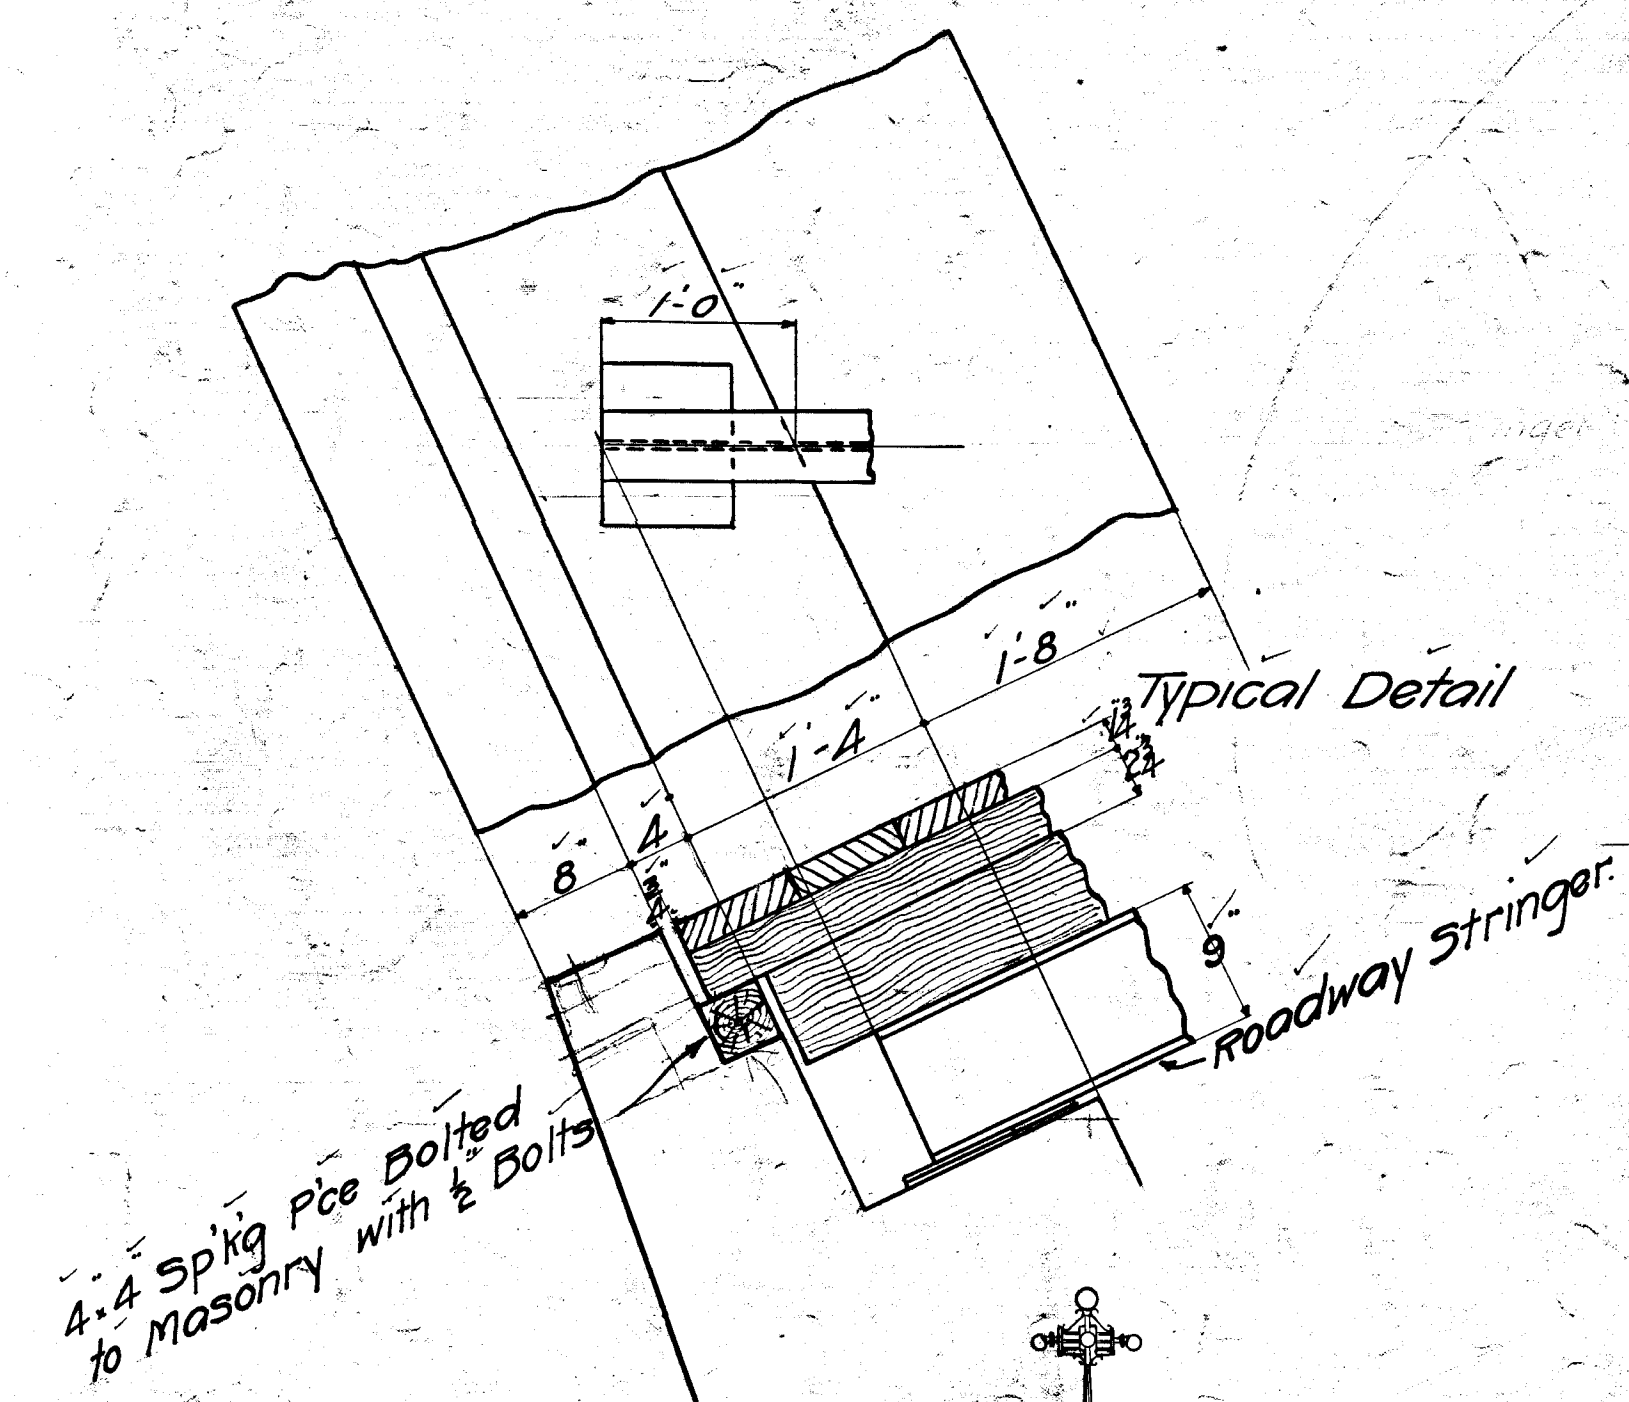


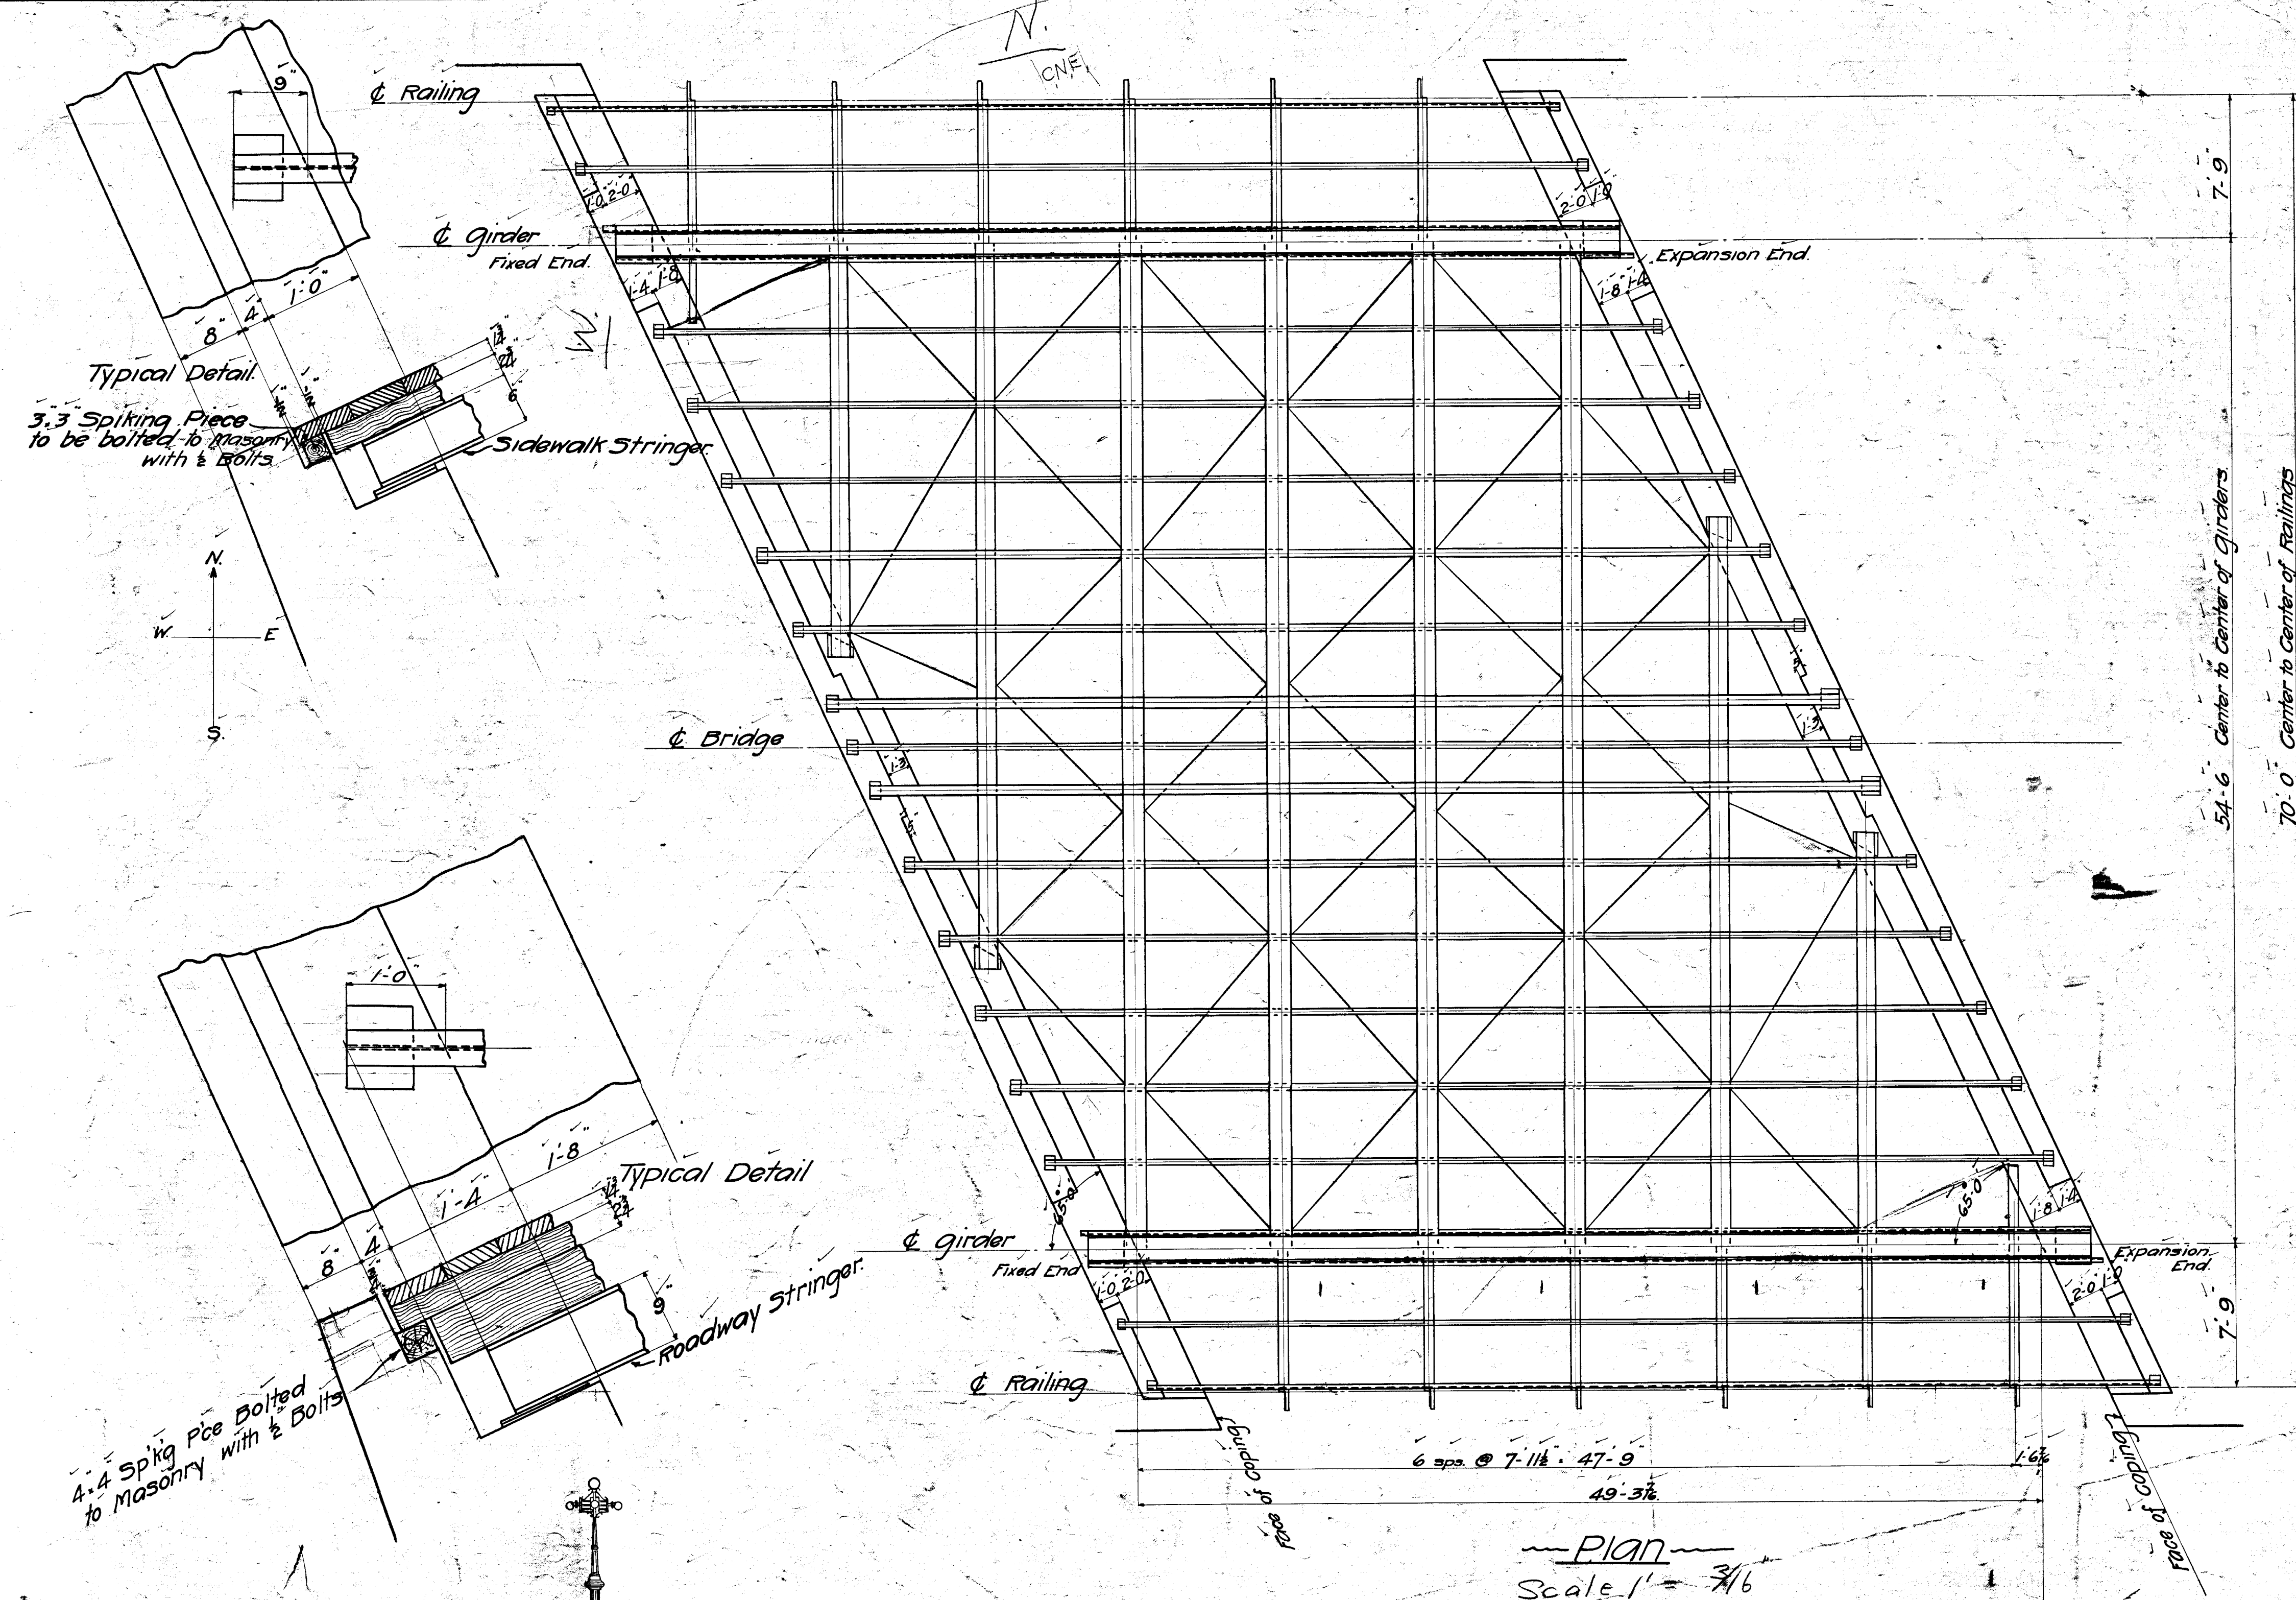


See Specifications and Size and Section Sheet
in connection with this plan

All Lumber to be long leaf Southern yellow Pine.
See Specifications

Revised Sheet Aug. 5th 1905
Destroy All Other Prints
Revision Due to Change in Headroom.

Frederick L. Ford, City Engineer, Hartford Conn.

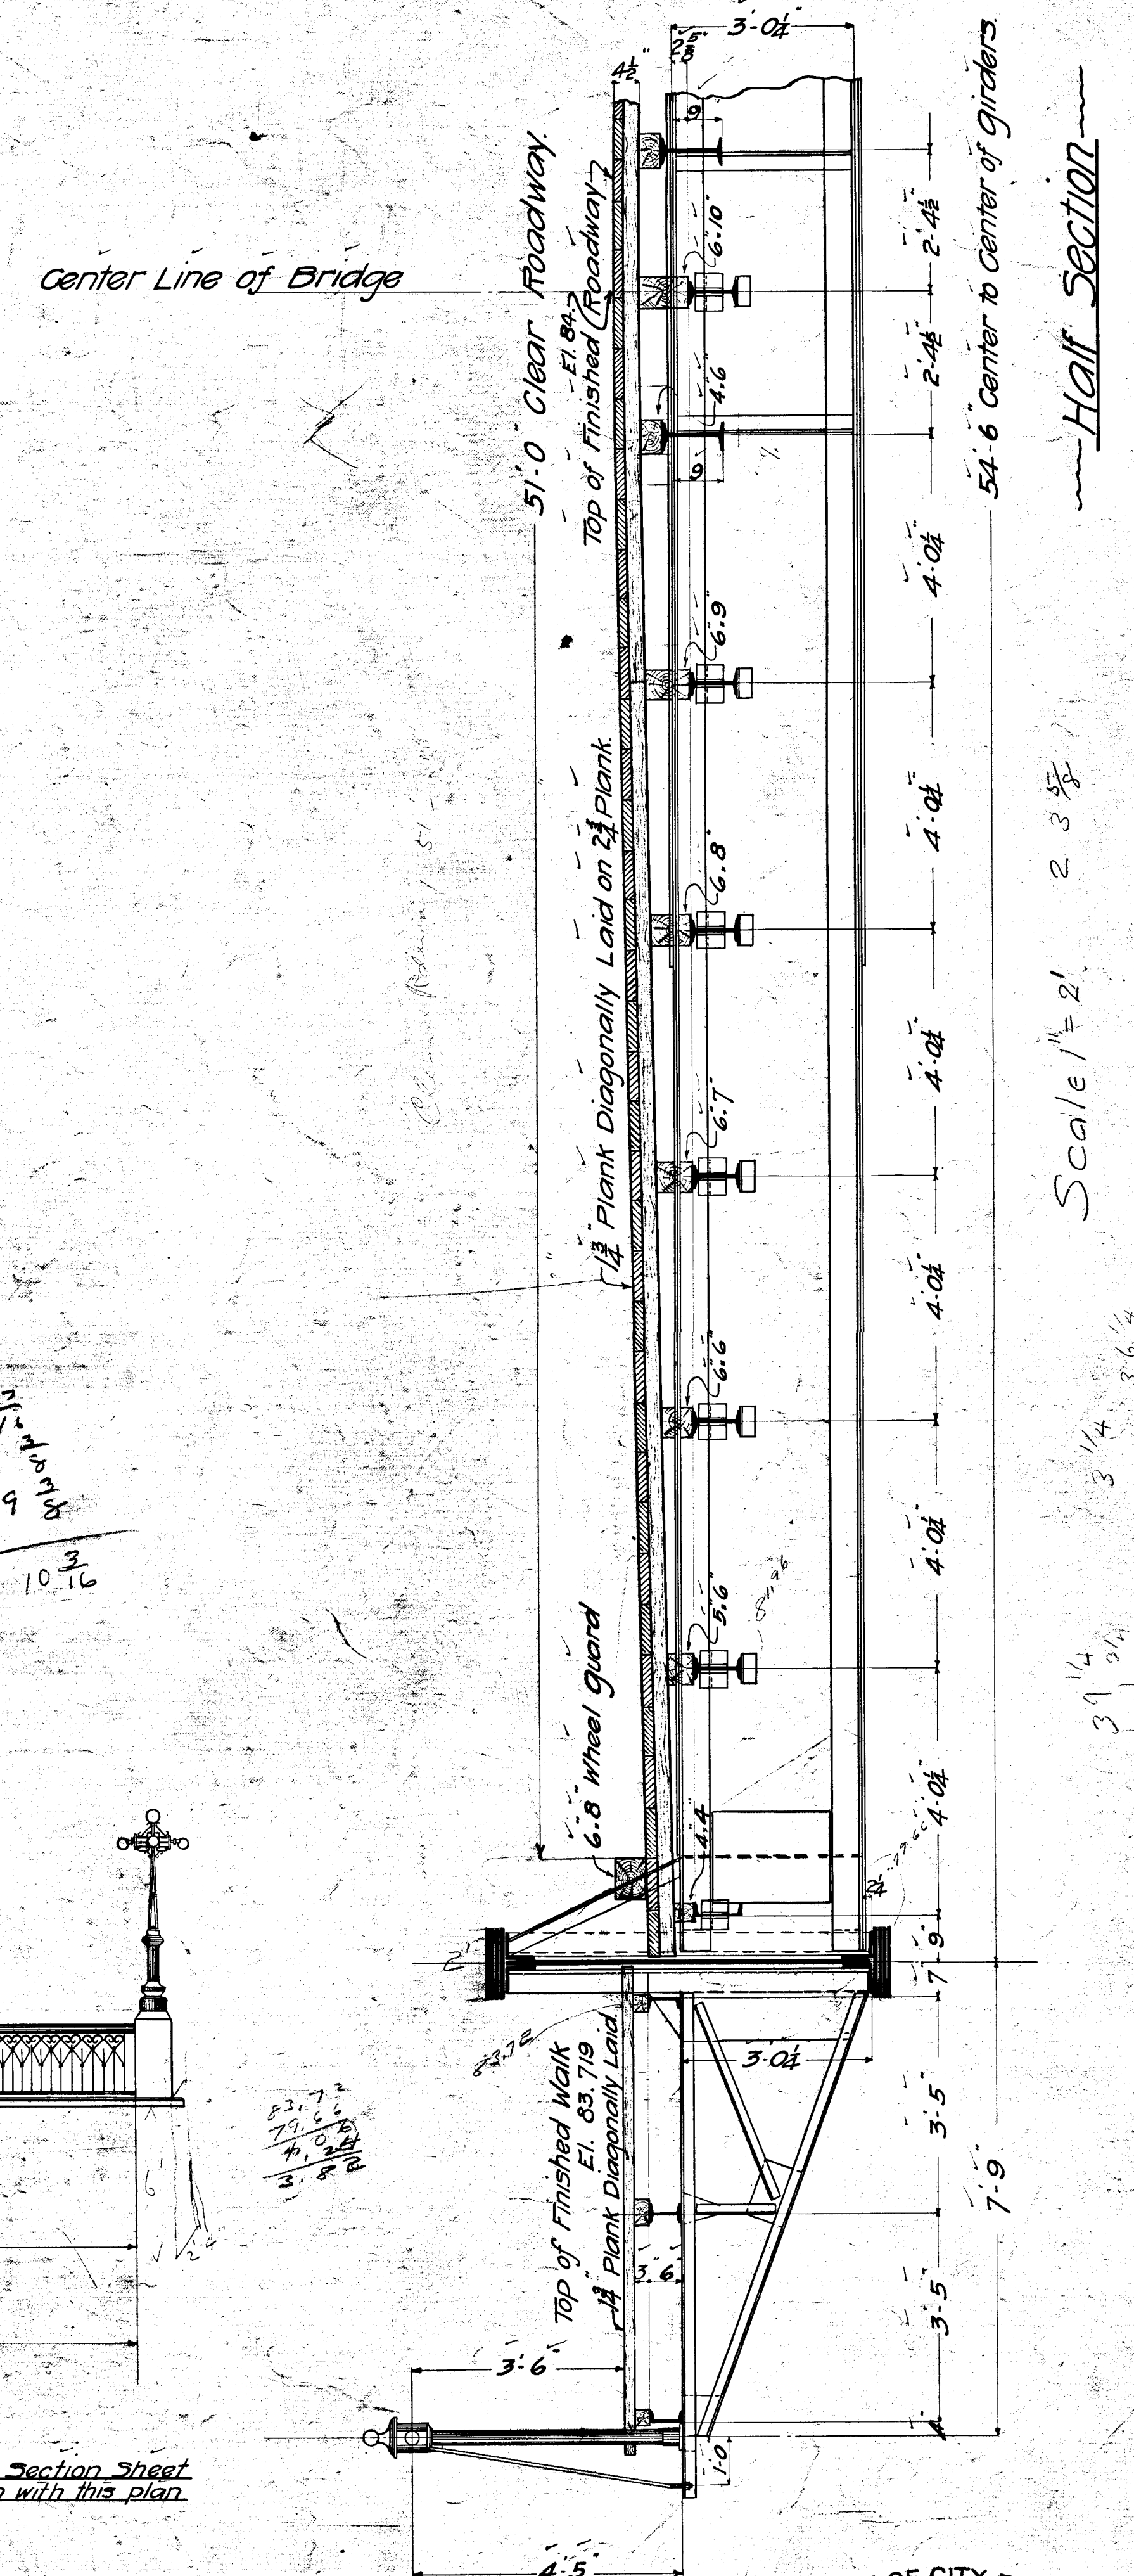

Scale $1'' = 2'$

OFFICE OF CITY ENGINEER
HARTFORD, CONN.
Date May 1905 Day Book No. 01702.

**STEEL HIGHWAY BRIDGE
AT ALBANY AVENUE
OVER TRACKS OF
CENTRAL NEW ENGLAND RAILROAD CO.**