


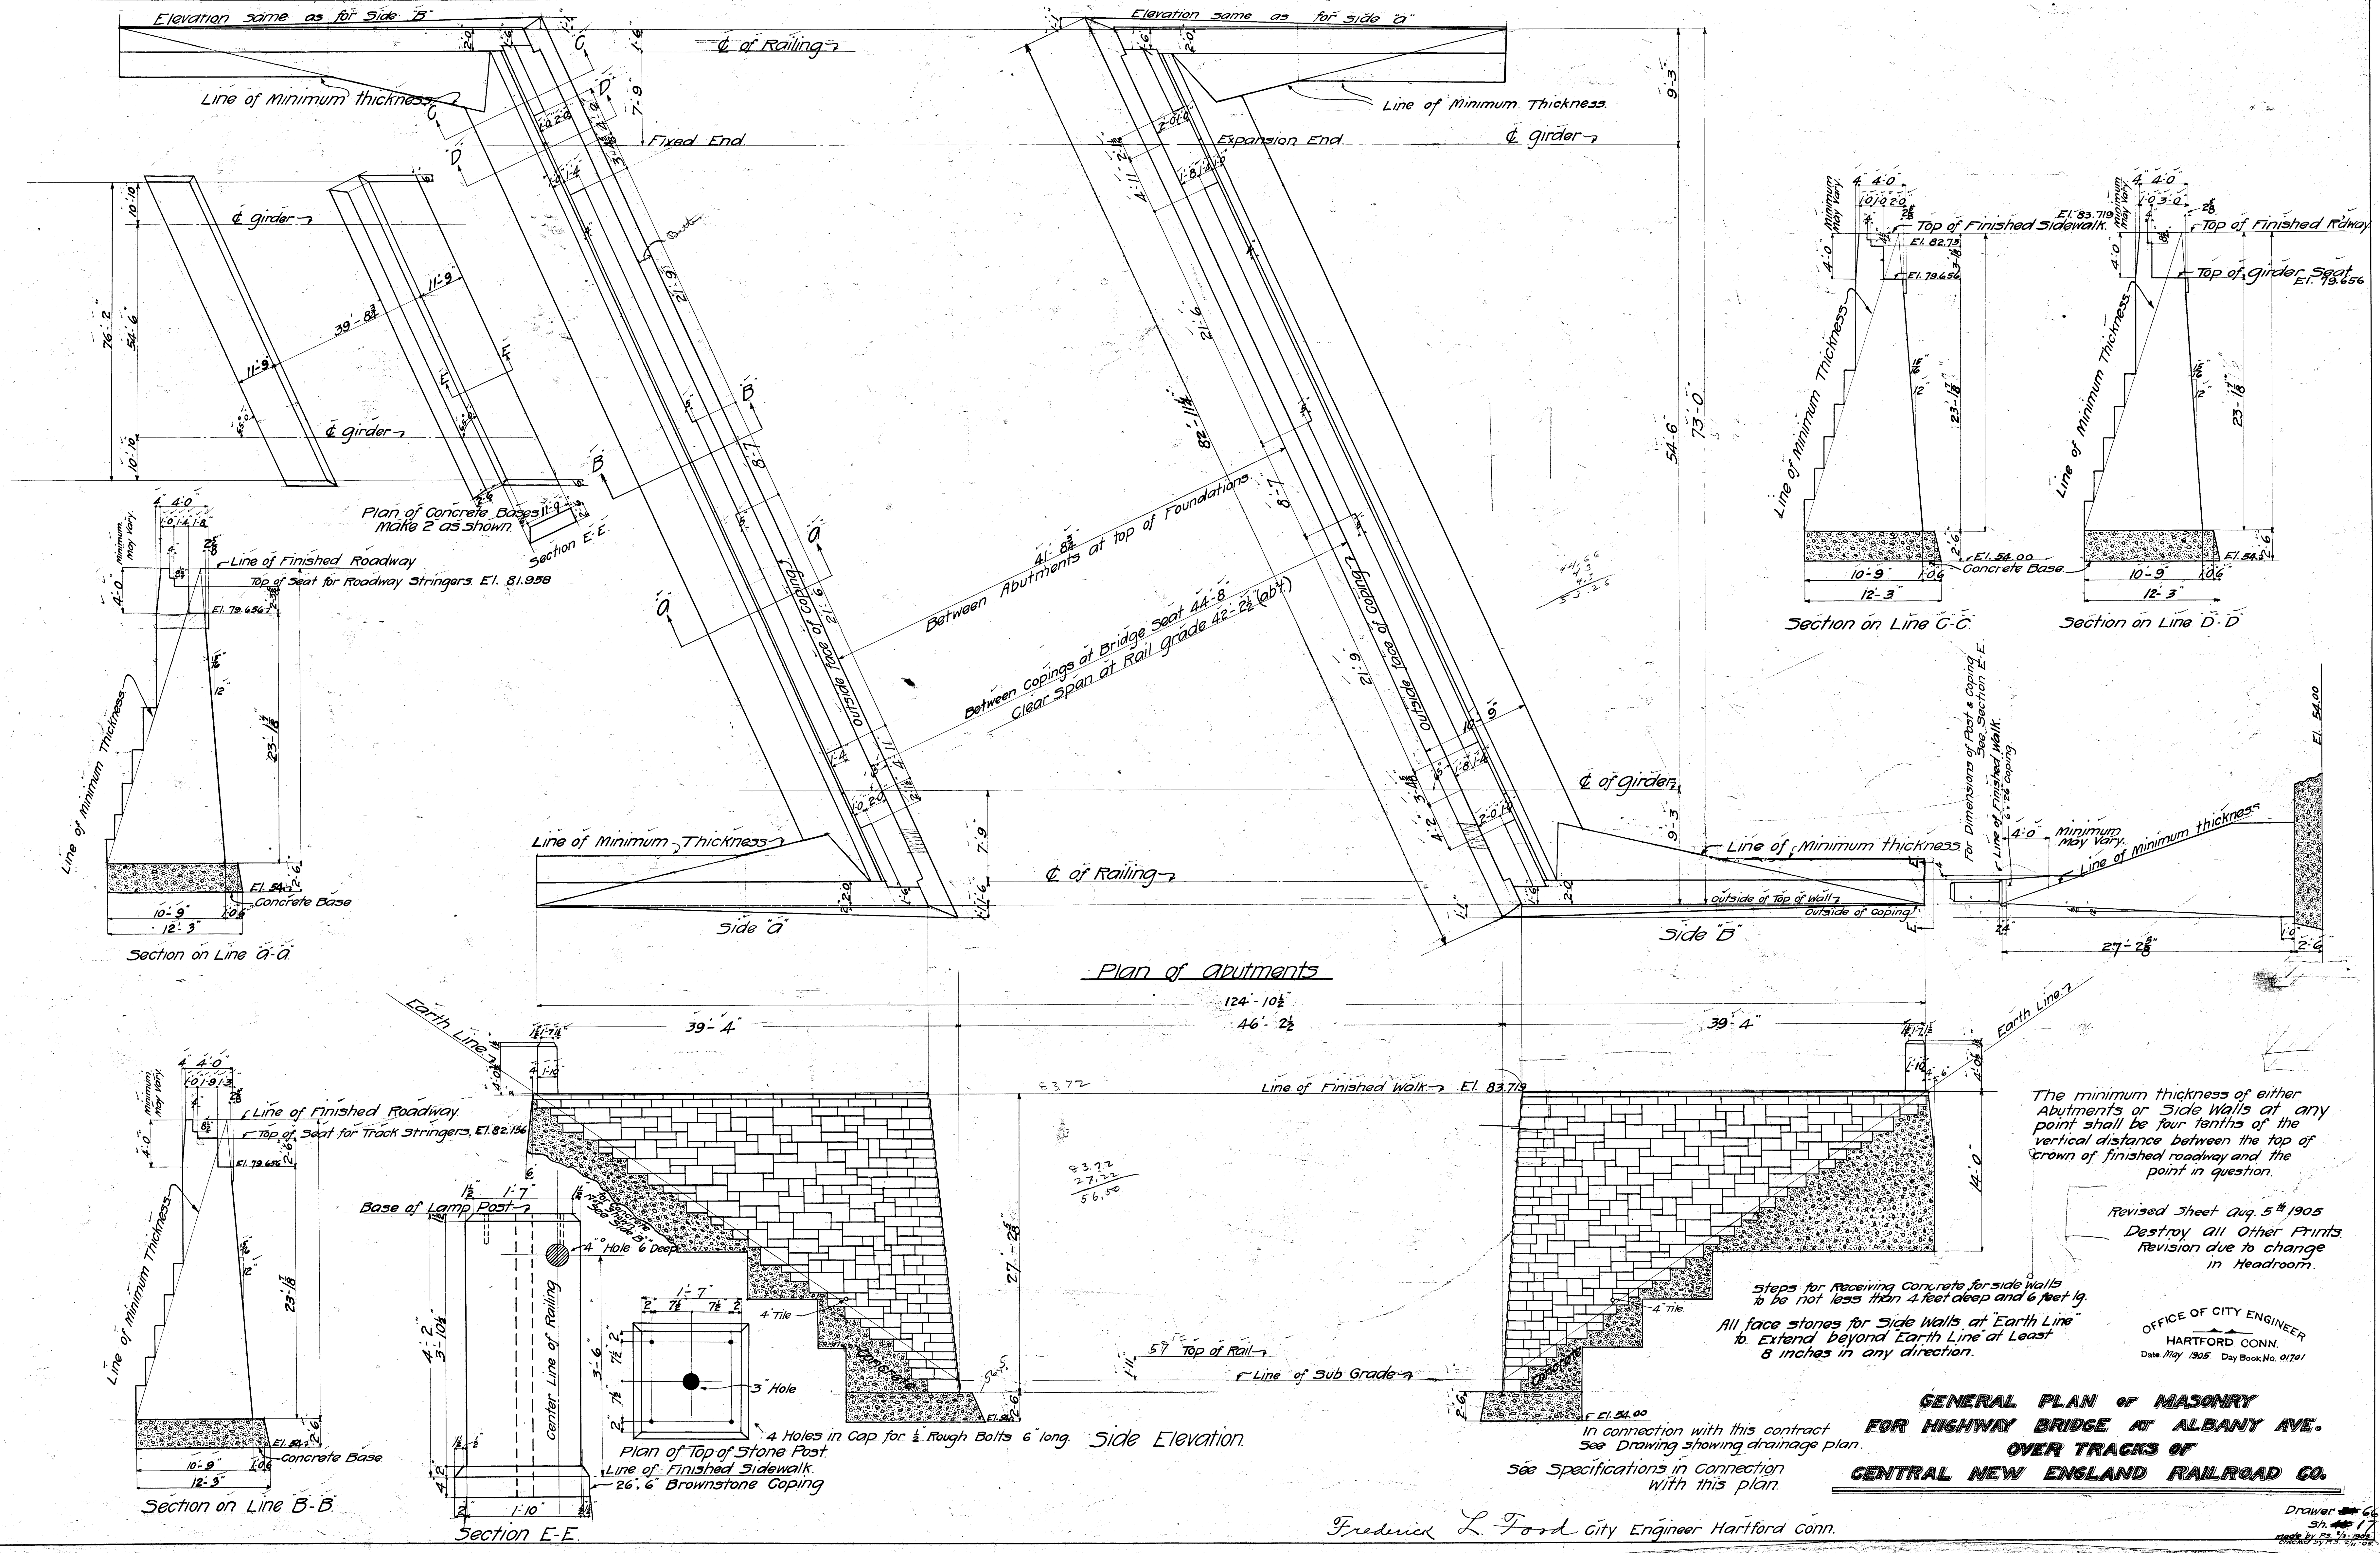

The minimum thickness of either Abutments or Side Walls at any point shall be four tenths of the vertical distance between the top of crown of finished roadway and the point in question.

Revised Sheet Aug. 5th 1905
Destroy all other Prints
Revision due to change
in Headroom.

Steps for receiving concrete for side walls
to be not less than 4 feet deep and 6 feet lg.
All face stones for Side Walls at Earth Line
to extend beyond Earth Line at least
8 inches in any direction.

**GENERAL PLAN of MASONRY
FOR HIGHWAY BRIDGE at ALBANY AVE.
OVER TRACKS of
CENTRAL NEW ENGLAND RAILROAD CO.**

Frederick L. Ford City Engineer Hartford Conn.

OFFICE OF CITY ENGINEER
HARTFORD CONN.
Date May 1905. Day Book No. 01701

Drawer 66
Sh. 17
Marked by J. H. Ford