


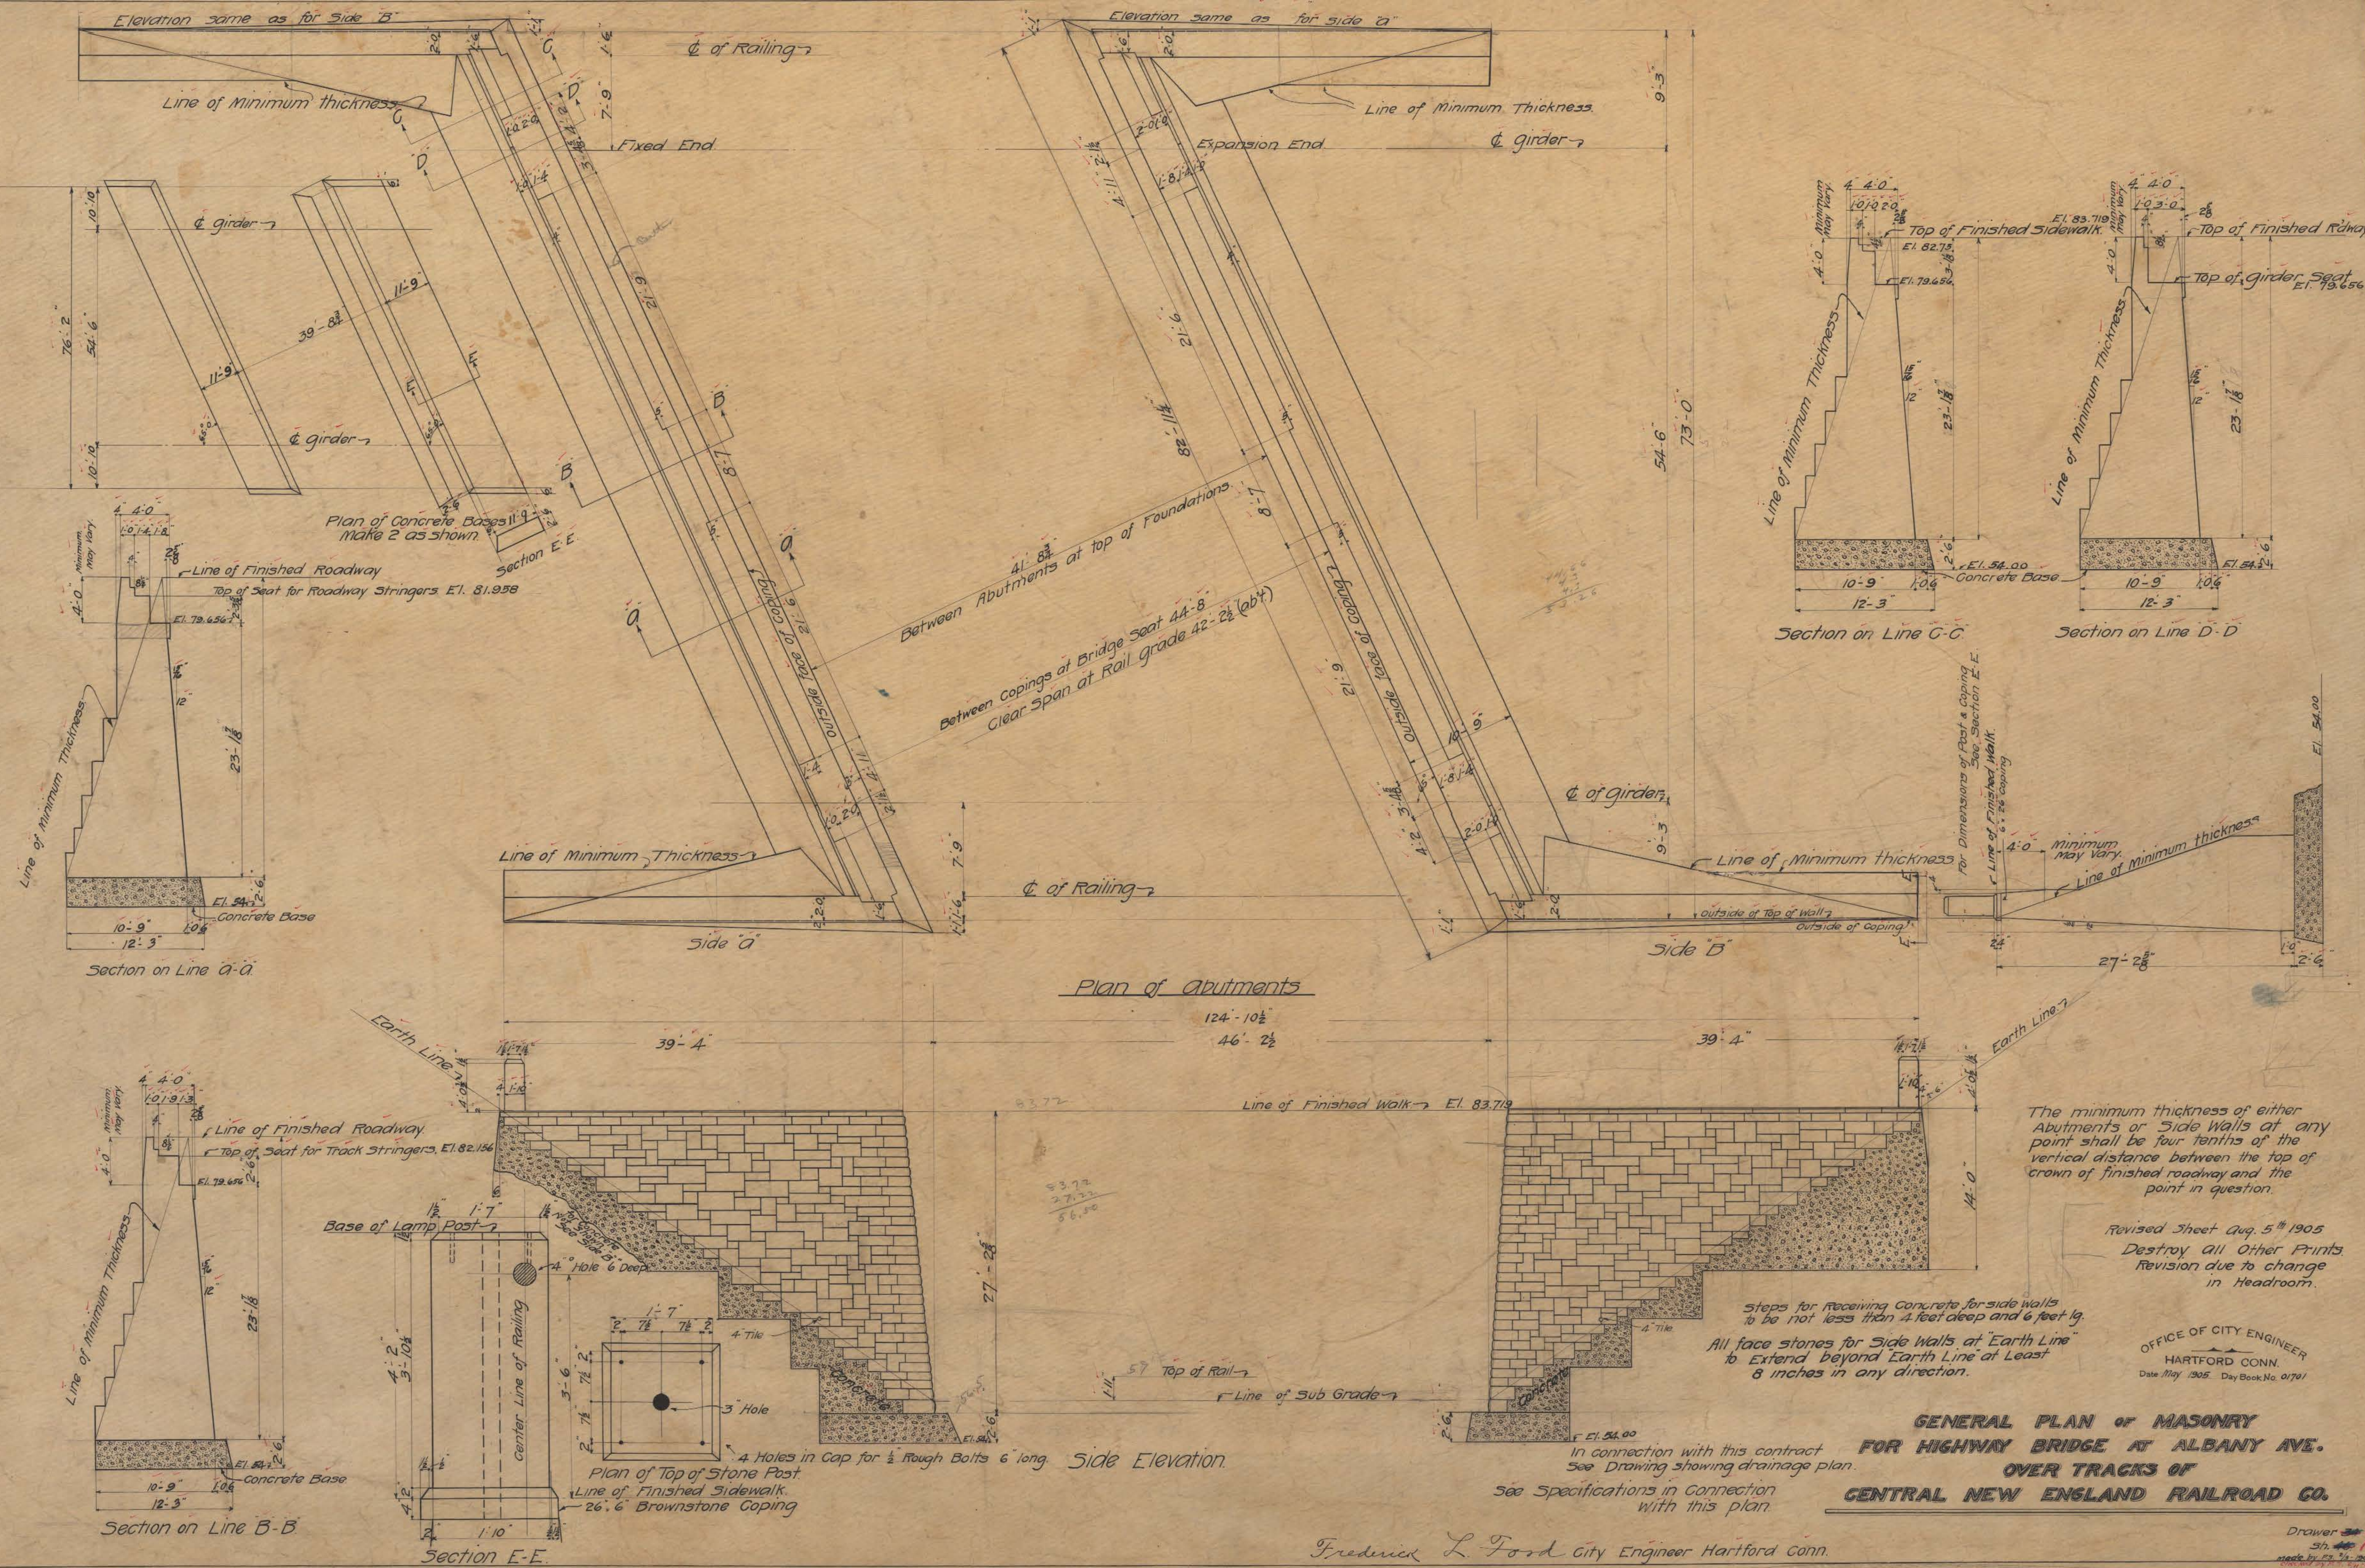

The minimum thickness of either Abutments or Side Walls at any point shall be four tenths of the vertical distance between the top of crown of finished roadway and the point in question.

Revised Sheet Aug. 5th 1905
Destroy all Other Prints.
Revision due to change in Headroom.

OFFICE OF CITY ENGINEER
HARTFORD CONN.
Date May 1905 Day Book No. 01701

**GENERAL PLAN OF MASONRY
FOR HIGHWAY BRIDGE AT ALBANY AVE.
OVER TRACKS OF
CENTRAL NEW ENGLAND RAILROAD CO.**

In connection with this contract
See Drawing showing drainage plan.
See Specifications in connection
with this plan.

Frederick L. Ford City Engineer Hartford Conn.

Drawer 36
Sh. 17
made by F. L. Ford
checked by F. L. Ford