
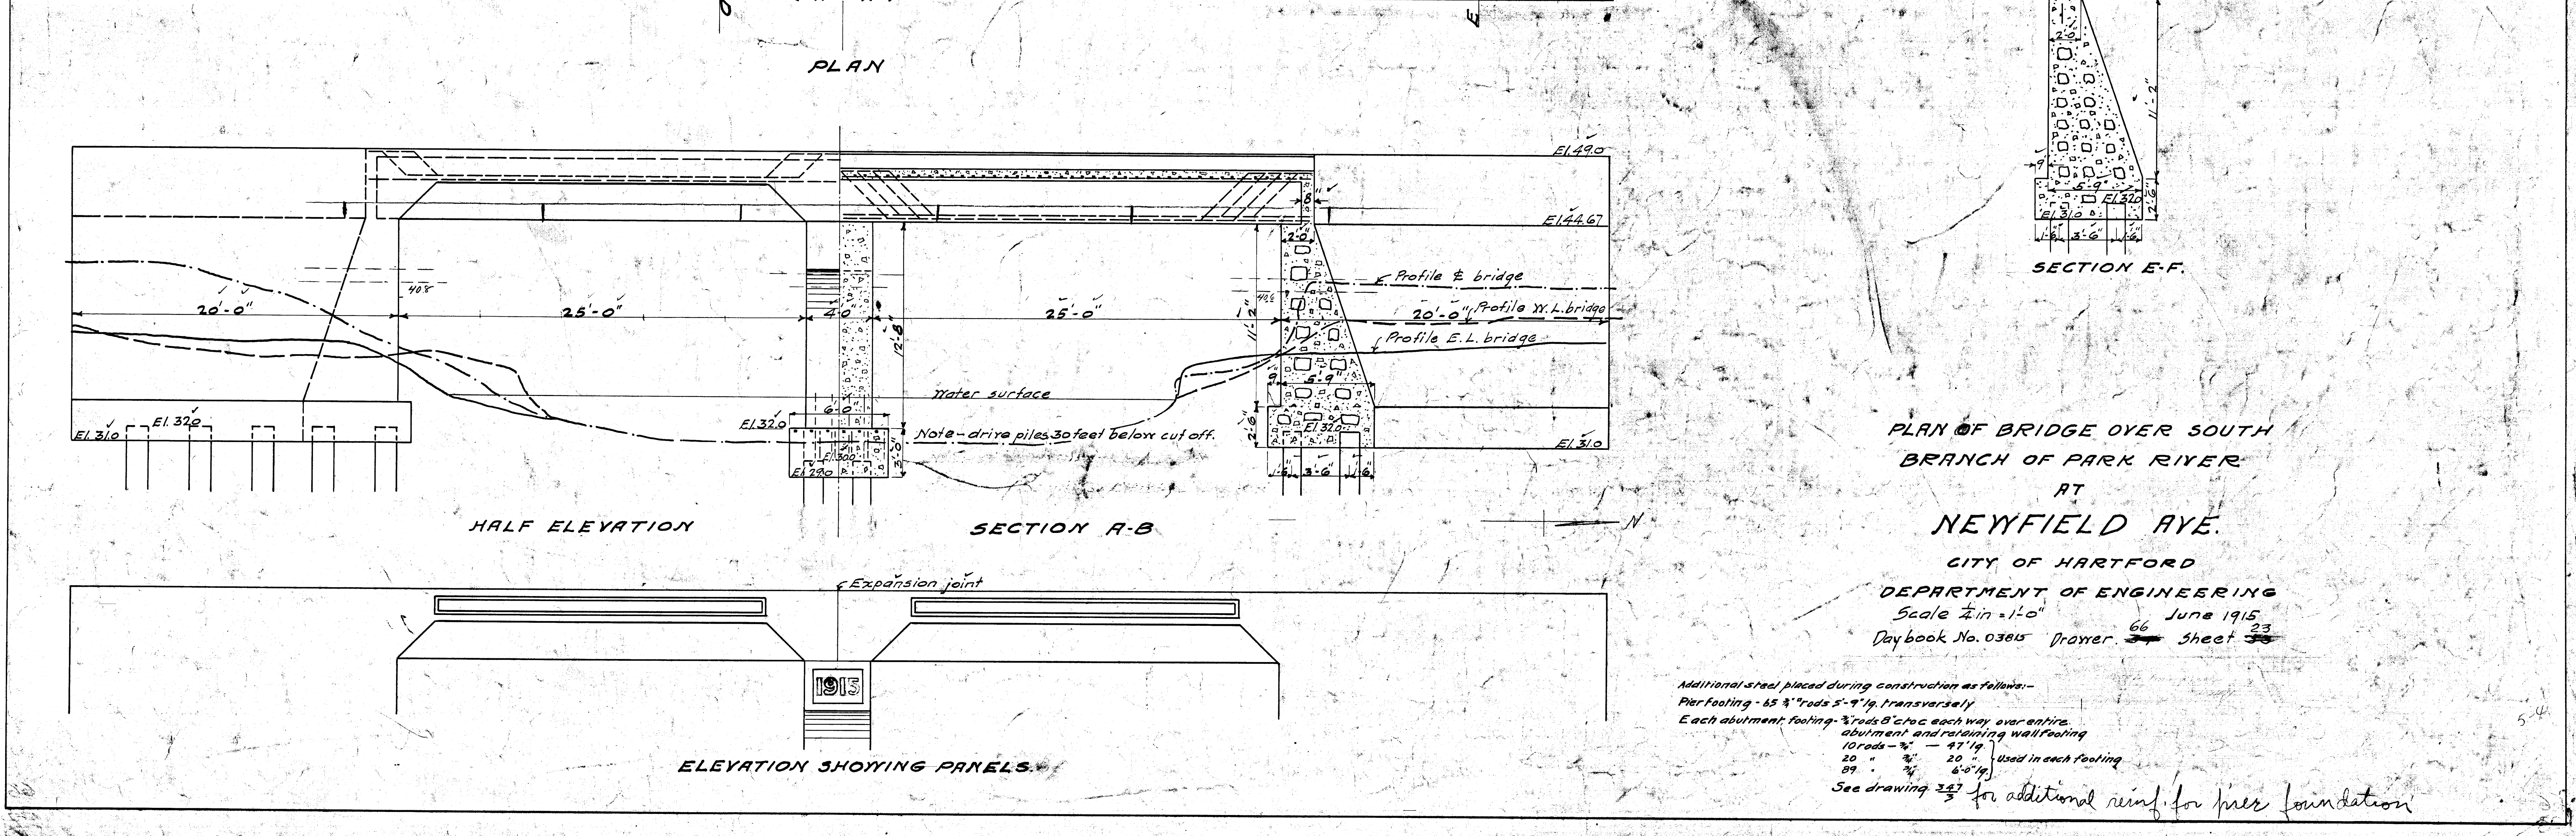


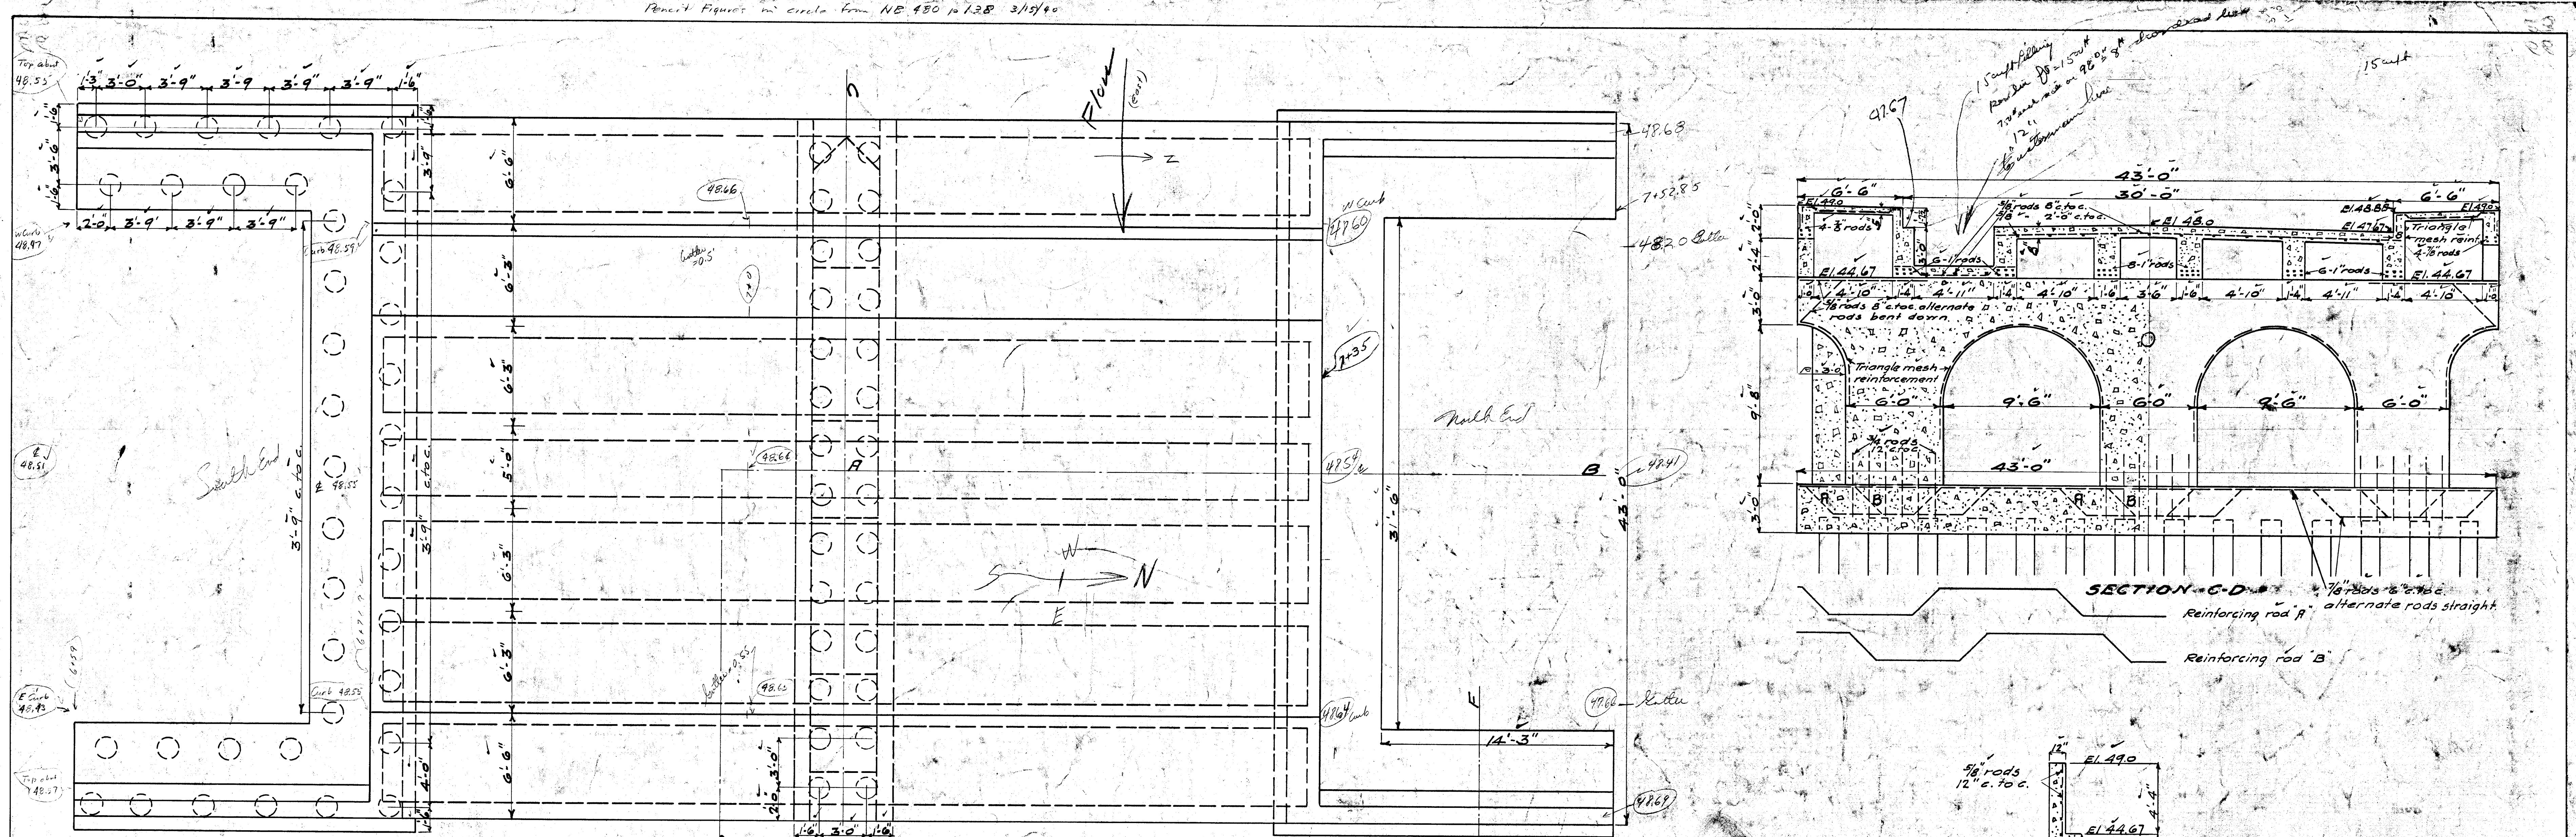

Additional steel placed during construction as follows:-
 Pier footing - 65 % "rods 5'-9" lg. transversely
 Each abutment footing - 3 rods 8' o.c. each way over entire
 abutment and retaining wall footing
 10 rods - 3" - 47' lg.
 20 " 3" - 20 " lg.
 89 " 2" - 4'-6" lg. } Used in each footing
 See drawing 347 for additional reinf. for pier foundation