


Out of Service Dec. 22 37

Out of Service, Dec. 22-37

Out of service, Dec. 22-1937

The House of the Good Shepherd of Hartford

19146
86 Sisson Ave
Harry W. Payne, East
Maria E. P. Meadows
Mary F. Payne

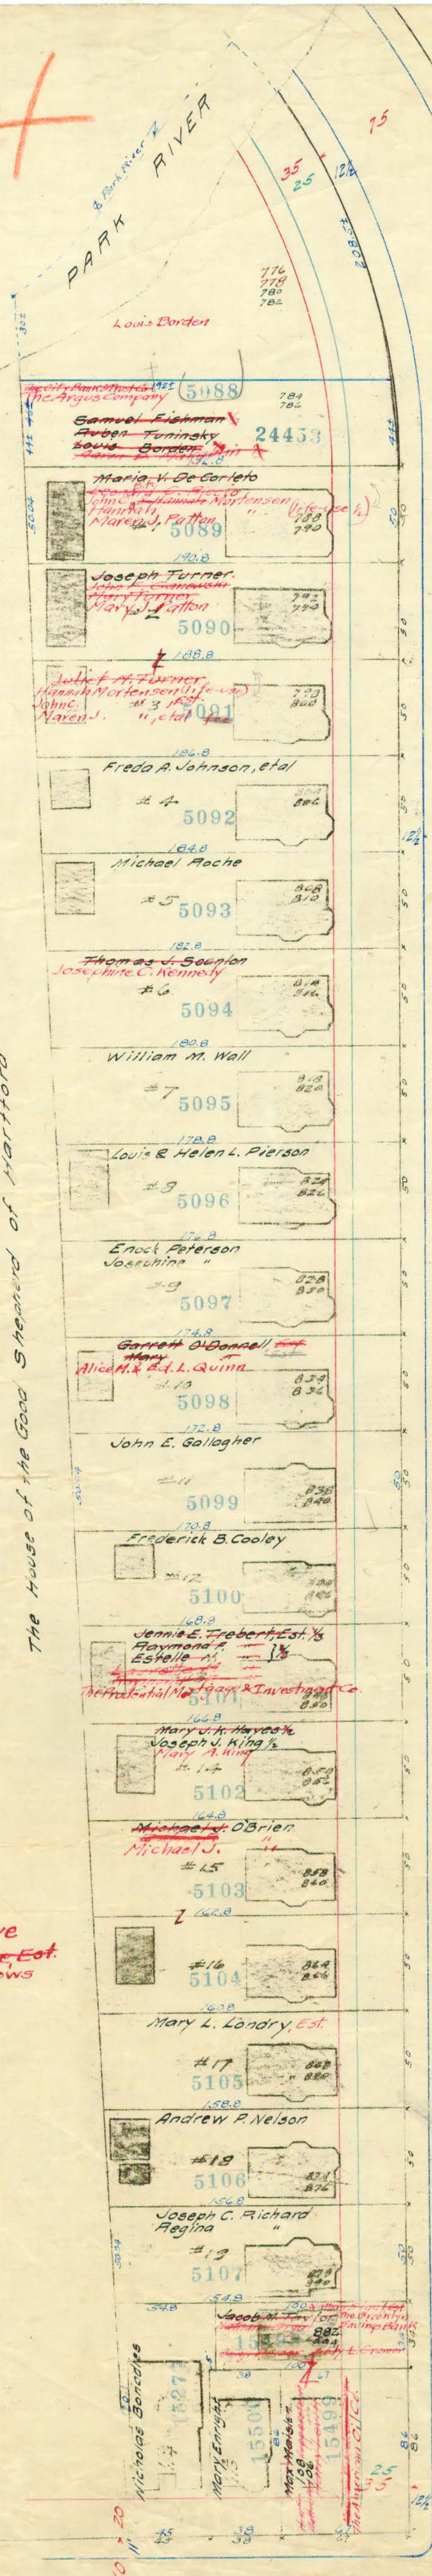

1937

Out of Service