


see sheet 67

The House of the Good Shepherd of Hartford

B.P.Co.	5088
John J. McKone	5089
John J. McKone	5090
B.P.Co. John C. Mortenson	5091
Robert A. McKone	5092
Robert A. McKone	5093
Robert A. McKone	5094
Robert A. McKone	5095
Robert A. McKone	5096
Robert A. McKone	5097
B.P.Co. Garrett O'Donnell	5098
John E. Gallagher	5099
B.P.Co. Gustaf A. Englund	5100
Francis Trebert	5101
B.P.Co. Gustaf A. Englund	5102
Francis Trebert	5103
Francis Trebert	5104
Francis Trebert	5105
Francis Trebert	5106
Francis Trebert	5107
Francis Trebert	5108
Francis Trebert	5109
Francis Trebert	5110

BOULEVARD

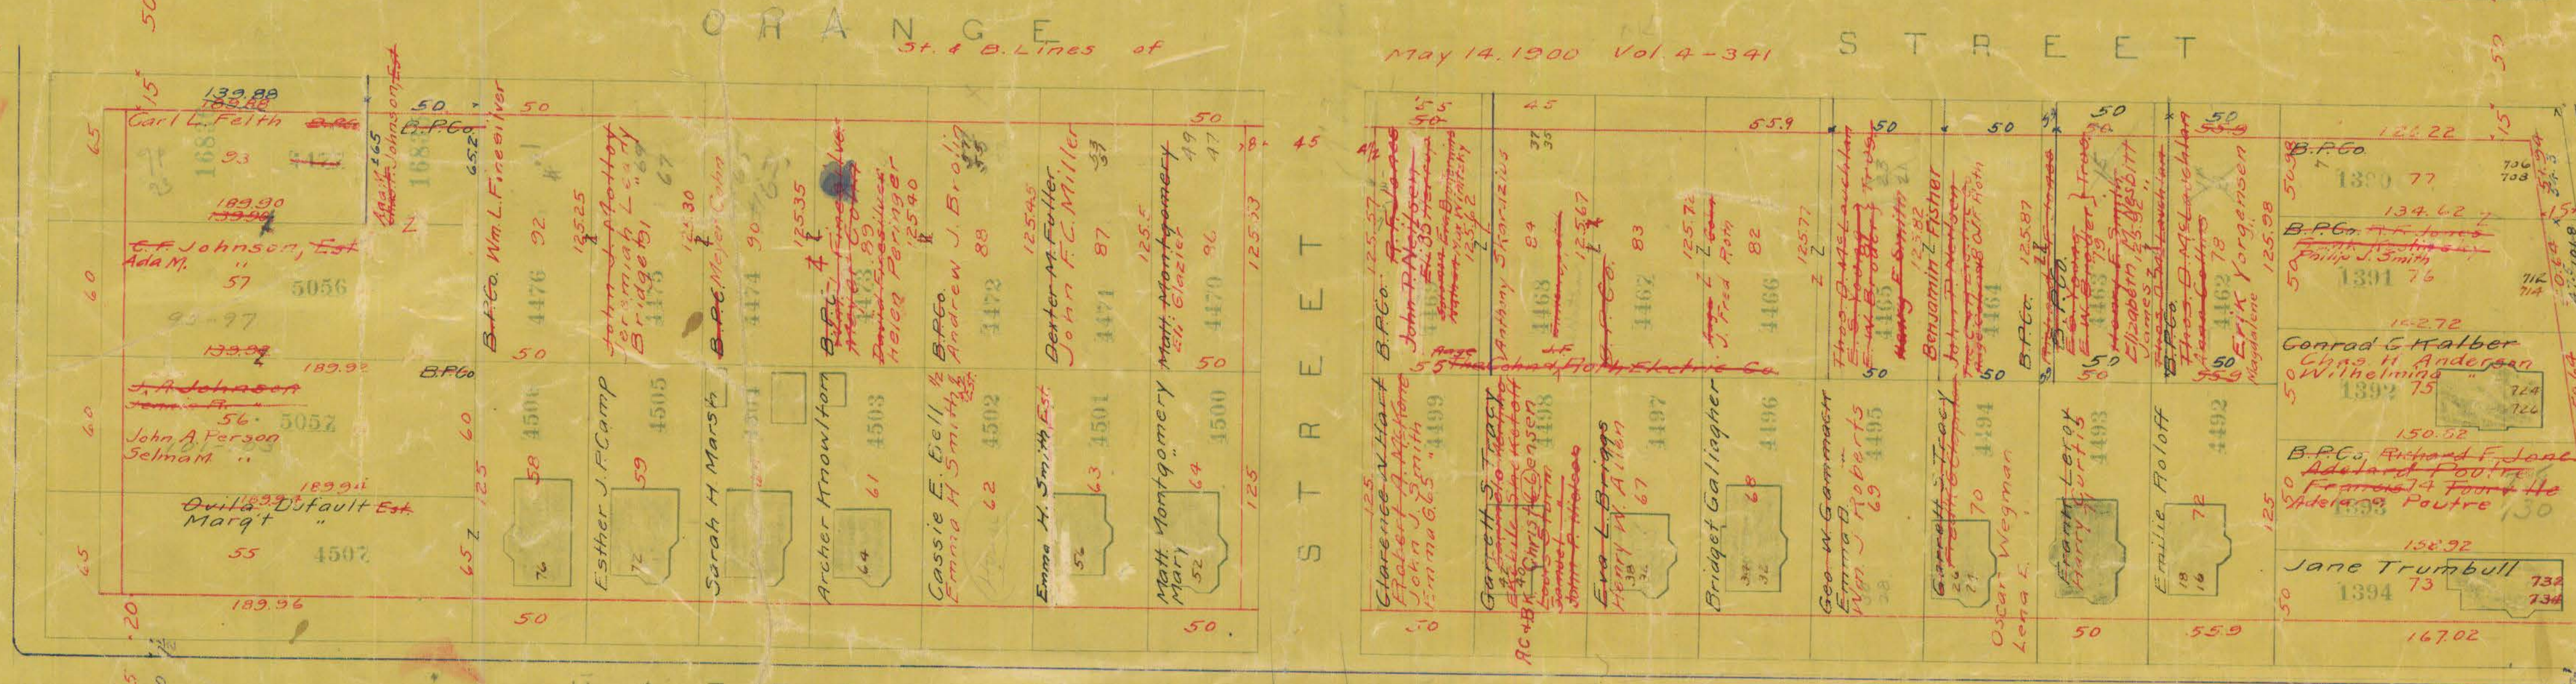

see sheet 65

see sheet 65