


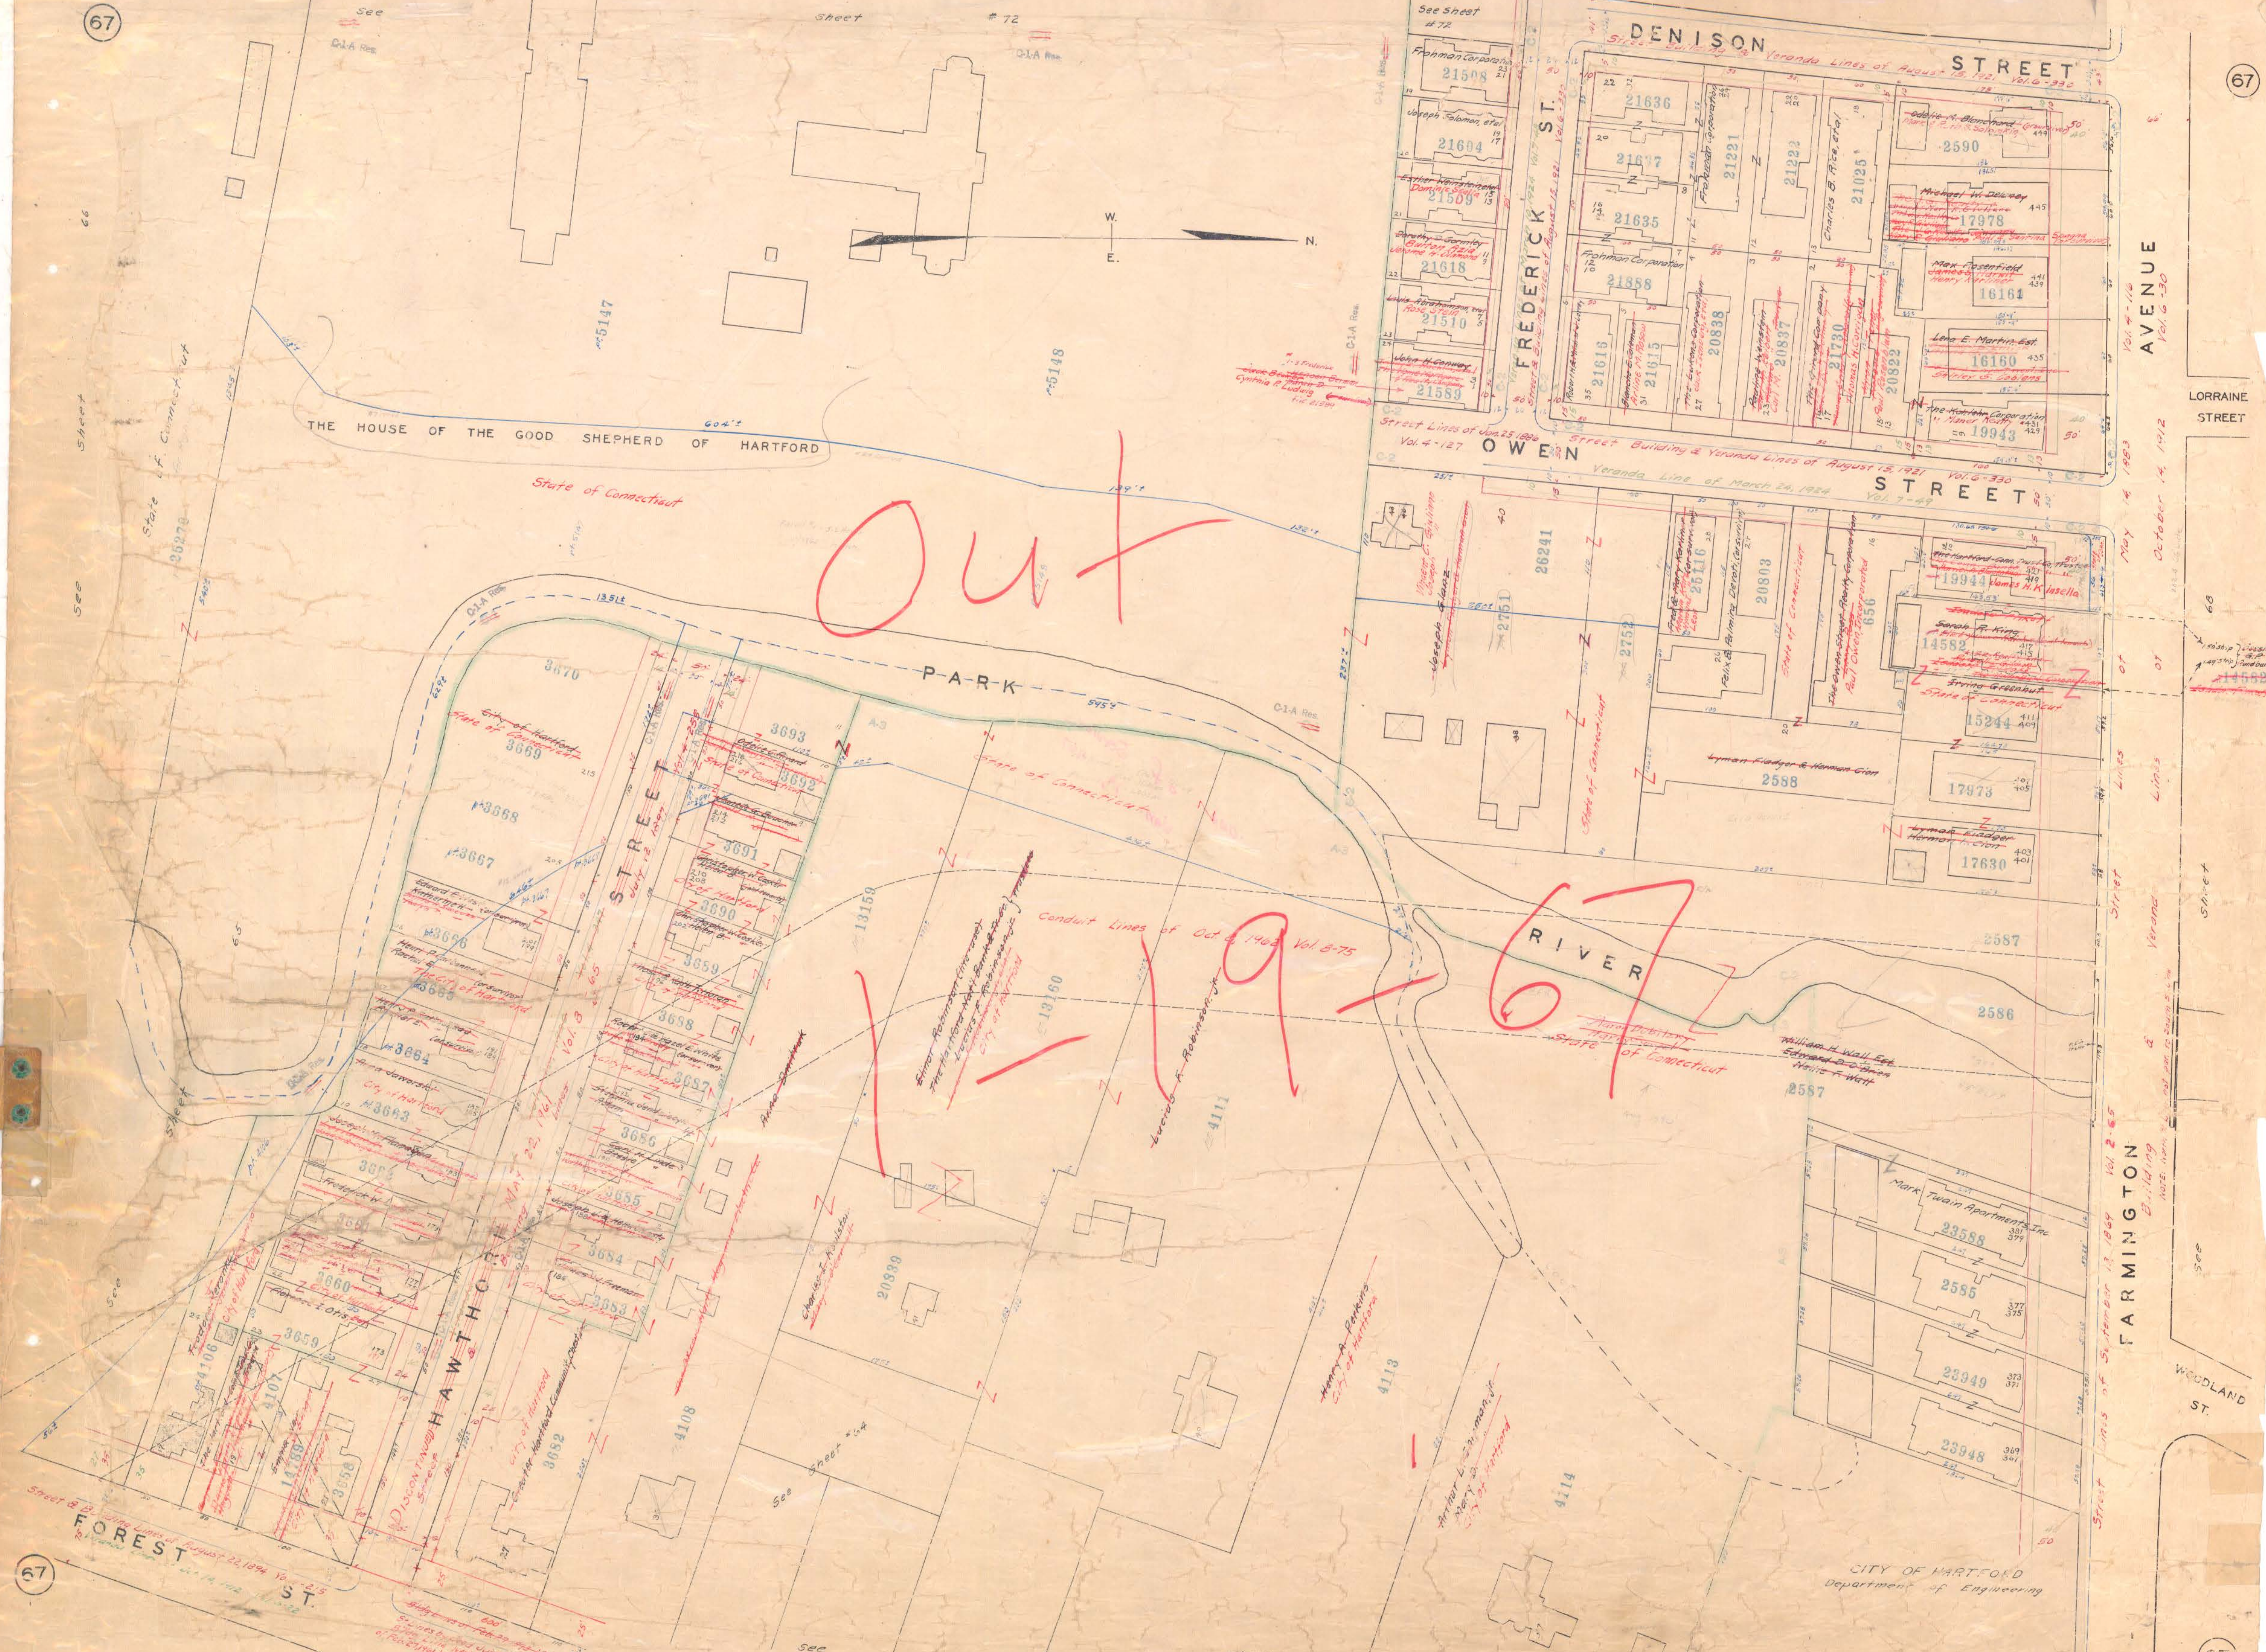

Out

1967

CITY OF HARTFORD
Department of Engineering