


Out of Service, Jan. 3-1941

Out of service Jan. 3-1941

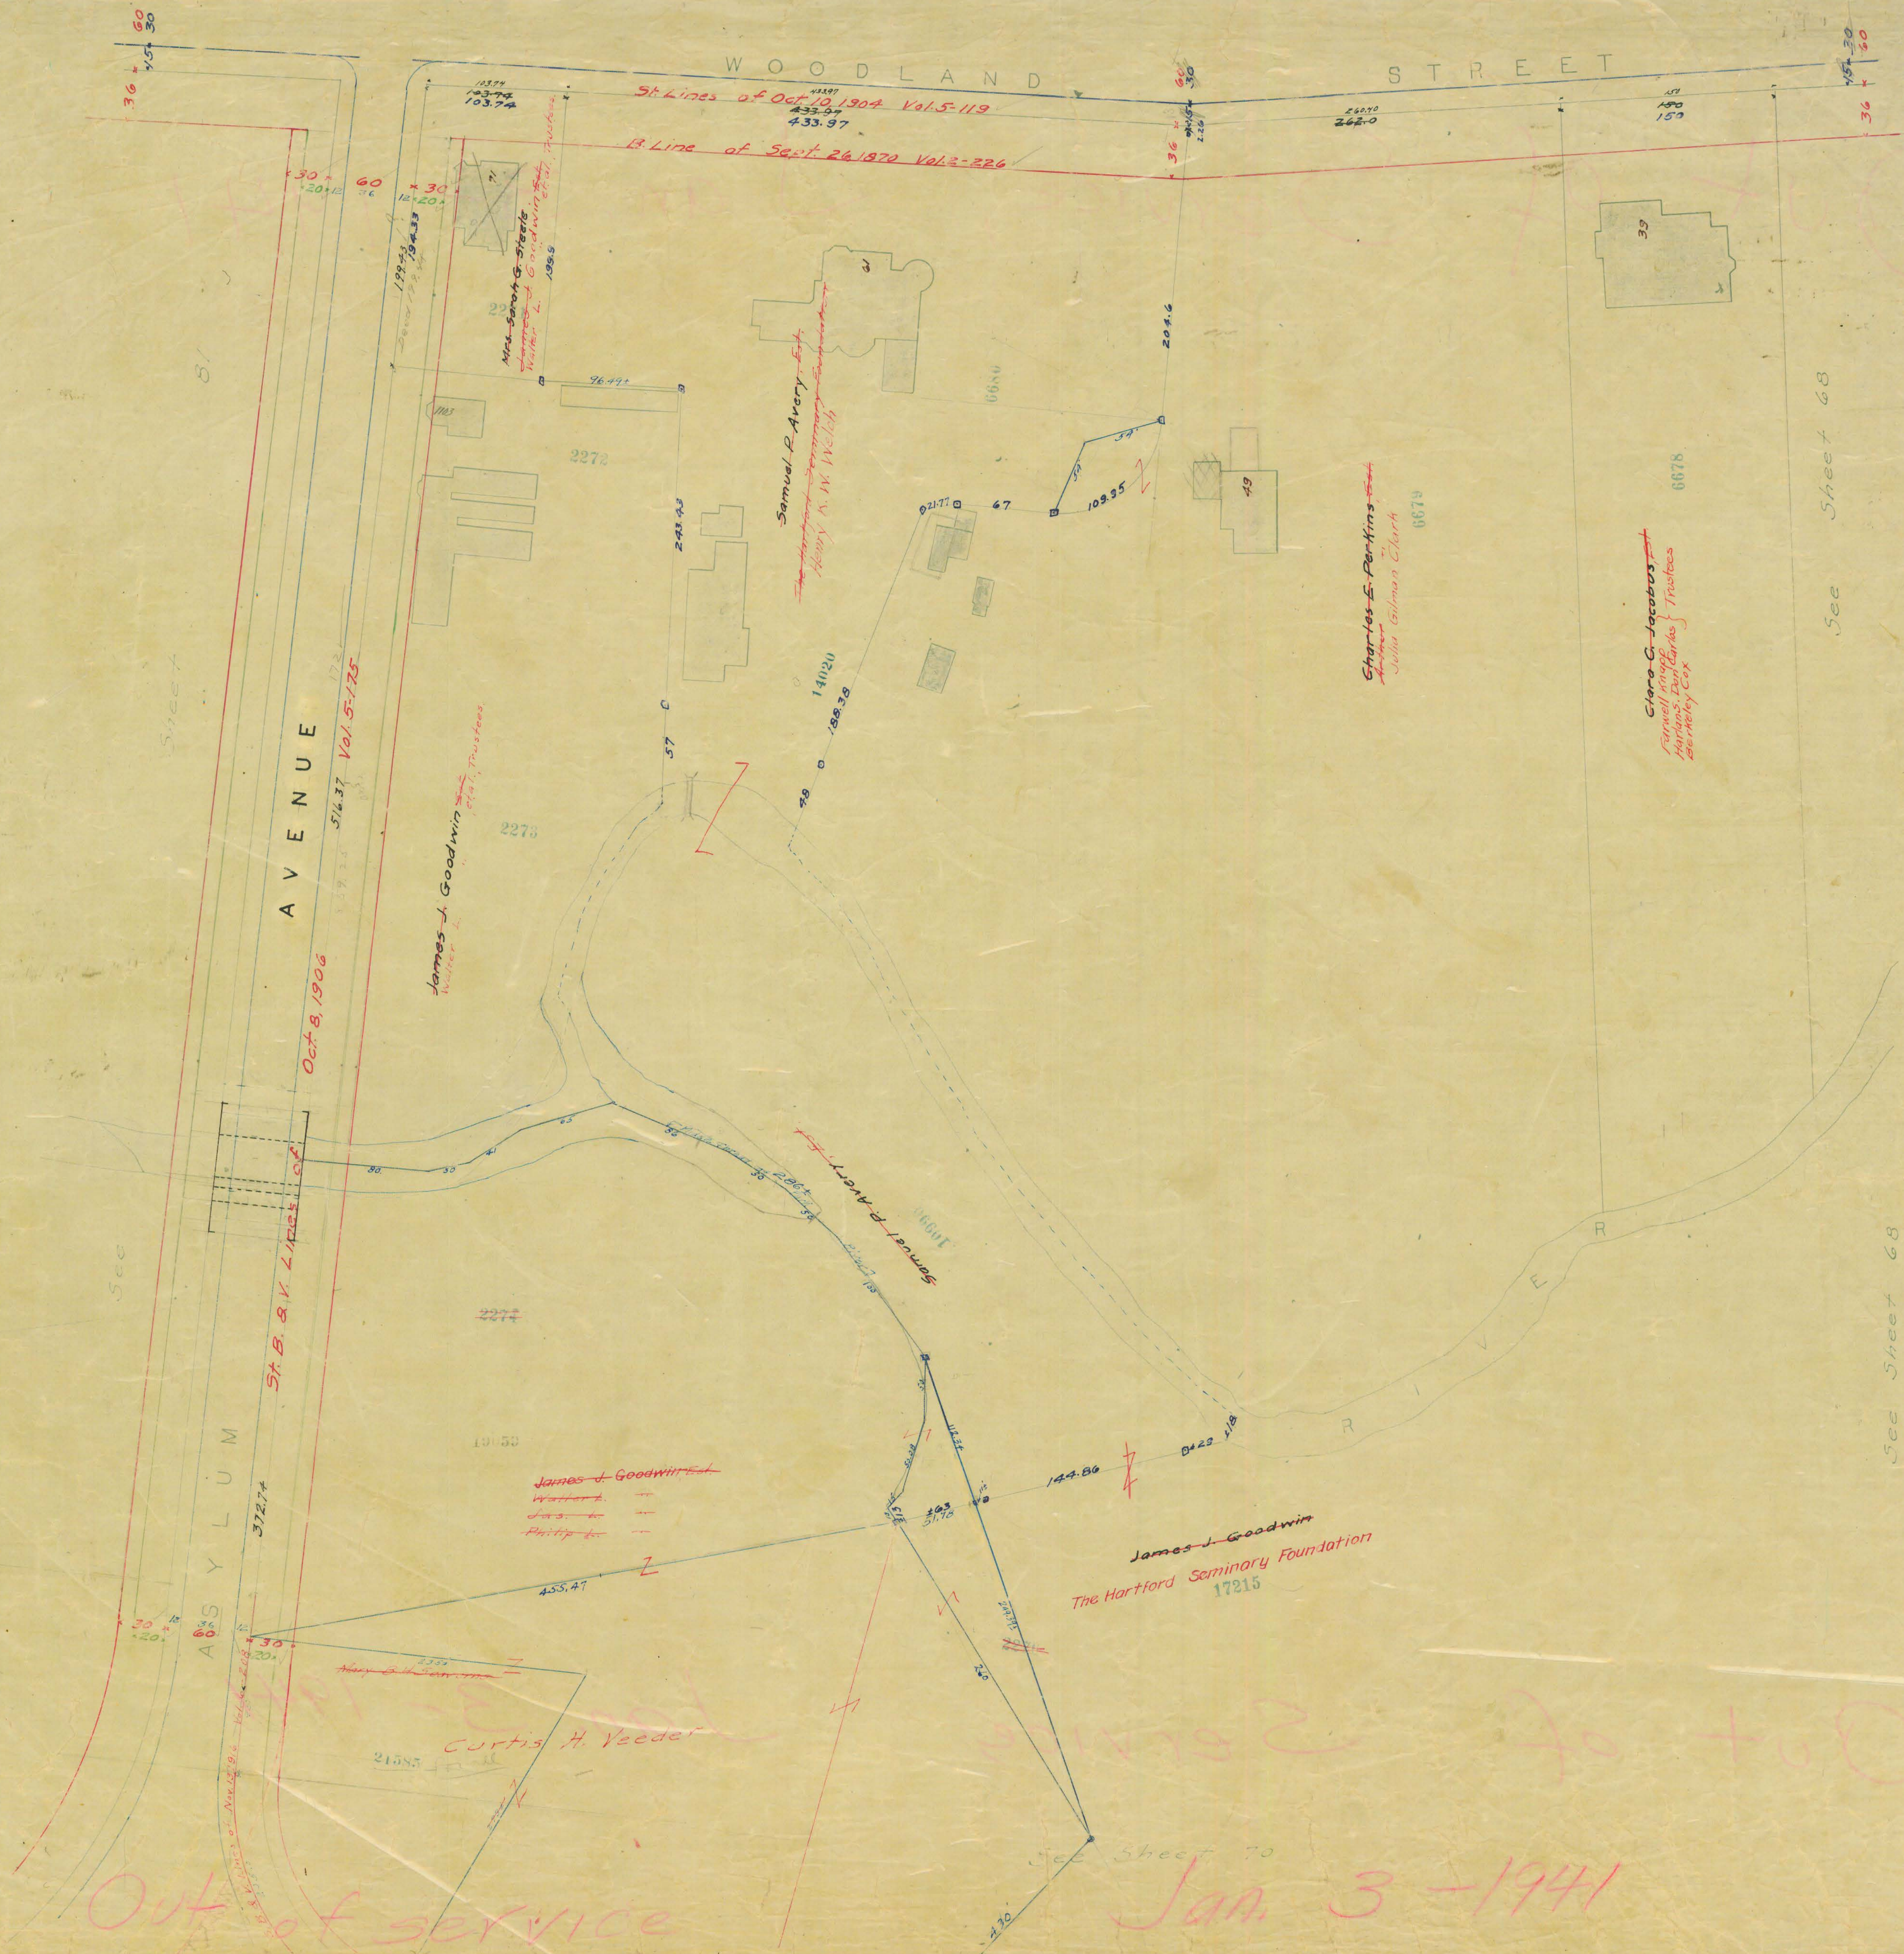

Out of Service, Jan. 3-1941