


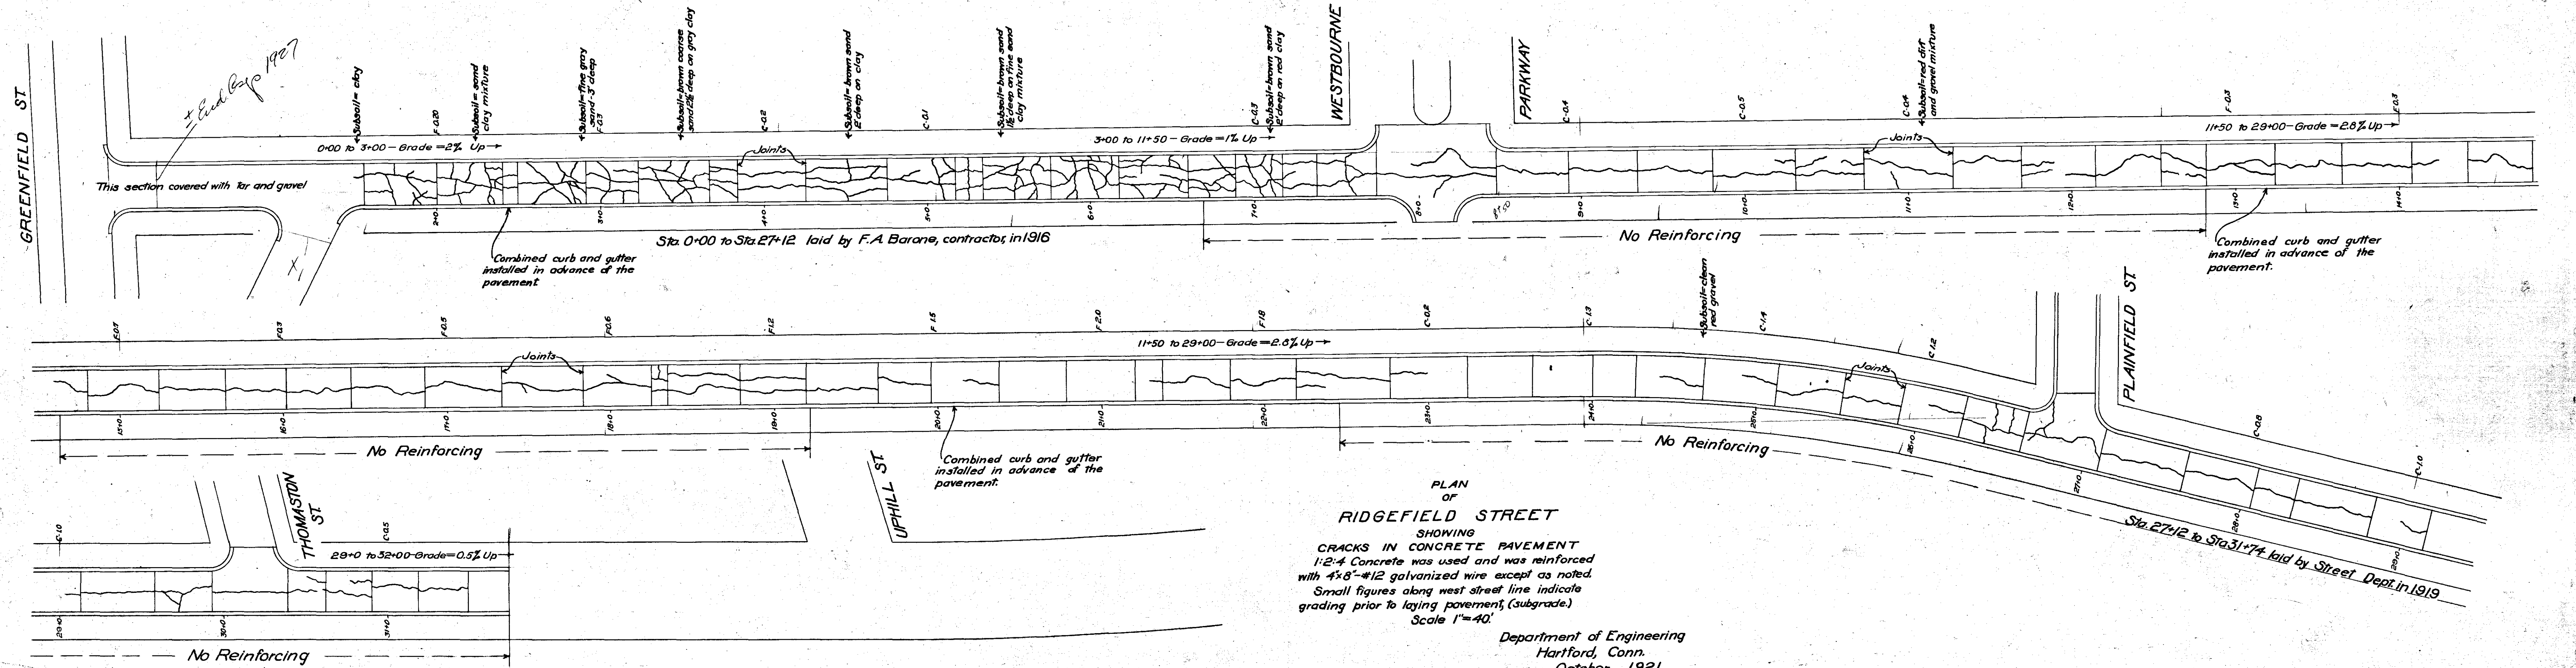

PLAN
OF
RIDGEFIELD STREET
SHOWING
CRACKS IN CONCRETE PAVEMENT
1:2:4 Concrete was used and was reinforced
with 4x8'-#12 galvanized wire except as noted.
Small figures along west street line indicate
grading prior to laying pavement, (subgrade.)
Scale 1"=40'

Department of Engineering
Hartford, Conn.
October 1921.
Day Book No. 05267.