
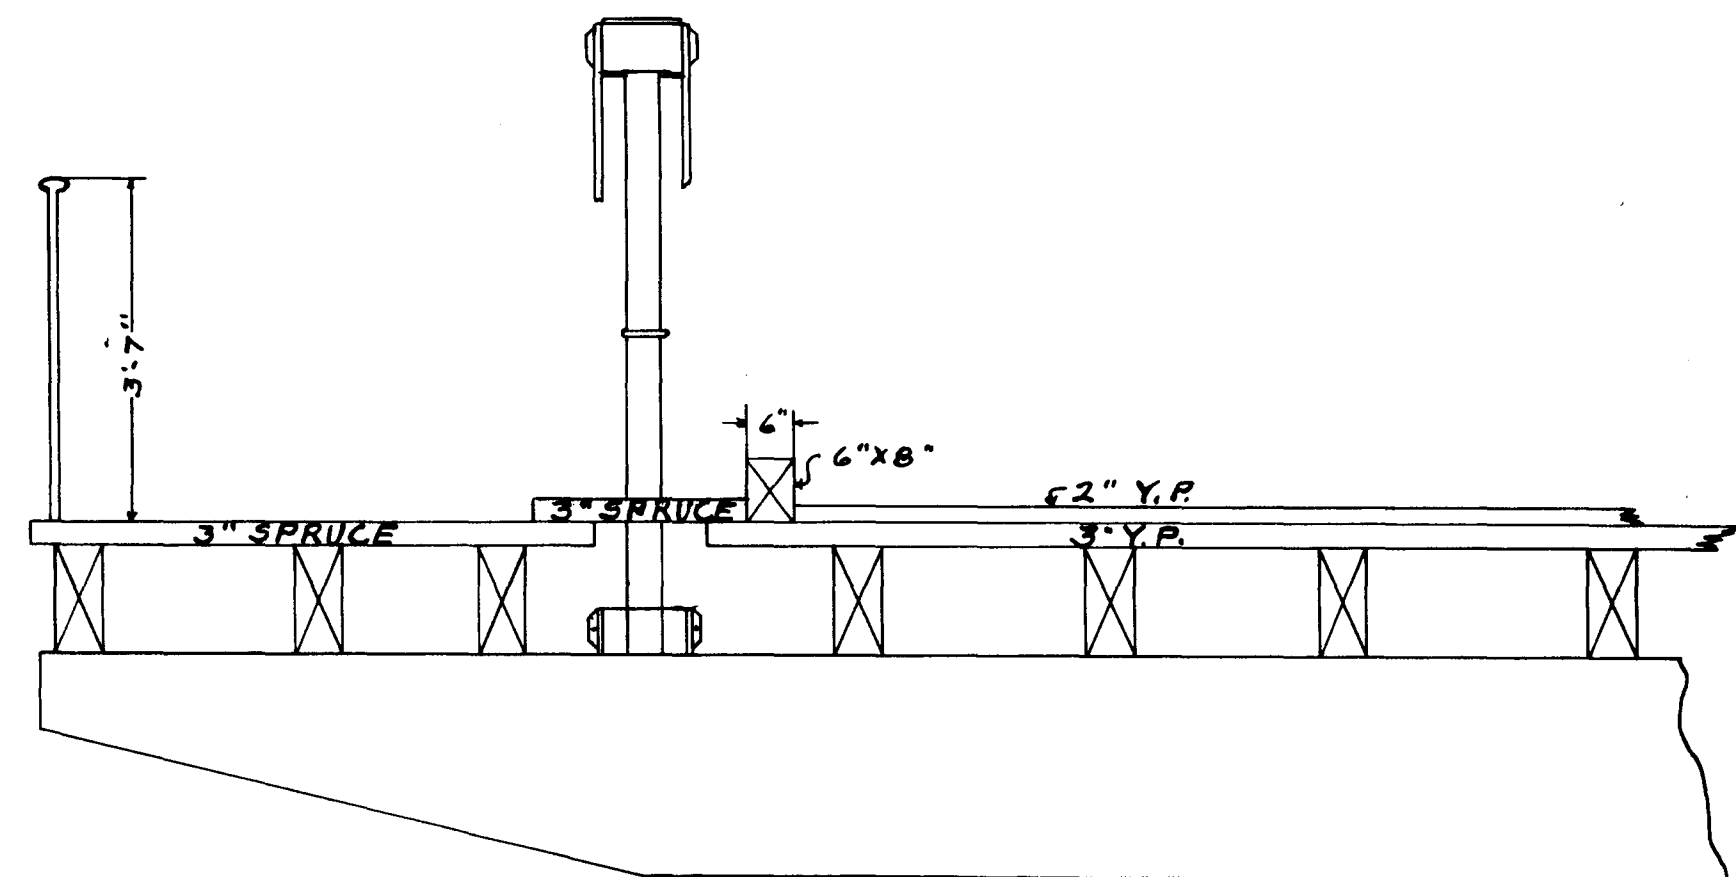
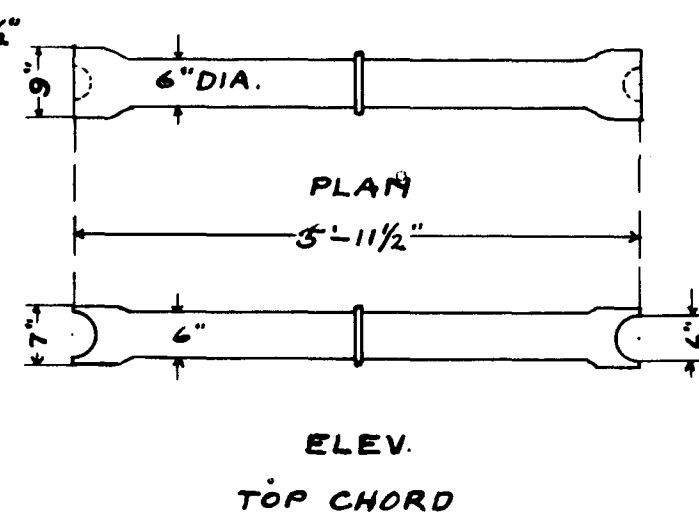
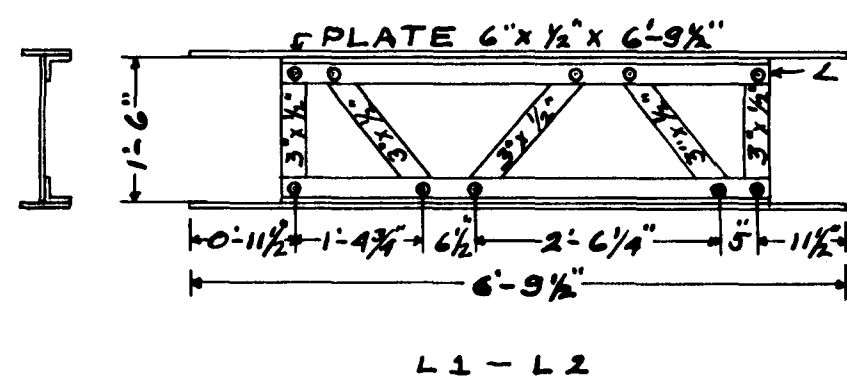


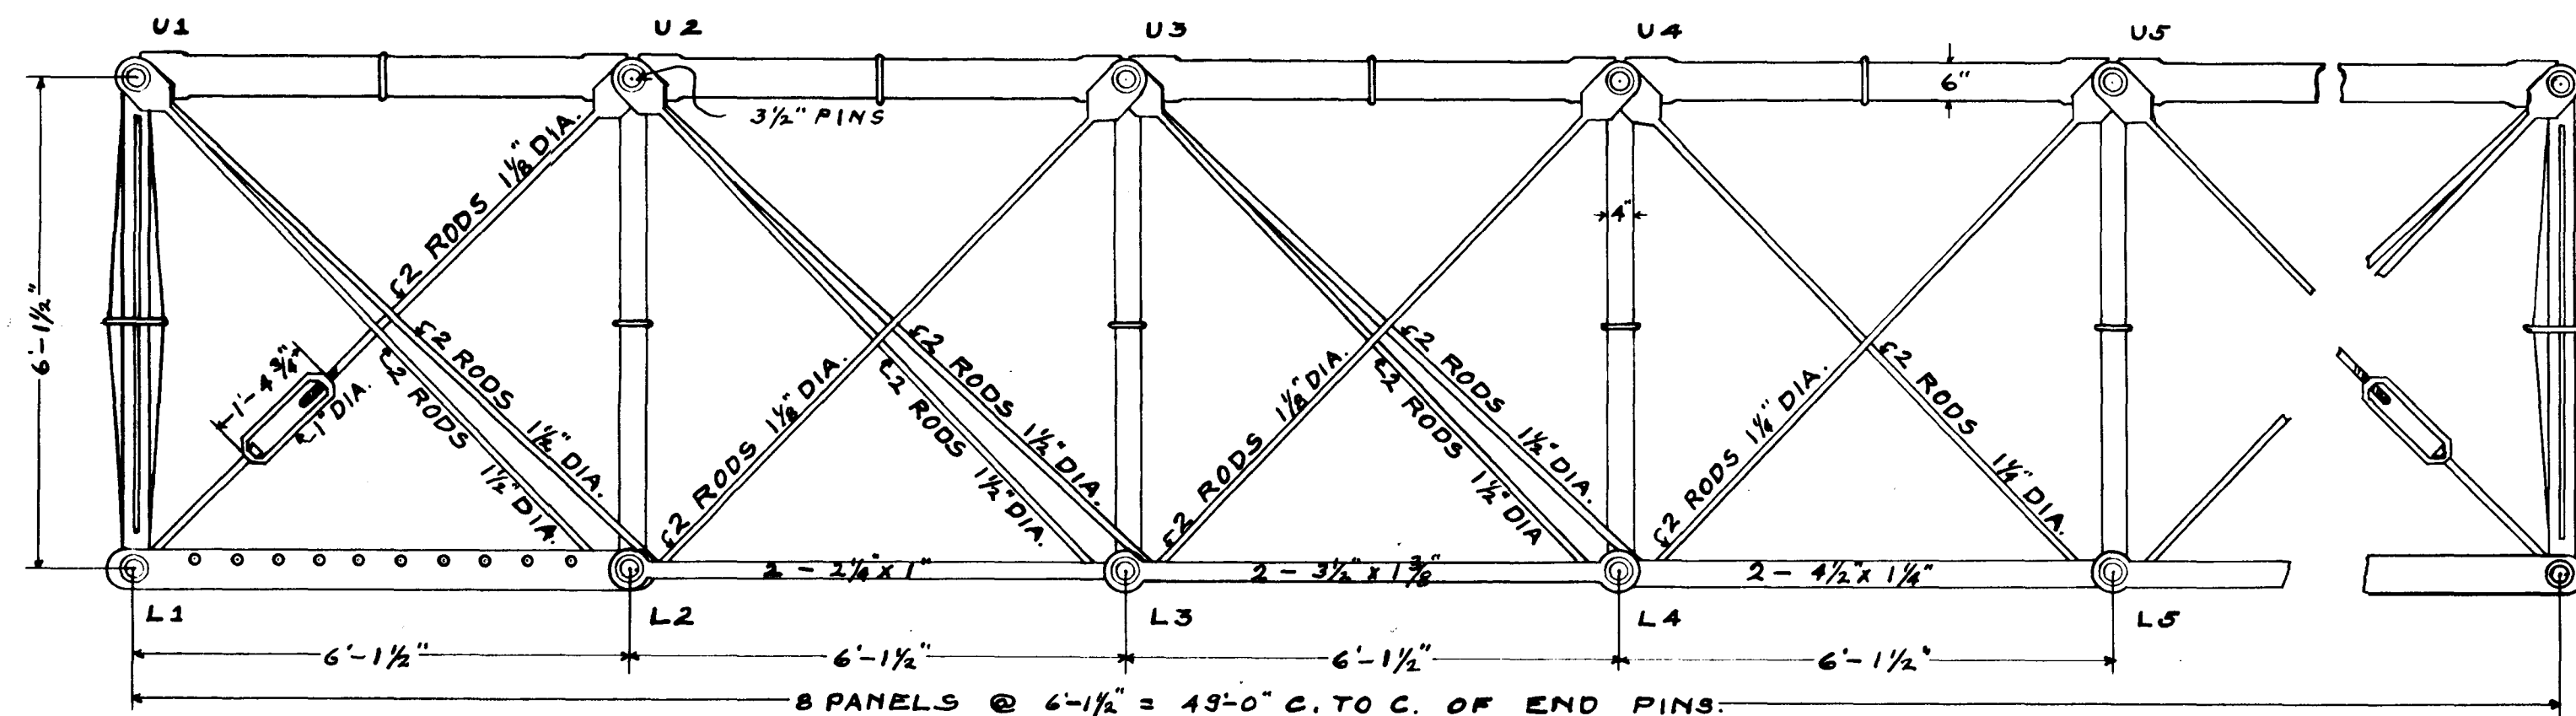

N.Y.N.H.&H.R.R.
 NEW HAVEN TO SPRINGFIELD
 BRIDGE No 35.64
 AT
 LAUREL STREET
 0.91 MILES SOUTH OF
 HARTFORD STA. CONN.
 SCALE 1/2" = 1'-0"
 NOVEMBER 14, 1924.

FROM FIELD MEASUREMENTS JUNE 27, 1924.
 A.S.W. CHECKED BY: J.W.S.

SHEET 2 OF 2 SHEETS.
 OPERATING DIVISION - HARTFORD.