


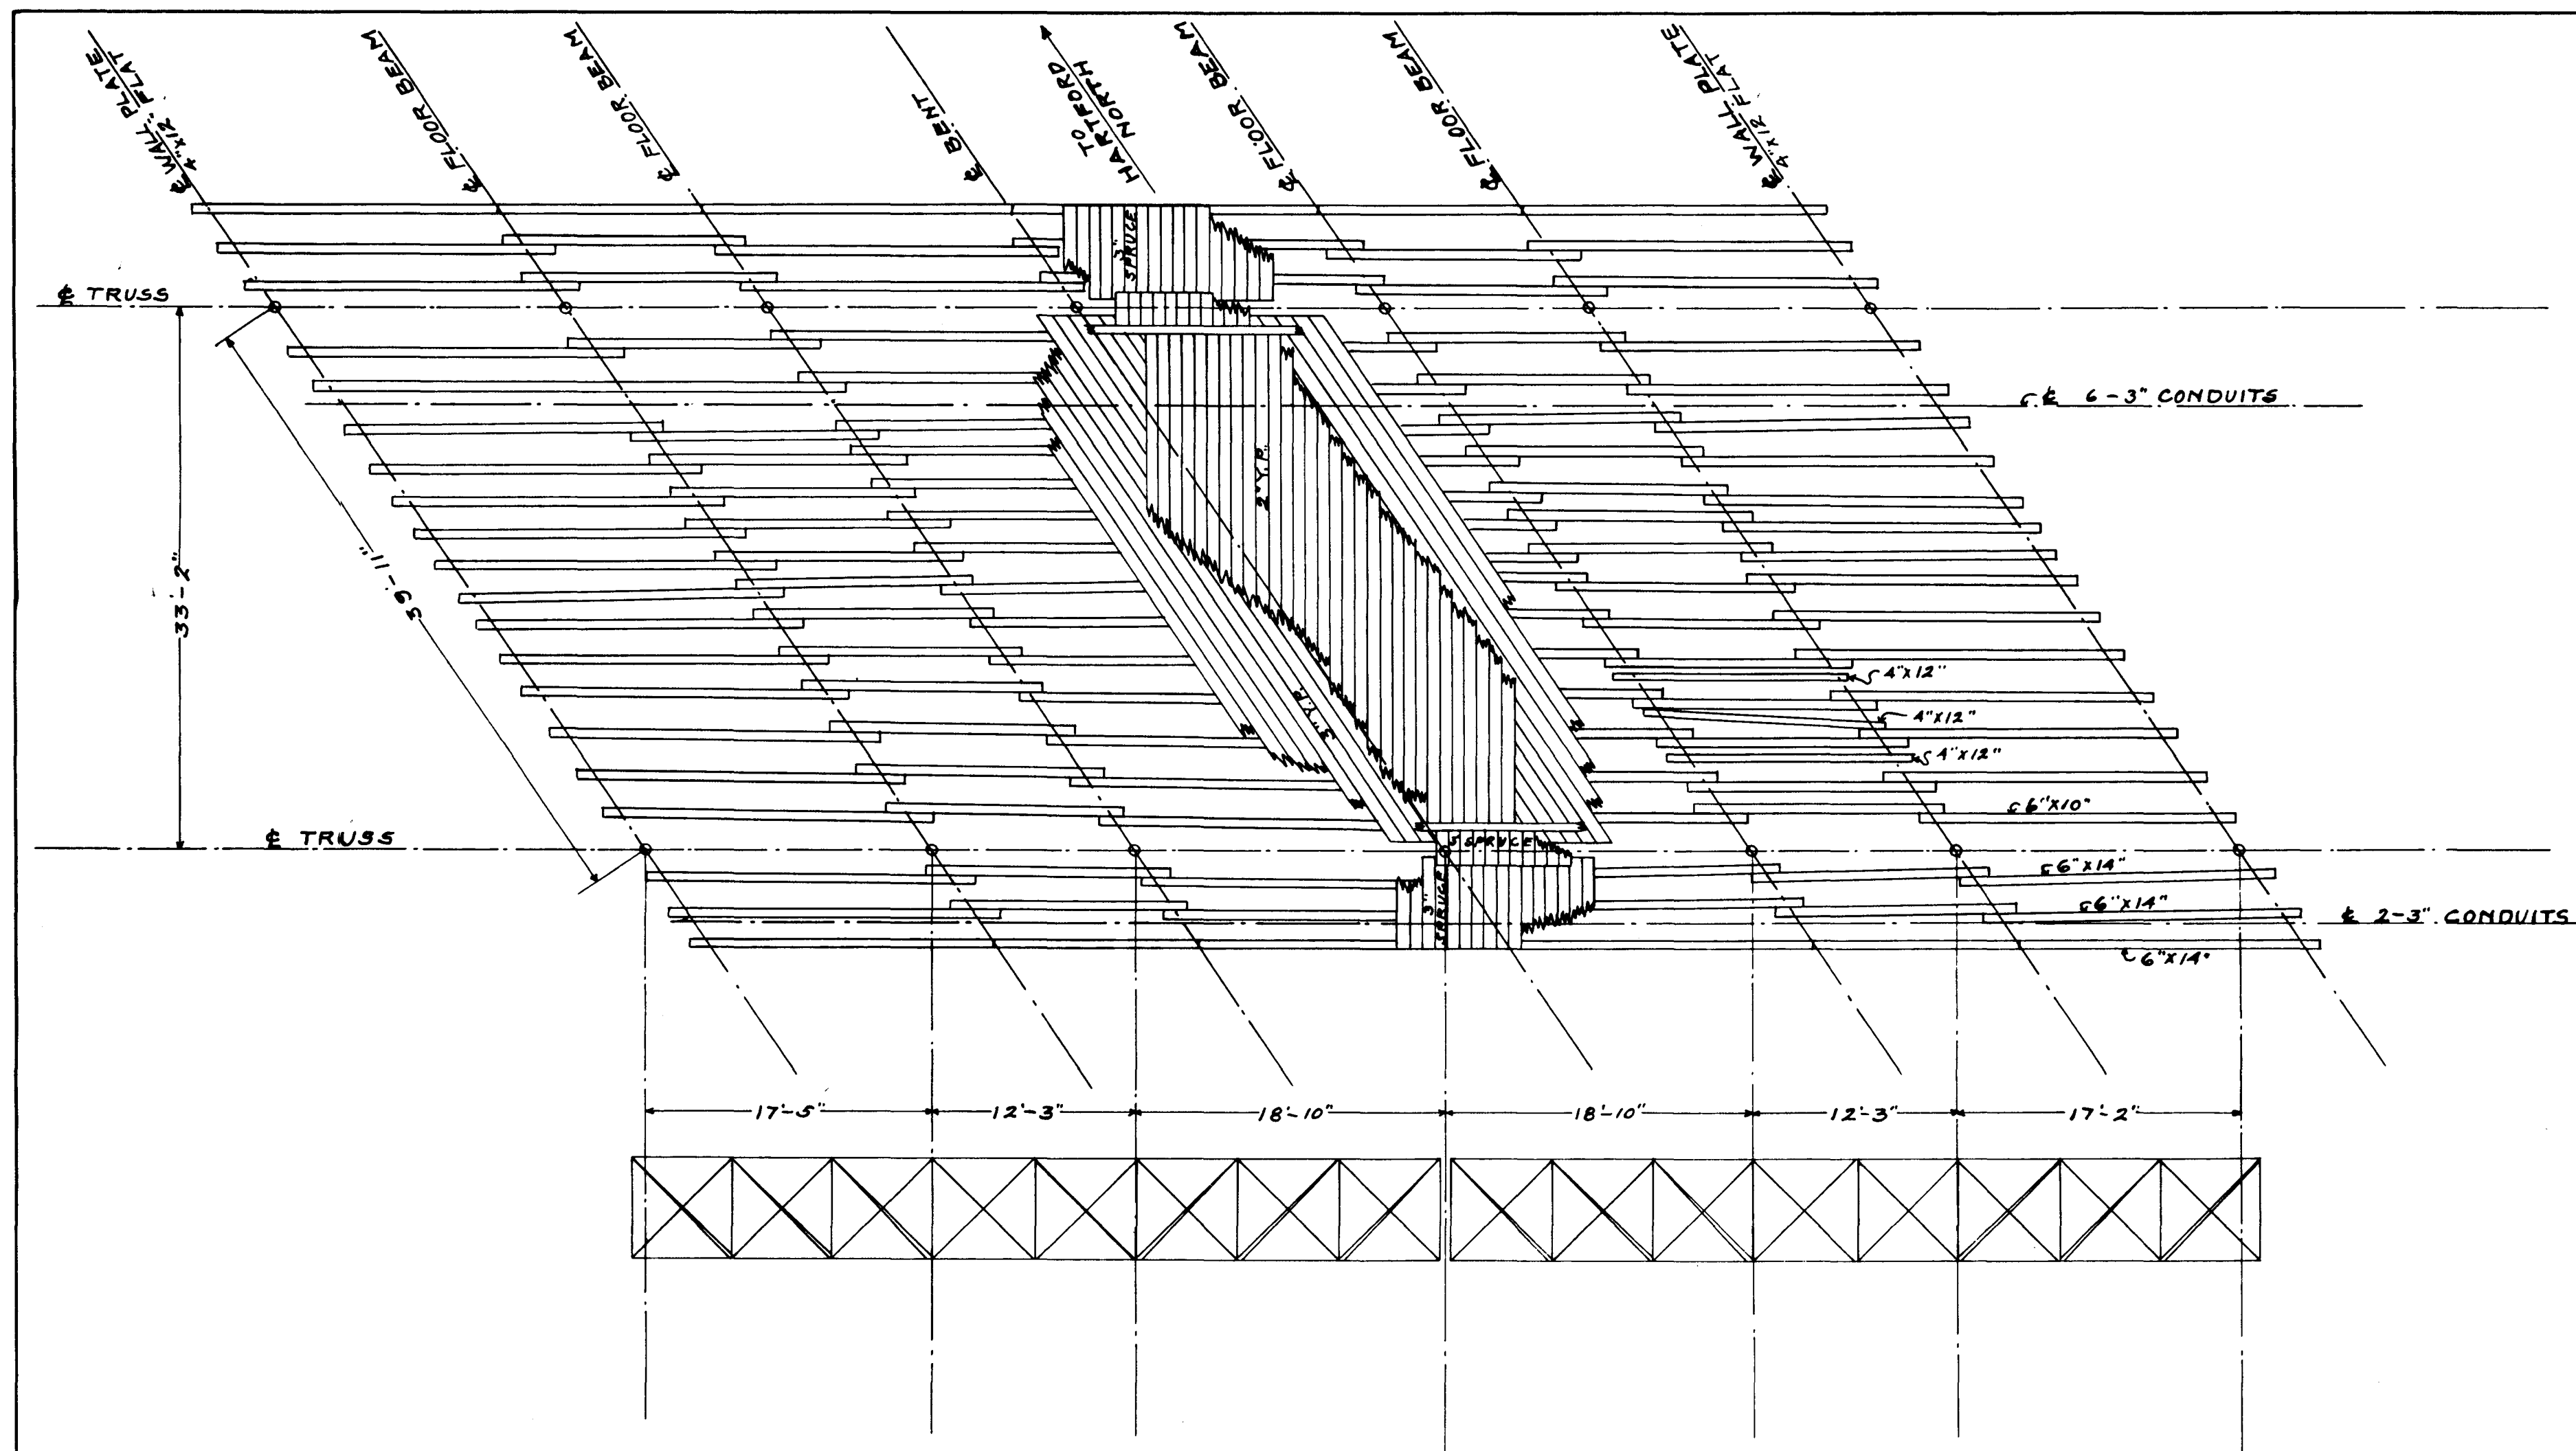

NOTE:-
 ALL STRINGERS 6"x14" Y.P. EXCEPT WHERE SHOWN ON PLAN.
 SPACING 1'-2 1/2" TO 3'-0" C. TO C.
 SEE PLANS VAULT FILE N^o 619.

N.Y.N.H. & H.R.R.
 NEW HAVEN TO SPRINGFIELD
 BRIDGE N^o 35.64
 AT
 LAUREL STREET
 0.91 MILES SOUTH OF
 HARTFORD STA. CONN.
 SCALE 1/8" = 1'-0"
 NOVEMBER 10, 1924.

FROM FIELD MEASUREMENTS JUNE 27, 1924.
 A.S.W. CHECKED BY: J.W.S.

SHEET 1 OF 2 SHEETS.
 OPERATING DIVISION-HARTFORD.