


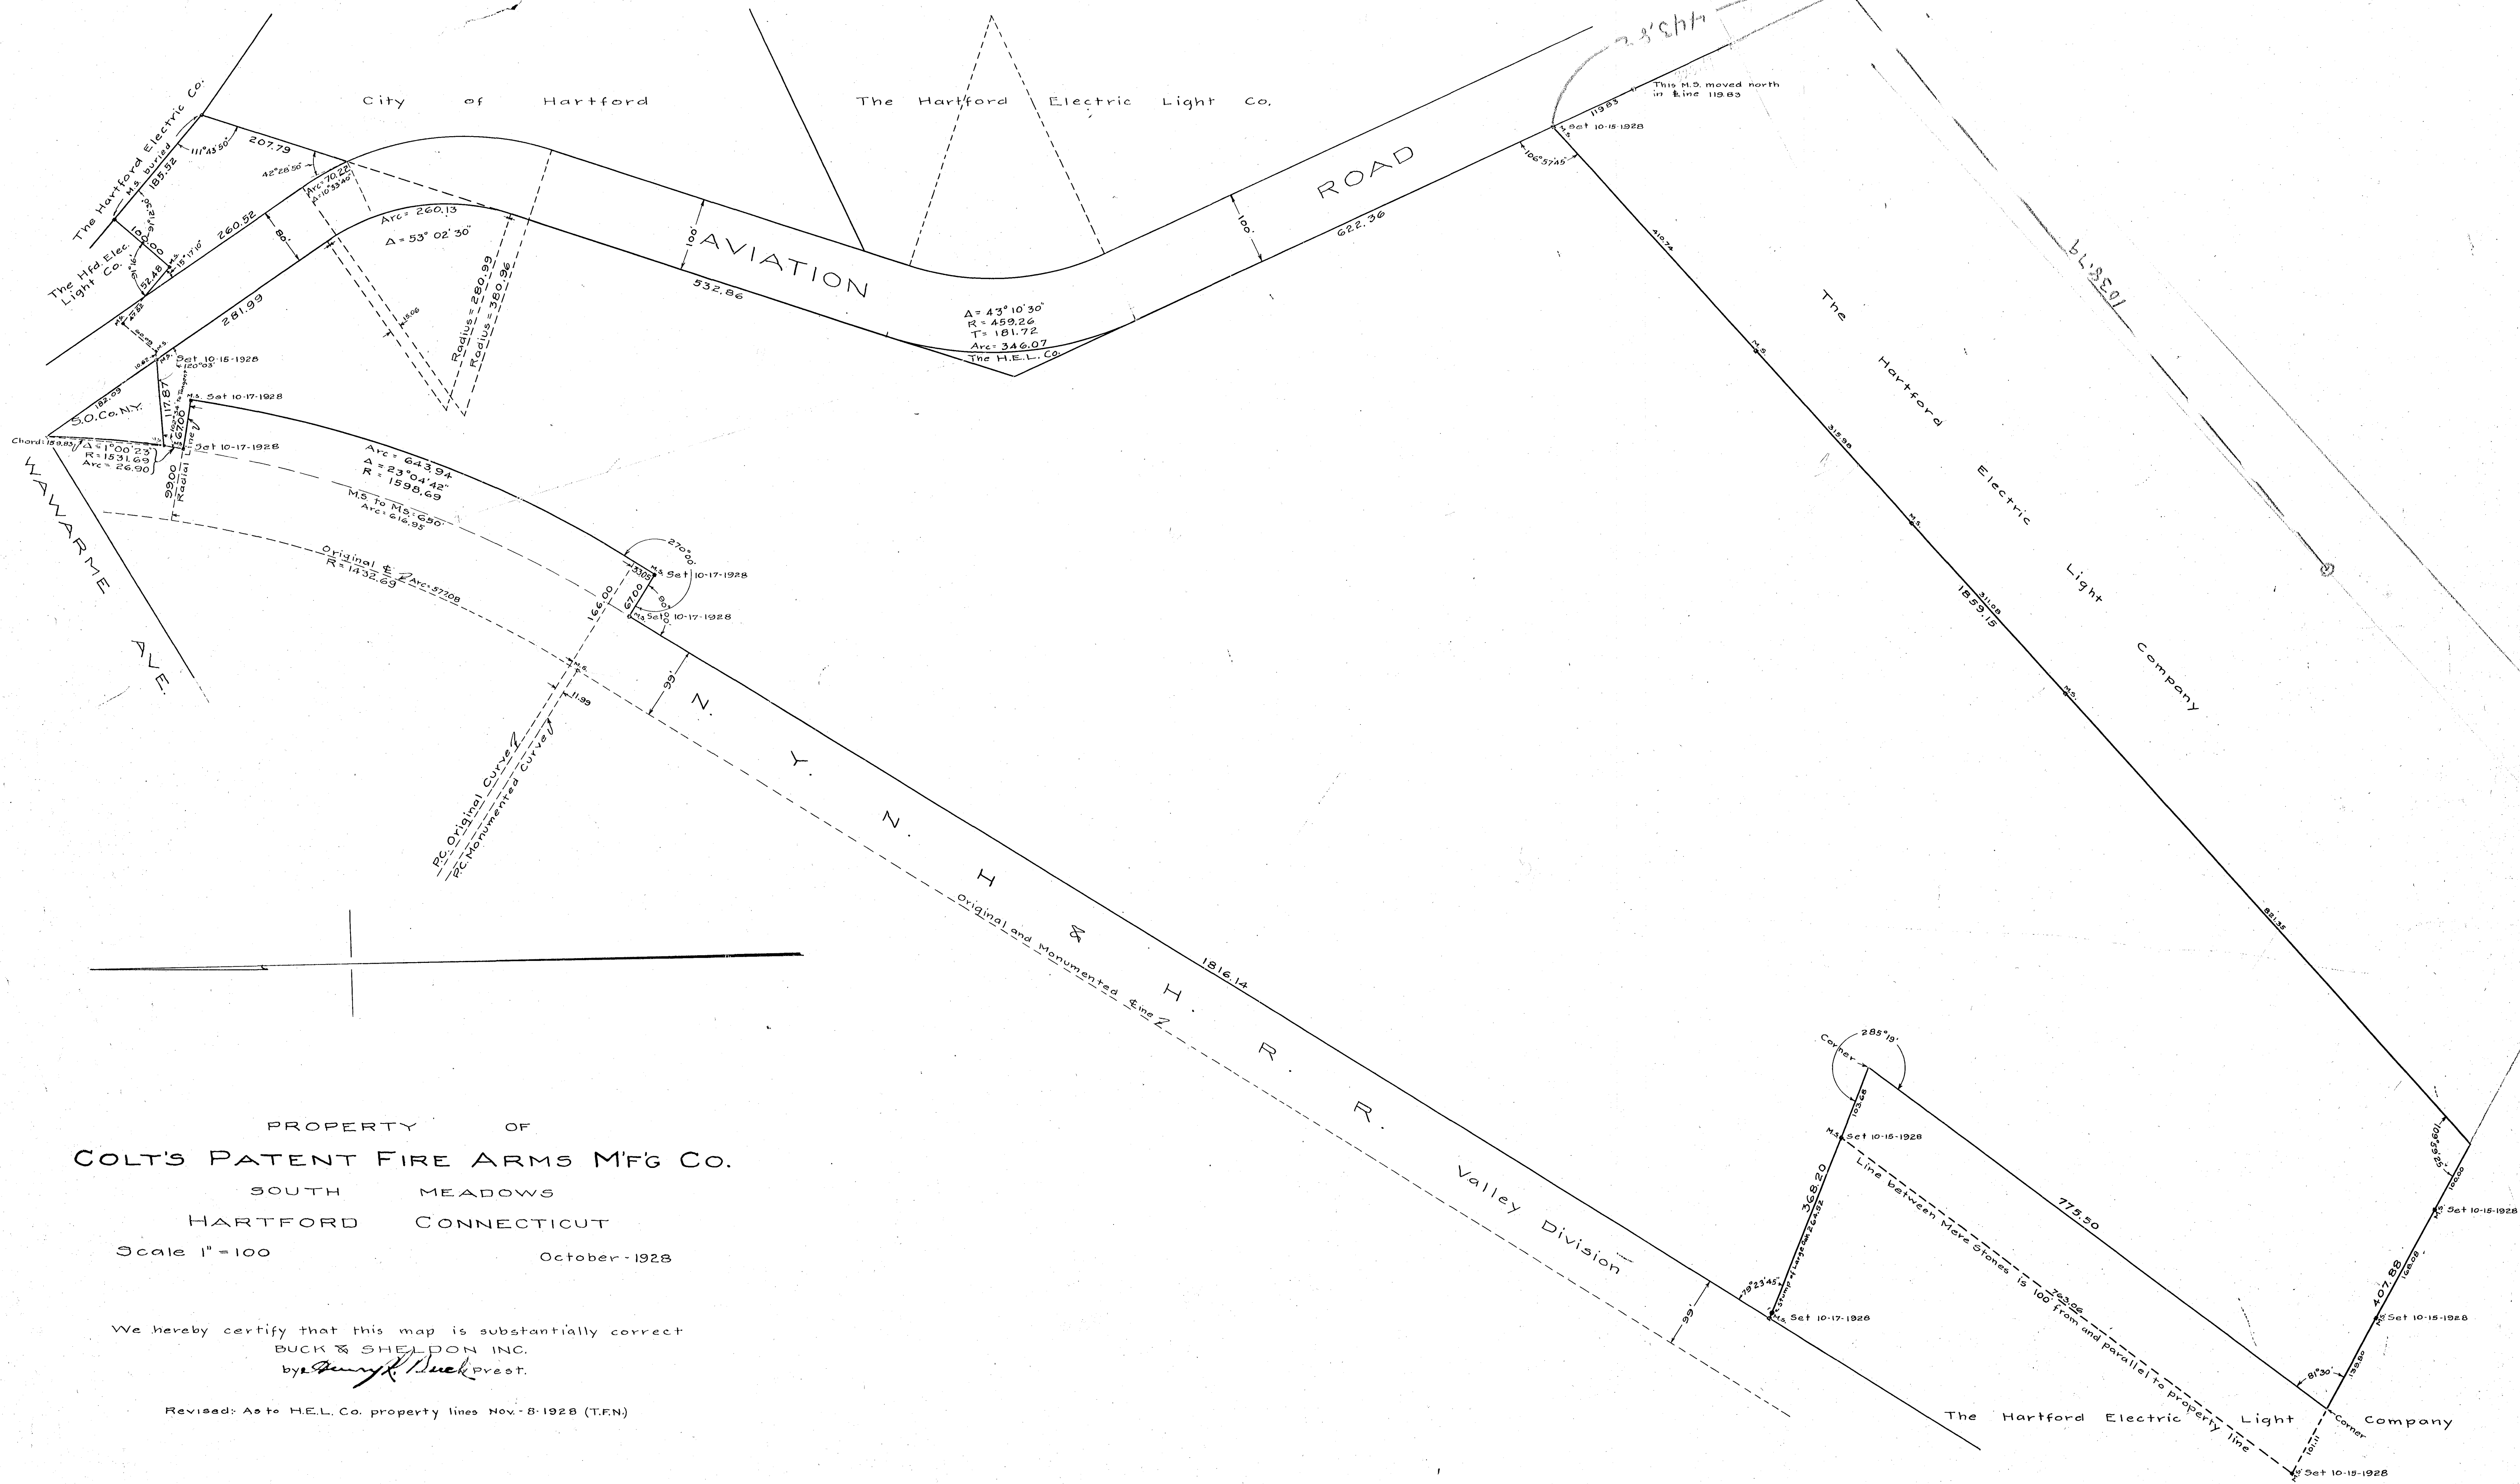

PROPERTY OF
COLT'S PATENT FIRE ARMS M'FG CO.

SOUTH MEADOWS
HARTFORD CONNECTICUT

Scale 1" = 100

October - 1928

We hereby certify that this map is substantially correct
BUCK & SHELDON INC.
by *Garry H. Buck* Pres.

Revised: As to H.E.L. Co. property lines Nov. 8, 1928 (T.F.N.)

Approved as to property lines

R.H. Rich
Engineer of Surveys
THE N.Y., N.H. & H.R.R. Co.

Approved as to property lines Nov. 9, 1928

F.J. Reynolds Engineer
THE HARTFORD ELECTRIC LIGHT COMPANY

Approved as to property lines Dec. 20, 1928

L.J. Drake Engineer
STANDARD OIL CO. OF NEW YORK

BUCK & SHELDON INC.
CIVIL ENGINEERS
HARTFORD, CONN.

Drawn