


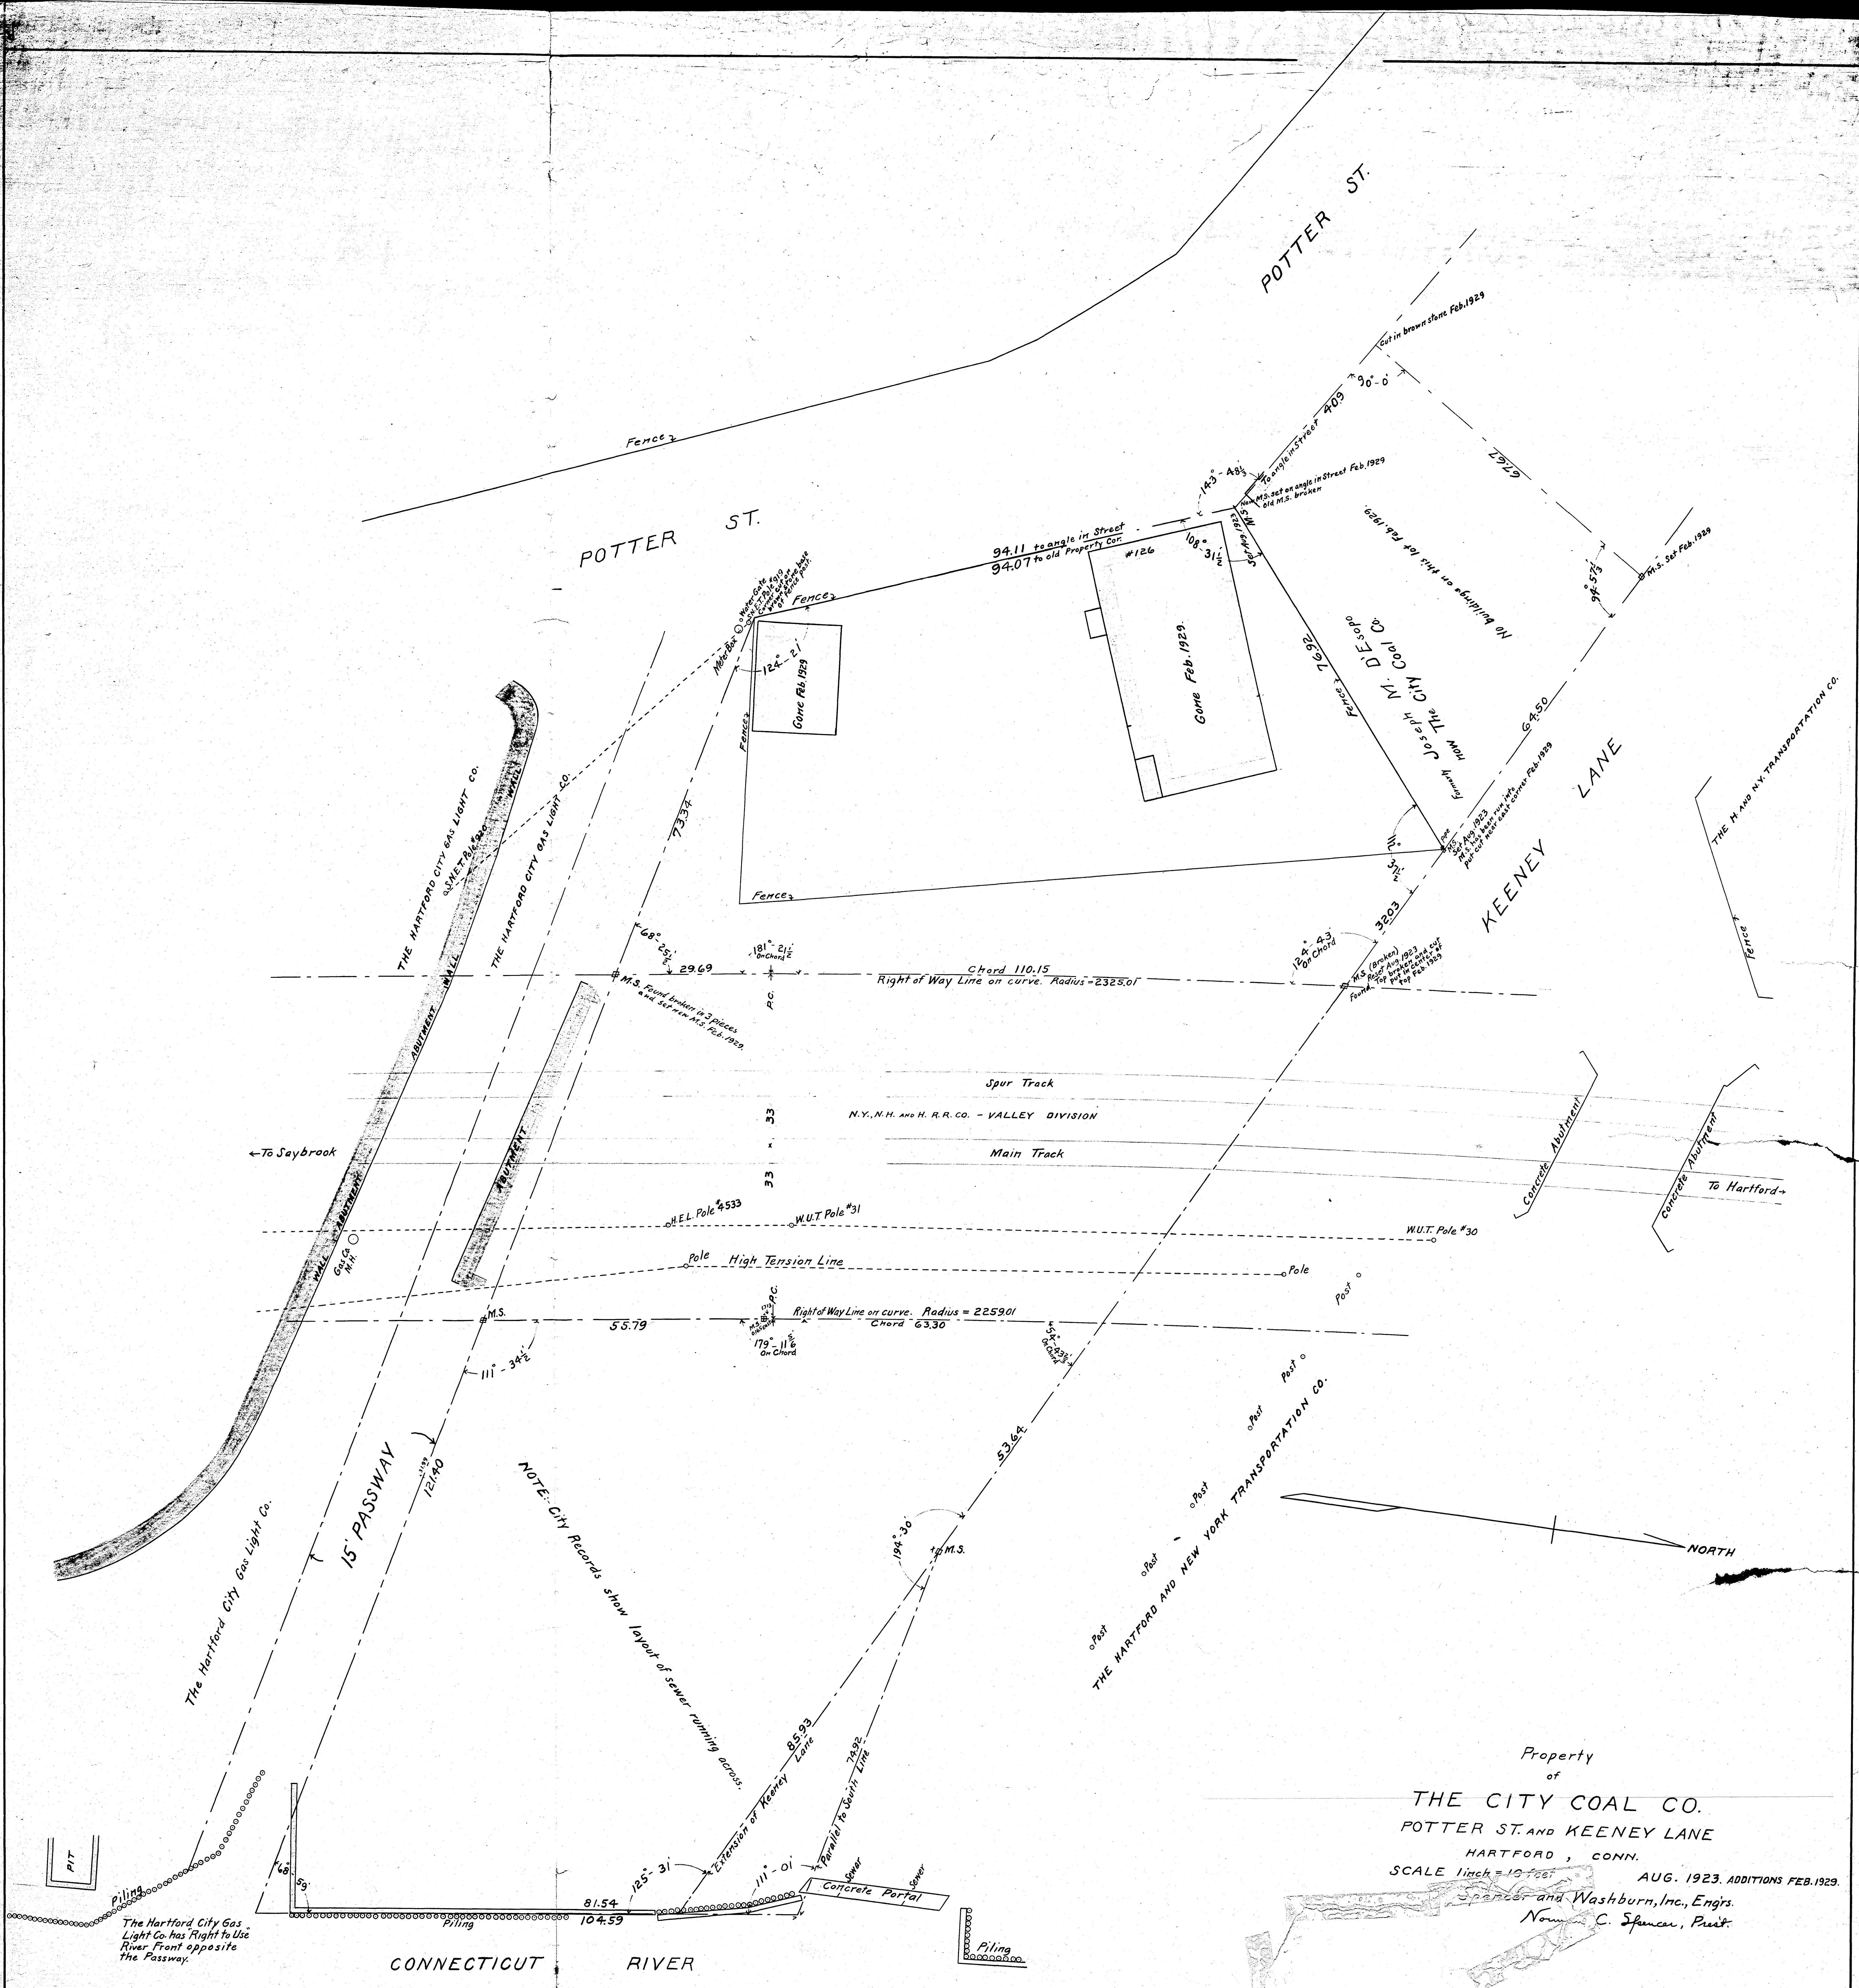

Property
of
THE CITY COAL CO.
POTTER ST. AND KEENEY LANE
HARTFORD, CONN.
SCALE 1 inch = 10 feet
AUG. 1923. ADDITIONS FEB. 1929.
Sprecher and Washburn, Inc., Engrs.
Norm C. Spencer, Print.