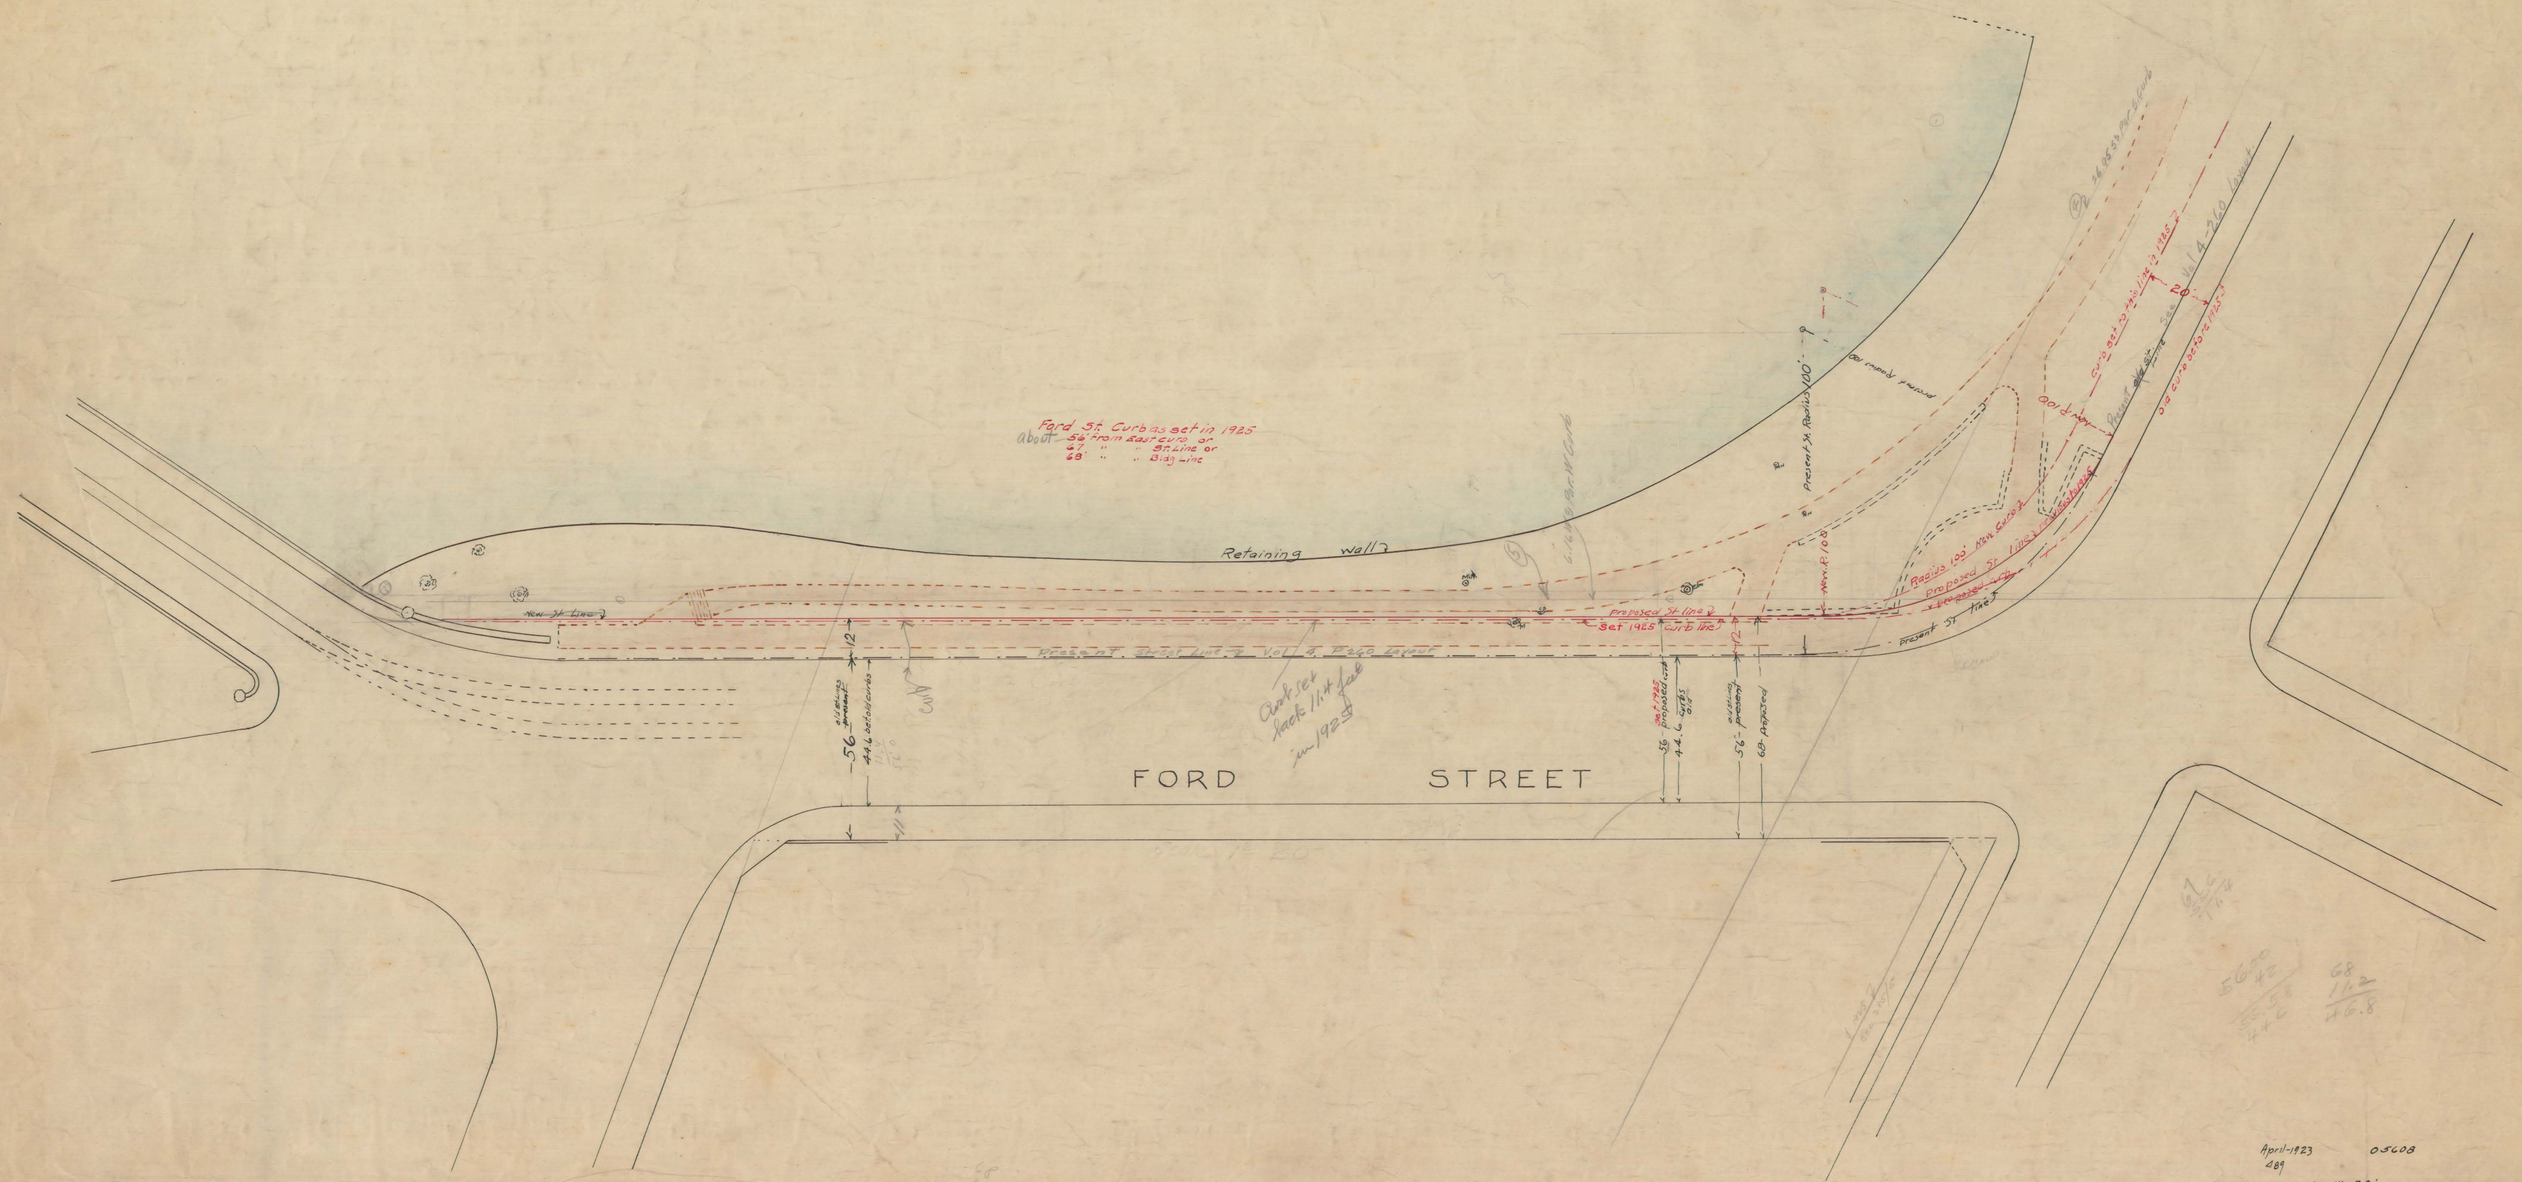
Ford St. Curb as set in 1925
about 56' from Bay curb or
67' " St. Line or
68' " " Bldg Line
Retaining wall
New St. Line
Present Bldg Line
Vol. 4 Page 20
Proposed St. Line
Set 1925 Curb line
Present St. Line
Present St. Radius 100'
New R 108
Radius 100' New Curb
Proposed St. Line
Proposed Curb
Curb set 1925
Present Curb
Present St. Line
Curb set back 1.1' feet in 1925
Cobblestone Curb
56' existing present
44.6 between curbs
12
11
56' existing present
44.6 proposed curb
56' proposed curb
68' proposed
FORD STREET
April-1923
dbj
0.5608
Scale 1"=20'
