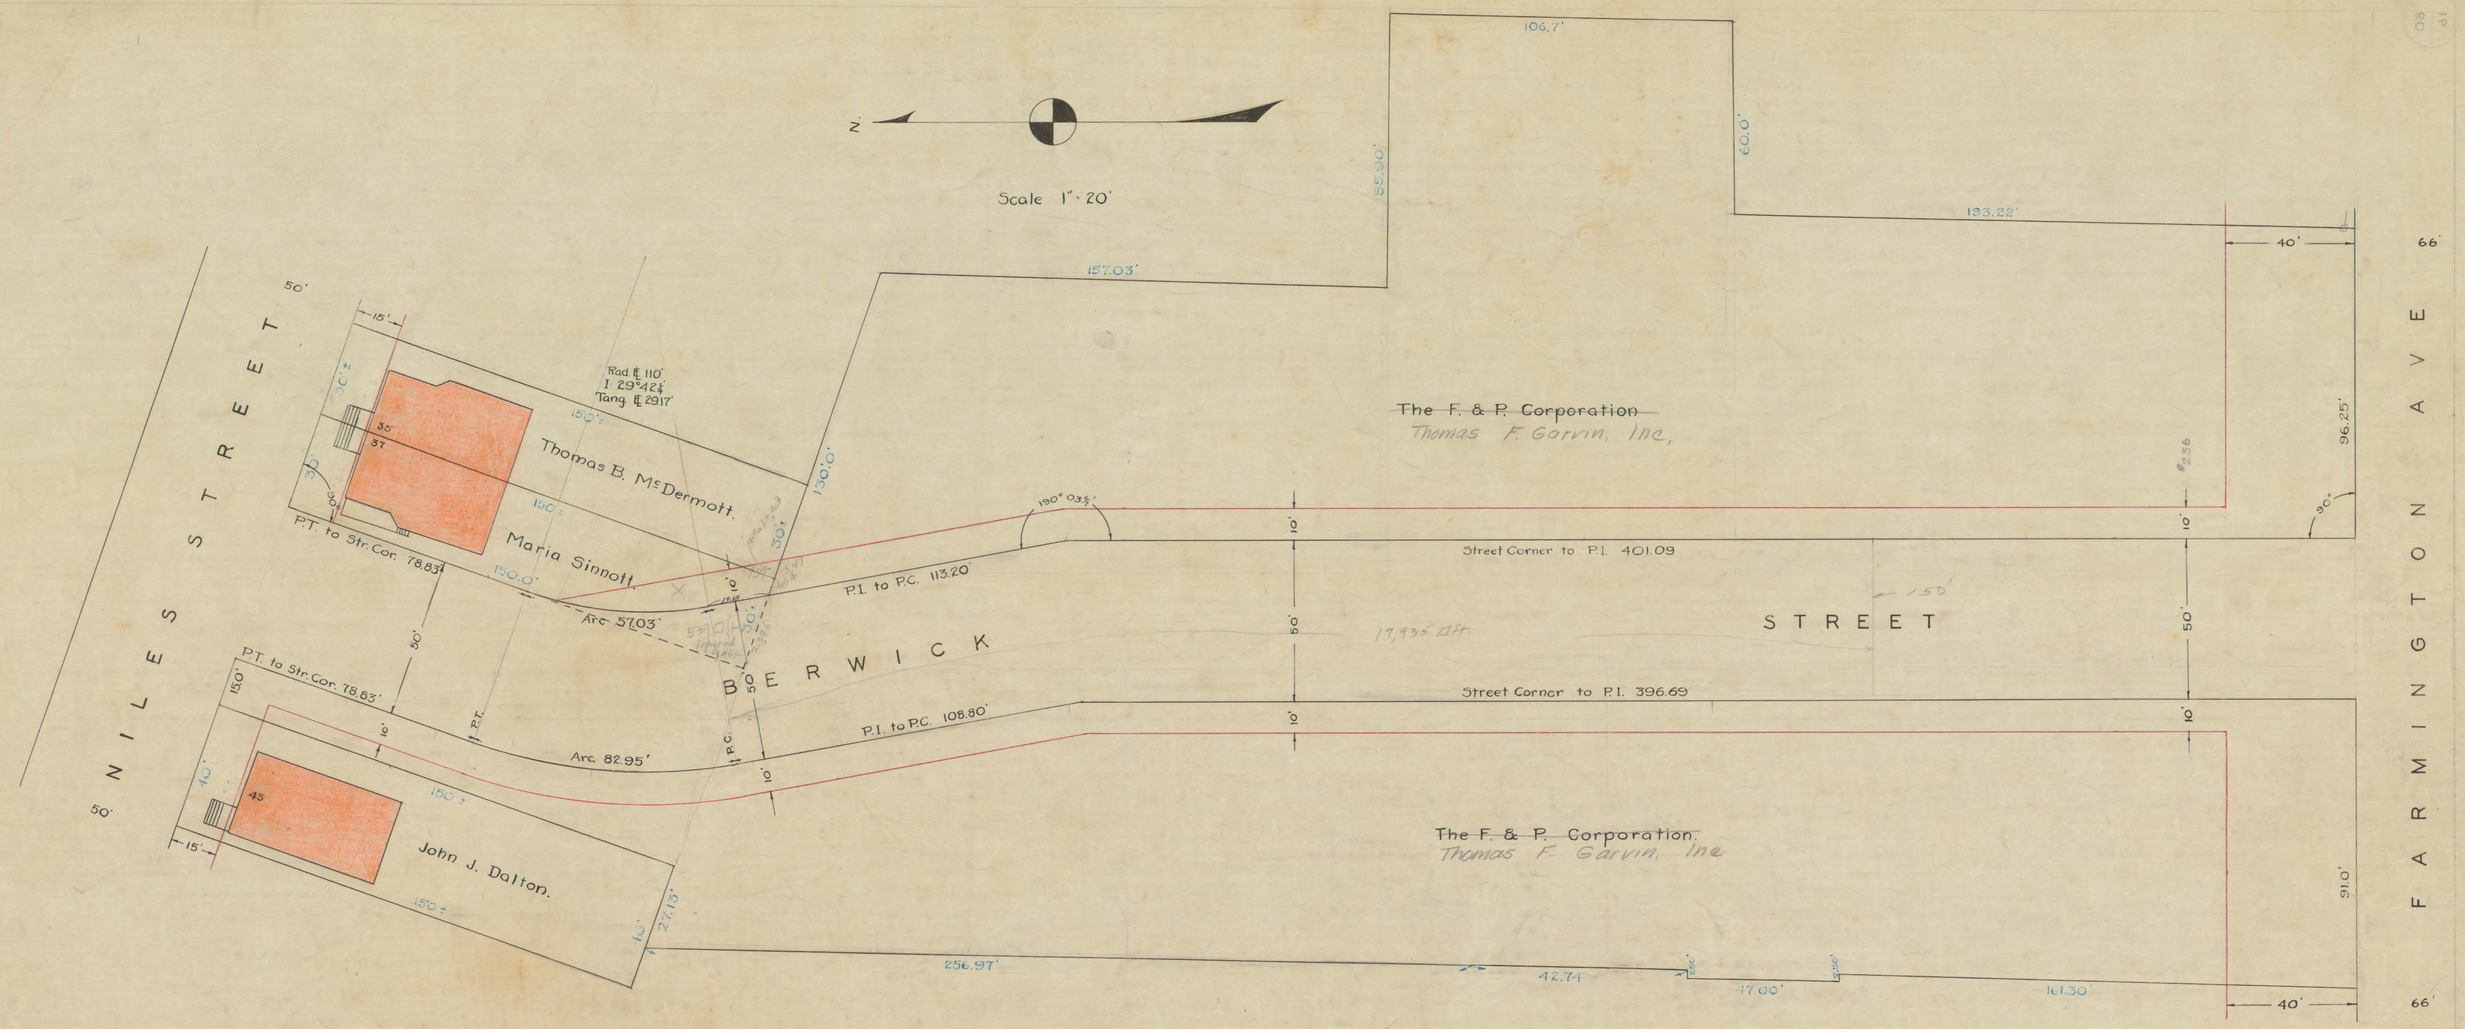

OFFICE OF CITY ENGINEER
HIGHWAY DIVISION
Date 10-19-26 No 06070
Source 515 P.130 Land Taken Plan & Profile
City Engineer
J.G.A.