


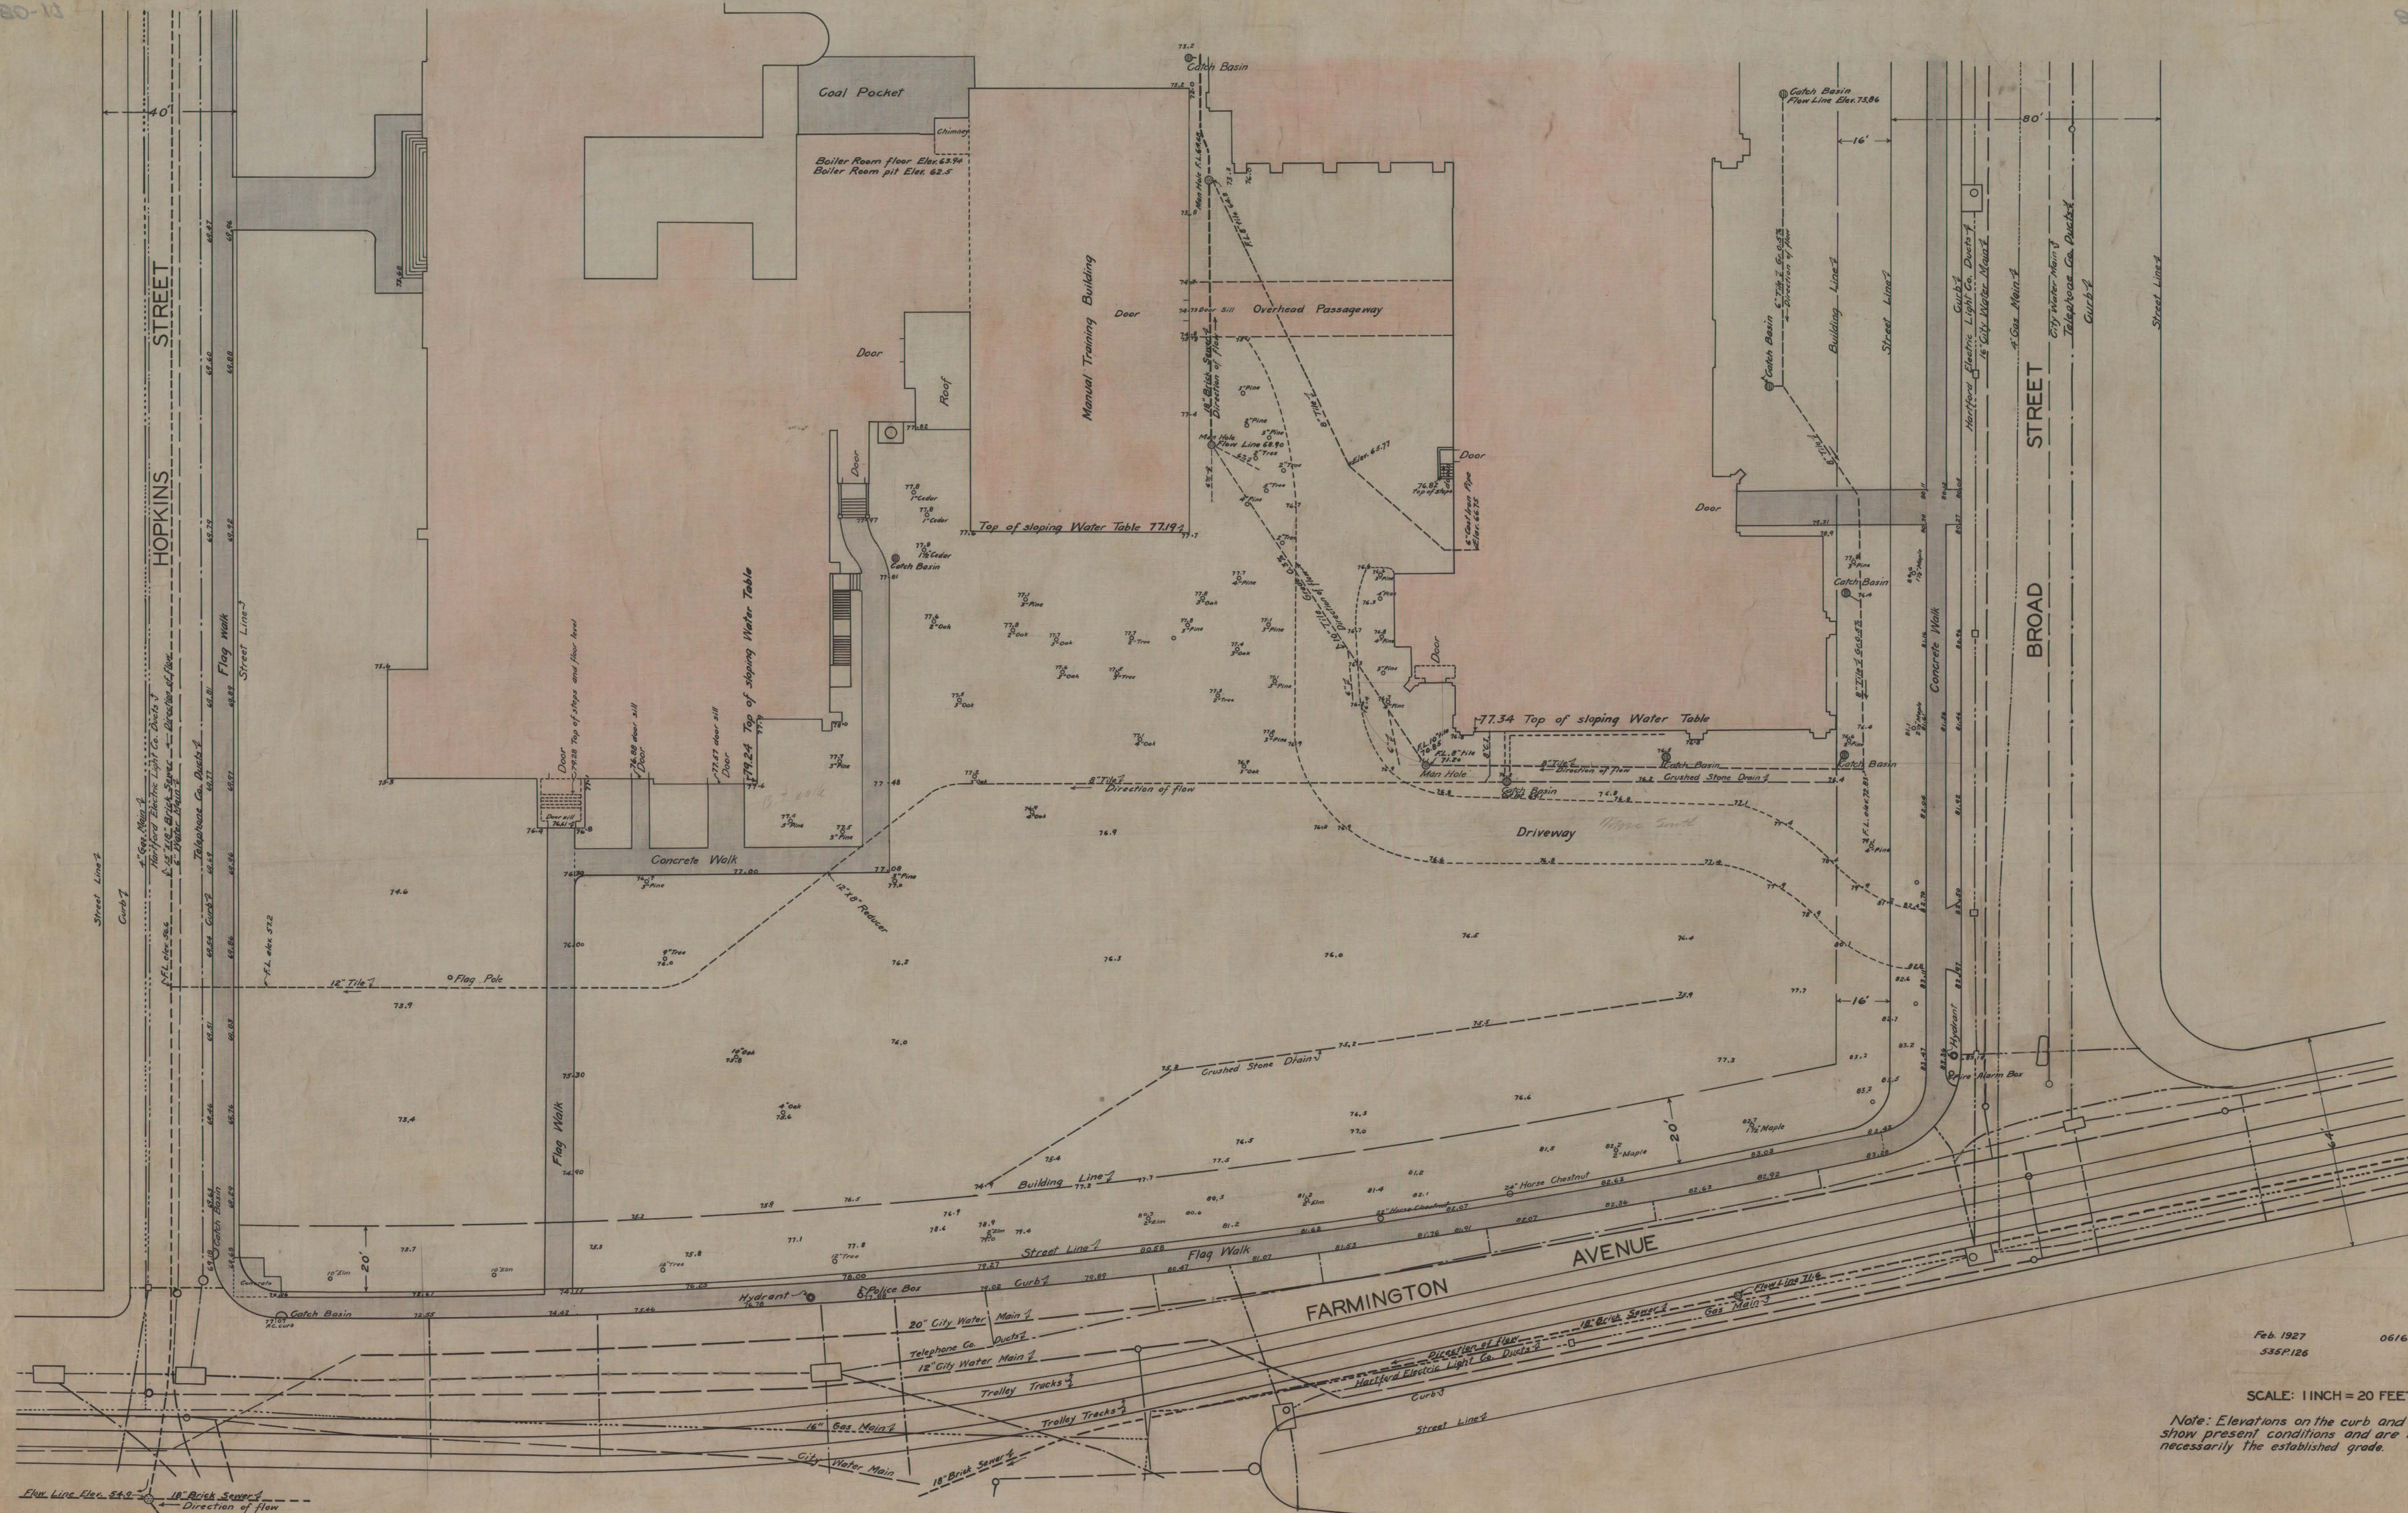

Feb. 1927 06/62
535P.126

SCALE: 1 INCH = 20 FEET.

Note: Elevations on the curb and sidewalk show present conditions and are not necessarily the established grade.

Flow Line Elev. 54.9
18" Brick Sewer
Direction of Flow