


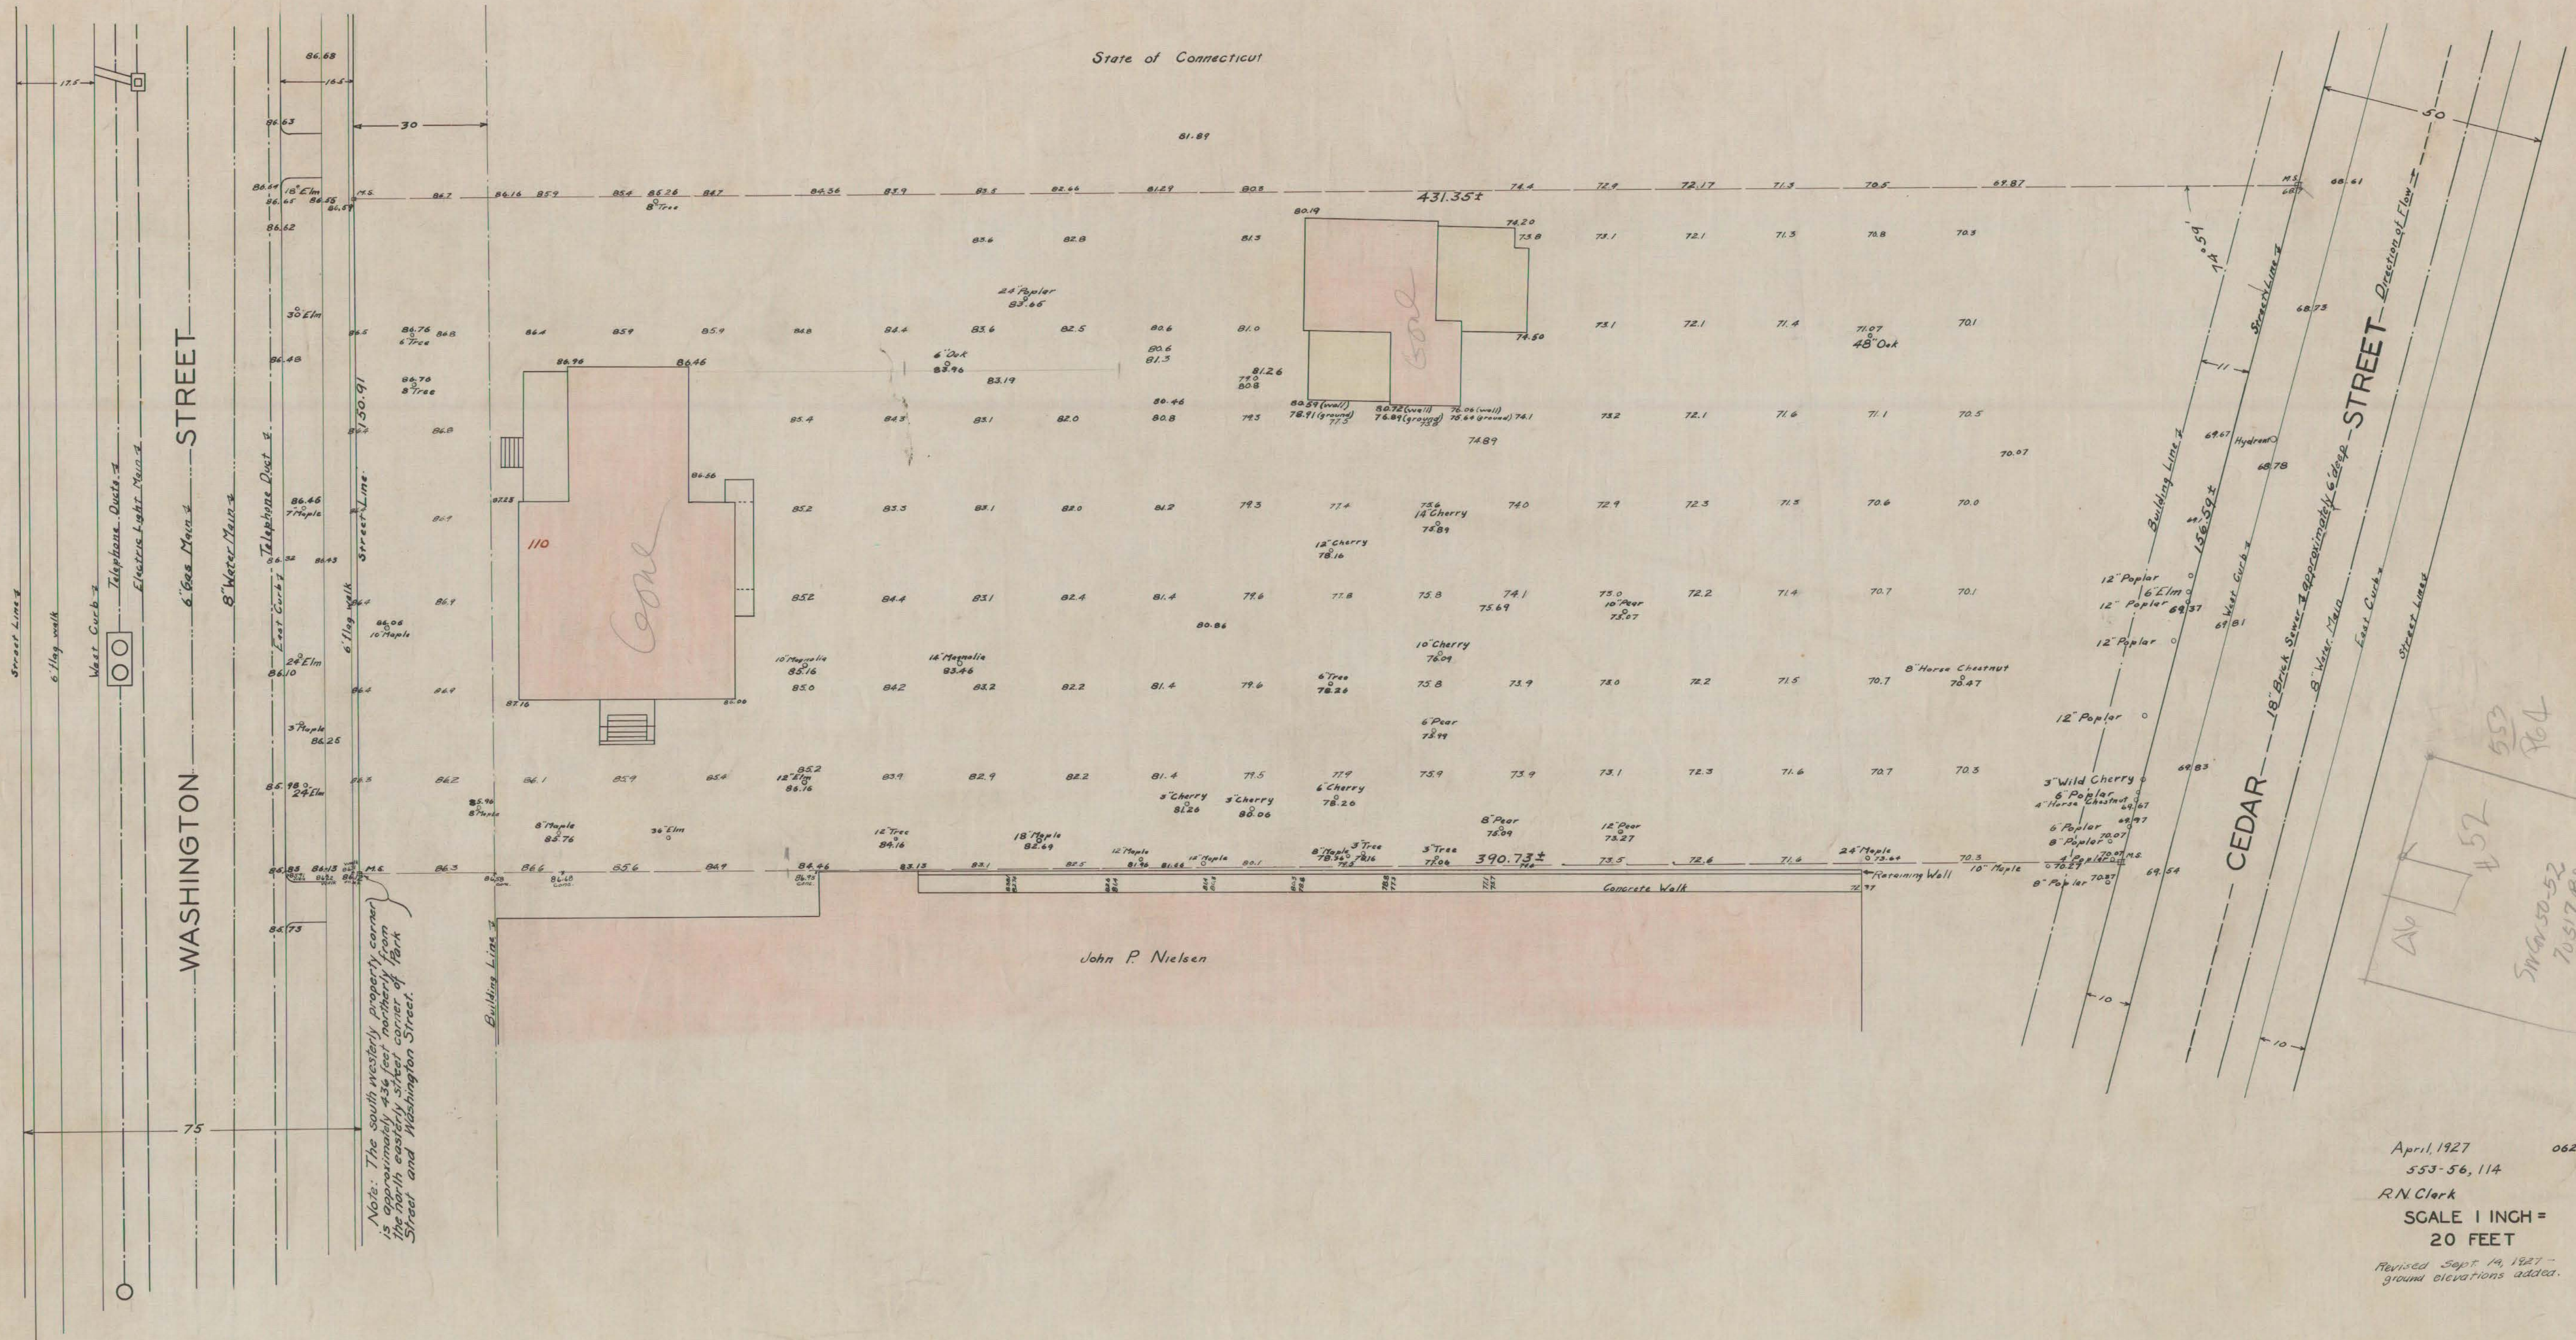

April, 1927 06200
553-56, 114
R.N. Clerk
SCALE 1 INCH =
20 FEET
Revised Sept. 14, 1927 -
ground elevations added.