

ST


BUCKINGHAM

WASHINGTON

ST

AVE.

CAPITOL

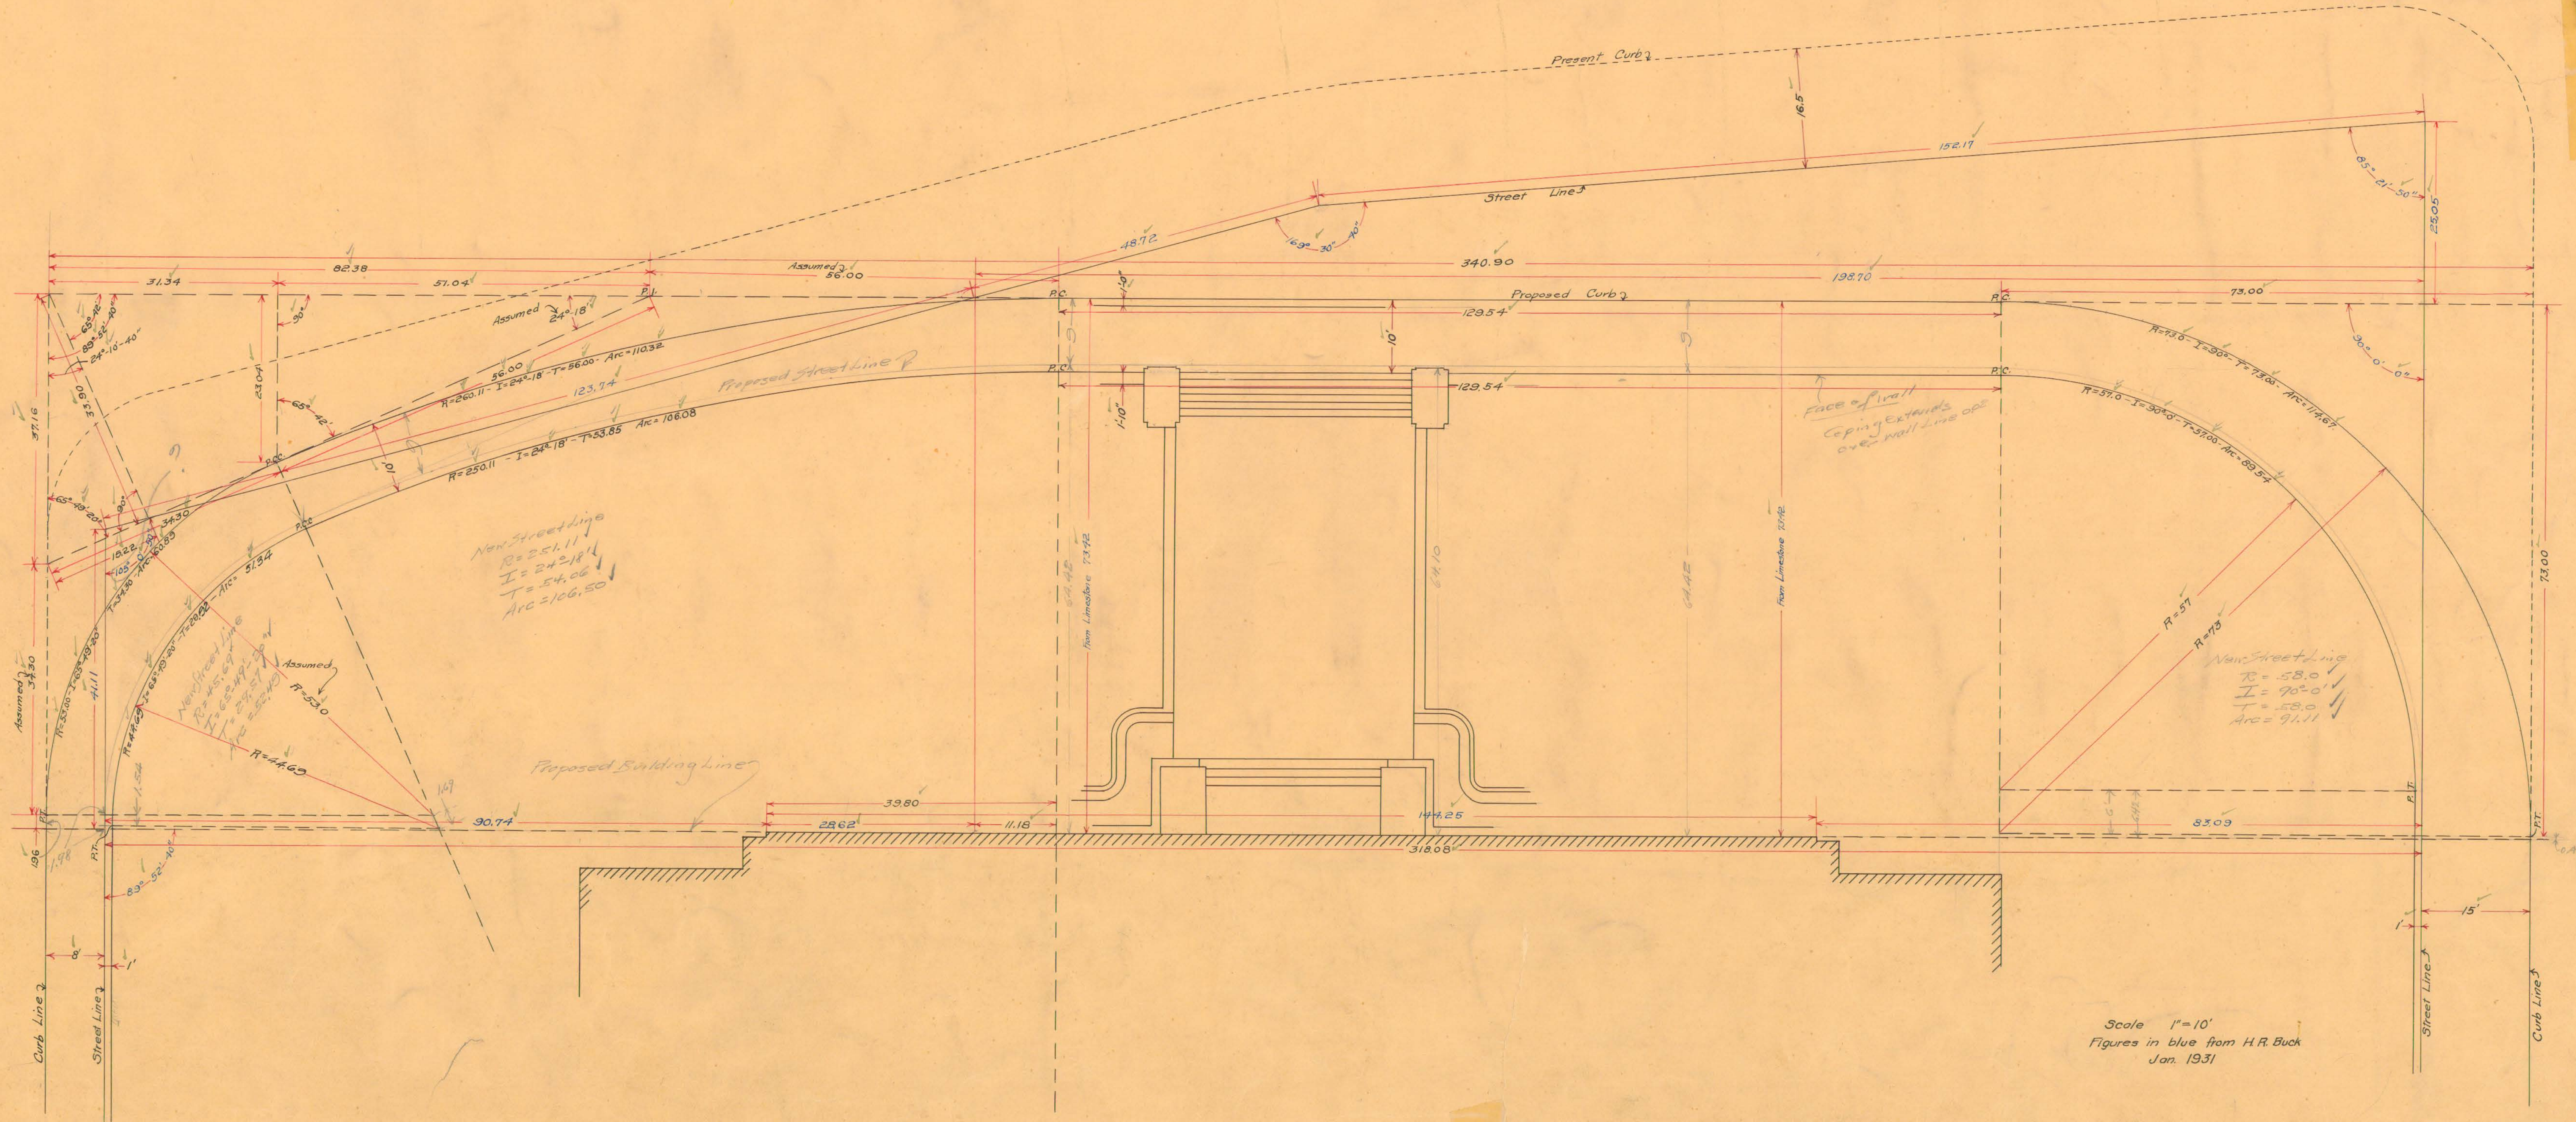

Scale 1"=10'
Figures in blue from H.R. Buck
Jan. 1931