


Note: These lines changed- See Vol 7, P 366

RETREAT AVENUE

JEFFERSON ST.

MAPLE AVENUE

CONGRESS STREET
Ties 373, P20

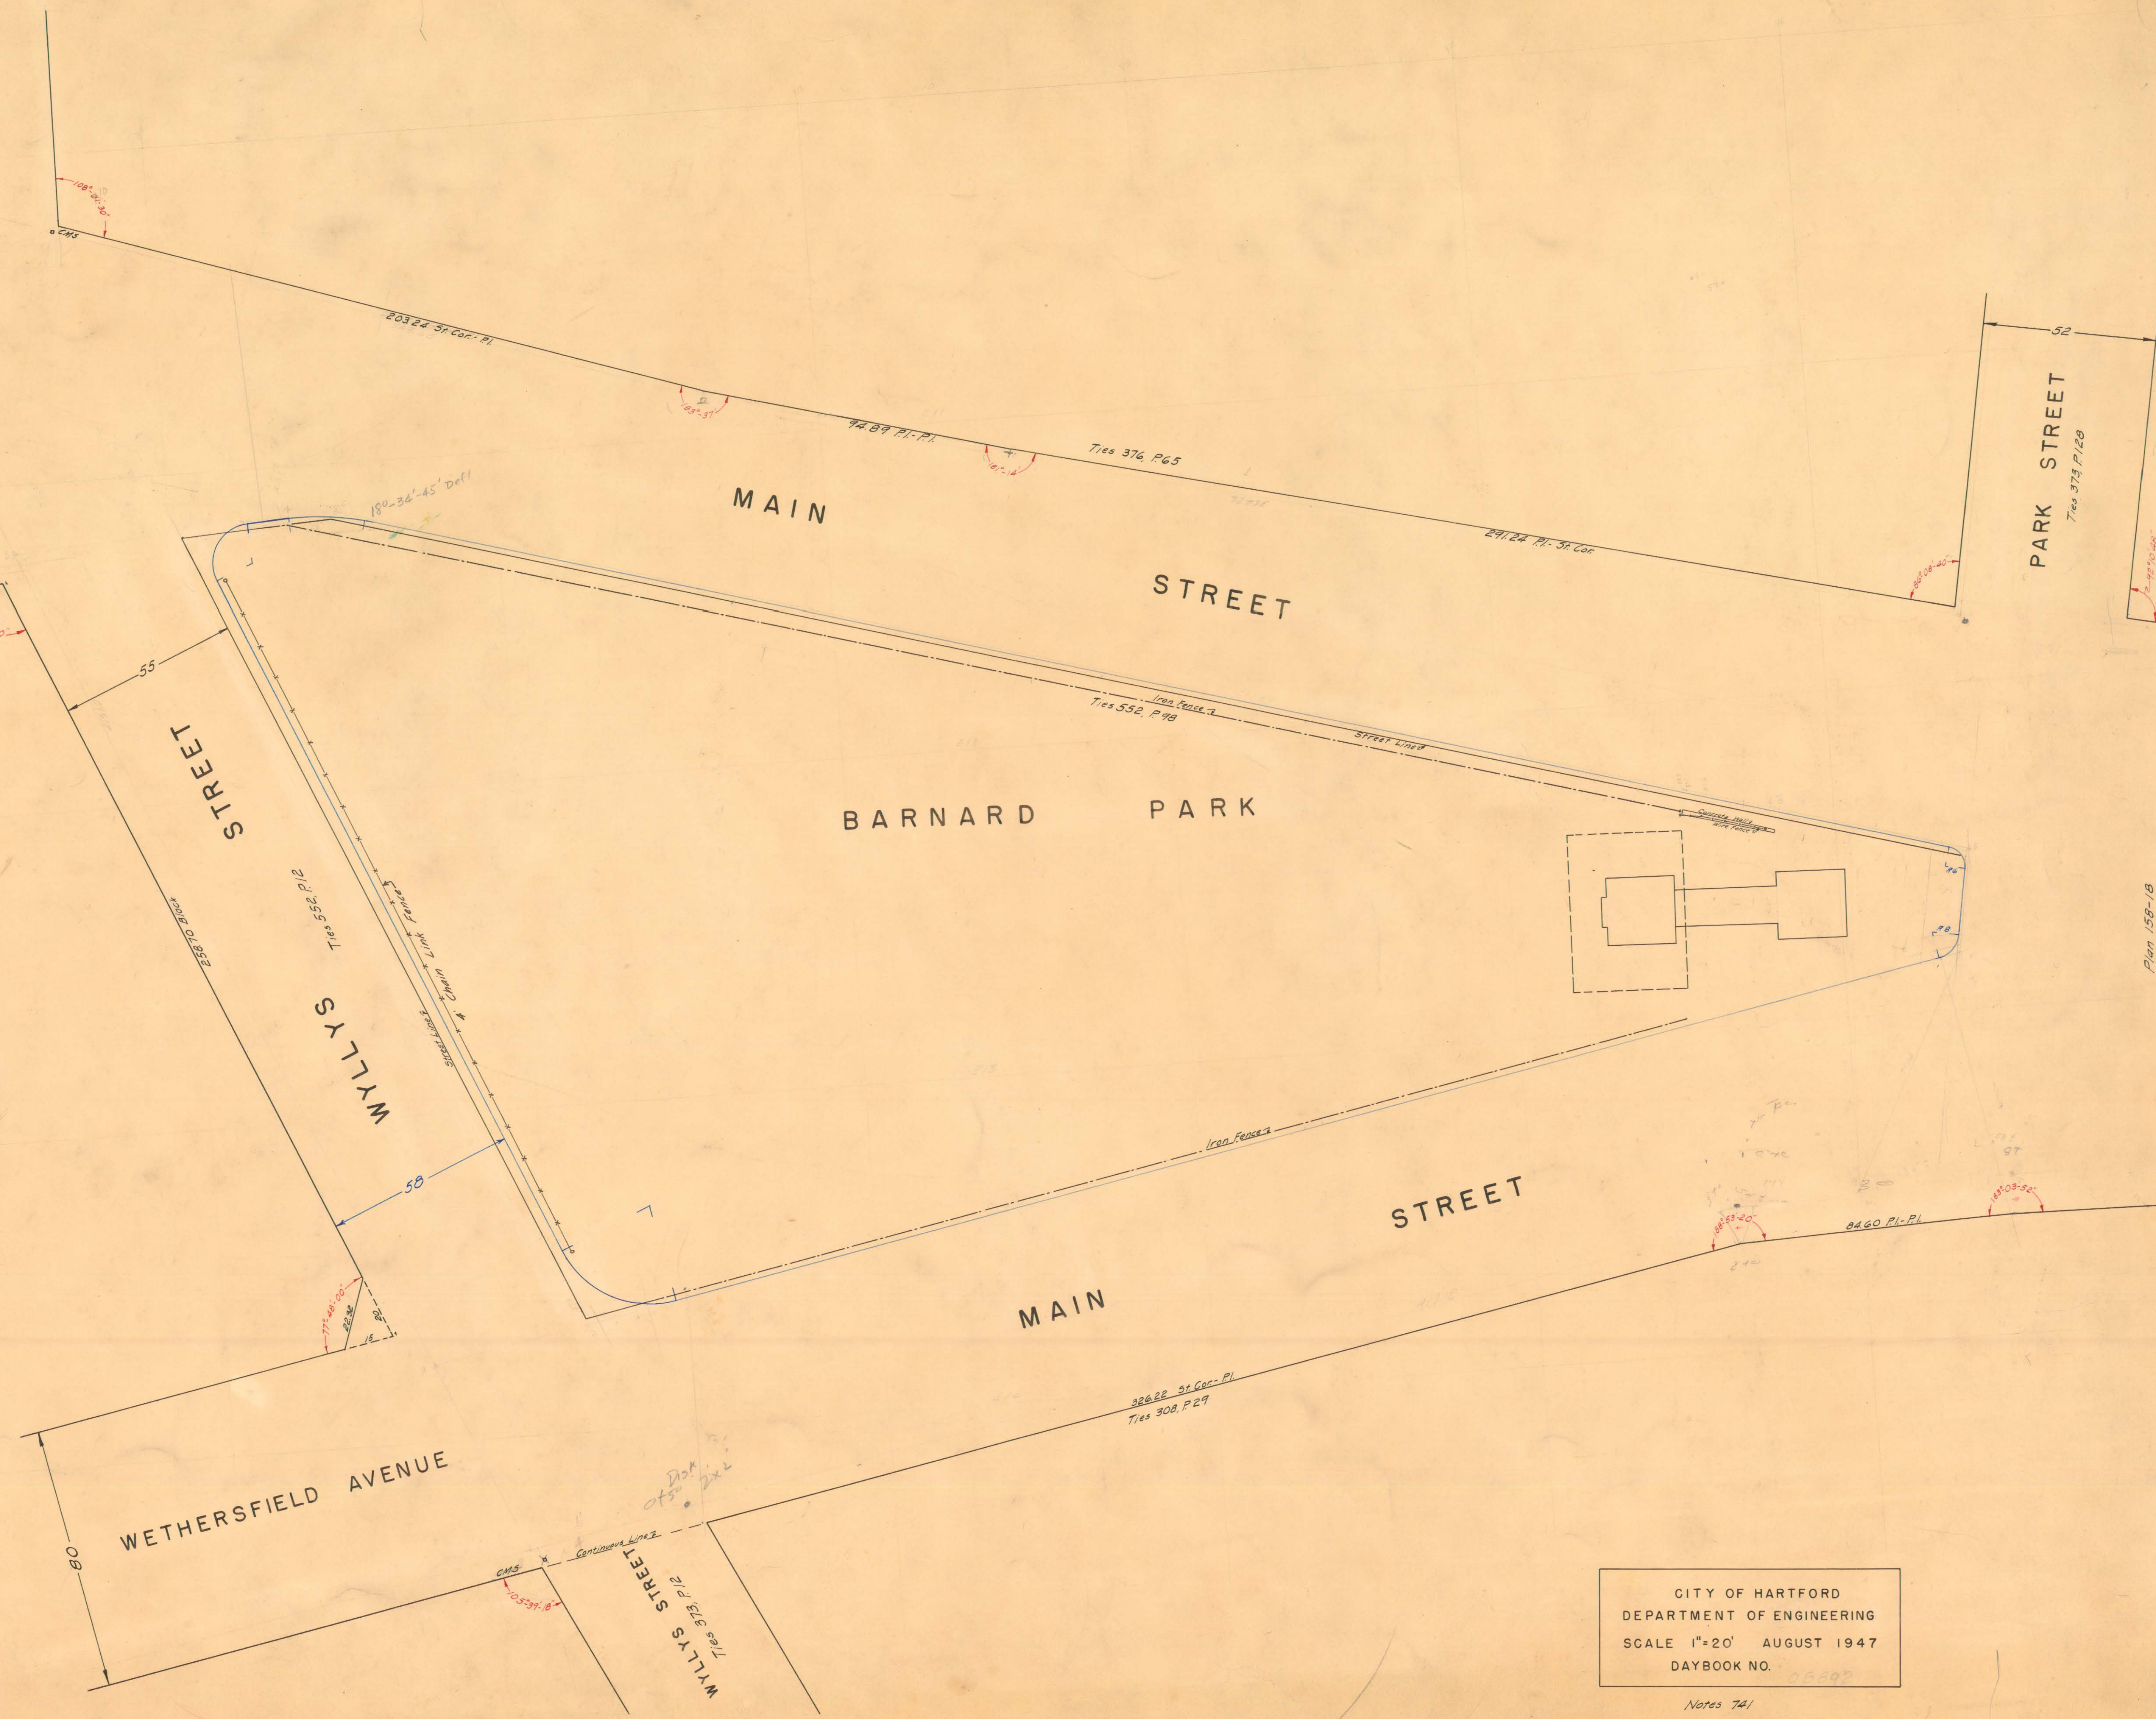

CITY OF HARTFORD
DEPARTMENT OF ENGINEERING
SCALE 1"=20' AUGUST 1947
DAYBOOK NO. 05497

Notes 741

Plan 158-18