




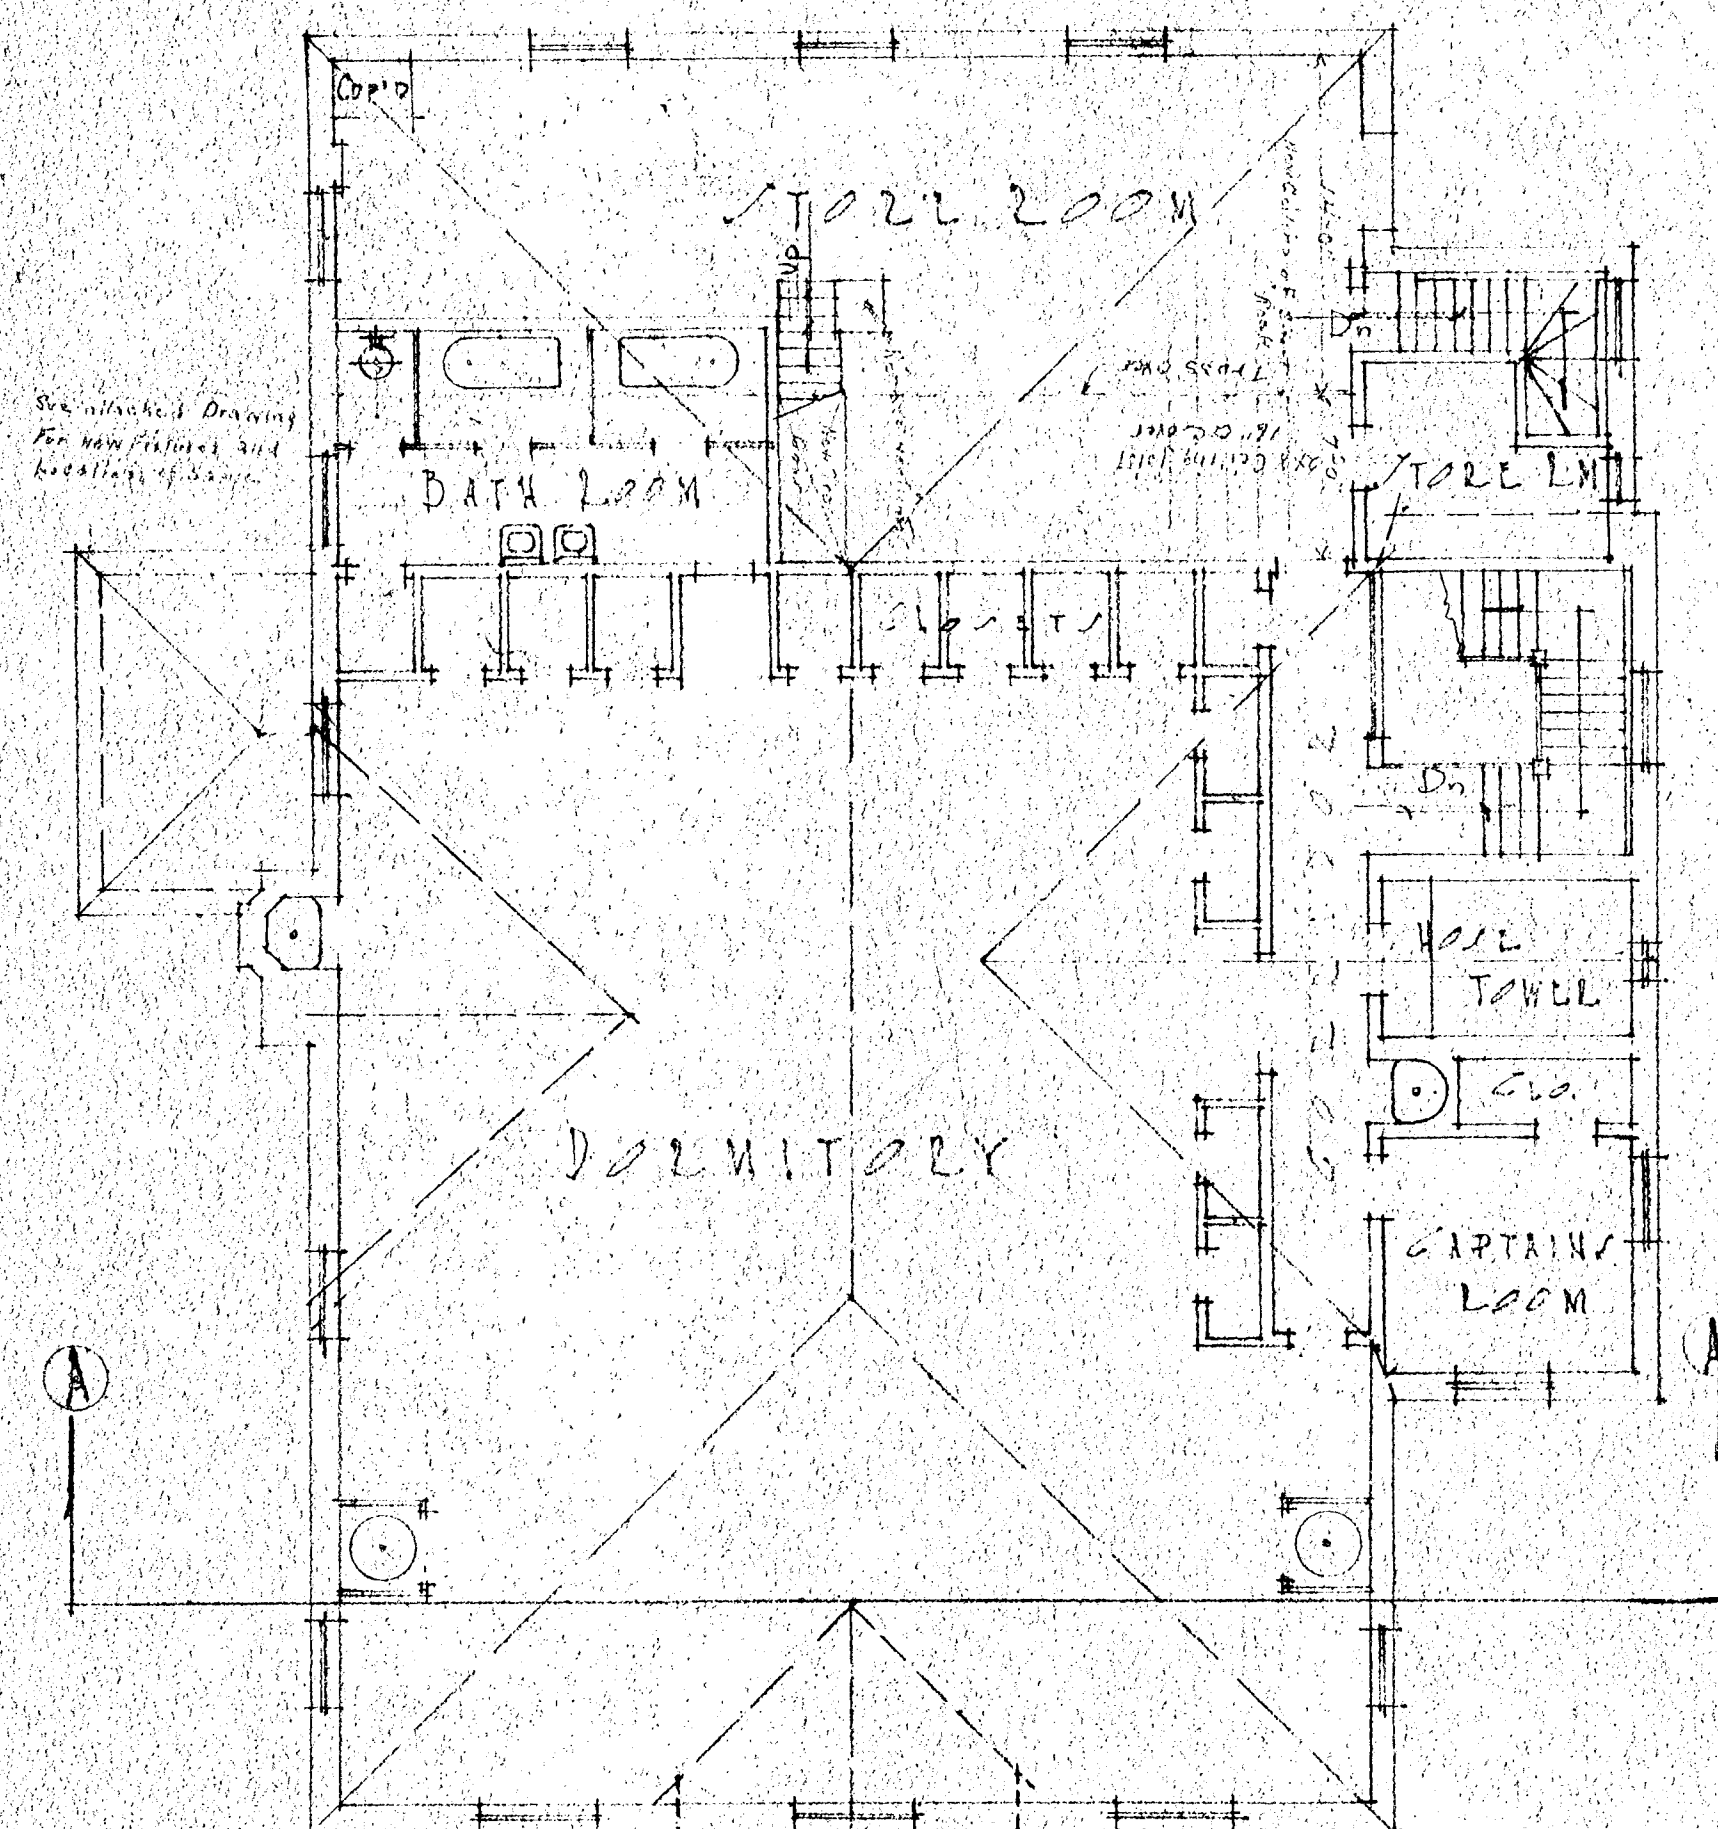


SECOND FLOOR PLAN

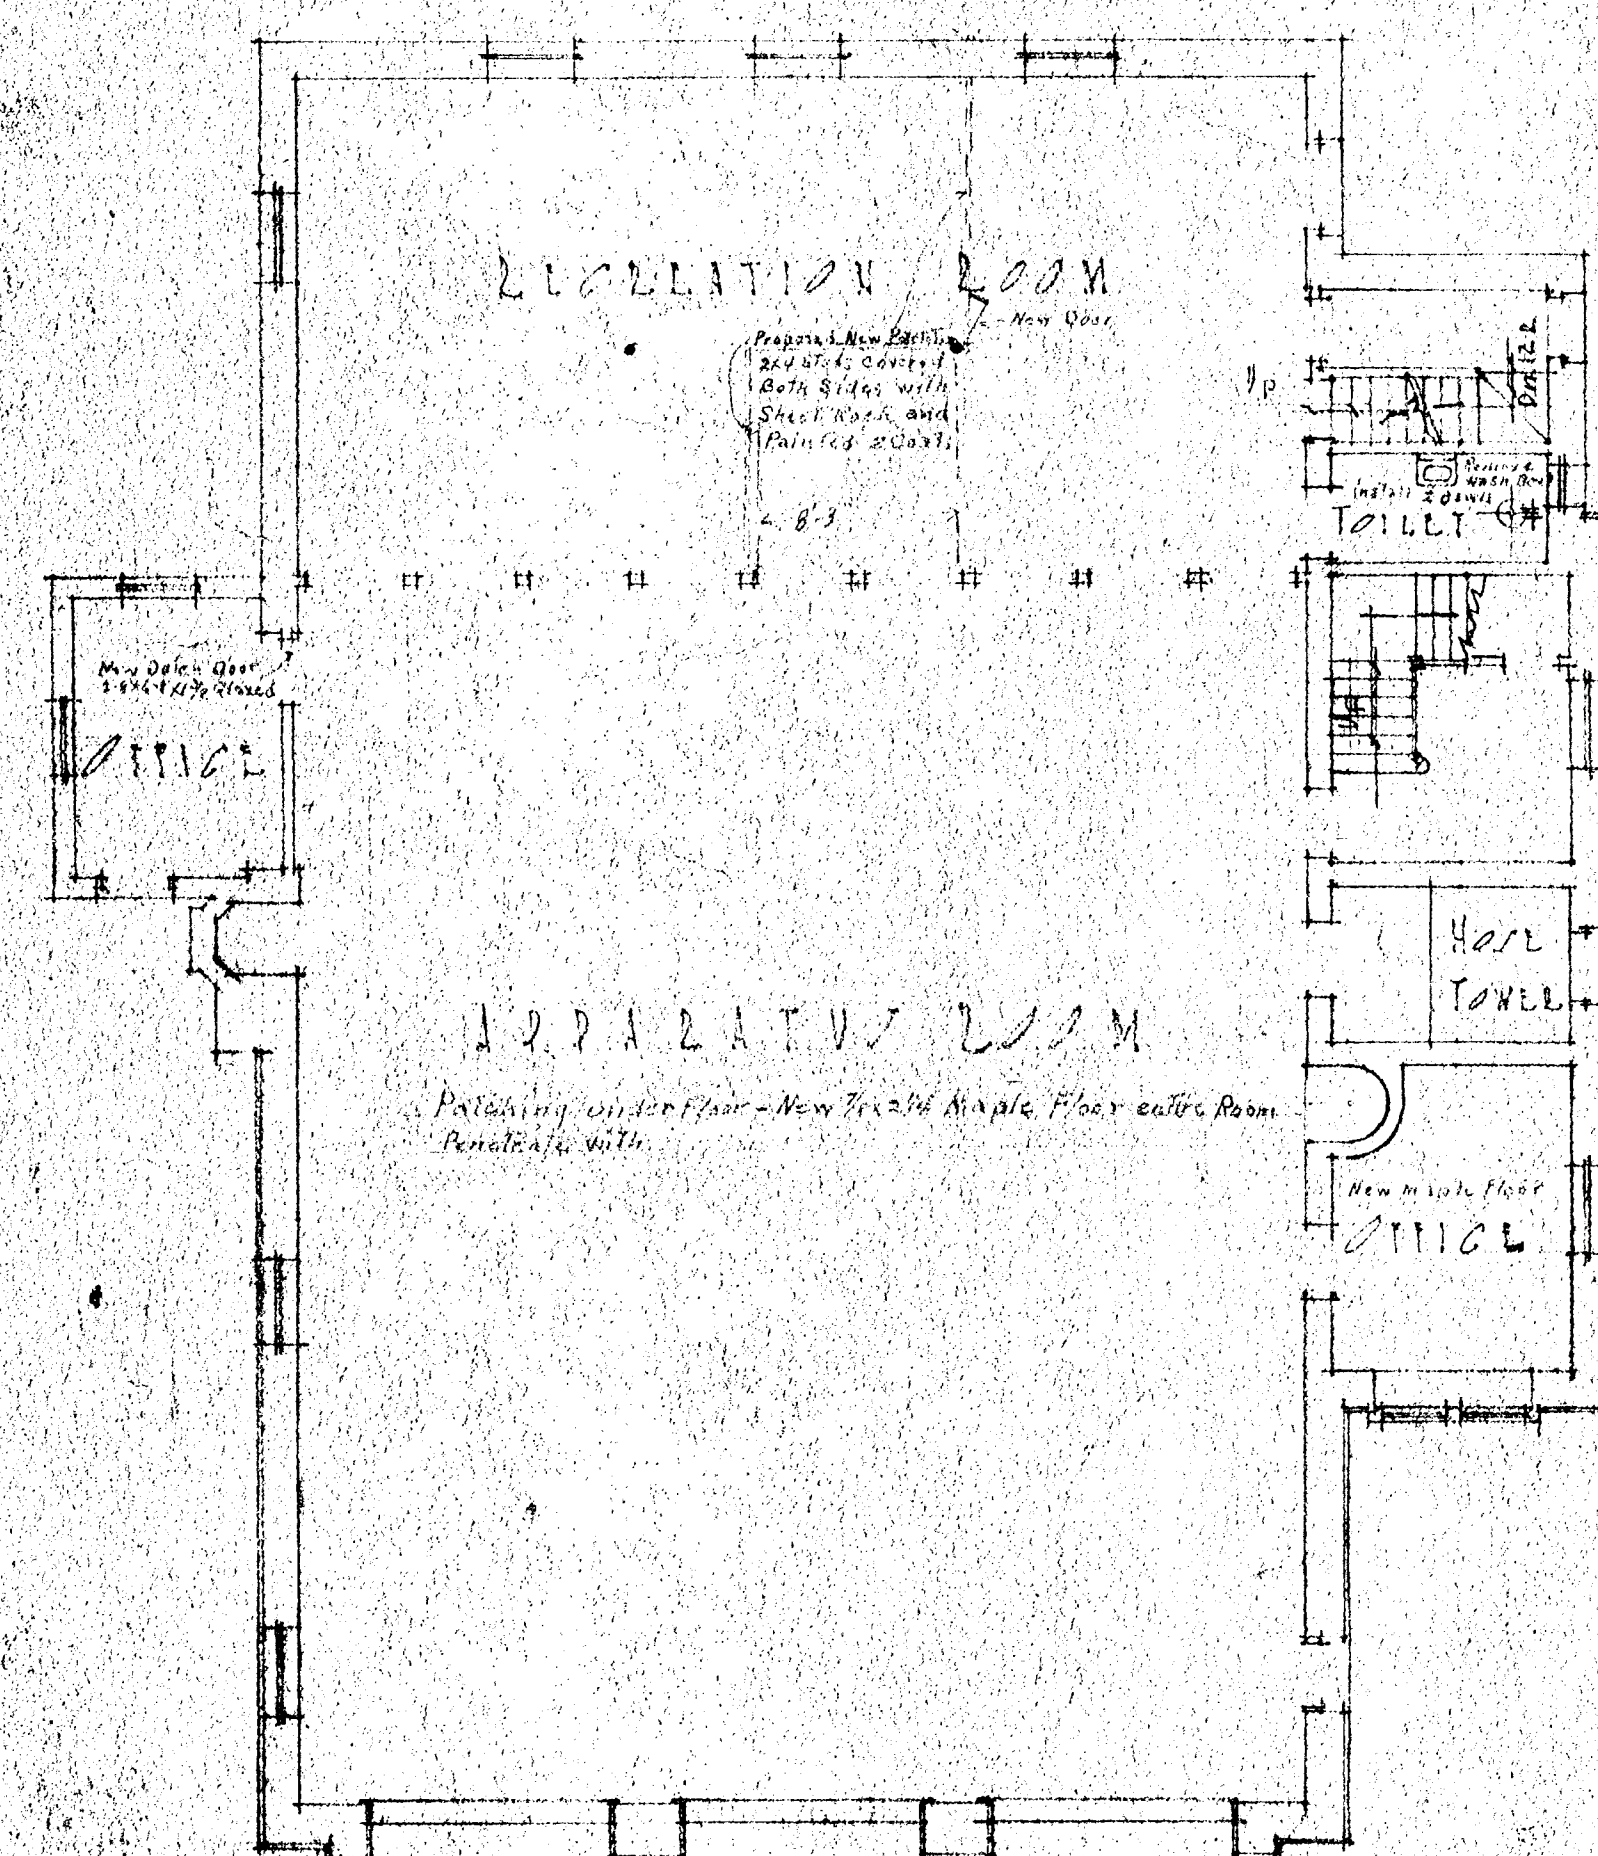


FIRST FLOOR PLAN

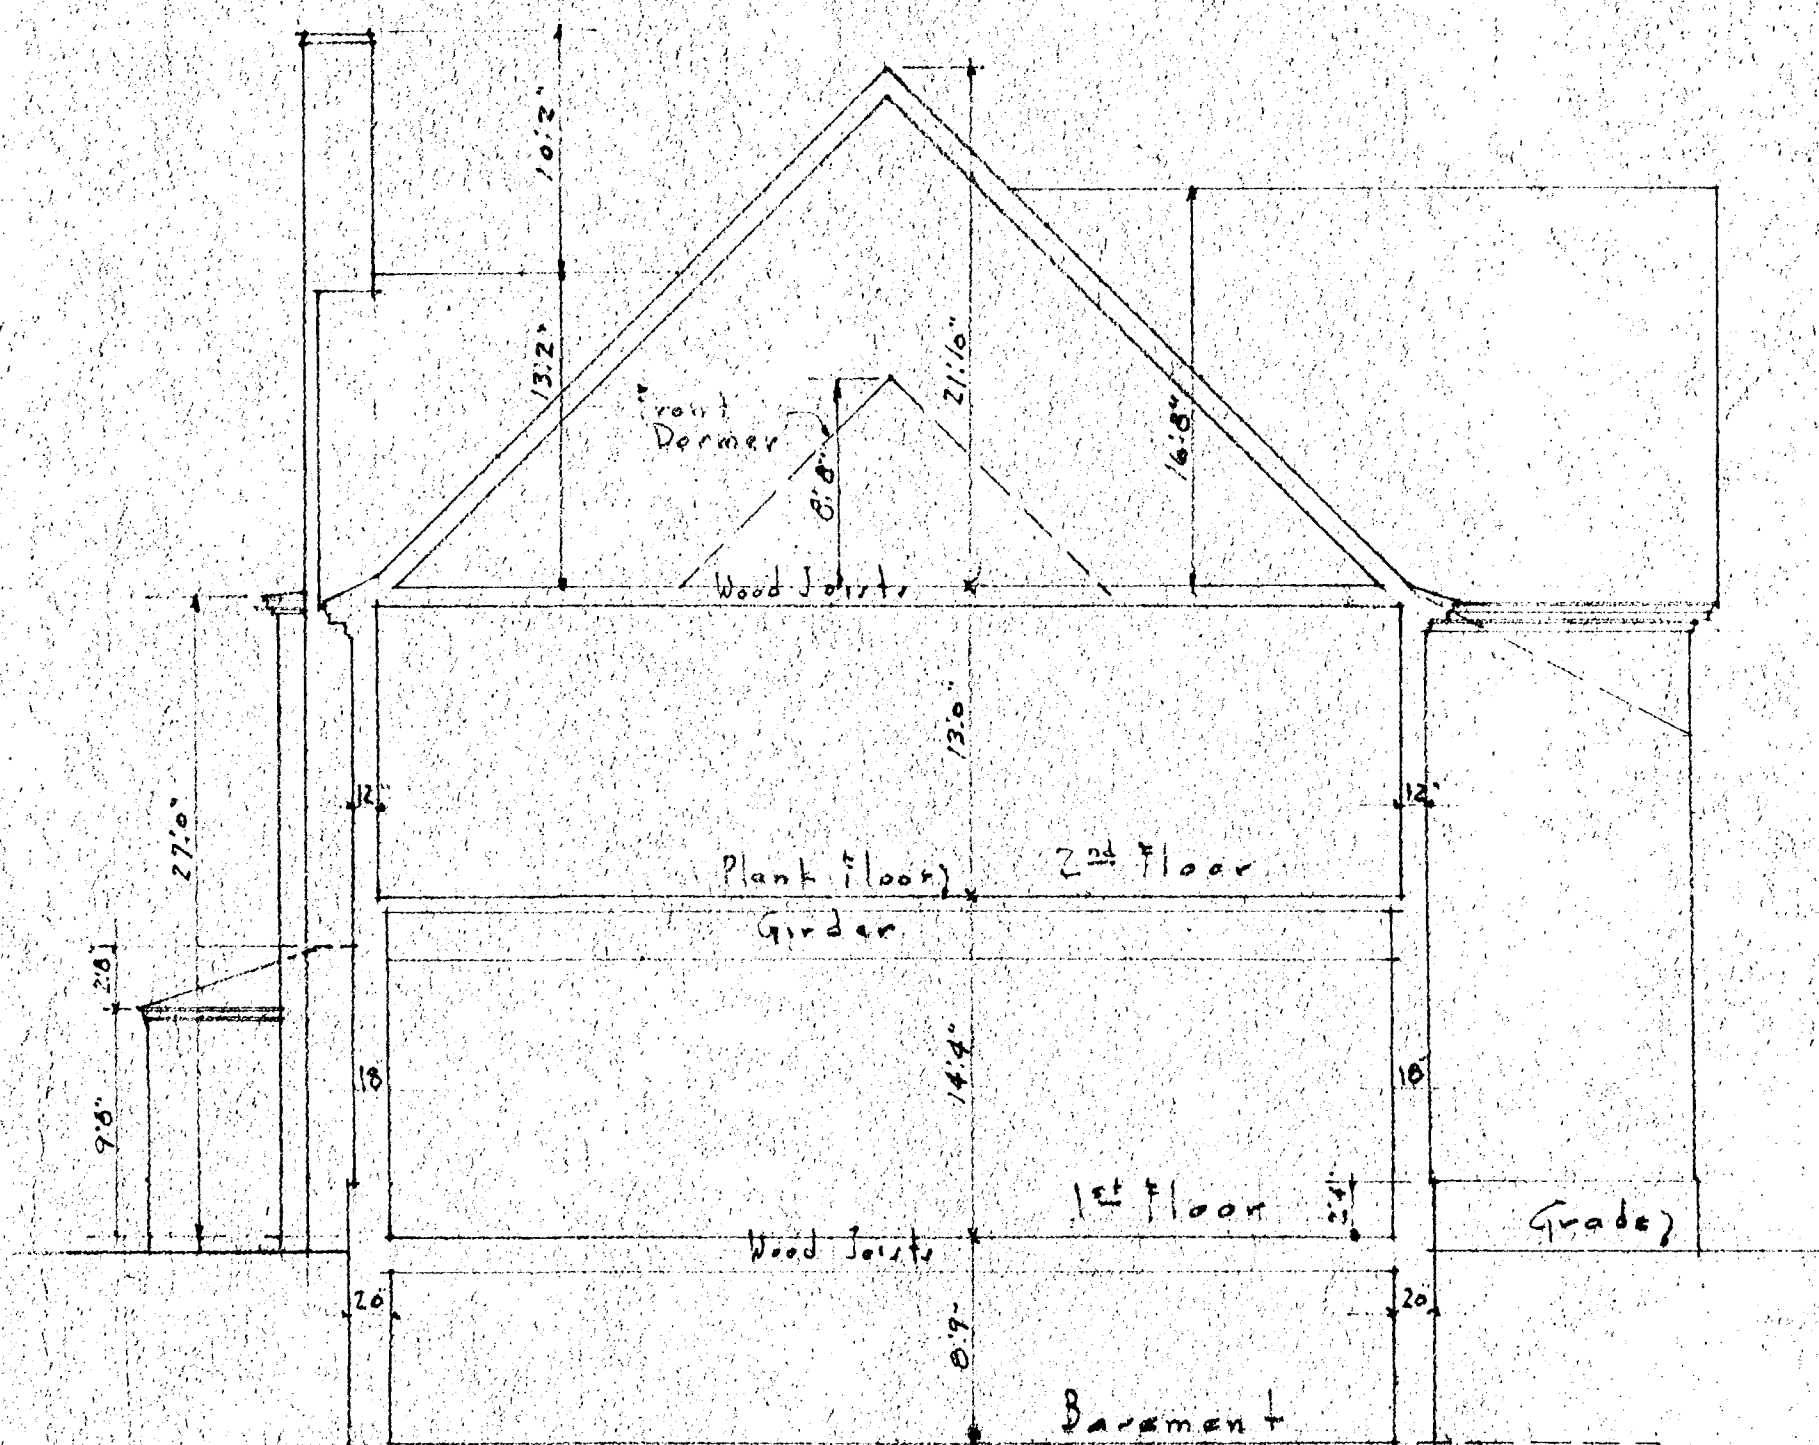

SECTION 1-1

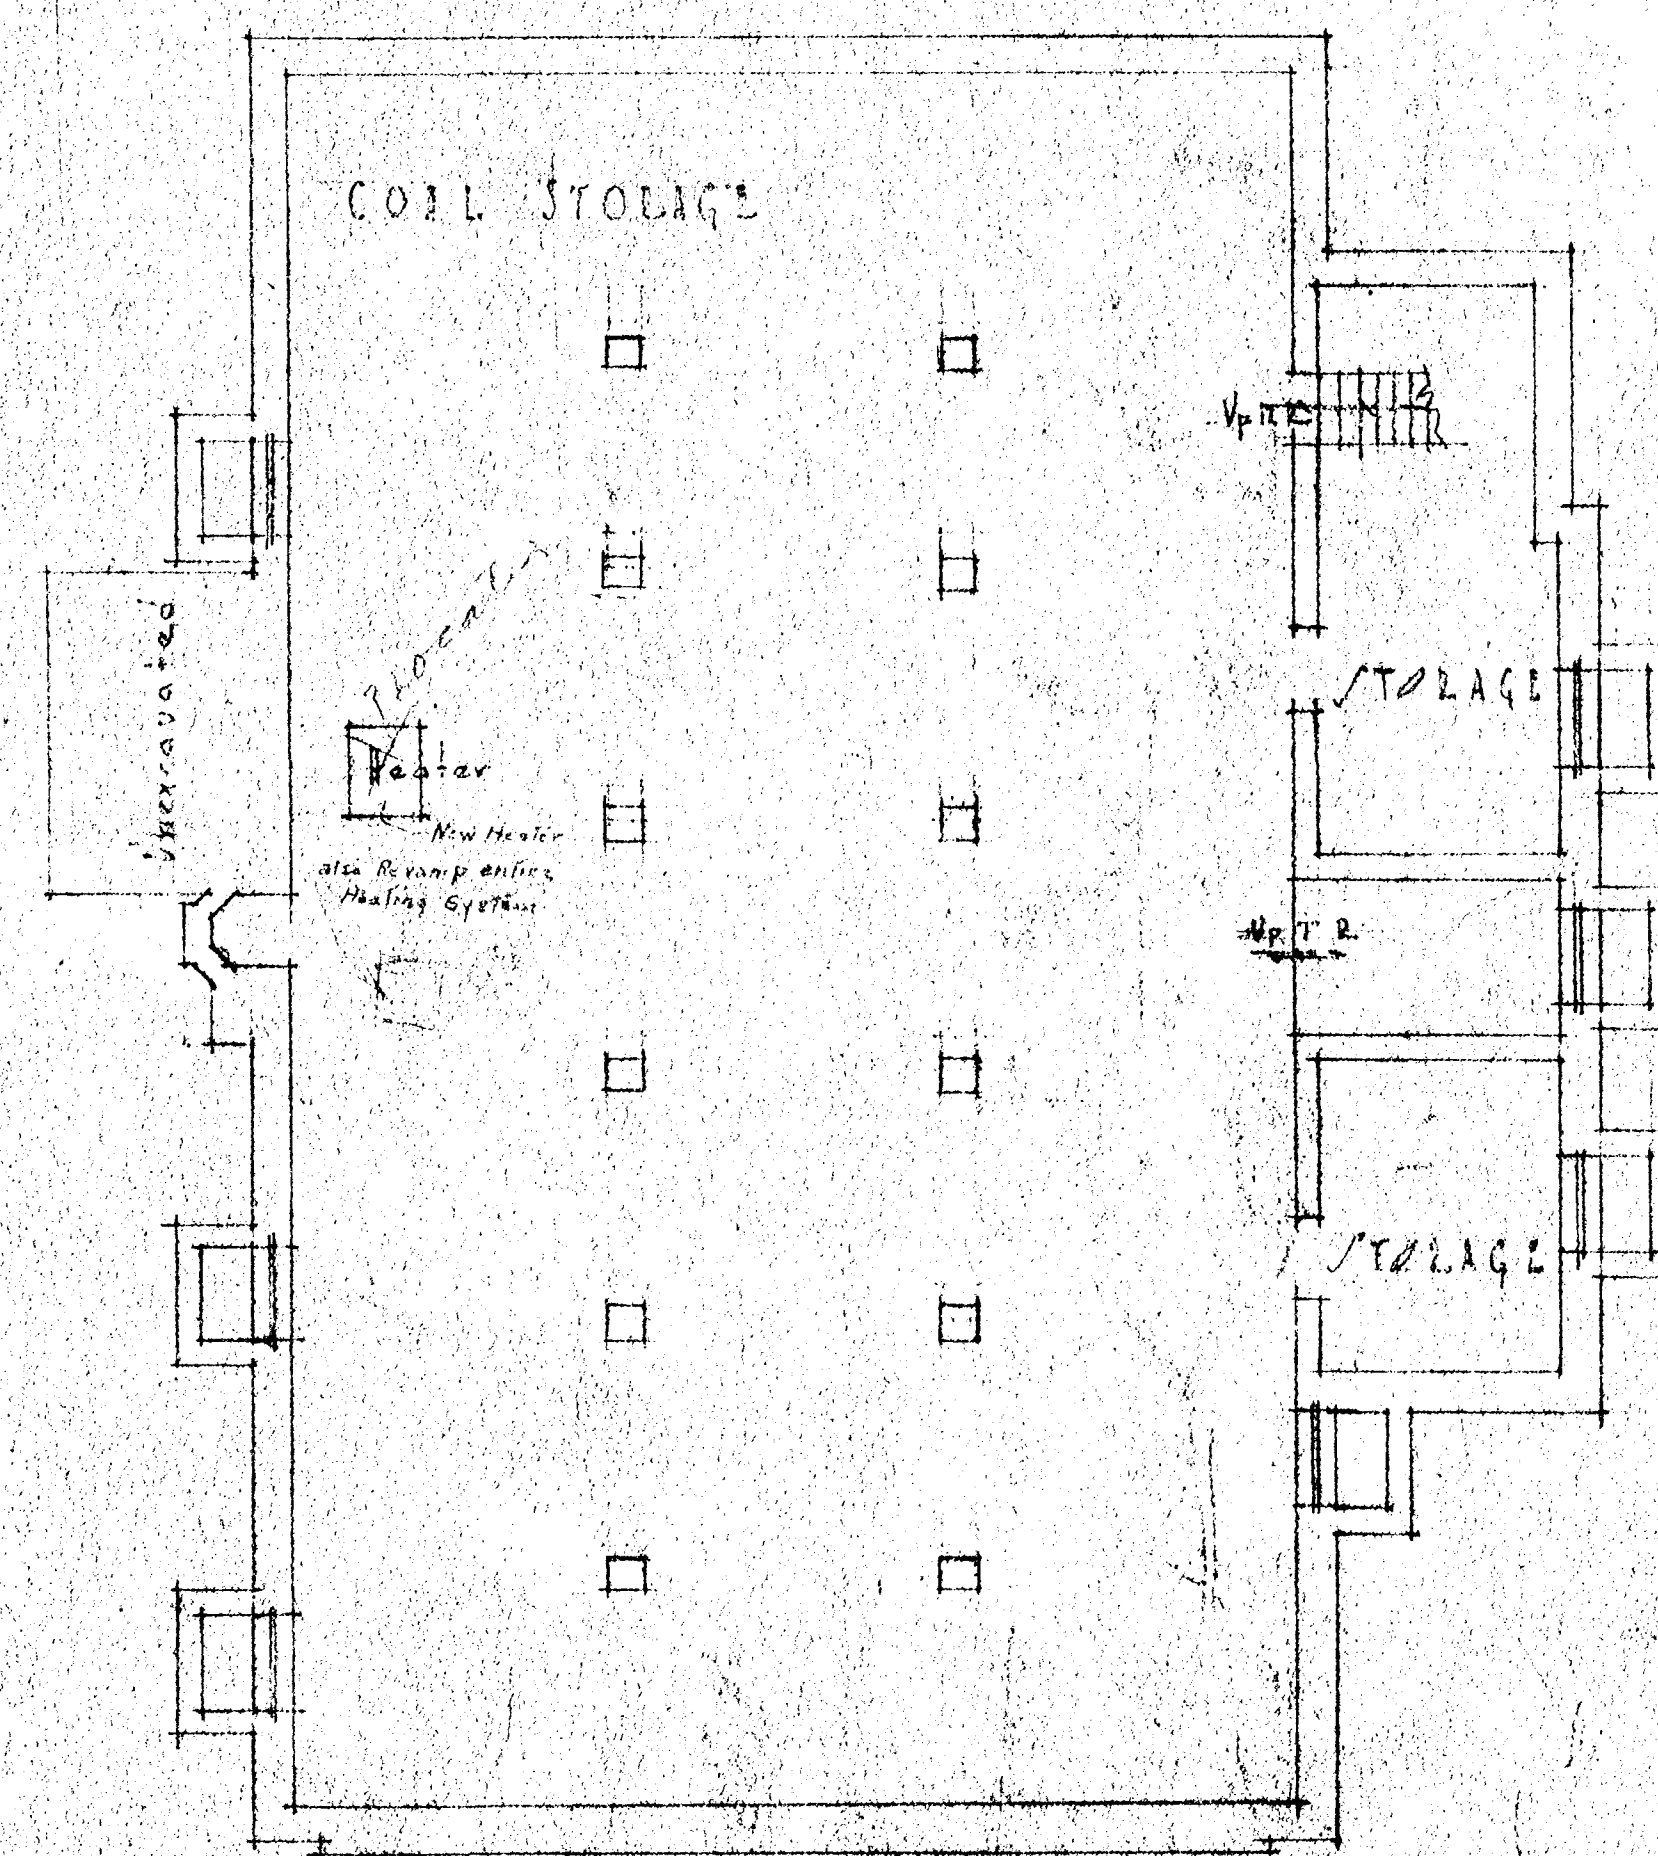

BASMENT PLAN

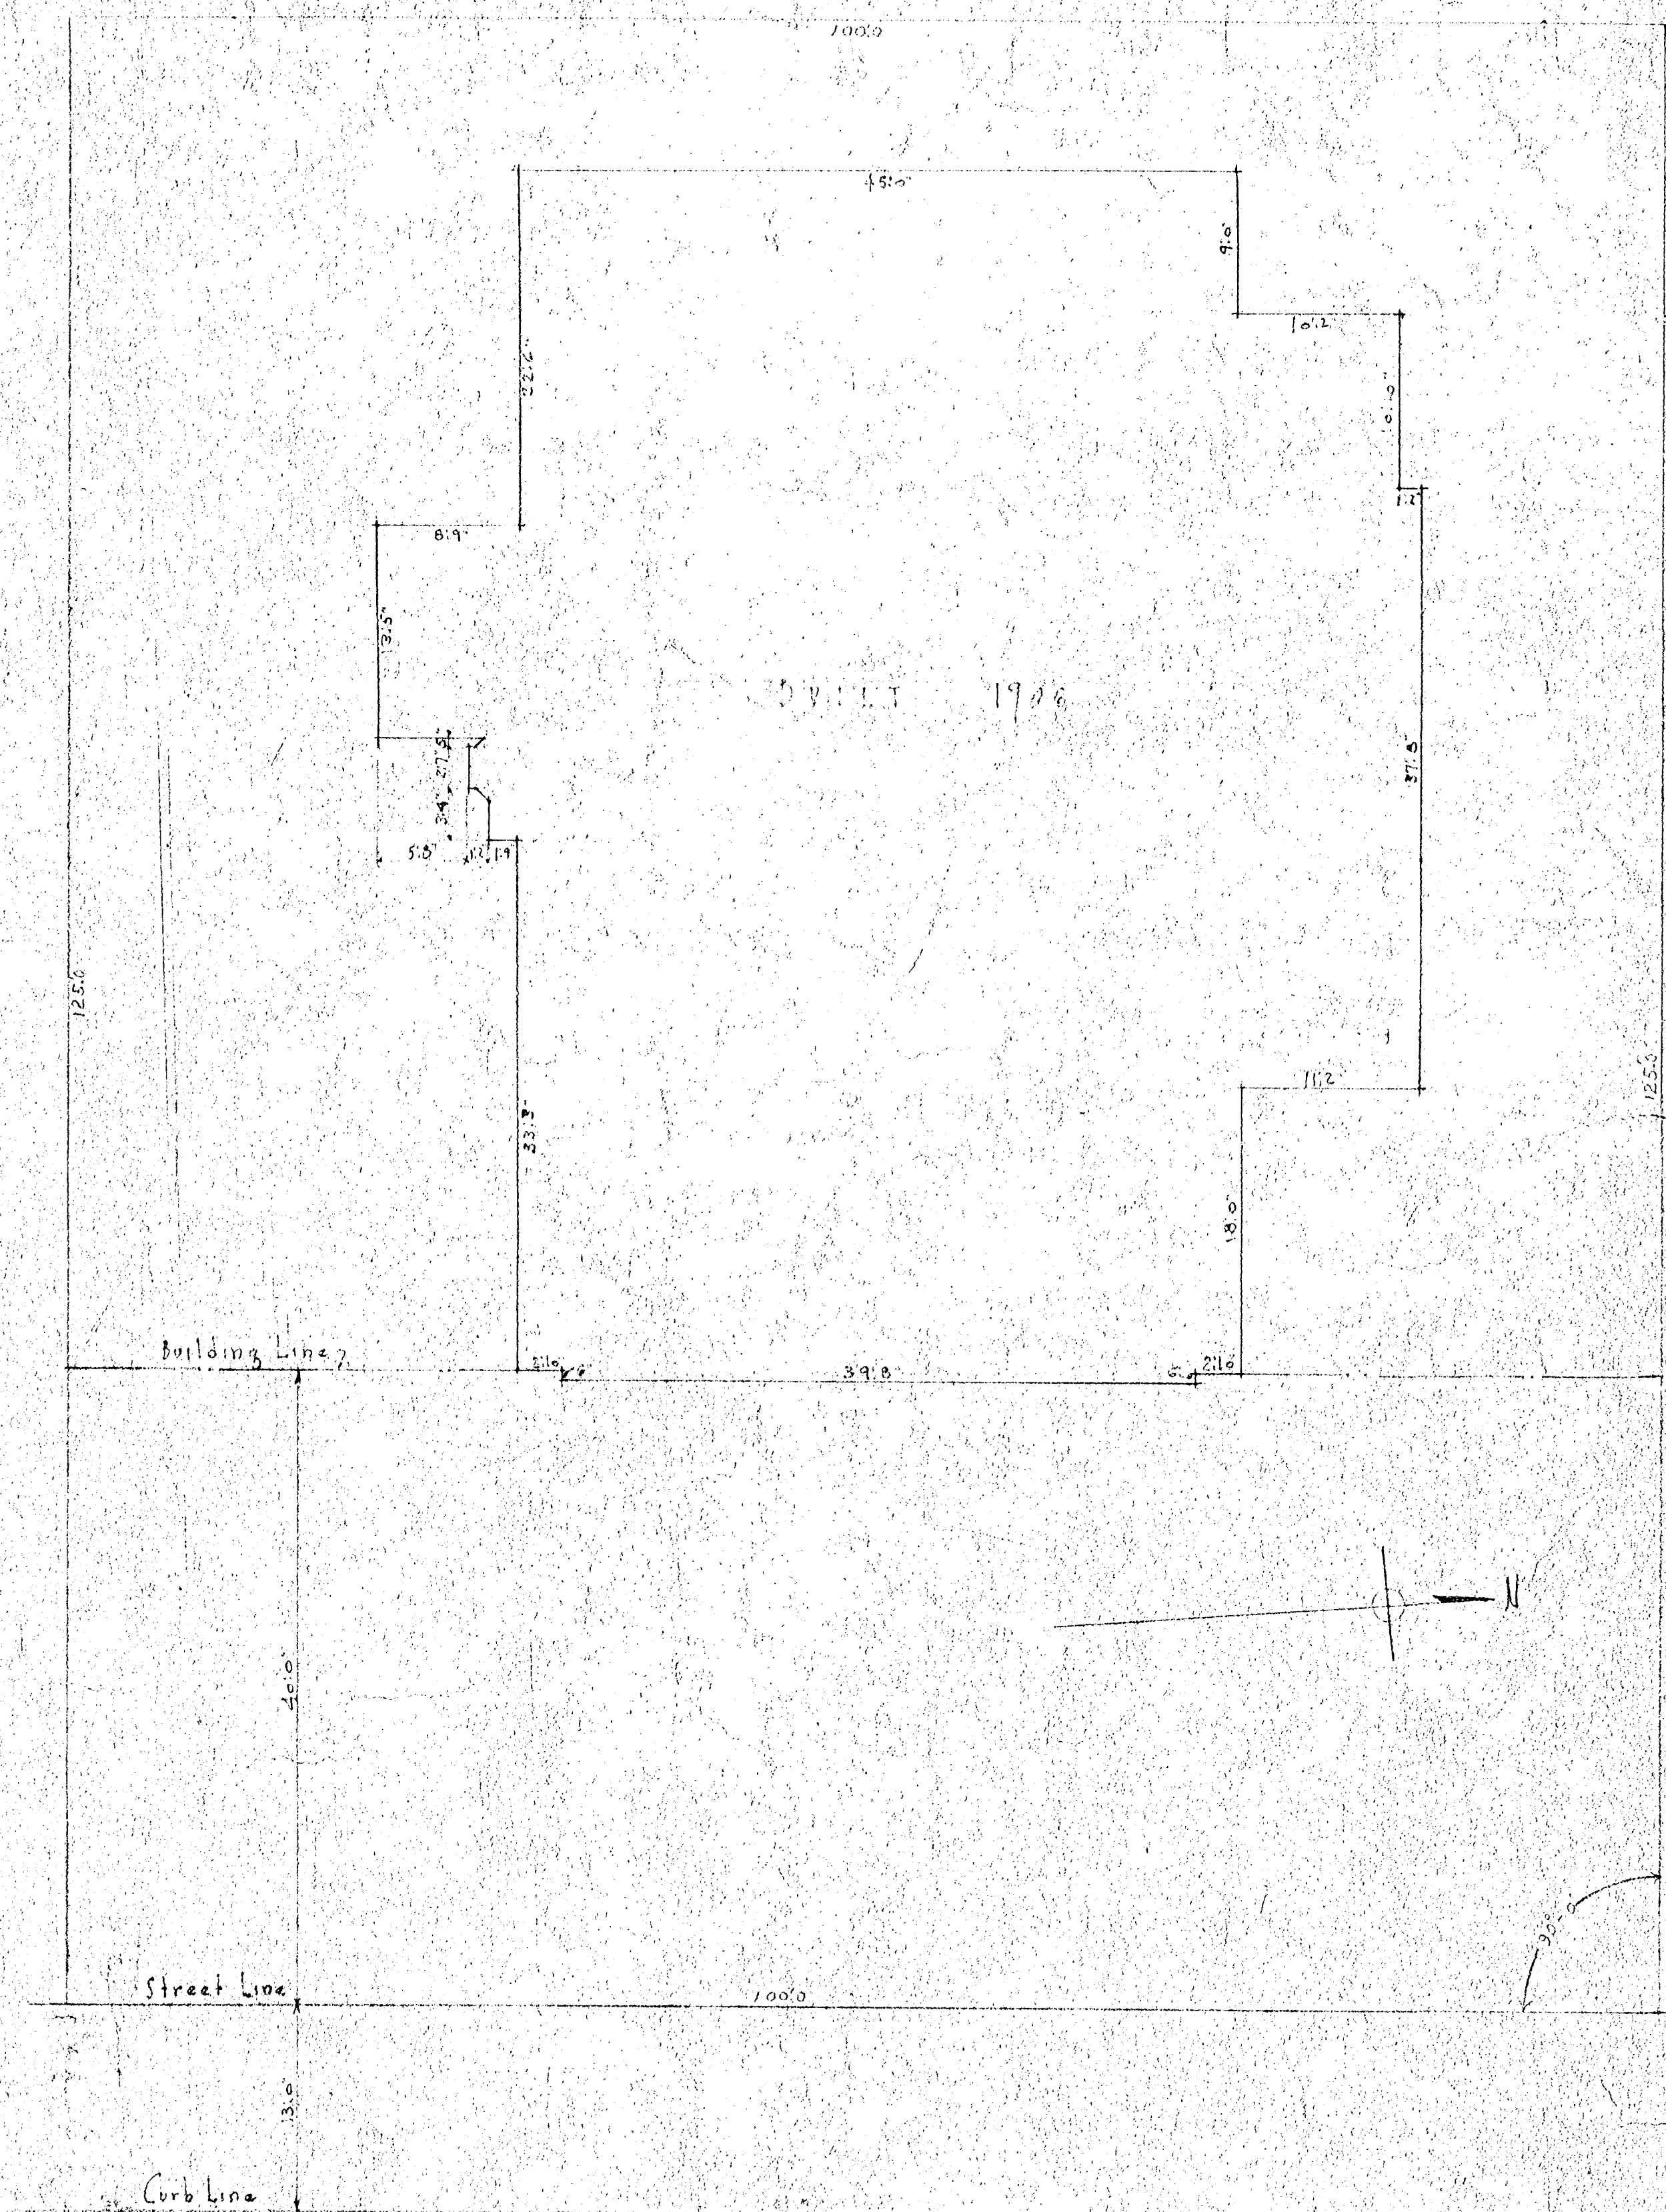

BLUE HILLS AVENUE
PLOT PLAN

ITEM D-13	
28 BLUE HILLS AVENUE	
Date 11-20-34	Scale 1/4" = 1'-0"
Drawn by J. D. L.	
Area of site 12,500 sq. ft. Total floor area 8,000 sq. ft.	
Area of bldg. at ground level 4,000 sq. ft.	
Percentage of site occupied by bldg. 32.0%	
Curb line in plot 177.315 Cu. ft.	