
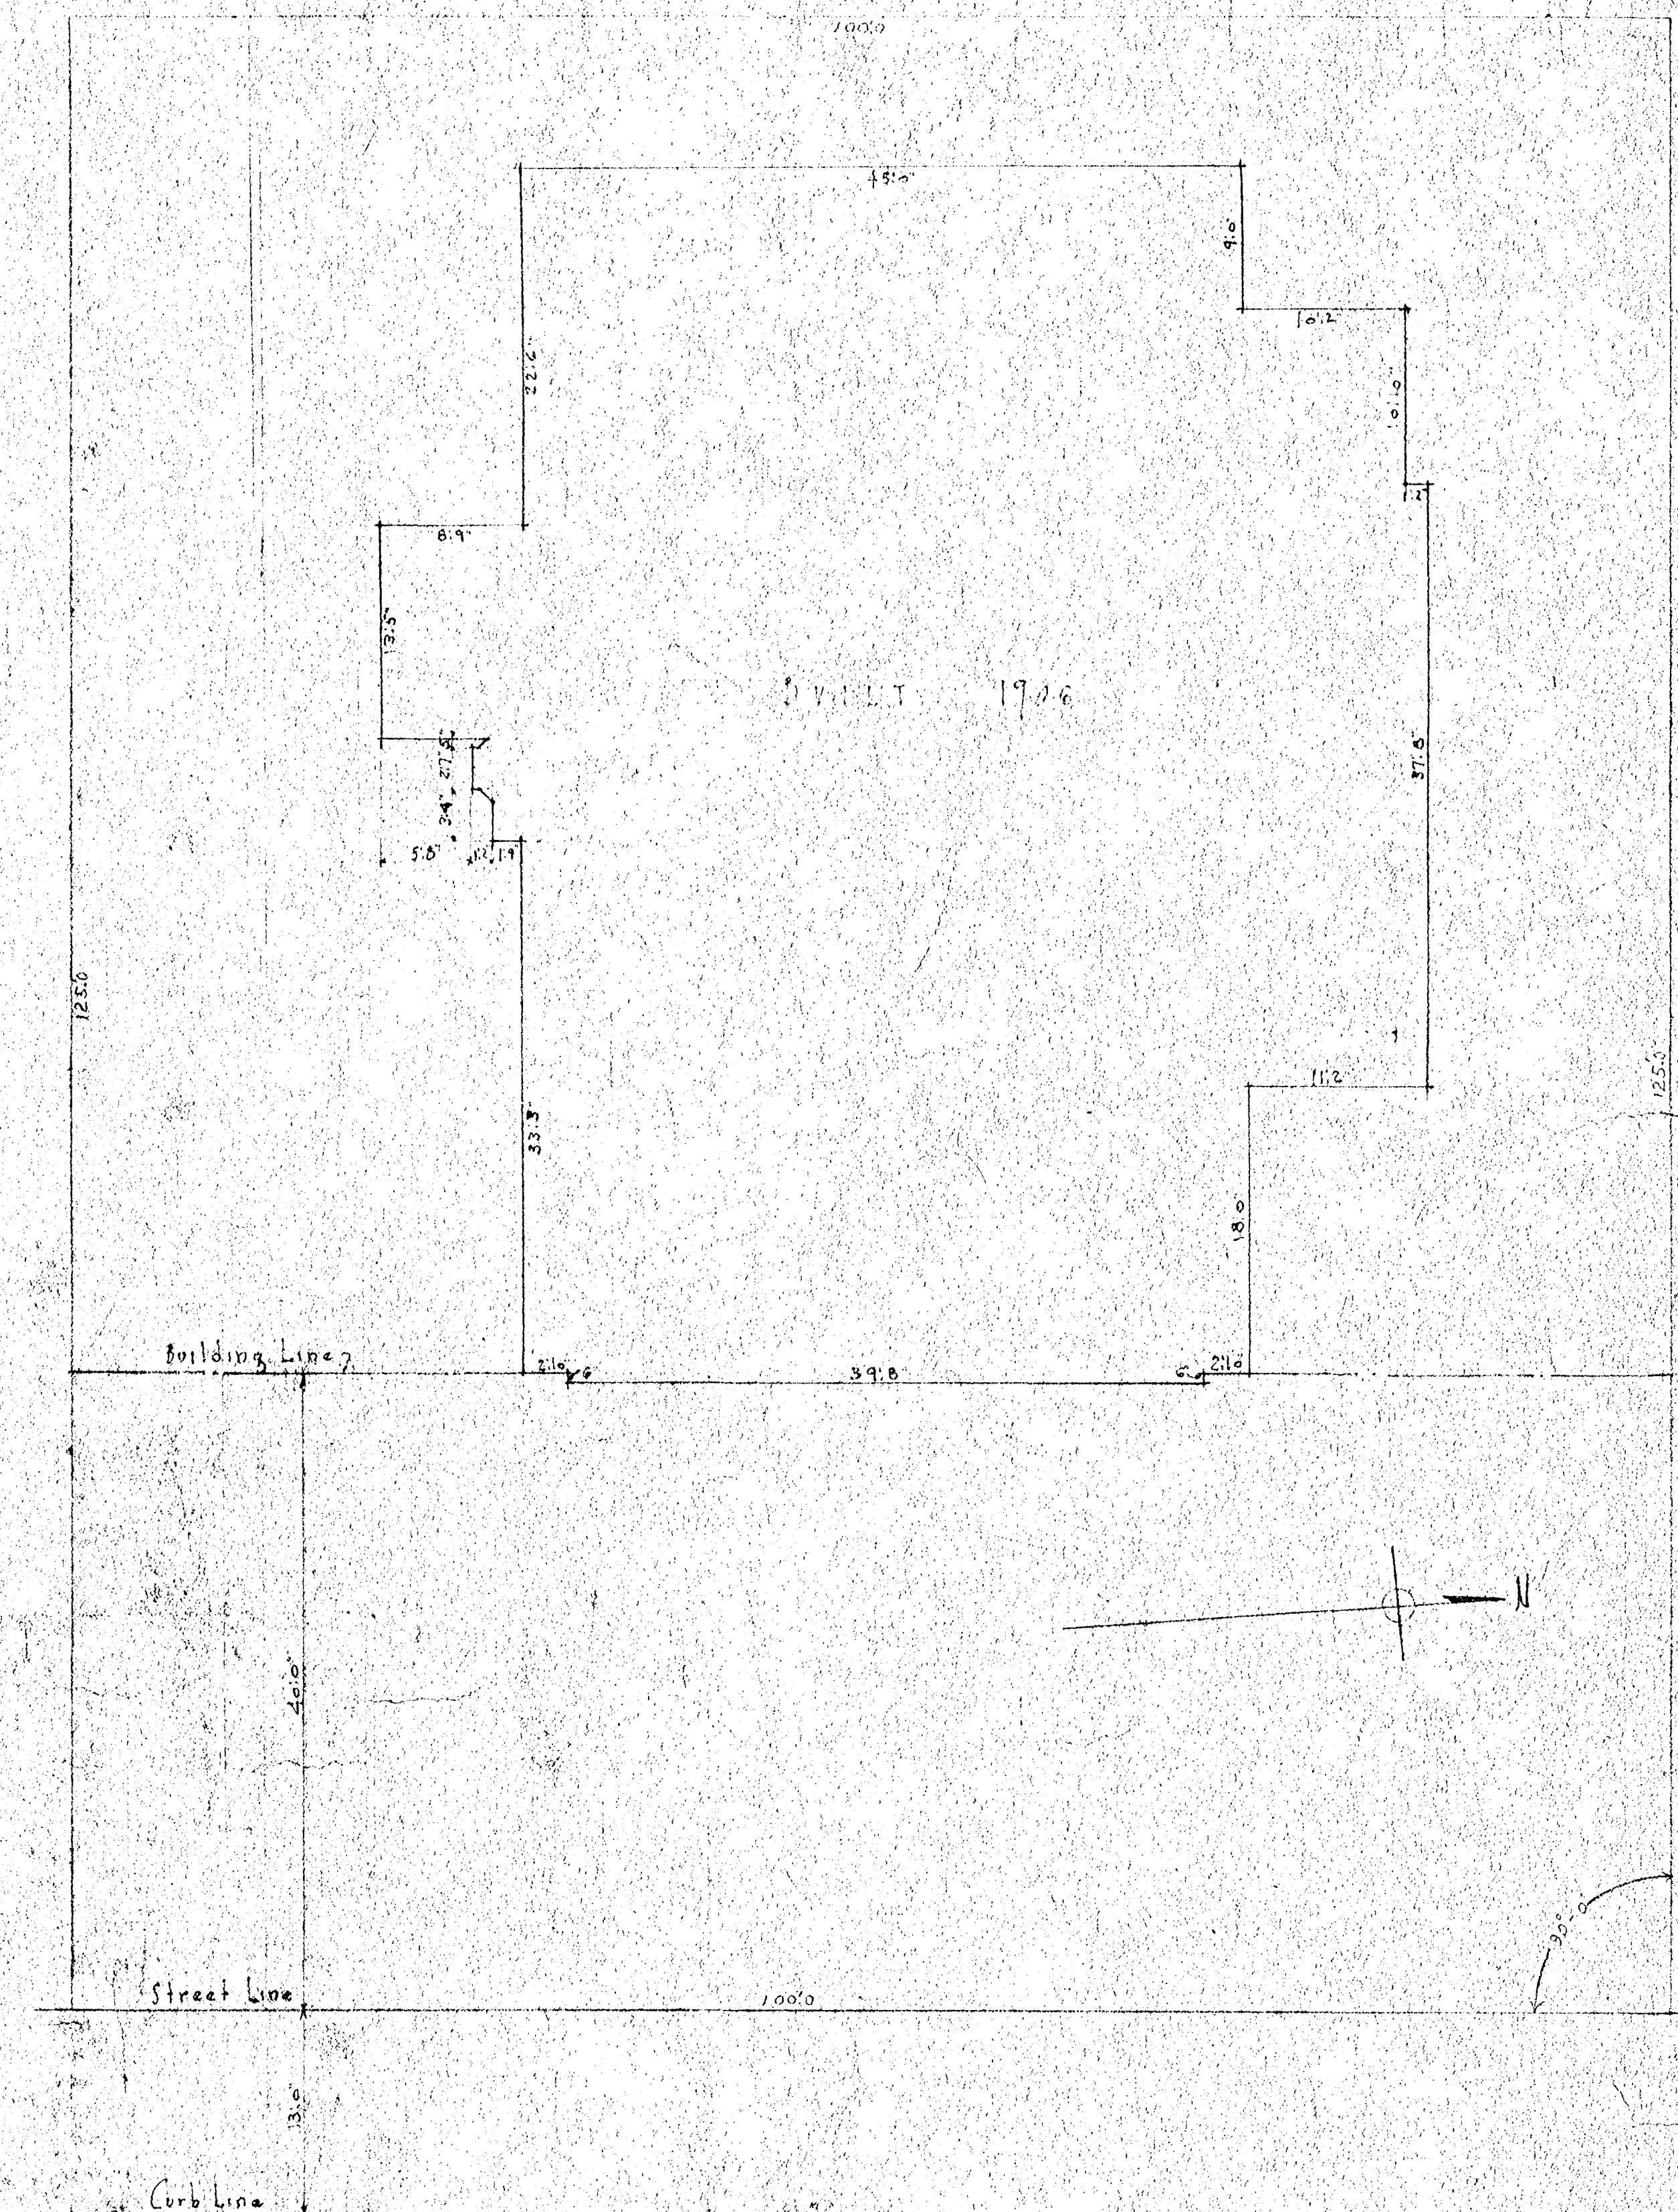
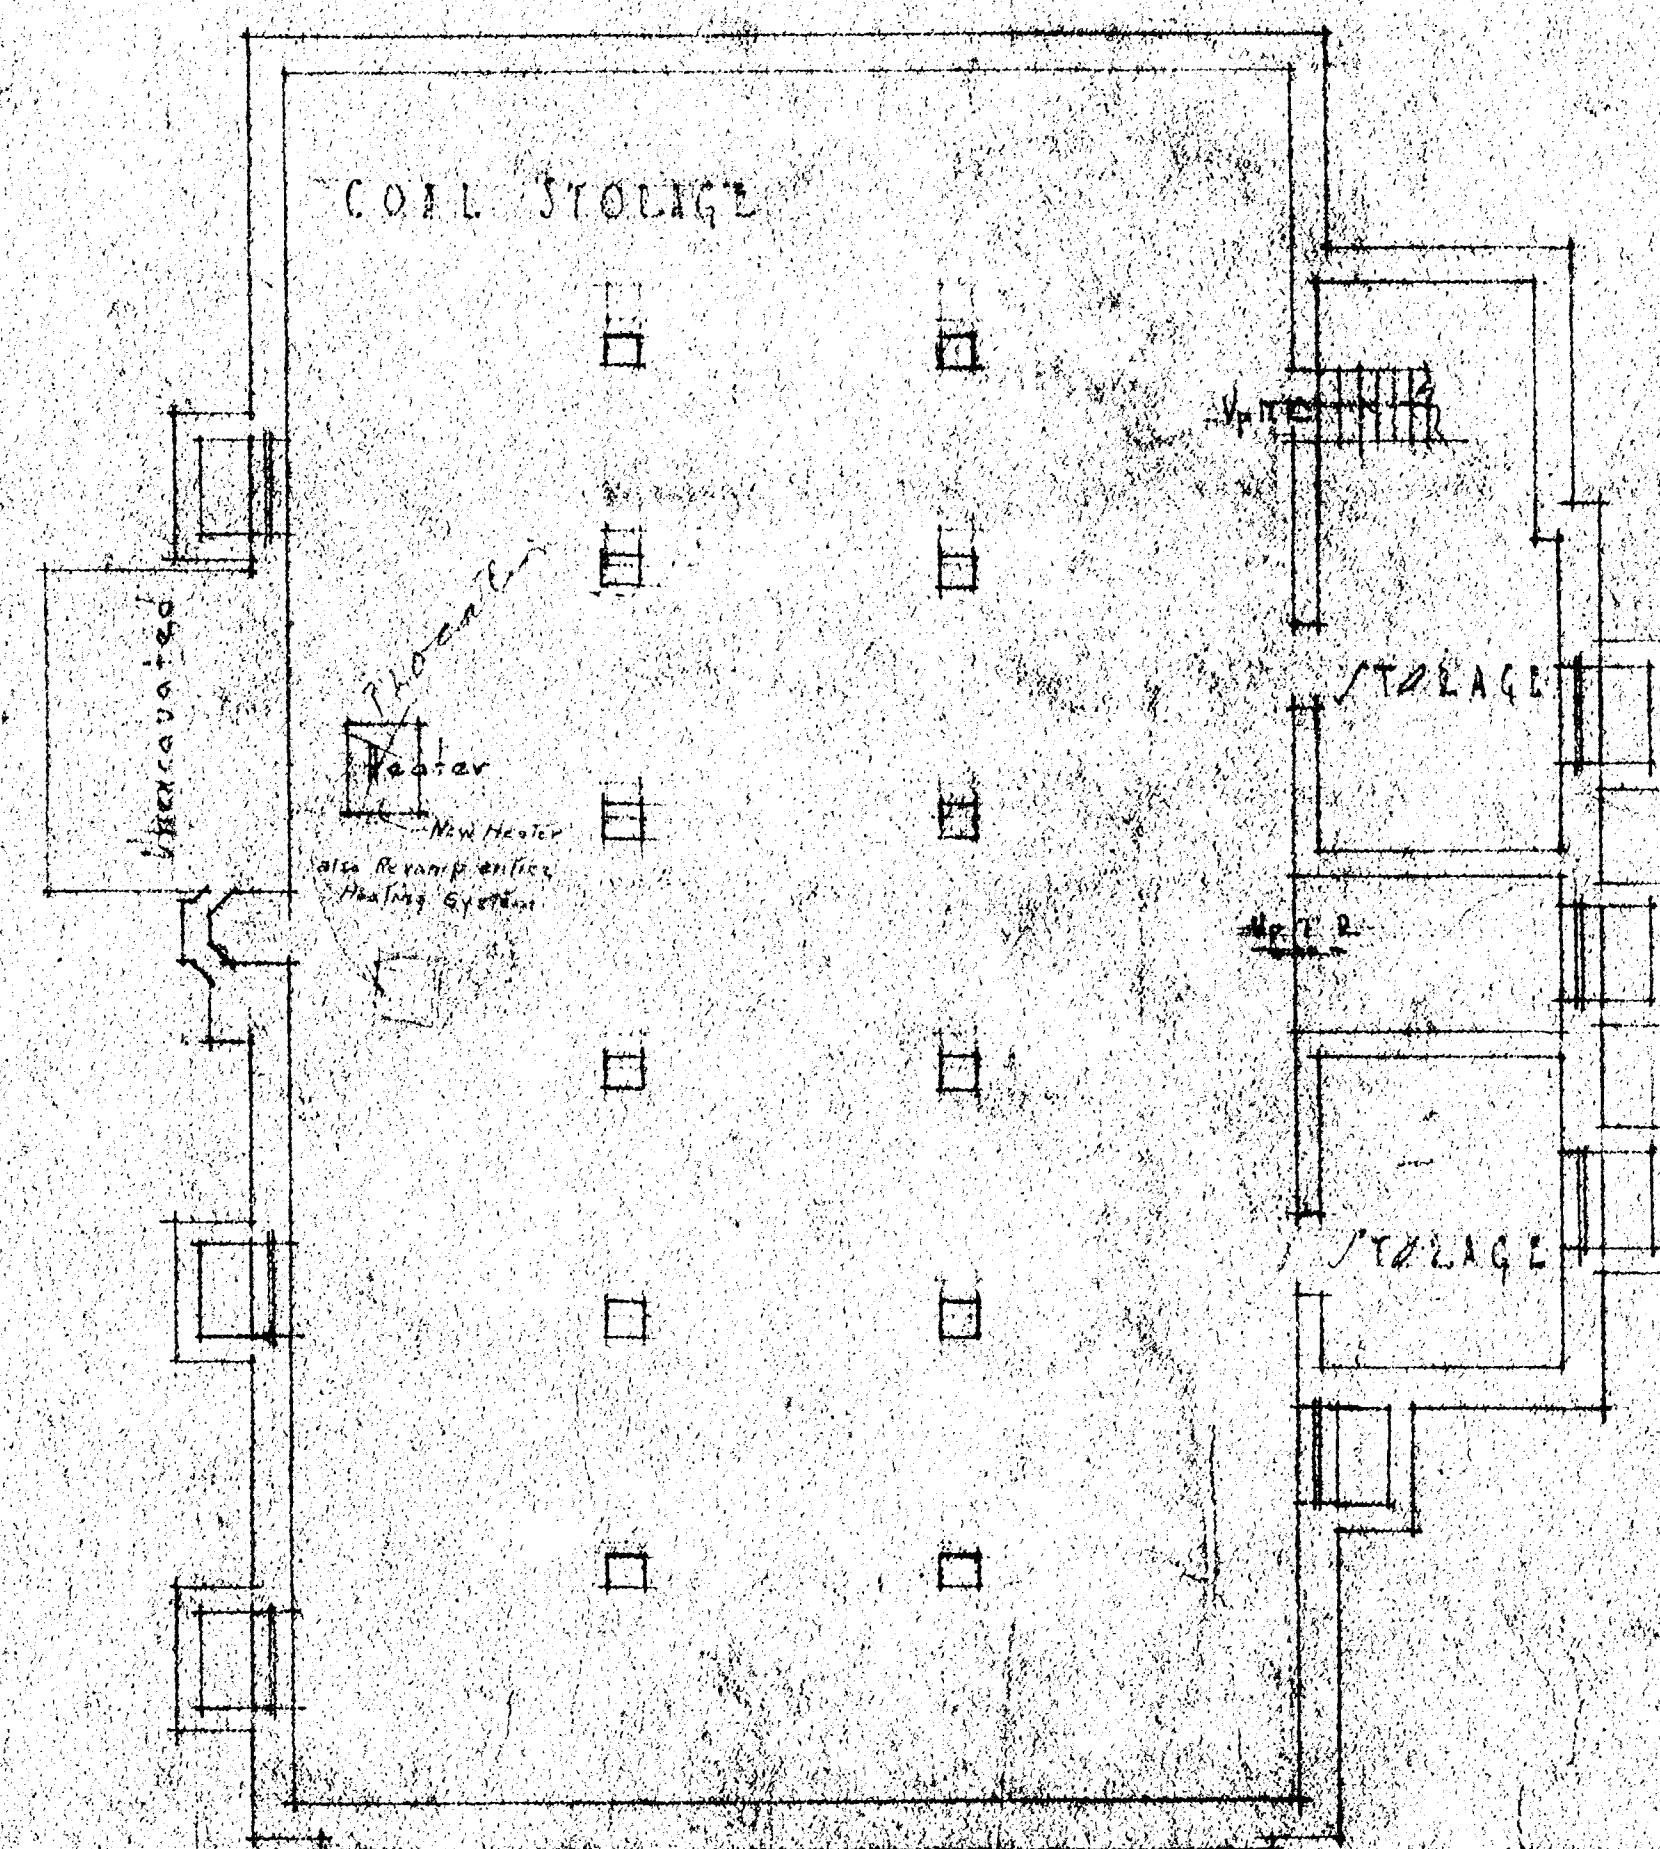
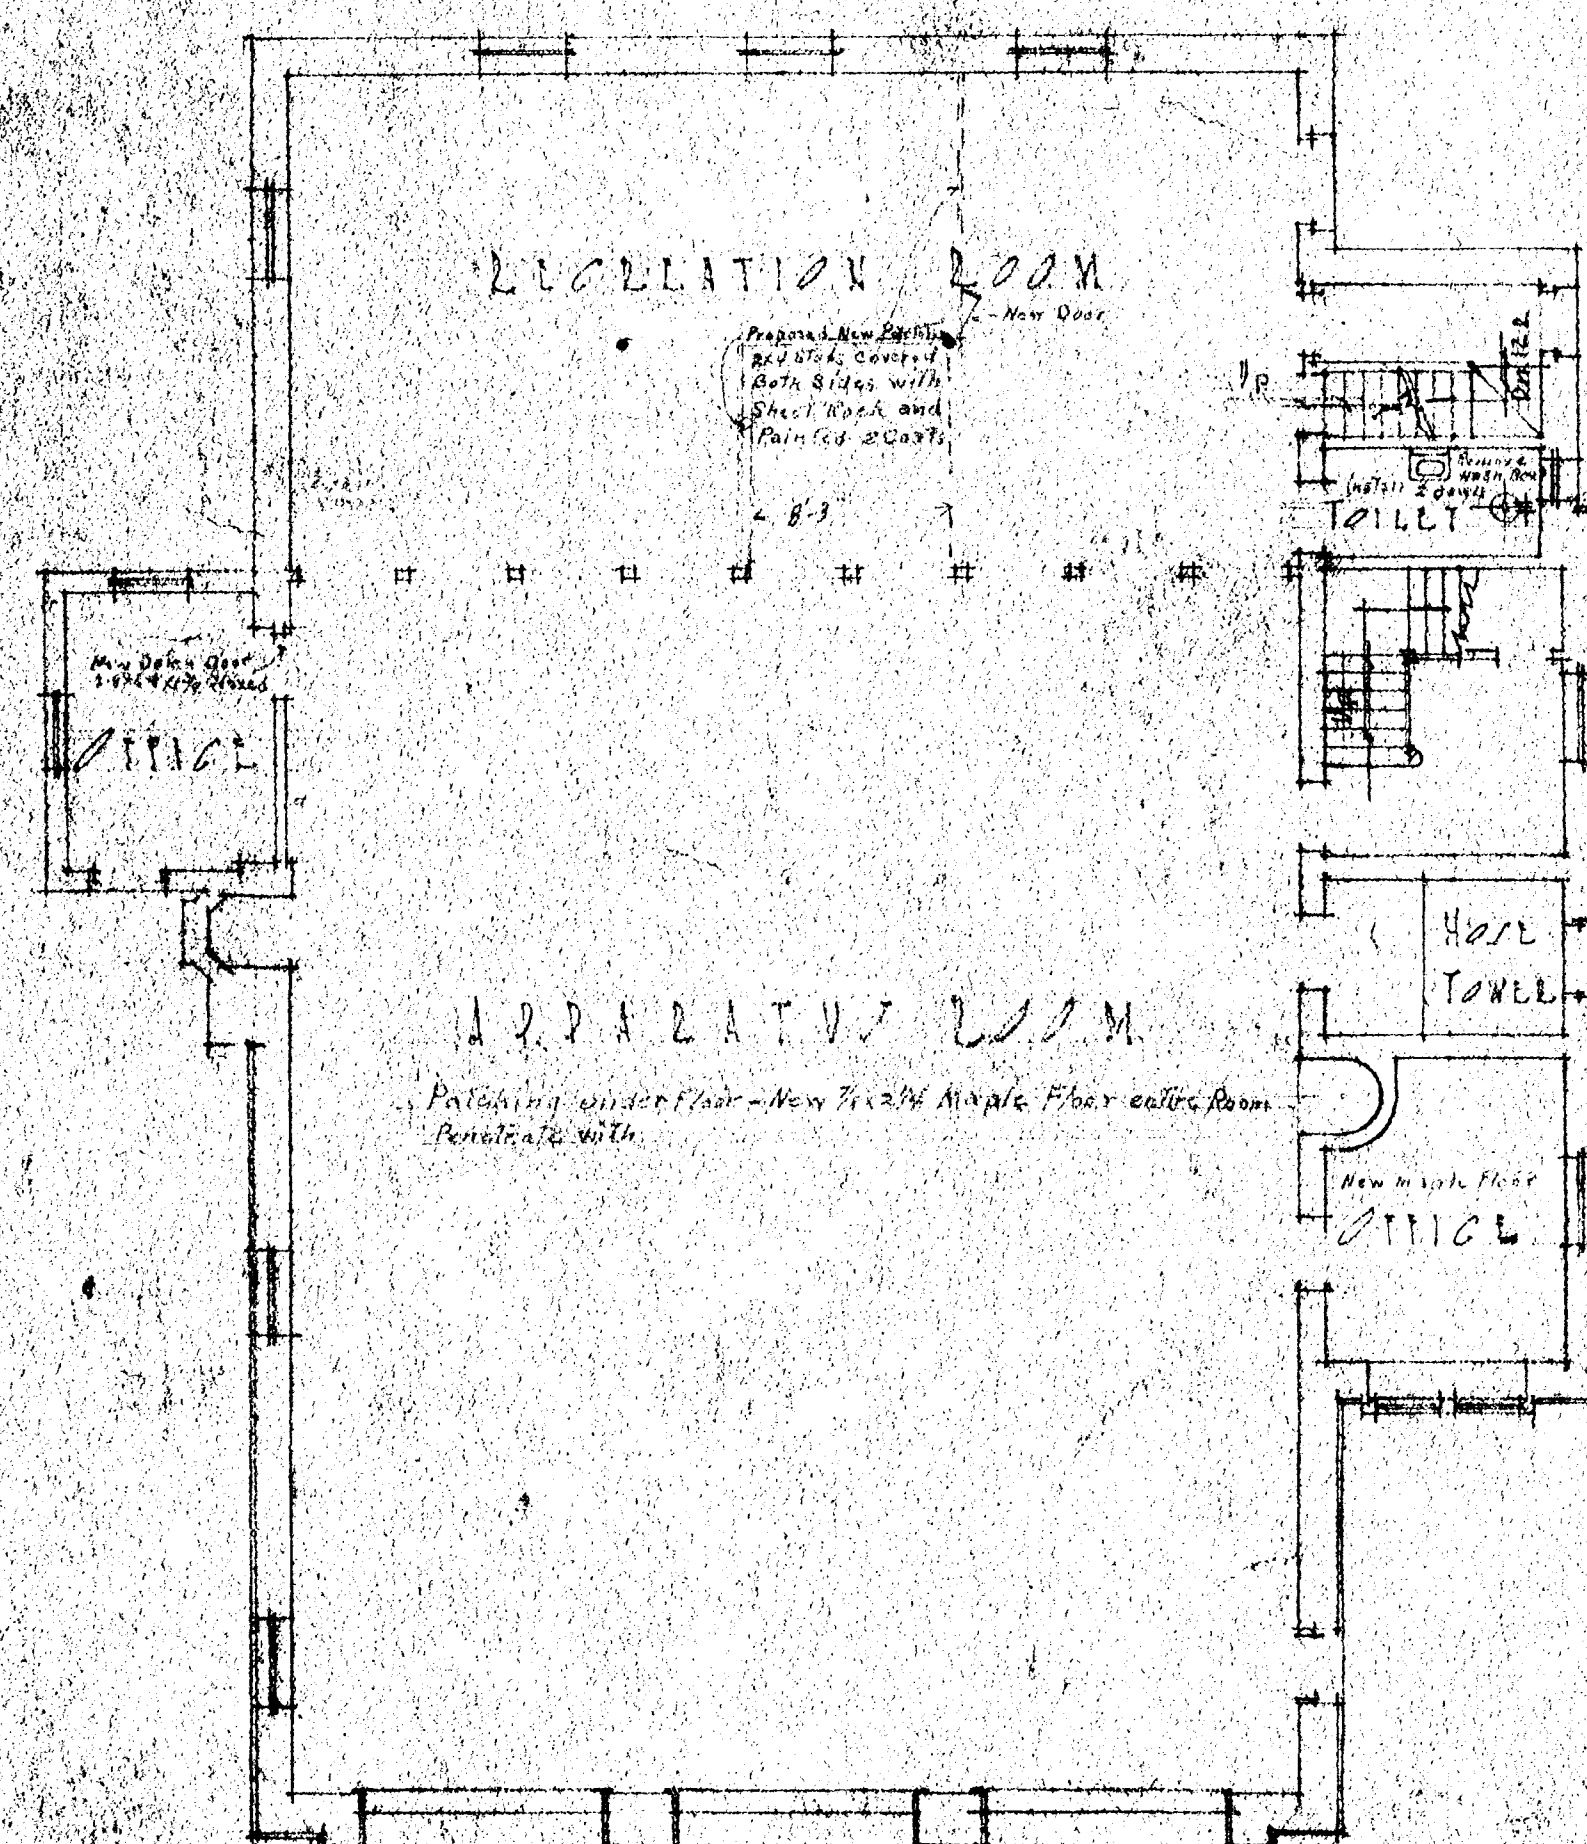
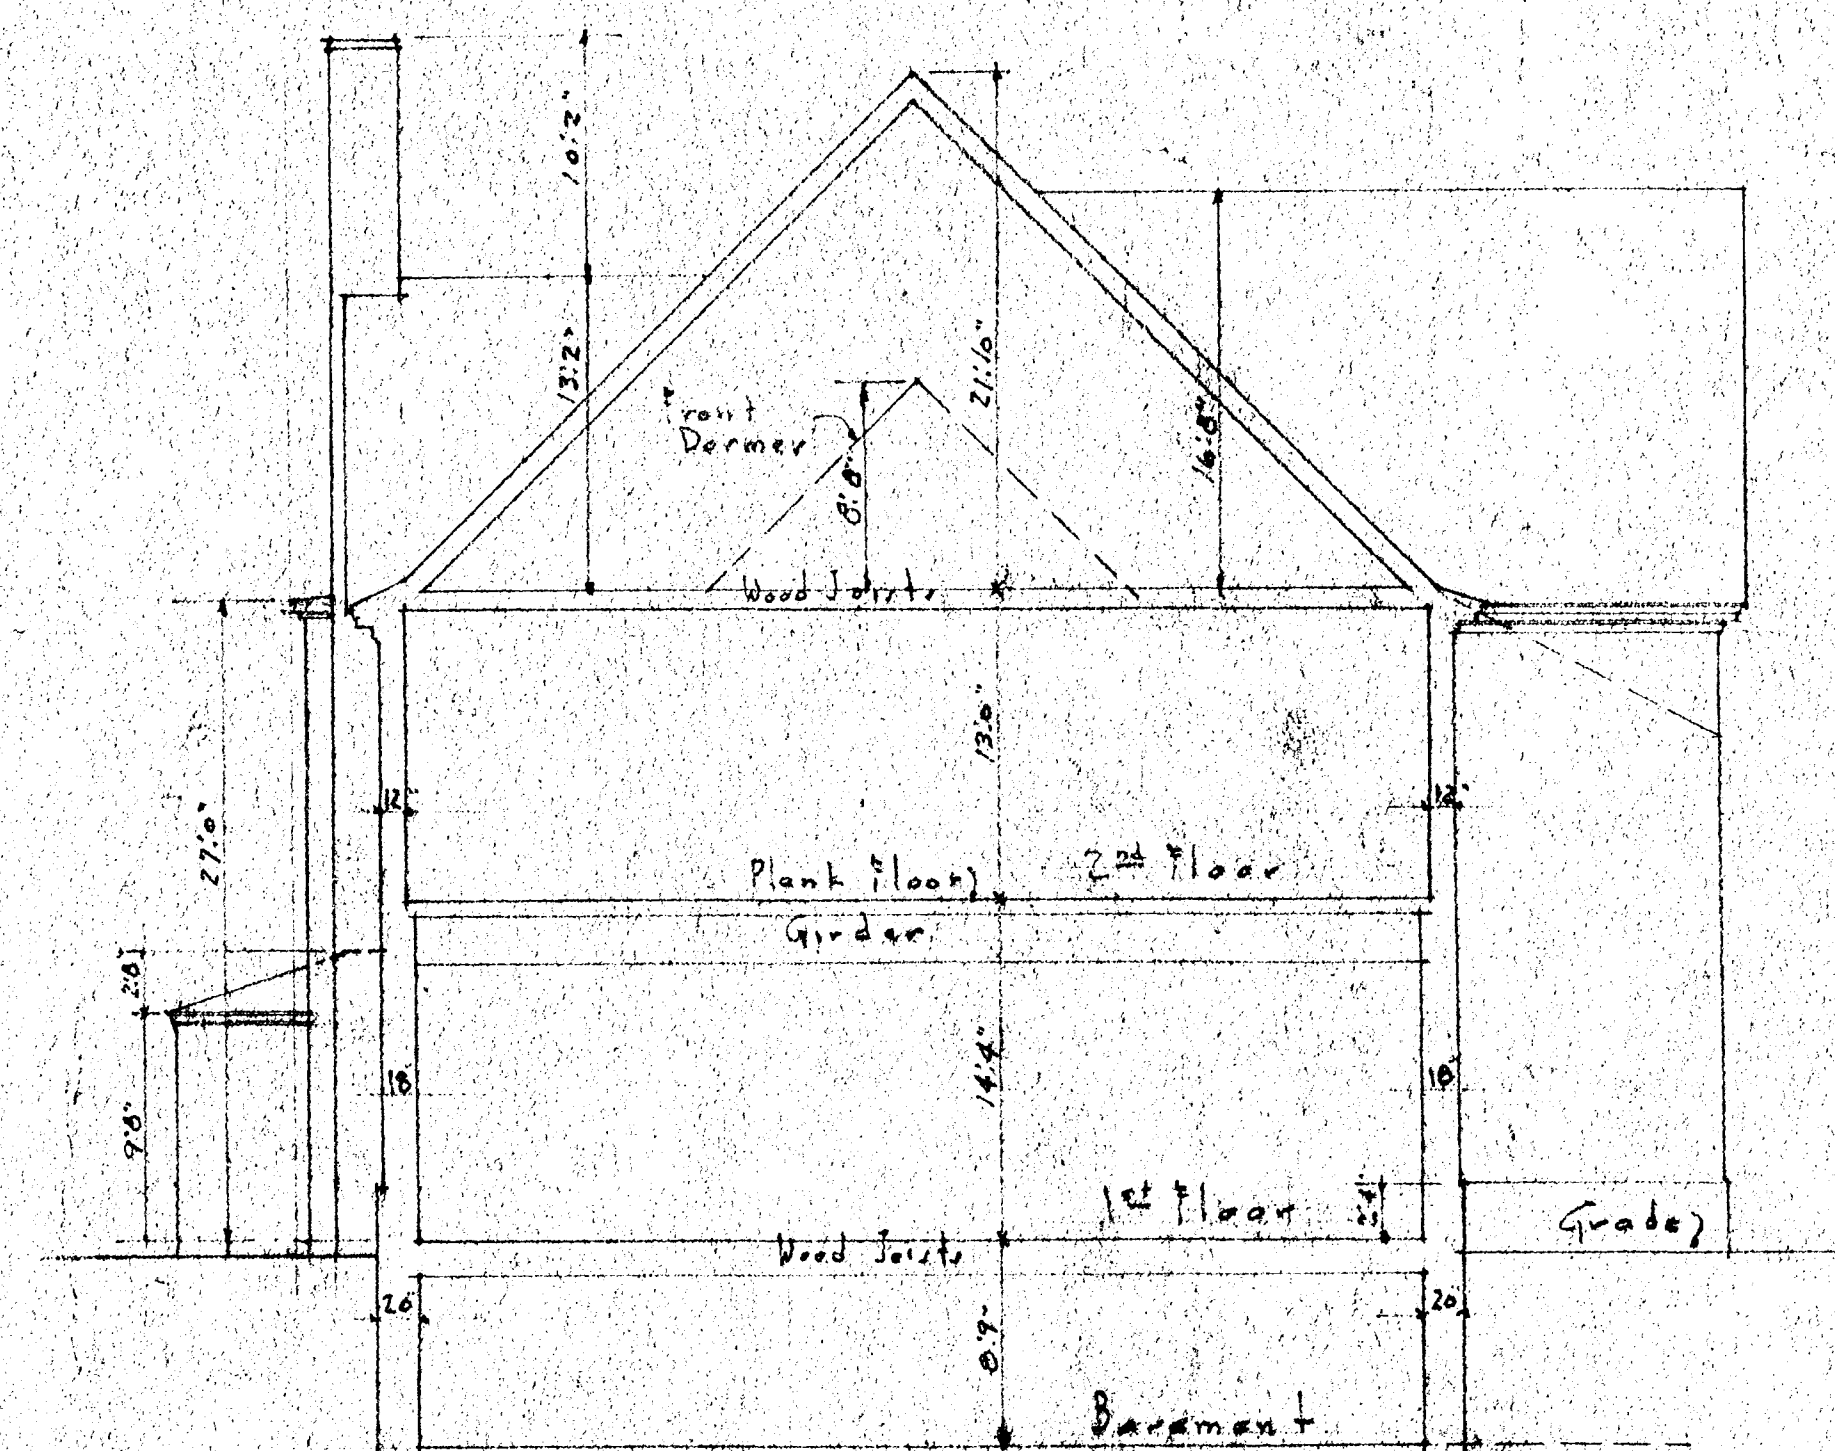


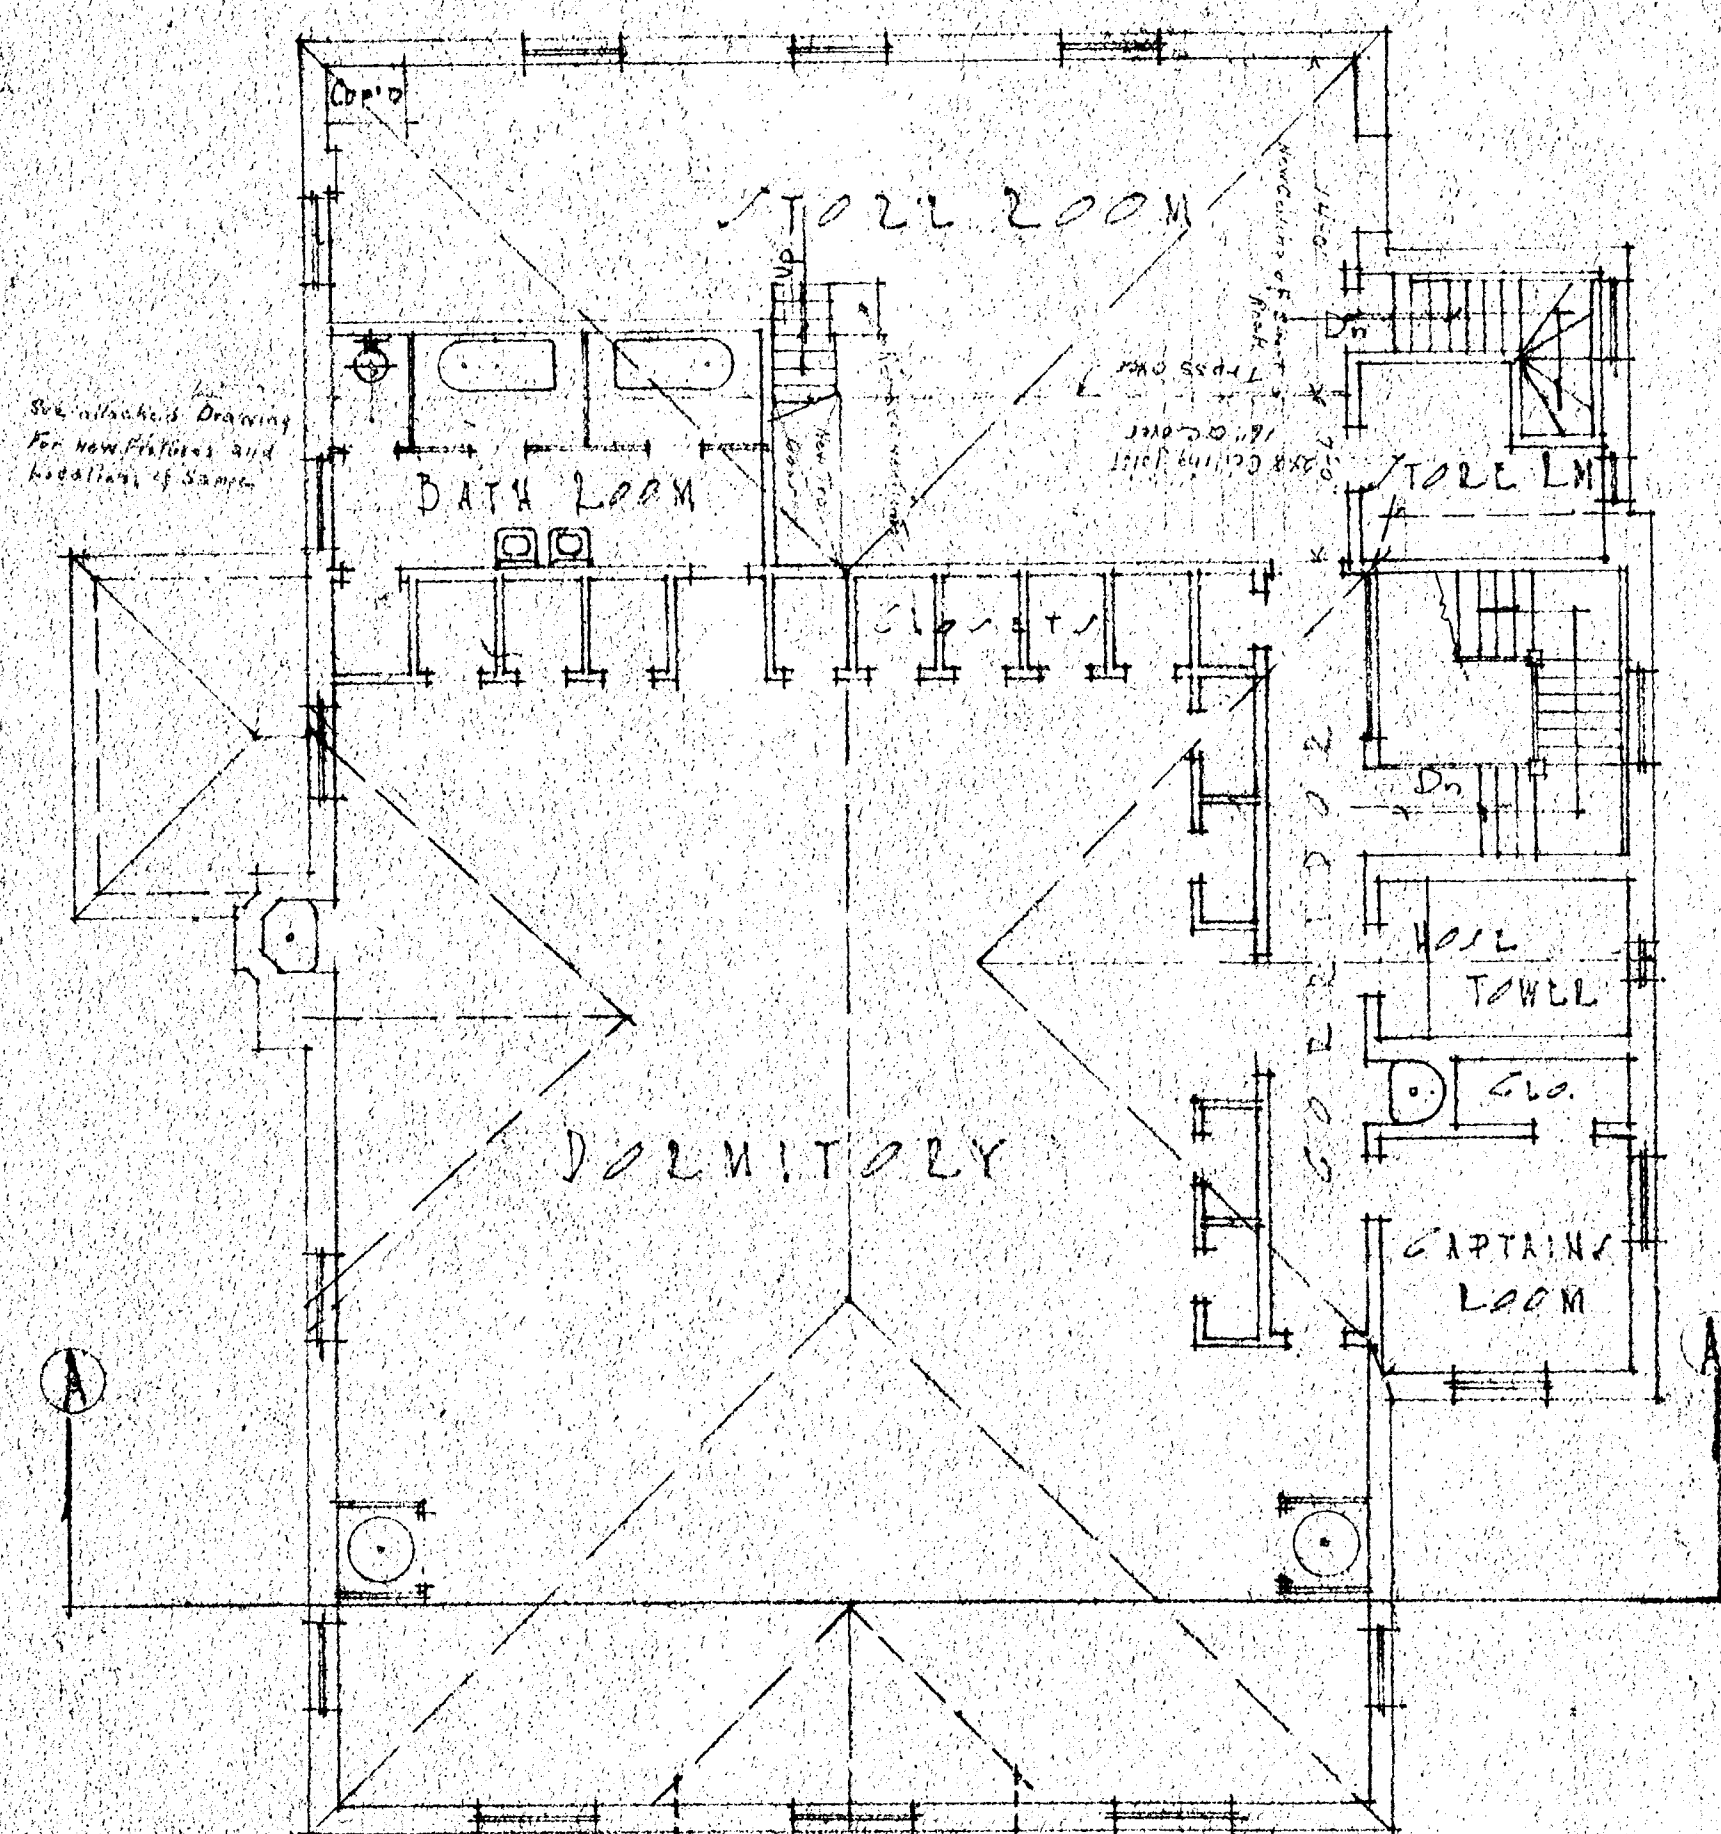

ITEM D-13

ENGINEER HOUSE NO. 143
28 BLUE HILLS AVENUE

Date 11/20/24 Scale 1/8" = 1'-0" Drawn by J.H.P.

Area of site 12,500 sq. ft. Total floor area 8,802 sq. ft.
Area of bldg. at ground level 4,982 sq. ft.
Percentage of site occupied by bldg. 39.8%
Curb line at bldg. 177.305 sq. ft.