


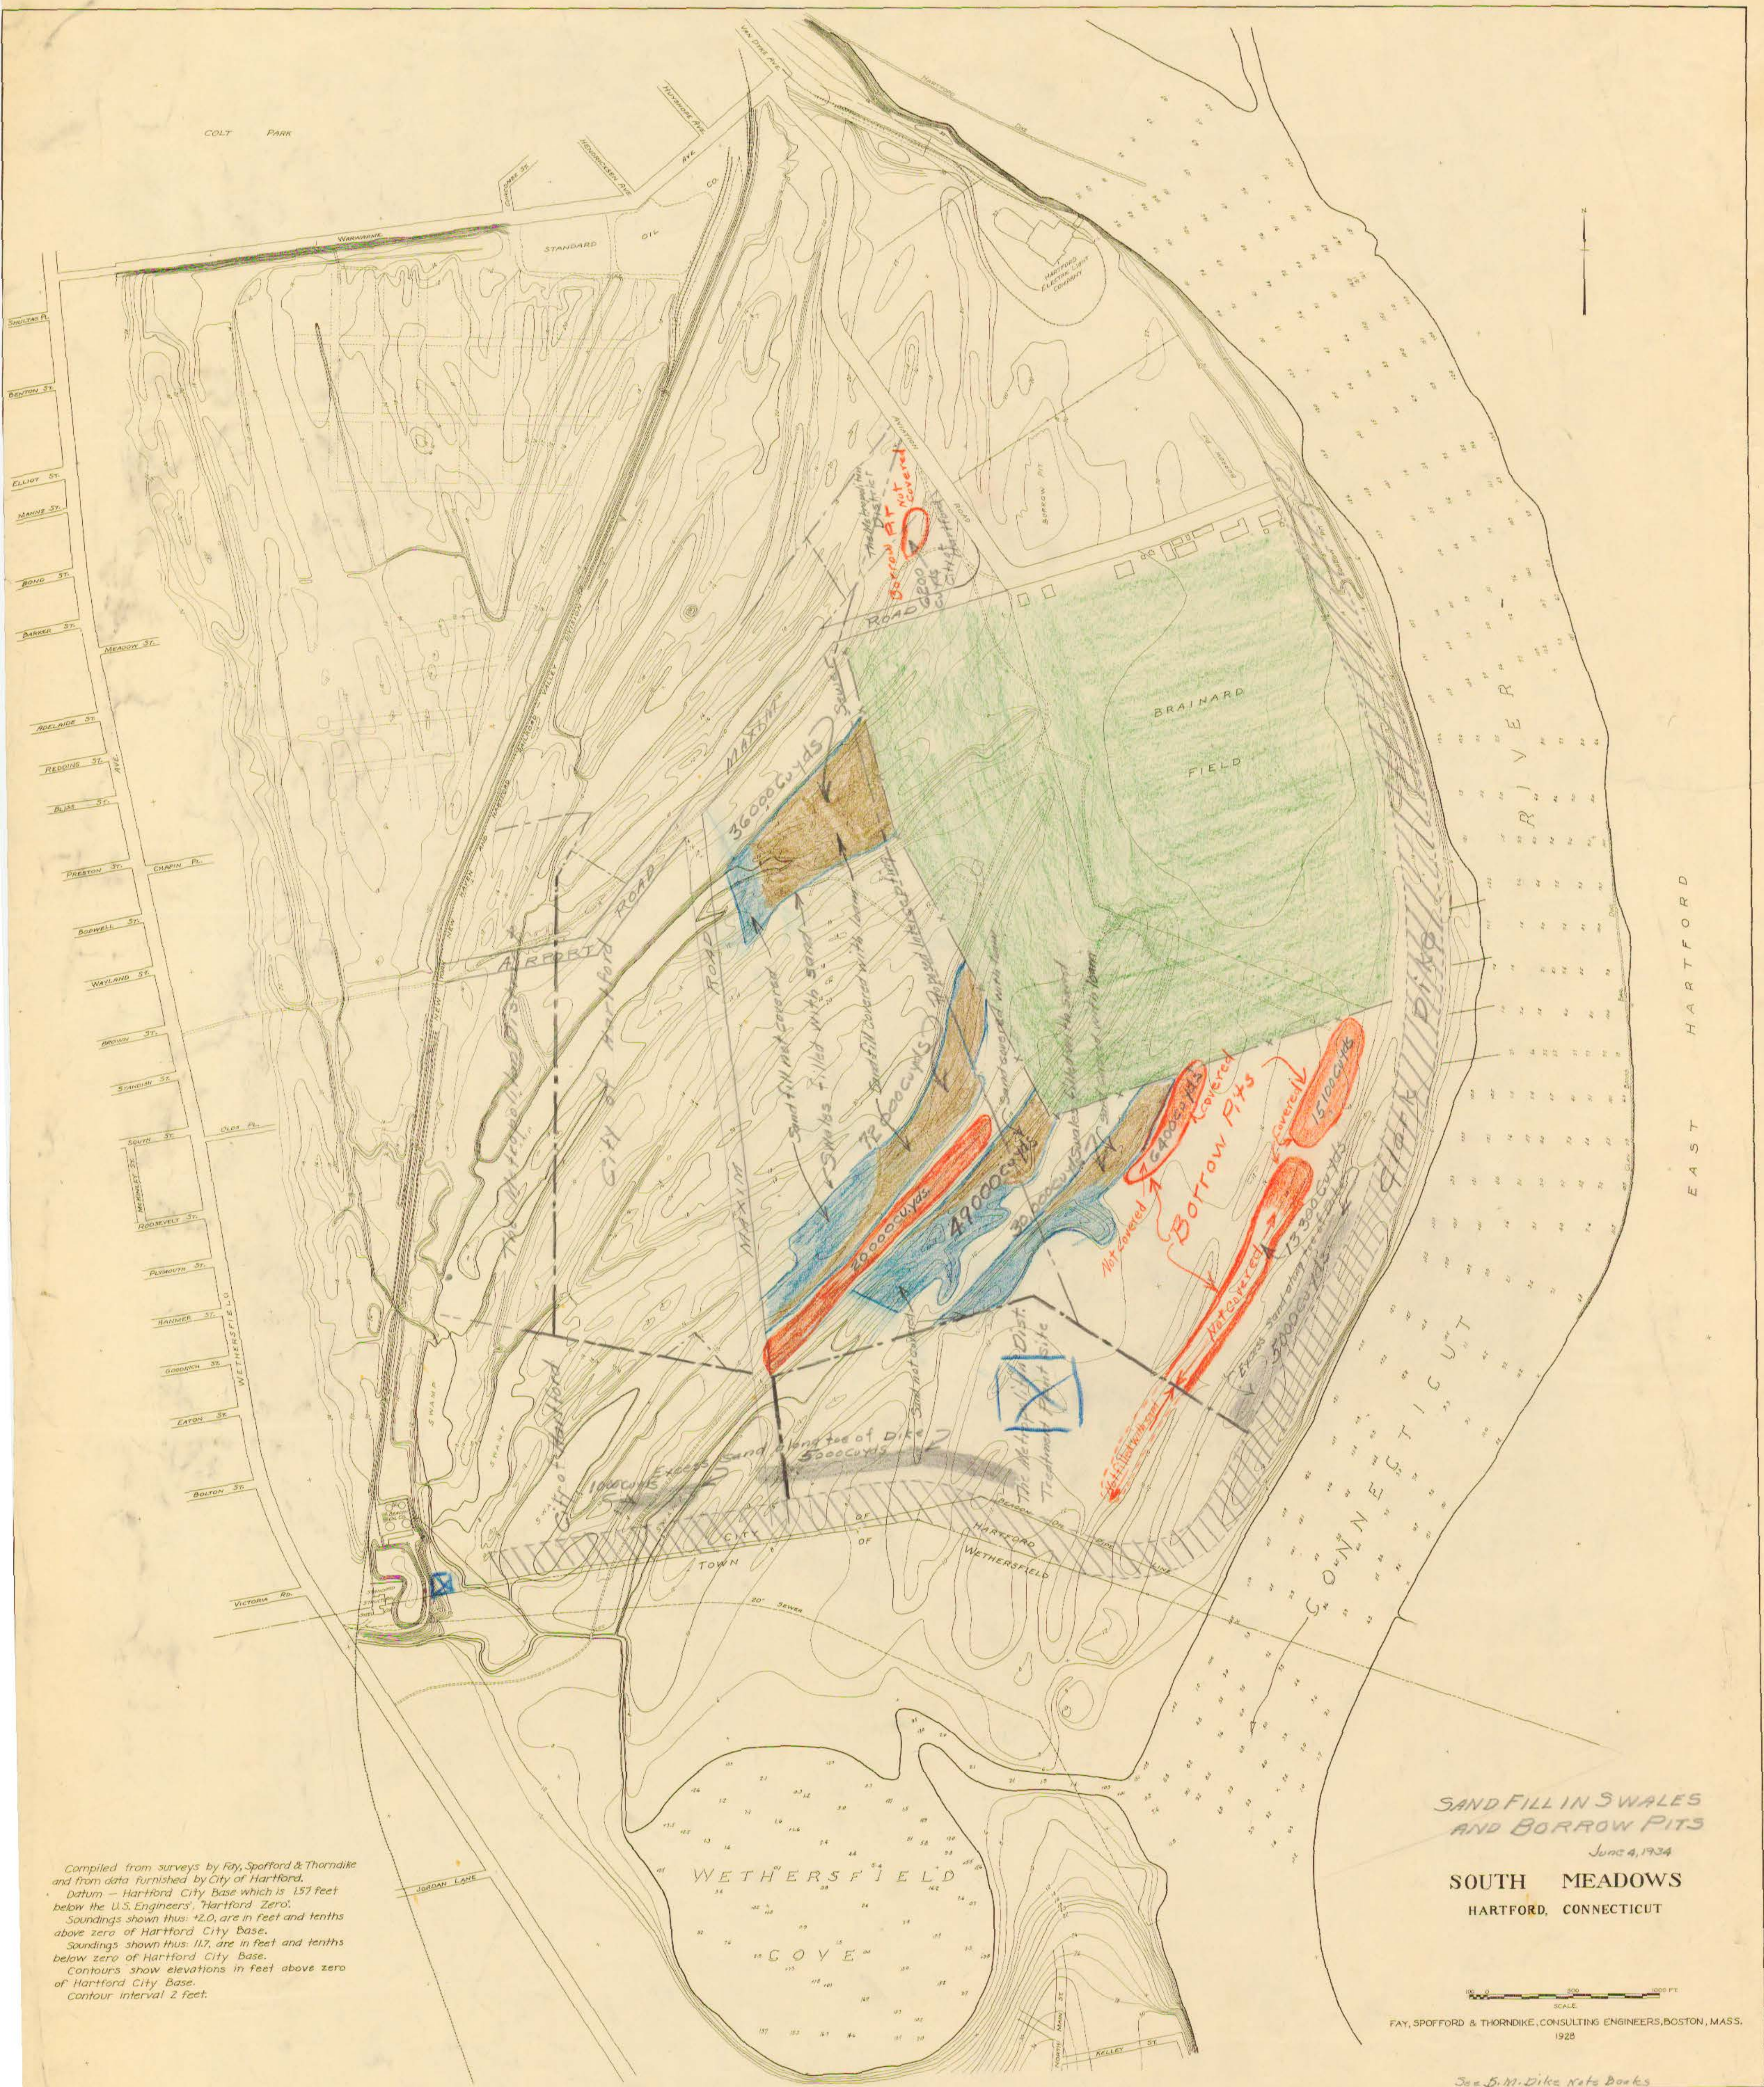

Compiled from surveys by Fay, Spofford & Thorndike and from data furnished by City of Hartford.
Datum - Hartford City Base which is 157 feet below the U.S. Engineers' Hartford Zero.
Soundings shown thus: +2.0, are in feet and tenths above zero of Hartford City Base.
Soundings shown thus: 11.7, are in feet and tenths below zero of Hartford City Base.
Contours show elevations in feet above zero of Hartford City Base.
Contour interval 2 feet.

SAND FILL IN SWALES
AND BORROW PITS
June 4, 1934
SOUTH MEADOWS
HARTFORD, CONNECTICUT

100 0 200 400 600 800 1000 FT
SCALE
FAY, SPOFFORD & THORNDIKE, CONSULTING ENGINEERS, BOSTON, MASS.
1928

See S.M. Dike Note Books