


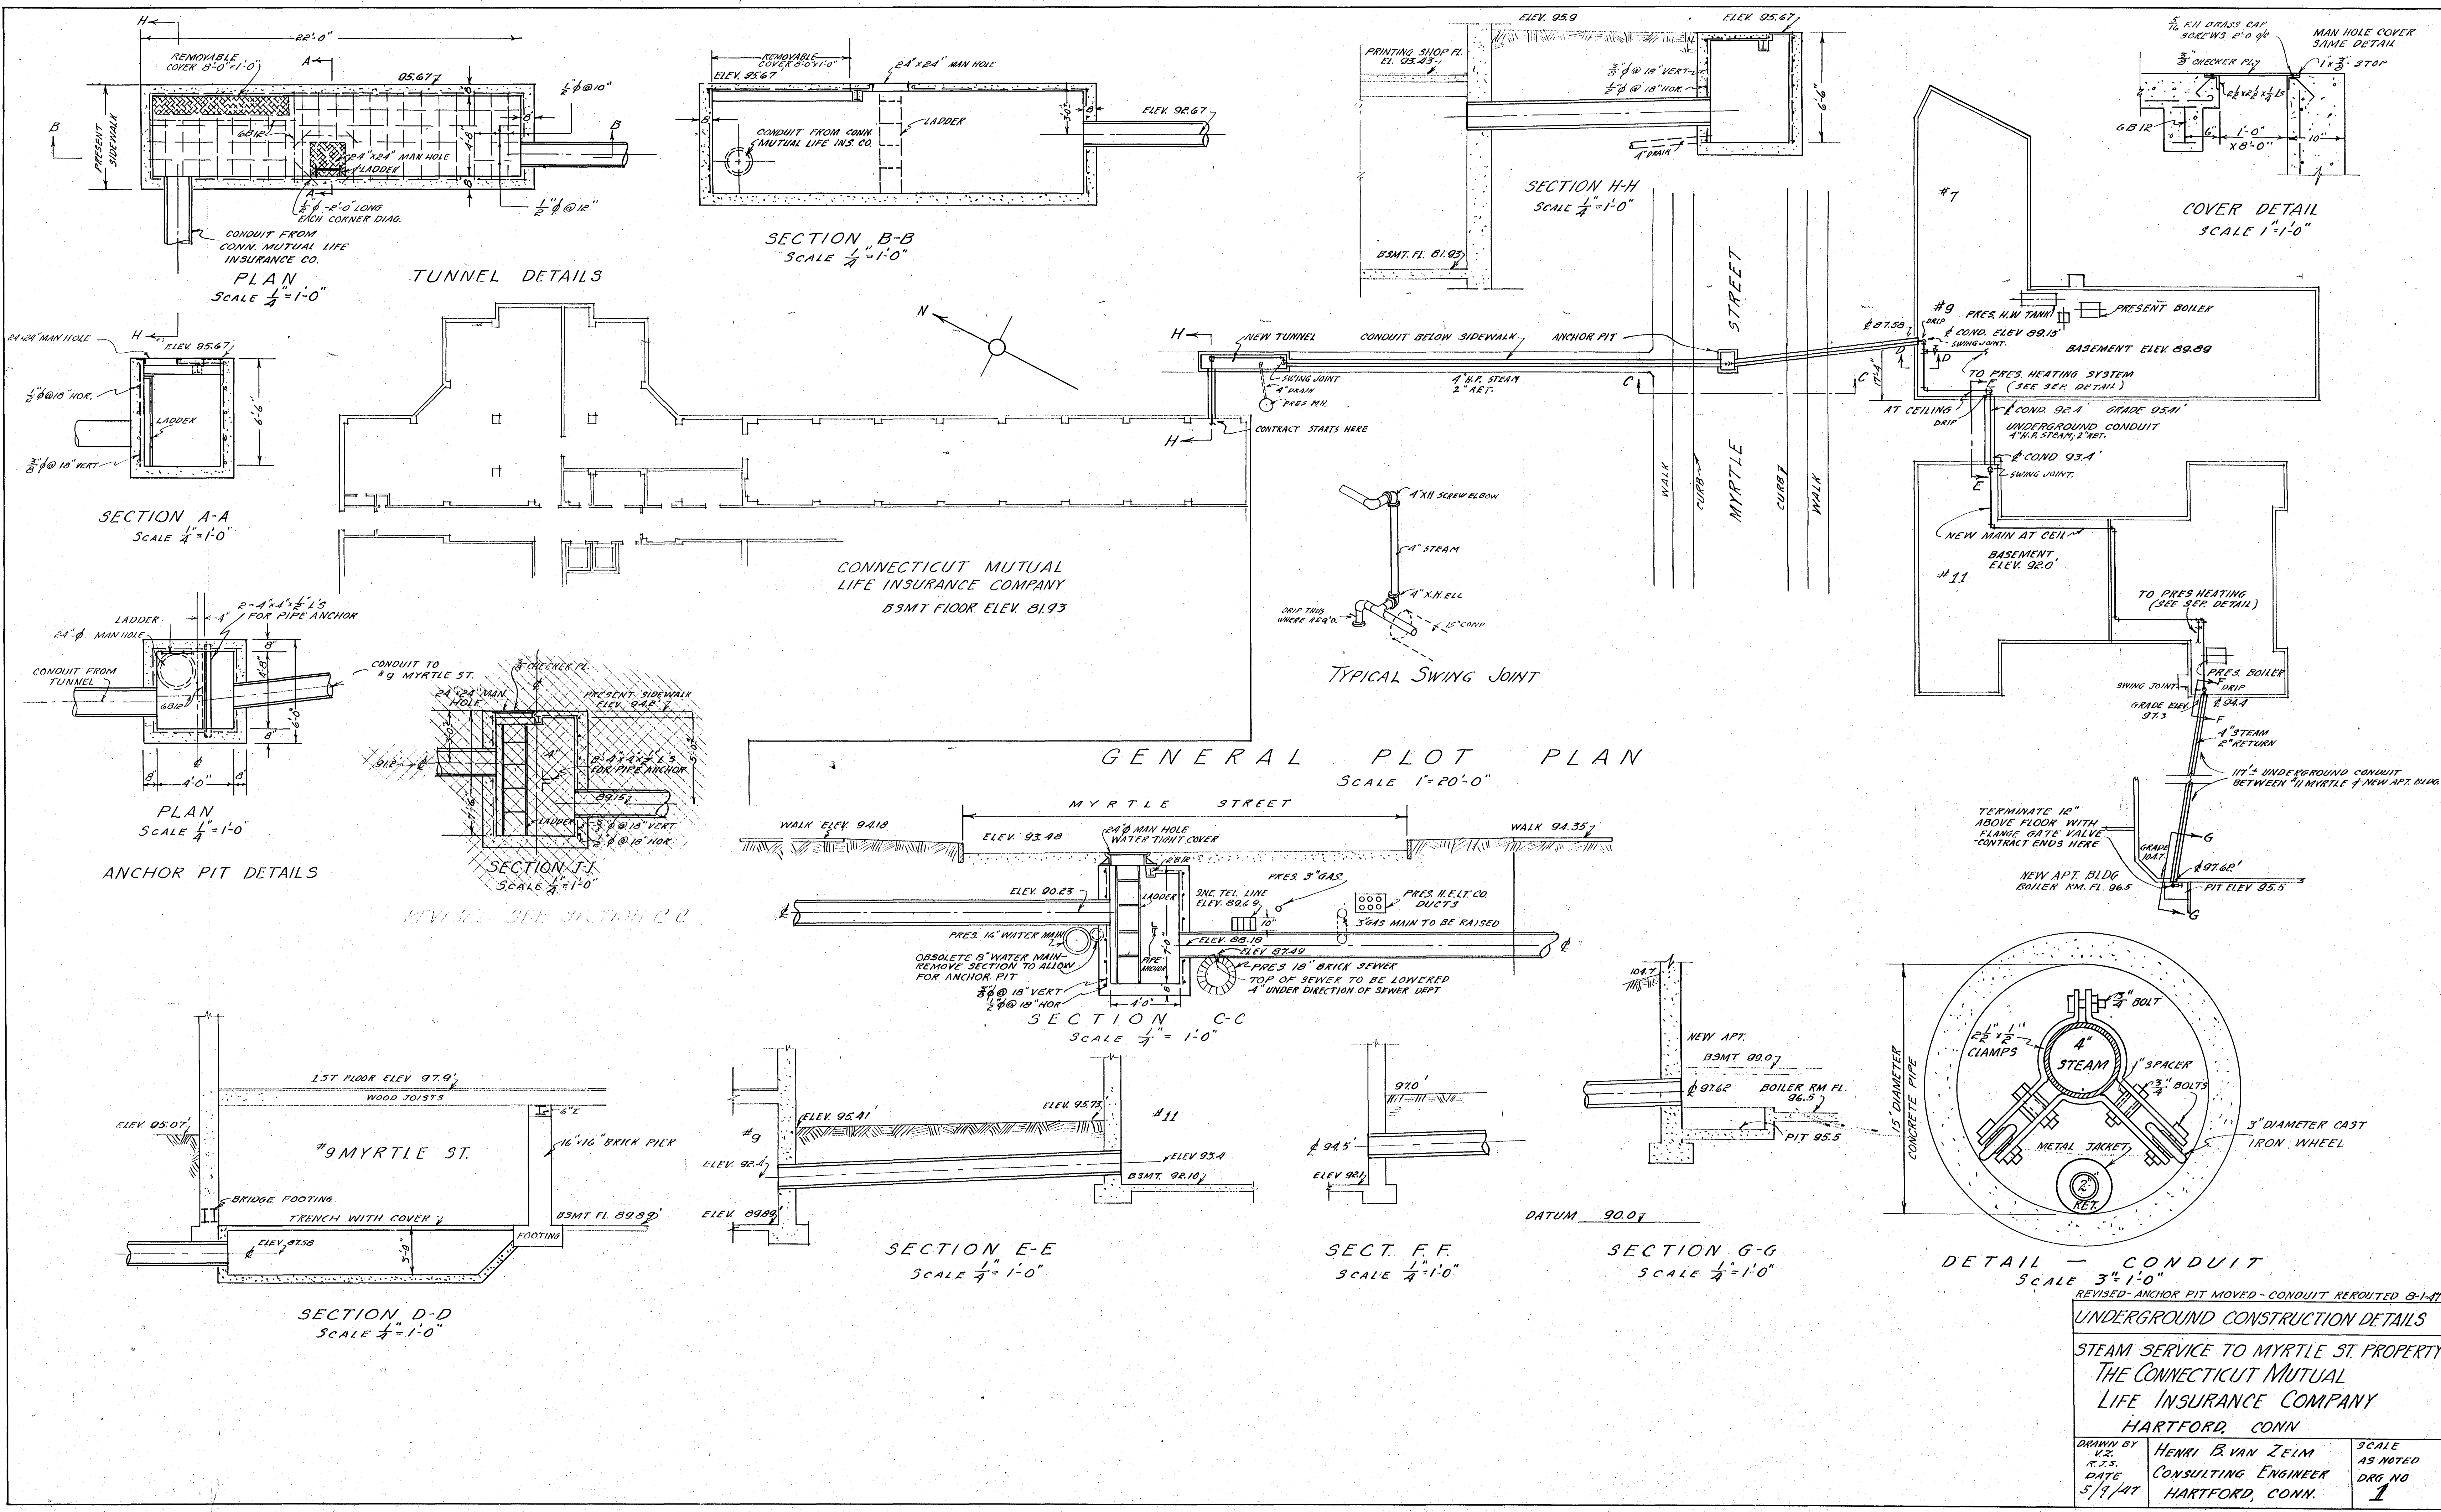

REVISD-ANCHOR PIT MOVED-CONDUIT REROUTED 8-1-47

UNDERGROUND CONSTRUCTION DETAILS

STEAM SERVICE TO MYRTLE ST PROPERTY
THE CONNECTICUT MUTUAL
LIFE INSURANCE COMPANY
HARTFORD, CONN.

DRAWN BY V.Z. R.J.S. DATE 5/9/47	HENRI B. VAN ZELM CONSULTING ENGINEER HARTFORD, CONN.	SCALE AS NOTED DRG. NO. 1
--	---	------------------------------------