




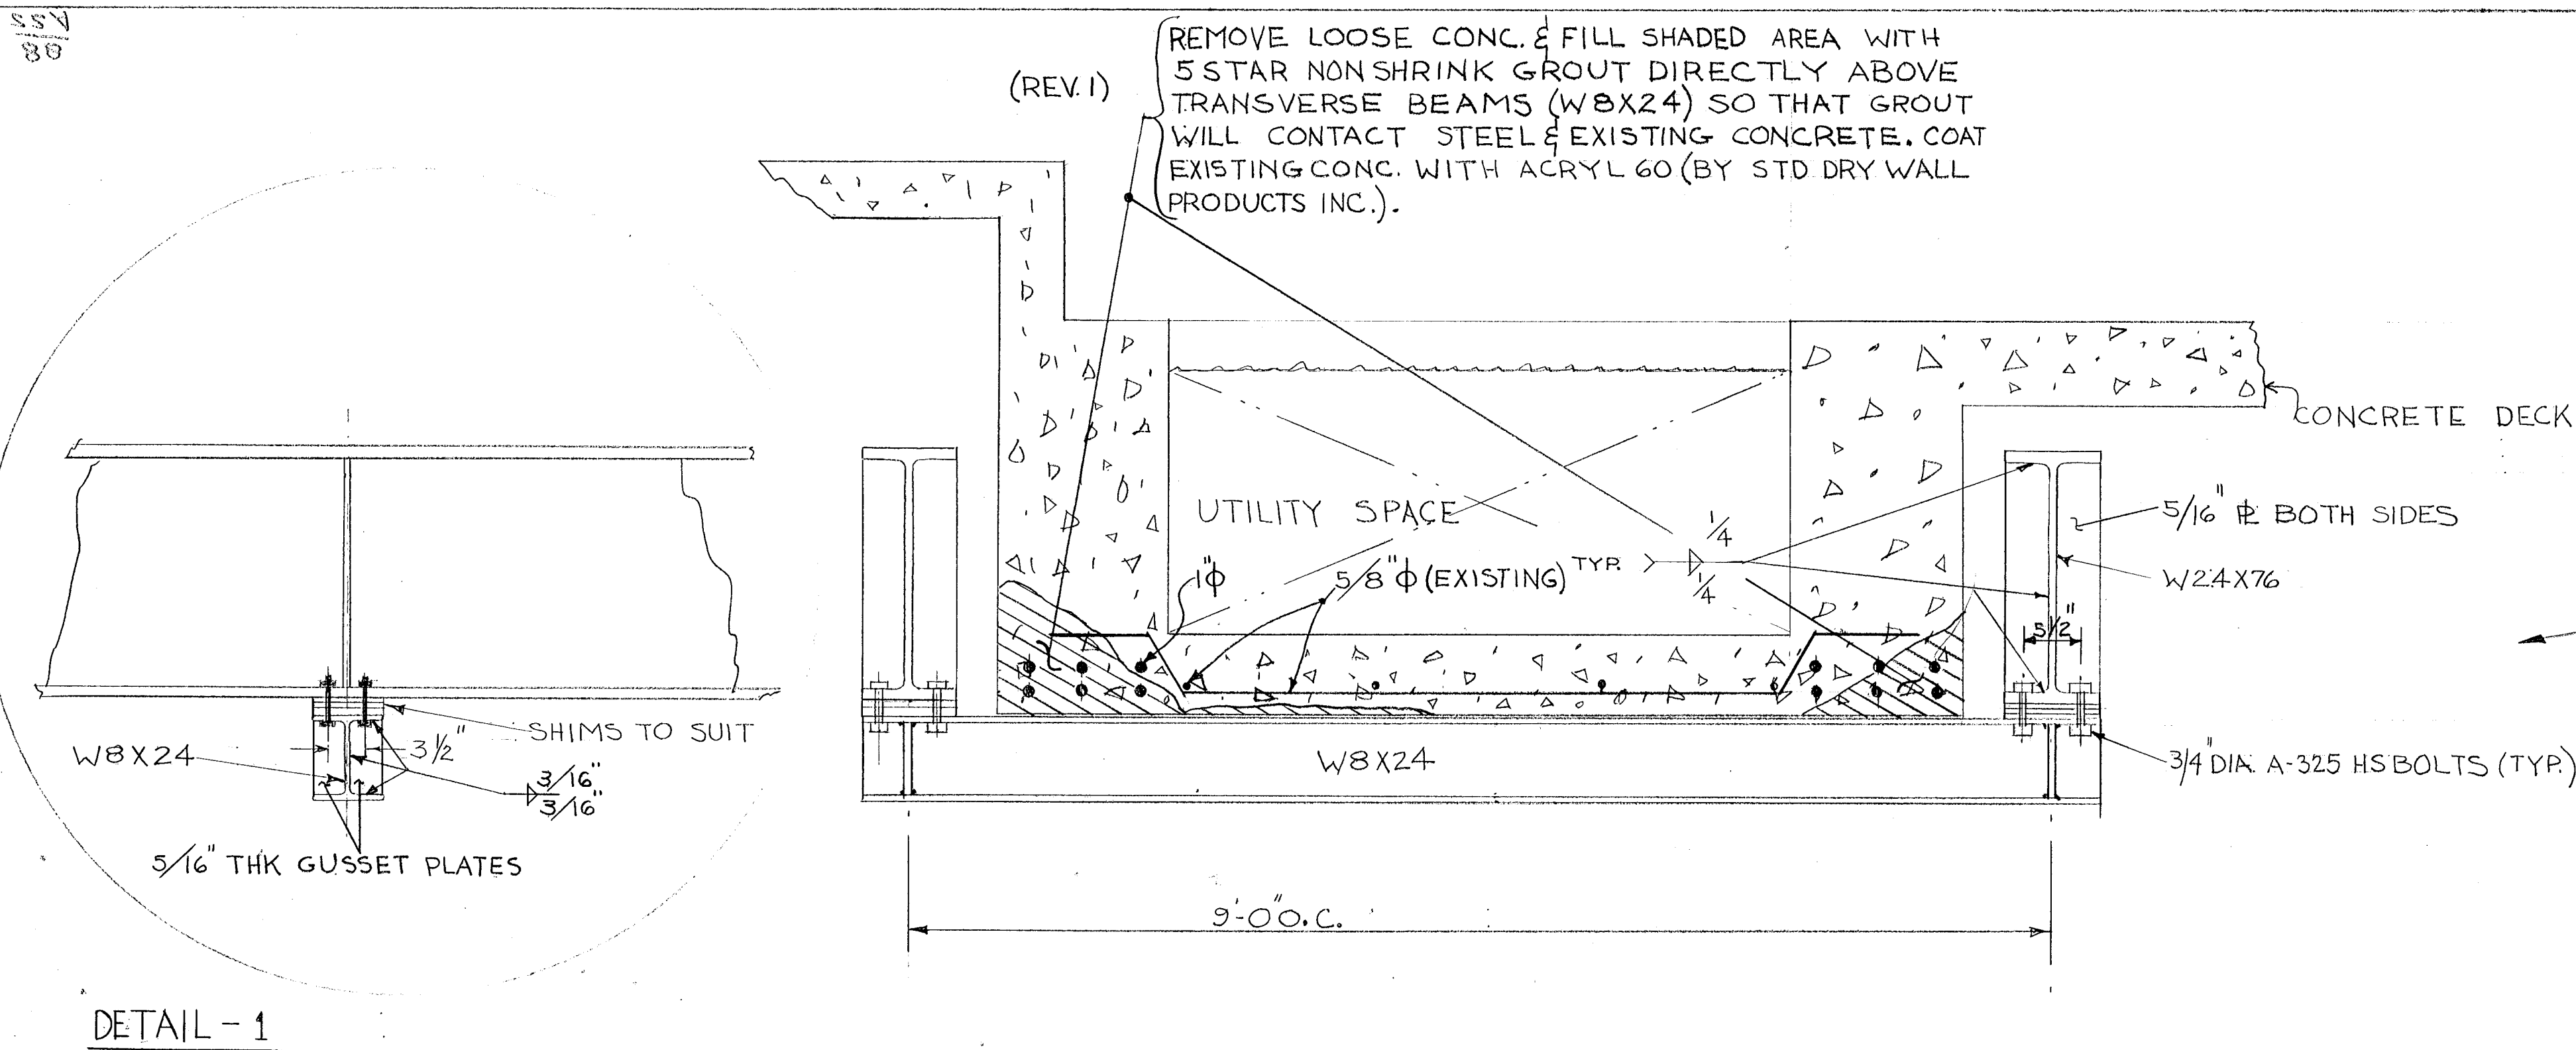

DETAIL - 1

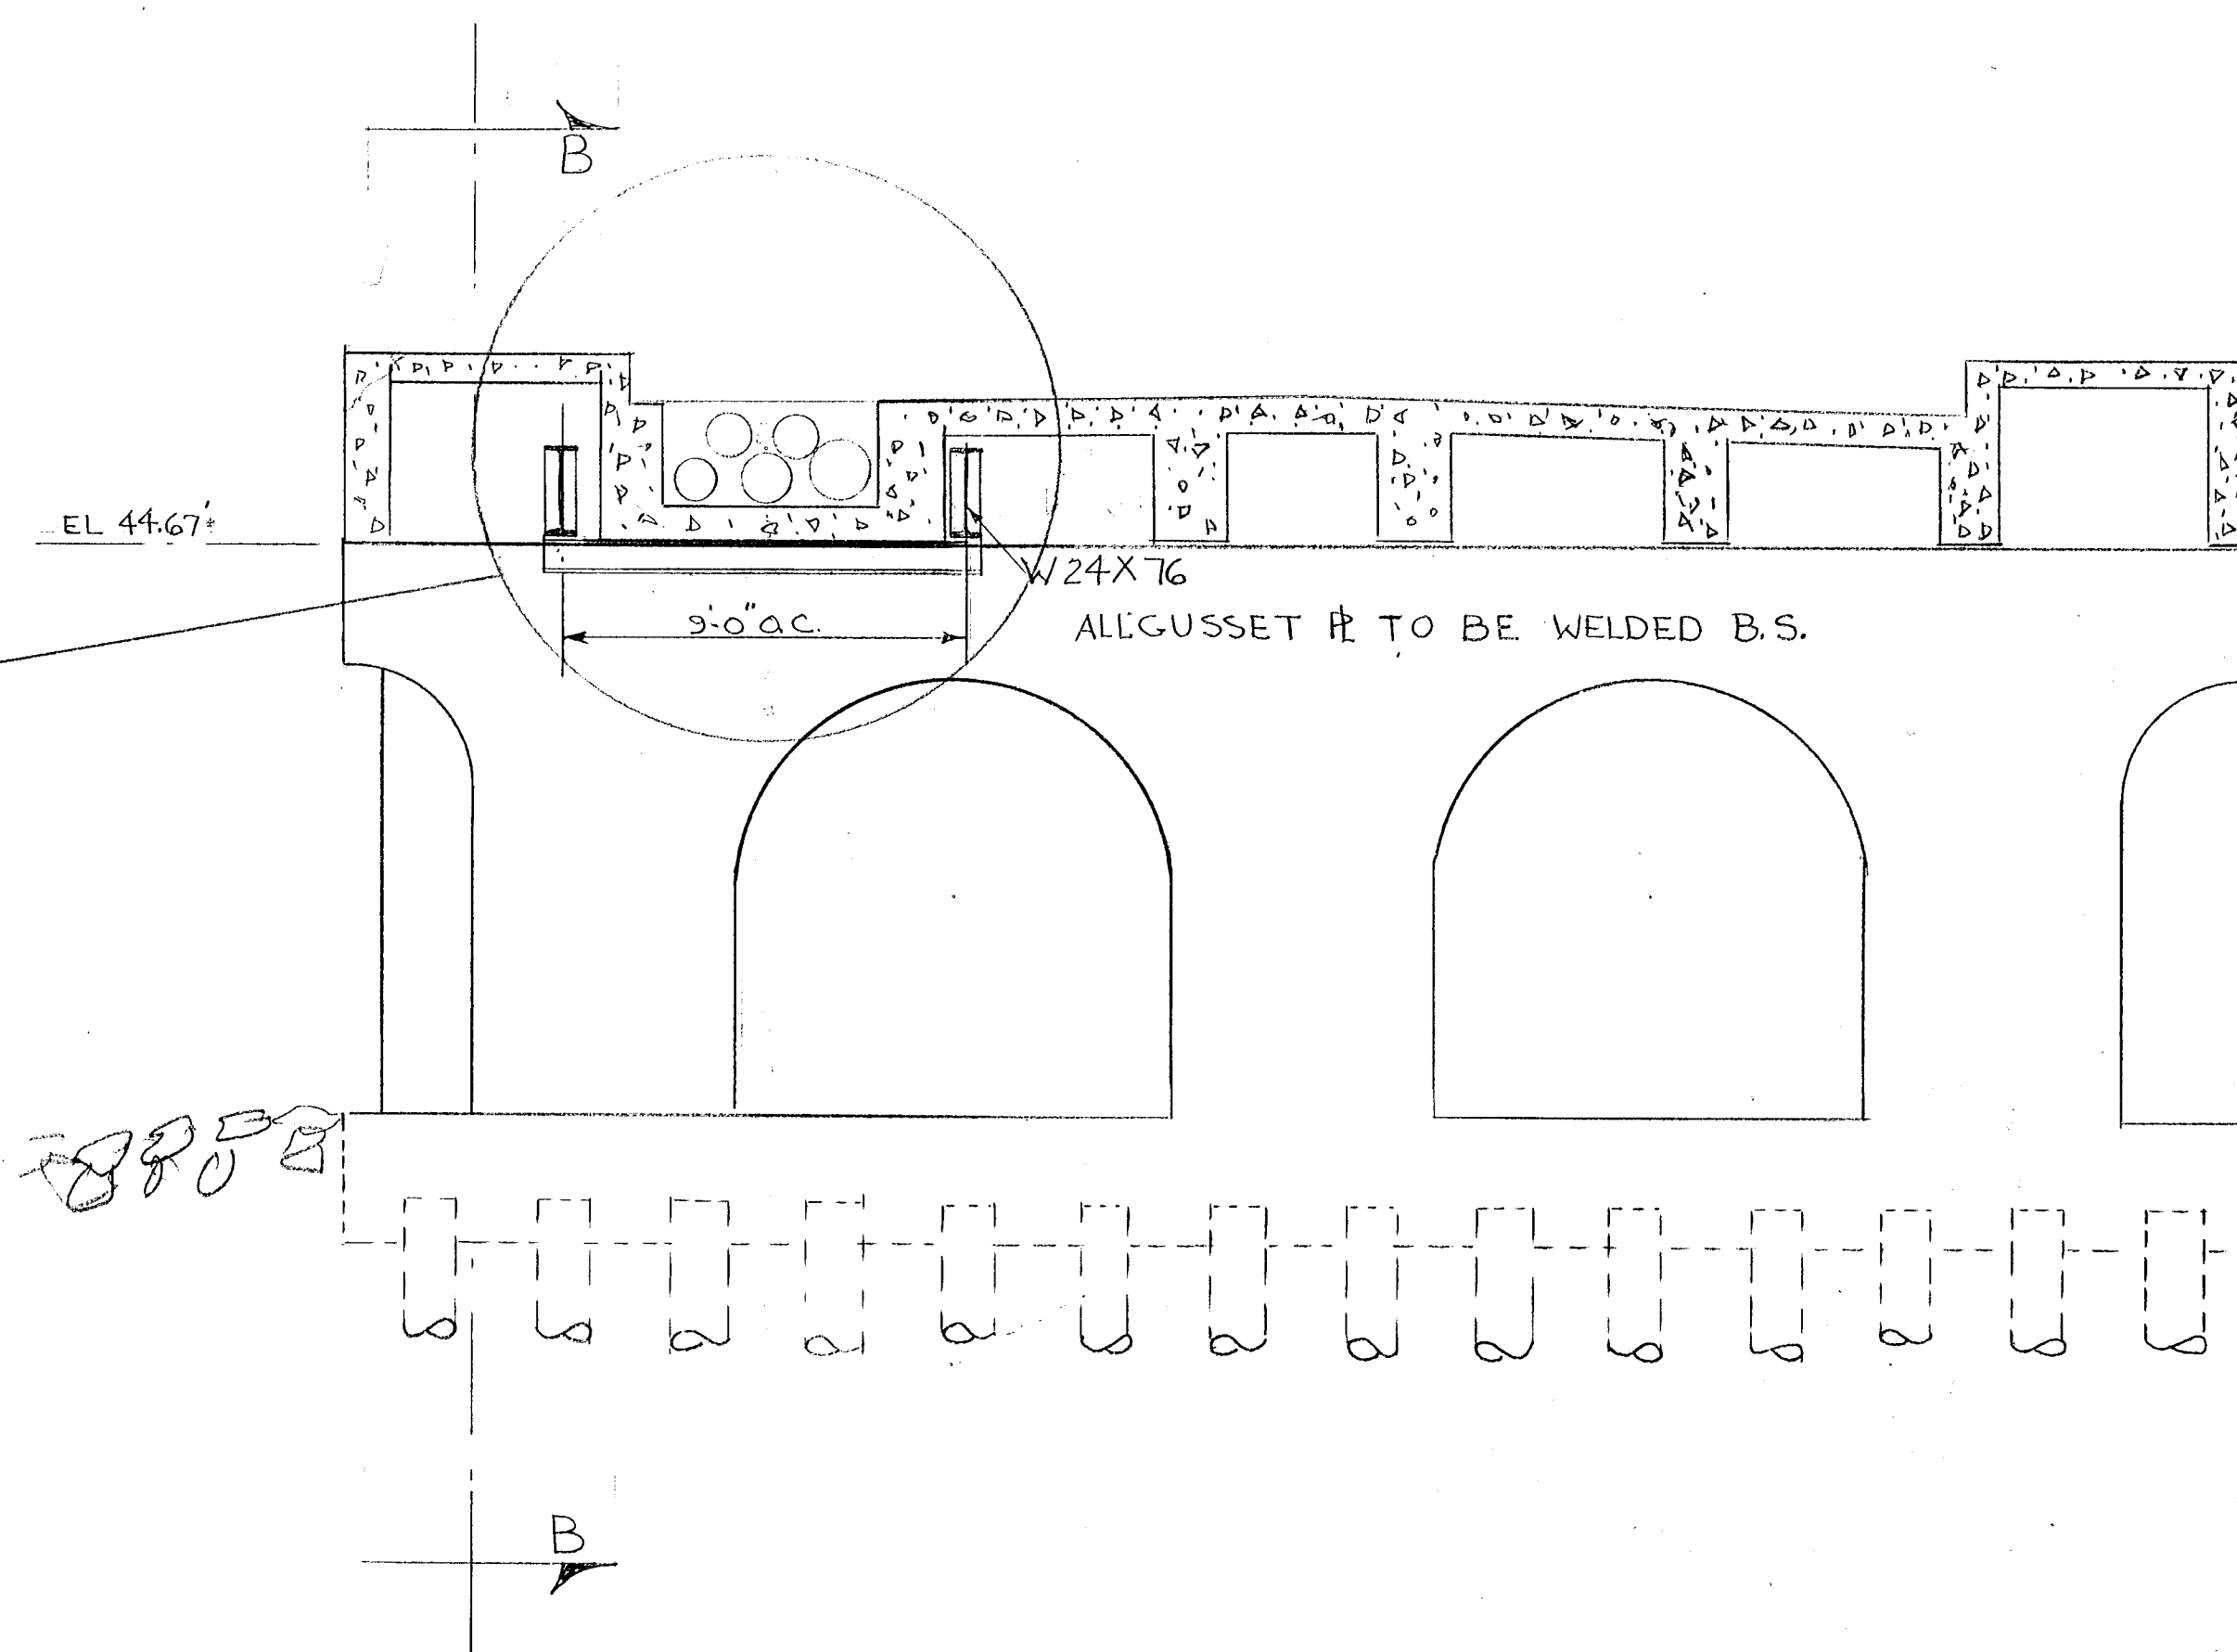

SECTION A-A LKG. NORTH

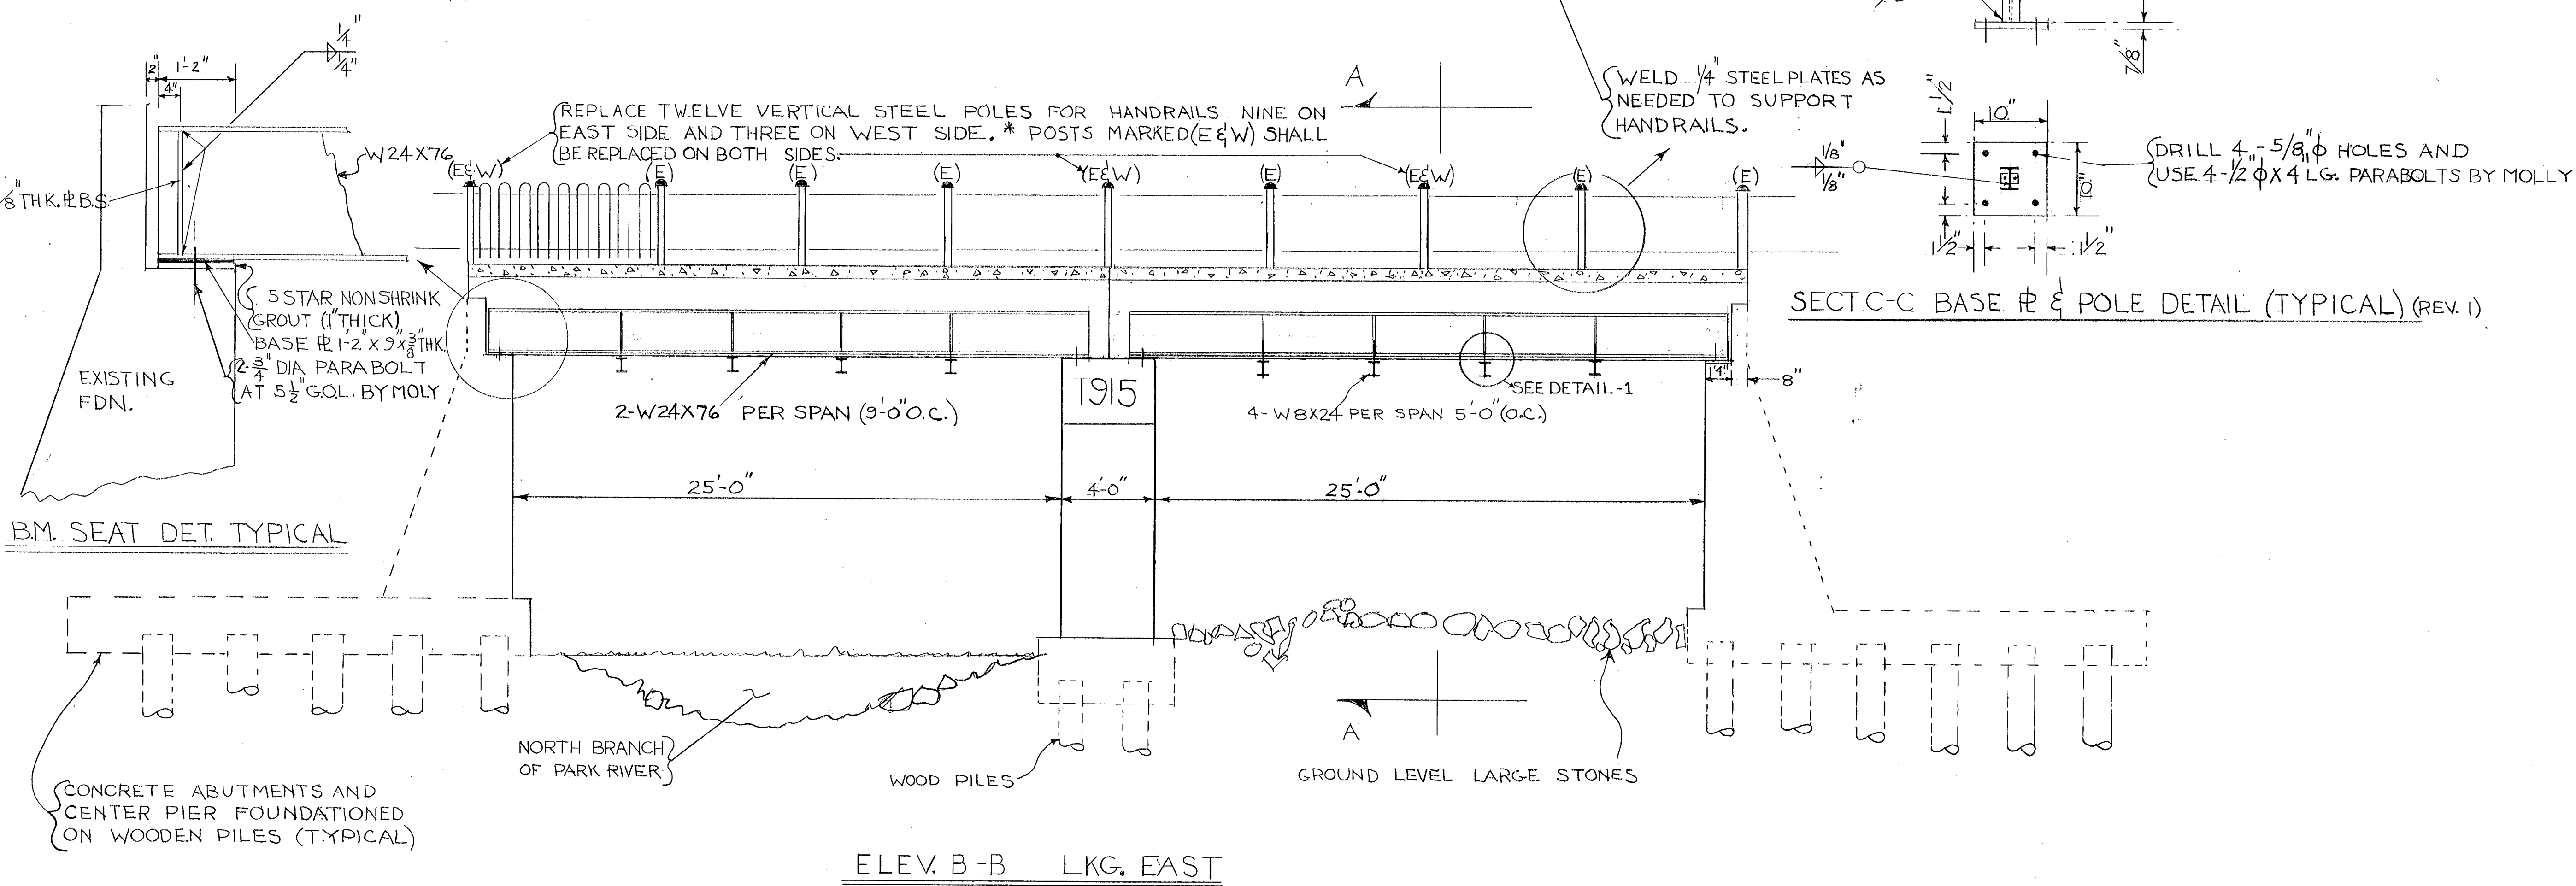

ELEV. B-B LKG. EAST

- GENERAL NOTES:
1. ALL STEEL TO BE ASTM A-36-69
 2. ALL WELDING TO CONFORM WITH A.W.S. SPEC. USE E-70 ELECTRODES.
 3. ALL BOLTS TO BE ASTM A-325 HS. BOLTS (3/4" DIA) TORQUED TO 325 FT.-LBS. MINIMUM.
 4. PAINT ALL STEEL ONE PRIME COAT WITH ZINC CHROMATIC PAINT. FINISH WITH 2 COATS OF RUST-OLEUM GREY FOR CRADLE BLACK FOR POSTS.
 5. REPAIR THE TOP OF THE OUTBOARD SIDEWALK BEAM ON THE EAST SIDE IN THE NORTH SPAN. REMOVE LOOSE CONCRETE AND FILL TO SIDEWALK LEVEL WITH 3000 PSI. CONC. FOR THE WIDTH OF THE BEAM. AT $\frac{1}{4}$ OF STRUCTURE ON THE WEST SIDE FILL IN FISSURE WITH CONC. & INSTALL EXP. MATERIAL 1/2" THK. (ASPHALT IMPREGNATED) AT $\frac{1}{4}$ COAT EXISTING CONC. WITH ACRYL 60 AS MANF BY (STD. DRY WALL)

REVISION #1 12-12-75 R.D.A.

1. ADDED NOTE #5 IN GEN. NOTES.
2. ADDED NOTE & SHADED AREA TO DETAIL OF SECT. A-A
3. ADDED BASE & POLE DETAIL

CITY OF HARTFORD, CONNECTICUT DEPARTMENT OF PUBLIC WORKS BUREAU OF PUBLIC BUILDINGS			
REPAIR TO NEWFIELD AVE BRIDGE. STEEL CRADLE, HANDRAIL POSTS & CONC. WORK.			DWG. NO. 1
SUBMITTED Paul Anthony	RECOMMENDED William H. Ruse	APPROVED James J. Ruse	DATE 10-24-75
SCALE N.T.S.	DAYBOOK NO. 010544		

VERIFY EXISTING
CONDITIONS AND
DIMENSIONS AT
BUILDING