

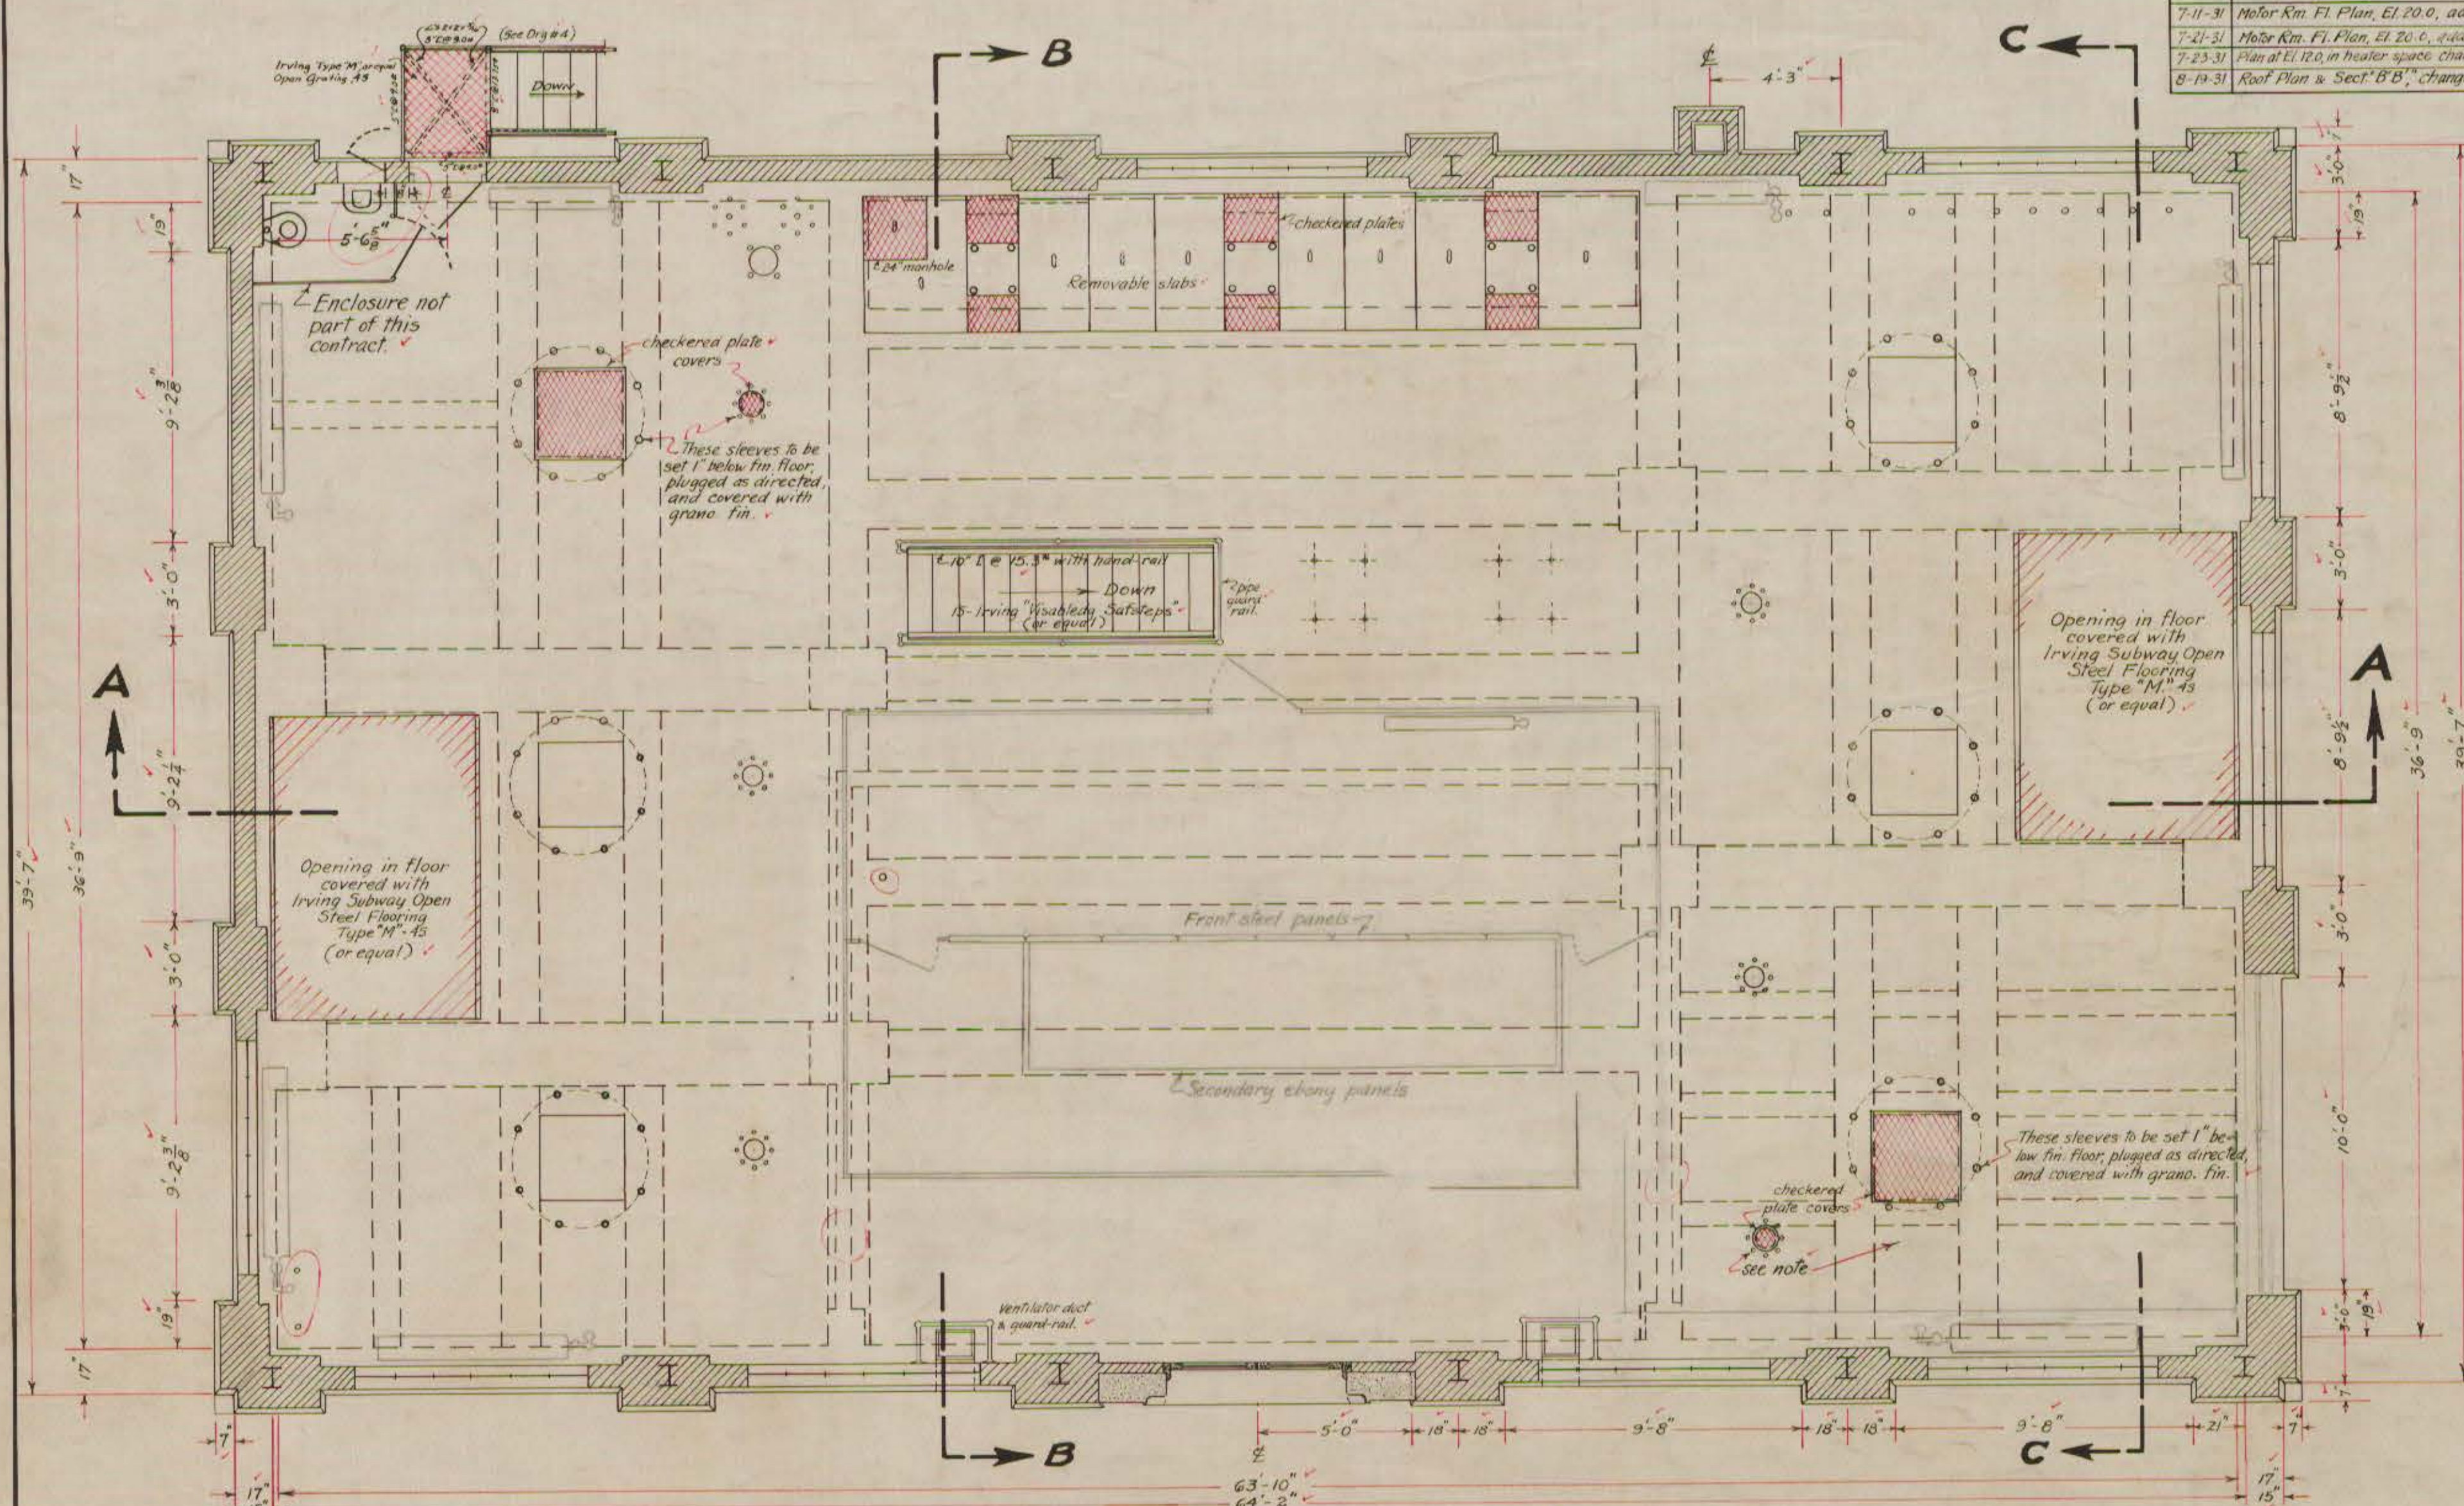


[illegible]


MOTOR ROOM FLOOR PLAN EL. 20.0  
Scale:  $\frac{1}{4}'' = 1'-0''$

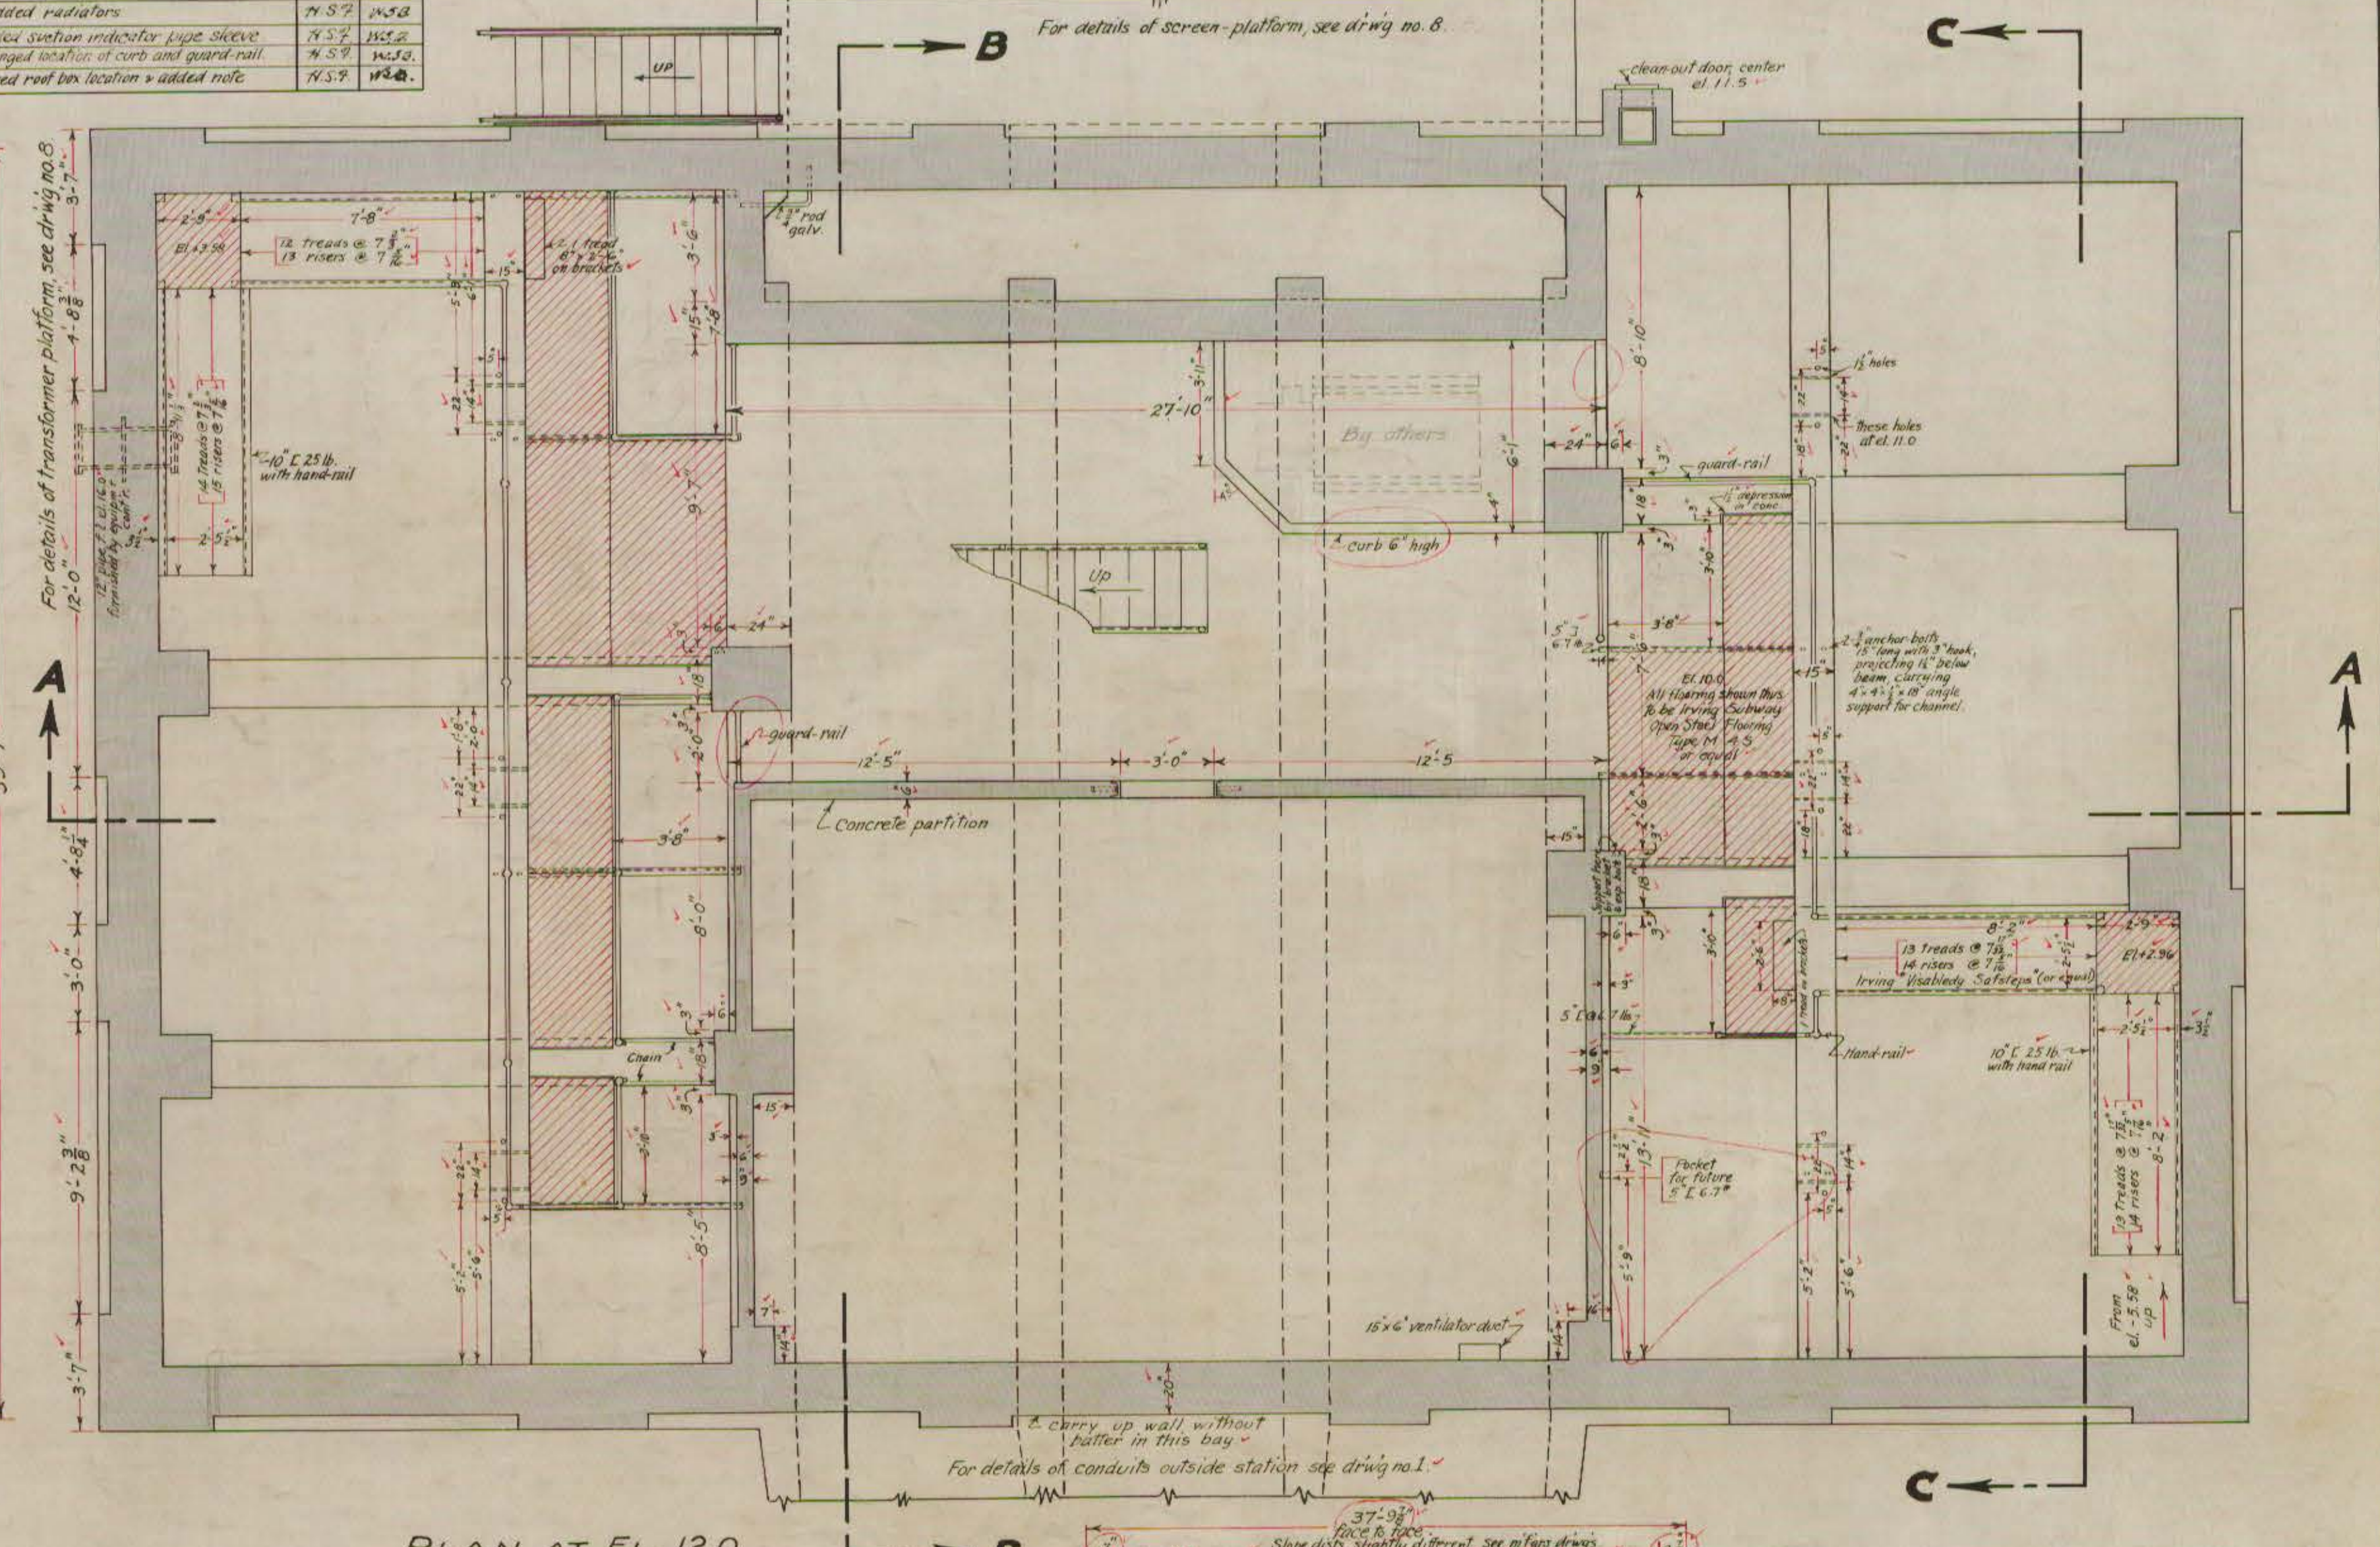


PLAN AT EL. 12.0  
Scale:  $\frac{1}{4}'' = 1'-0''$

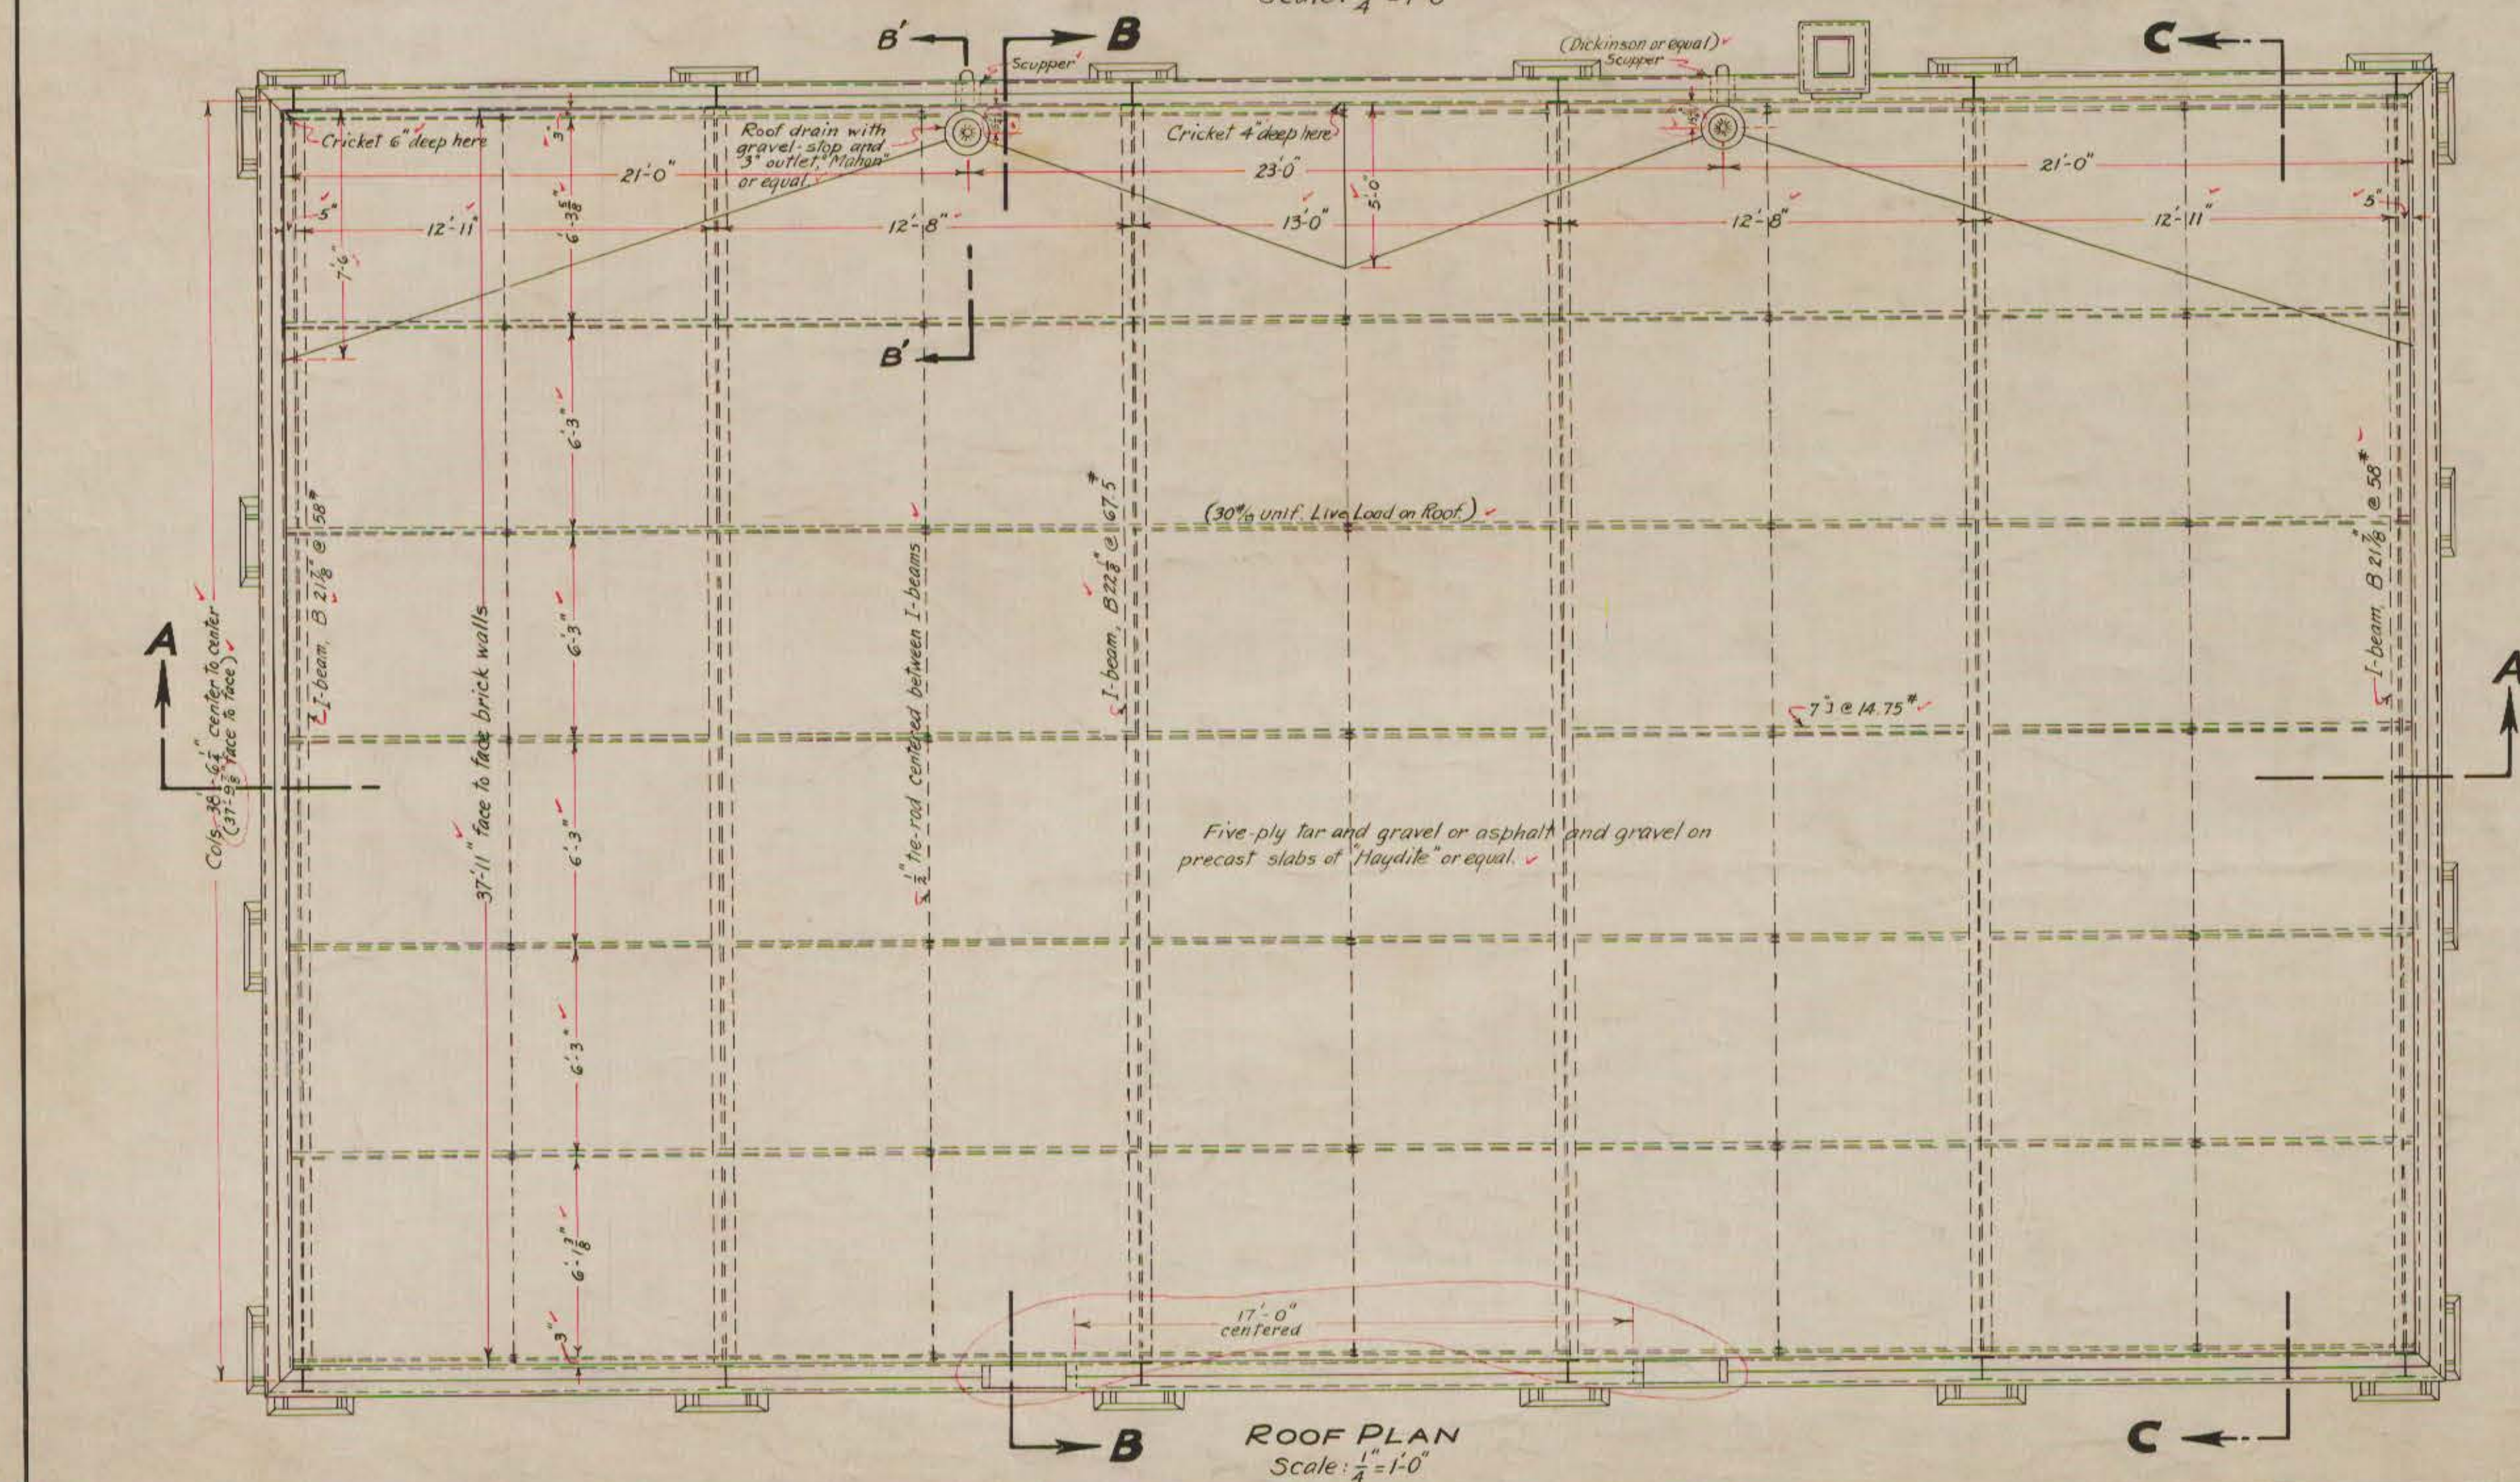

ROOF PLAN  
Scale:  $\frac{1}{4}'' = 1'-0''$

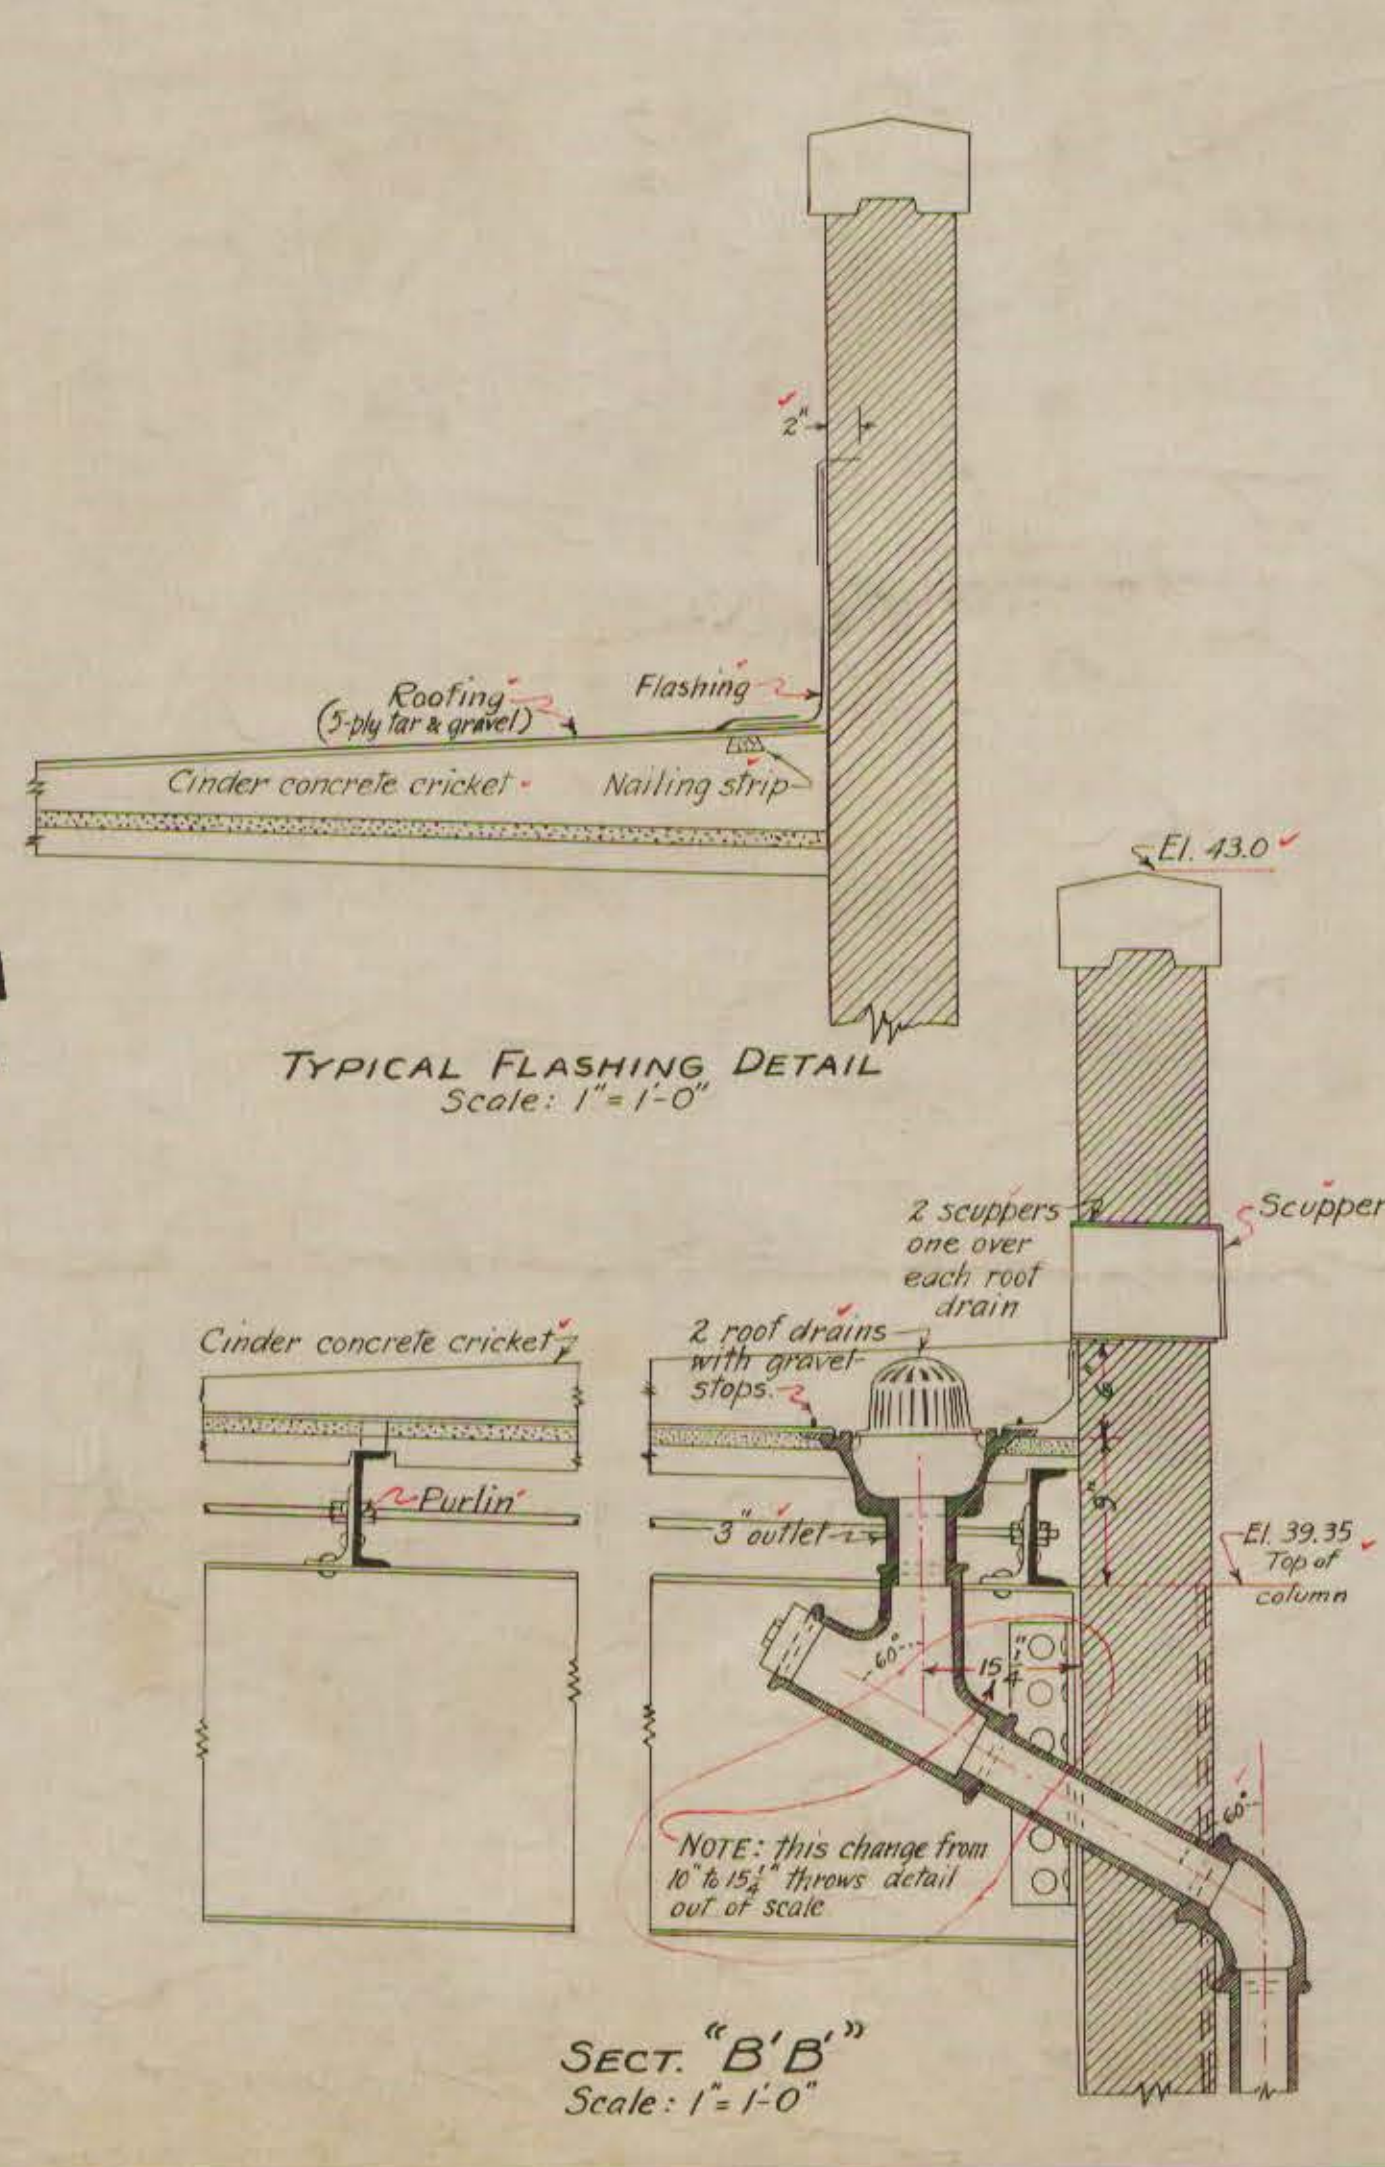

SECT. "B'B'"  
Scale: 1" = 1'-0"

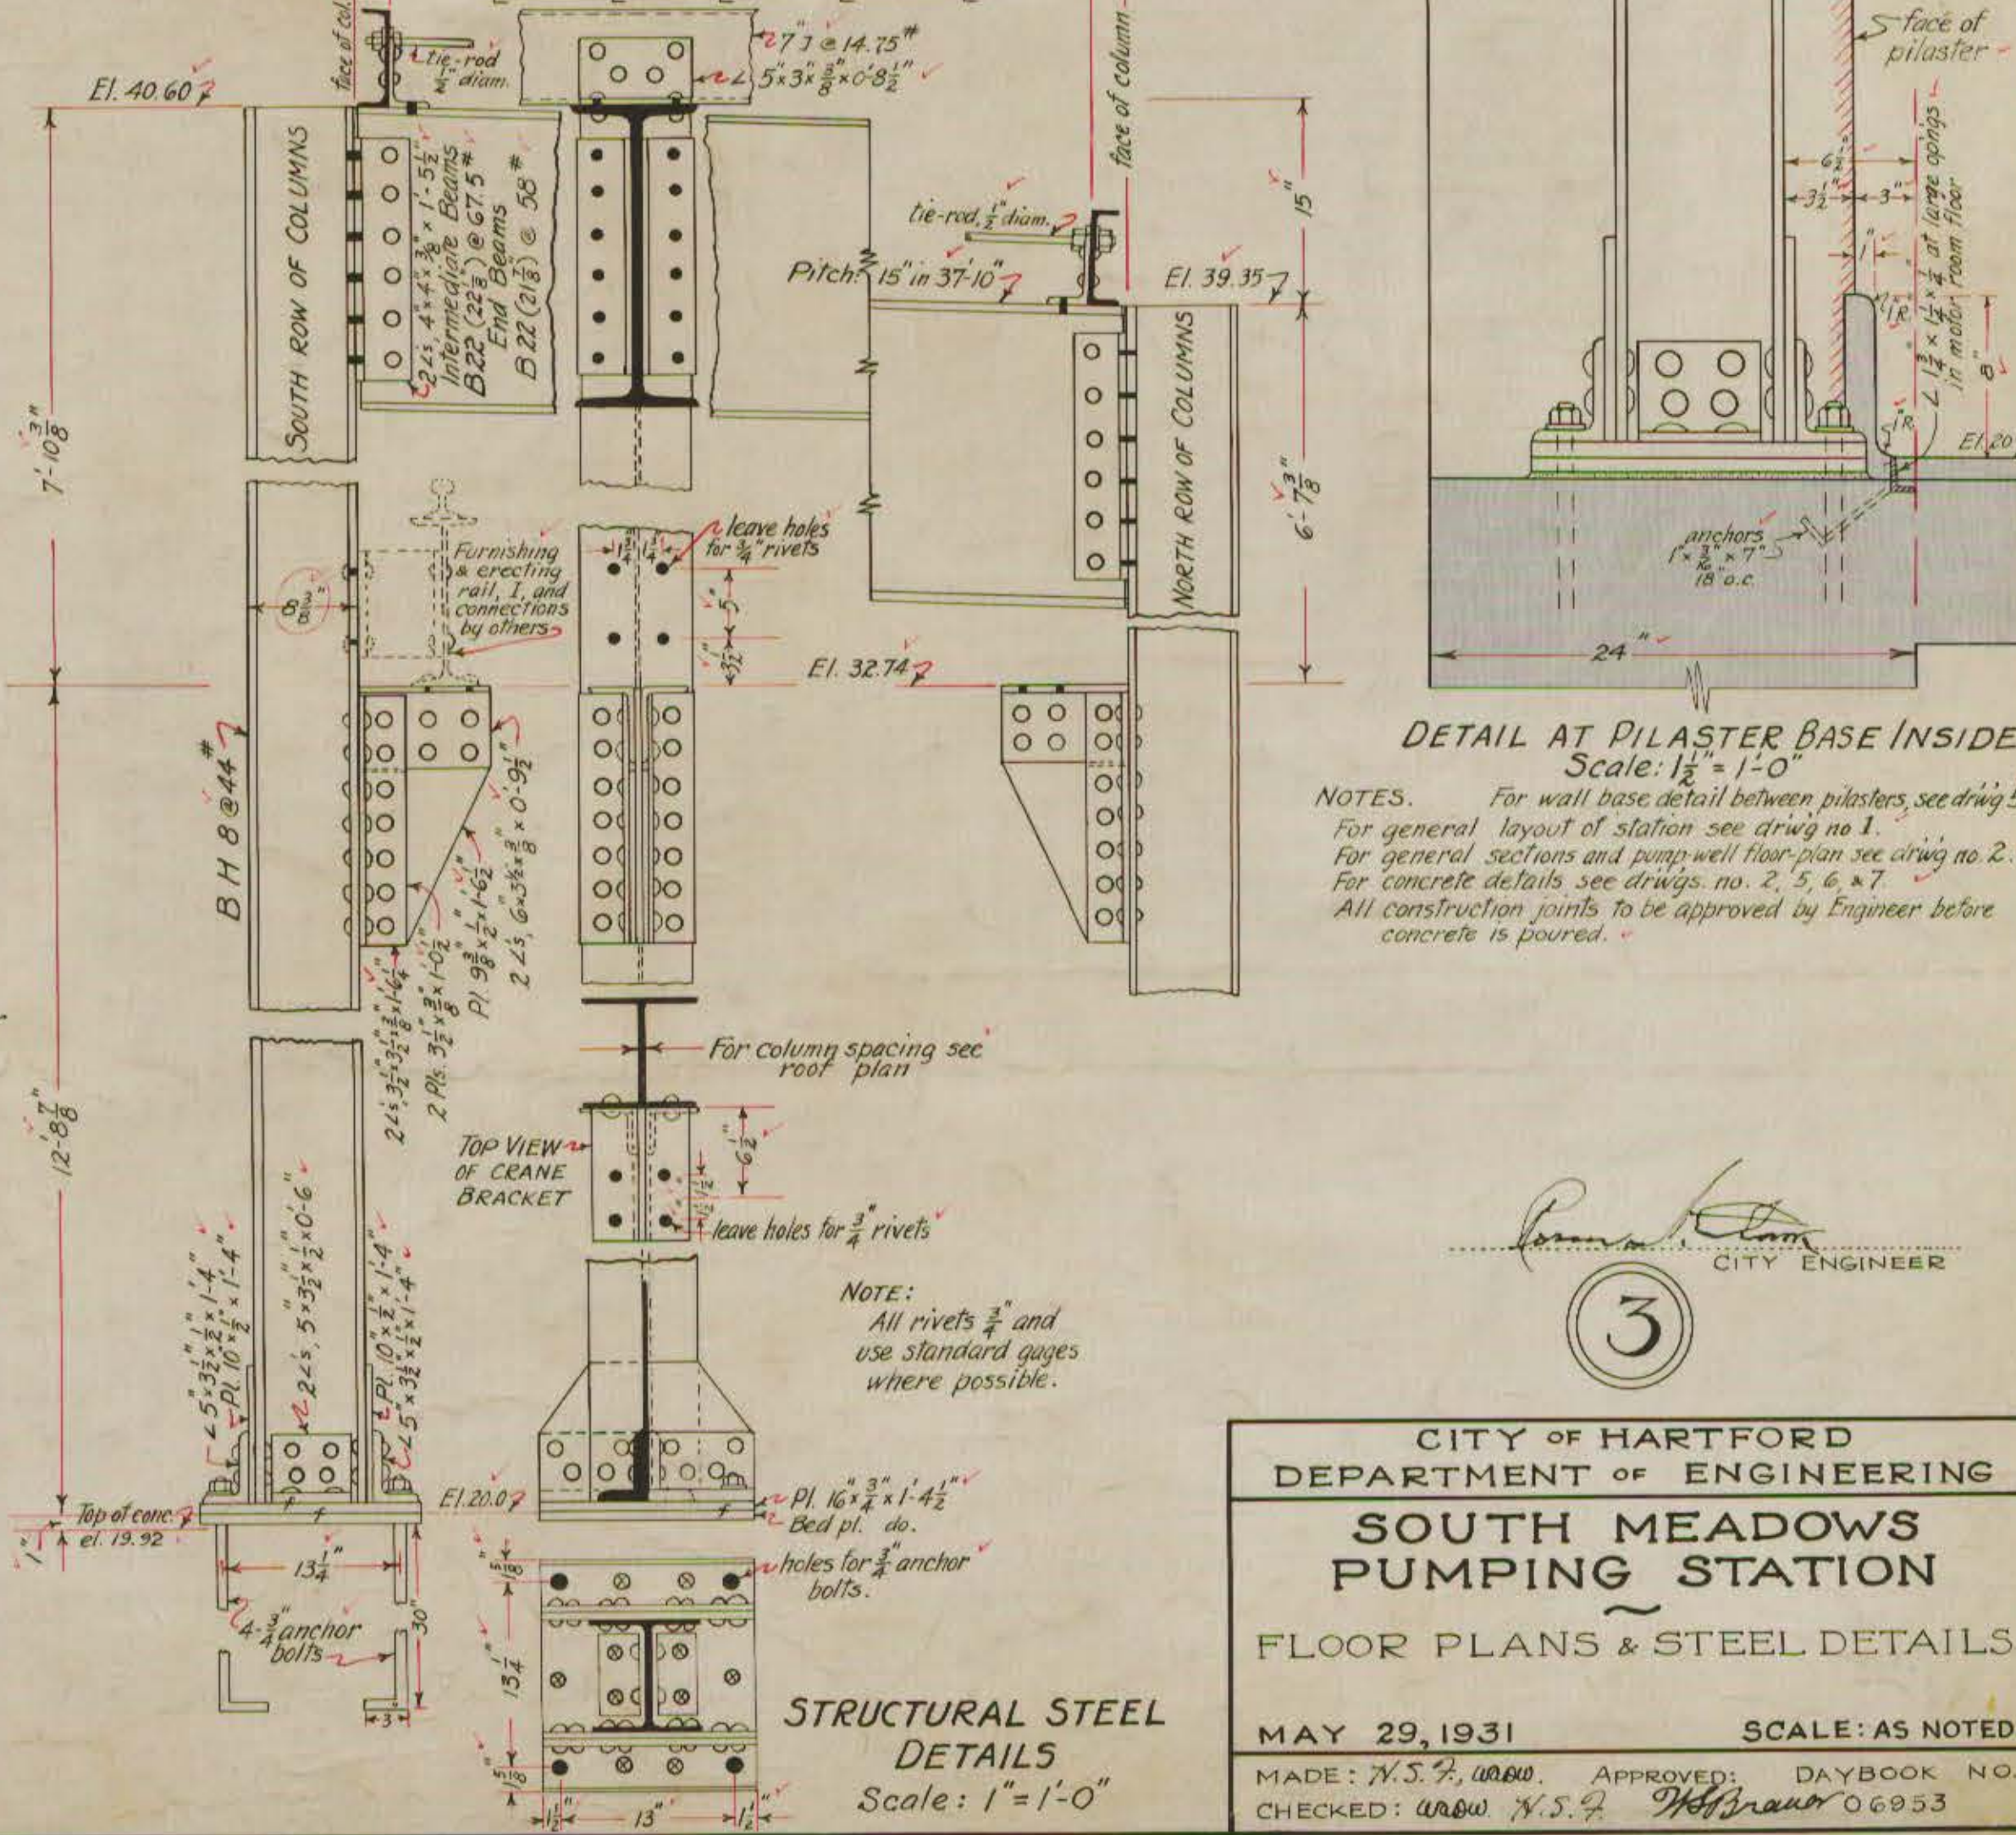

STRUCTURAL STEEL  
DETAILS  
Scale: 1" = 1'-0"

DETAIL AT PILASTER BASE INSIDE  
Scale:  $1\frac{1}{2}'' = 1'-0''$

NOTES. For wall base detail between pilasters, see drwg 5.  
For general layout of station see drwg no 1.  
For general sections and pump well floor plan see drwg no 2.  
For concrete details see drwgs. no. 2, 5, 6, & 7.  
All construction joints to be approved by Engineer before  
concrete is poured.

CITY OF HARTFORD  
DEPARTMENT OF ENGINEERING  
SOUTH MEADOWS  
PUMPING STATION  
FLOOR PLANS & STEEL DETAILS

MAY 29, 1931 SCALE: AS NOTED  
MADE: *N.S. 2, 10000* APPROVED: DAYBOOK NO.  
CHECKED: *(10000) N.S. 2* *W. H. Inman* 06953