




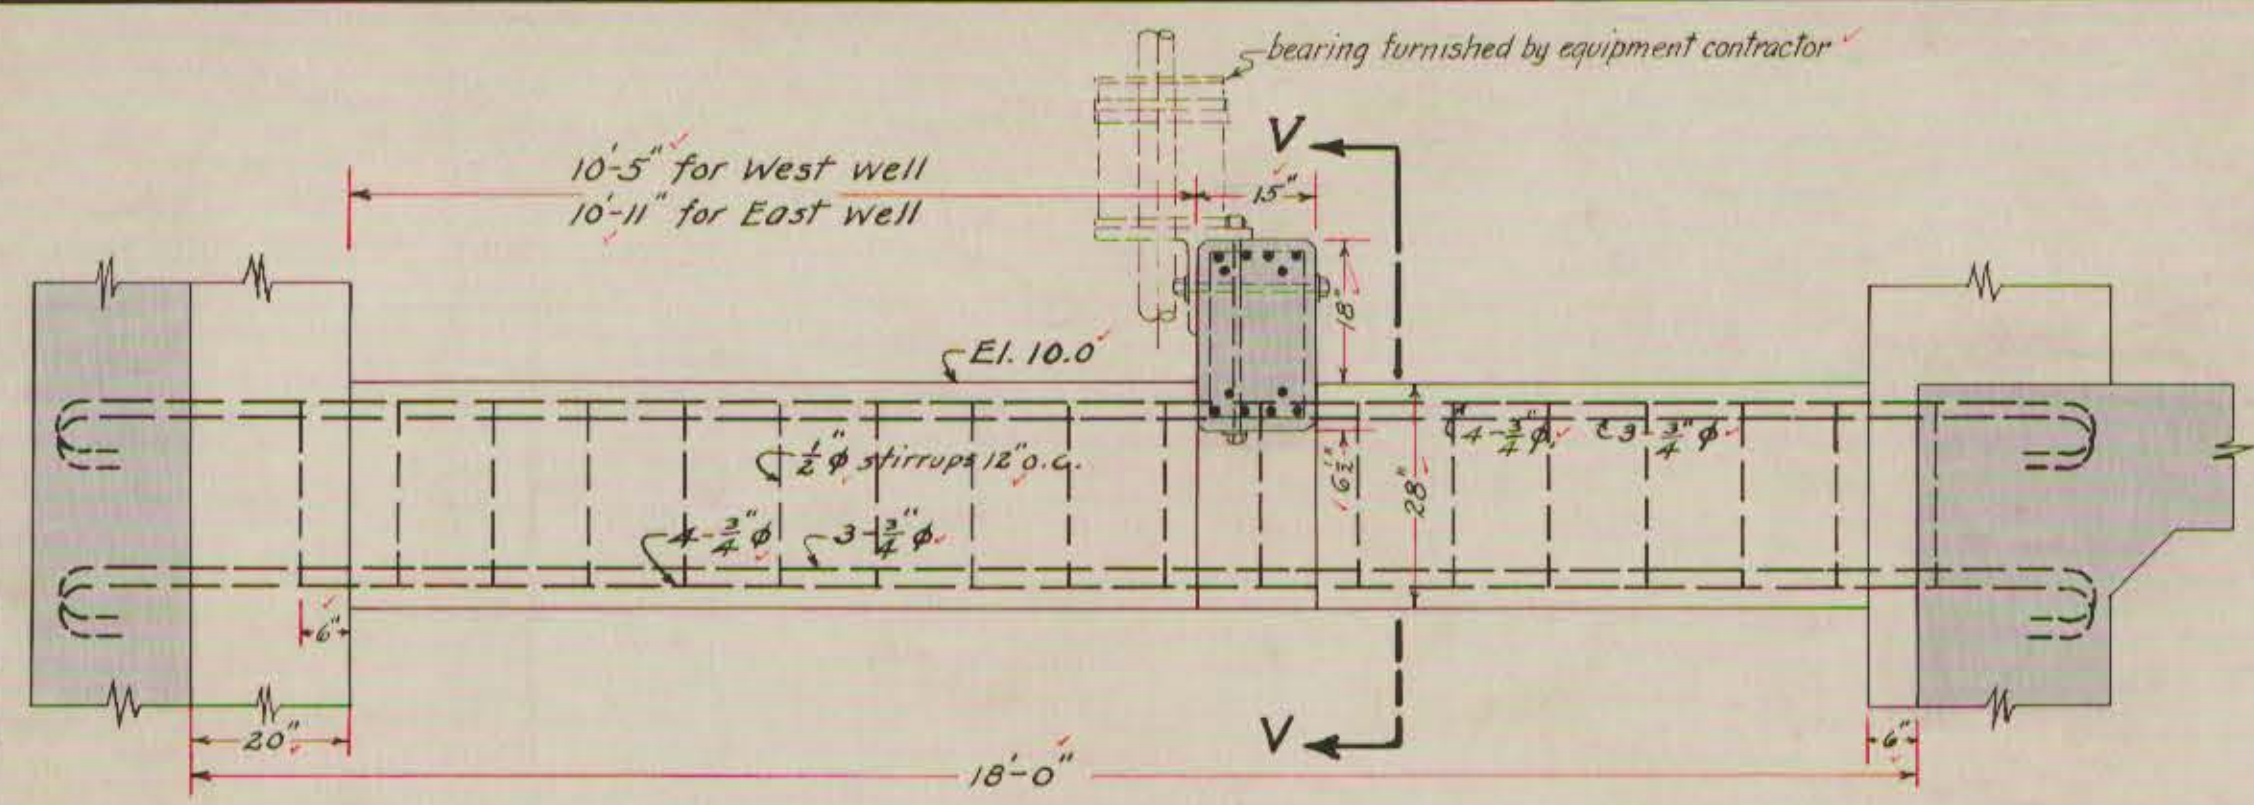


NORTH ELEVATION OF SUPPORTING BEAM  
FOR STEADY-BEARING BEAM  
Scale:  $\frac{1}{2}'' = 1'-0''$   
TWO THUS OVER WEST PUMP WELL  
TWO SIMILAR BUT OPPOSITE-HAND OVER EAST PUMP WELL  
ENDS CENTERED ON PILASTERS.

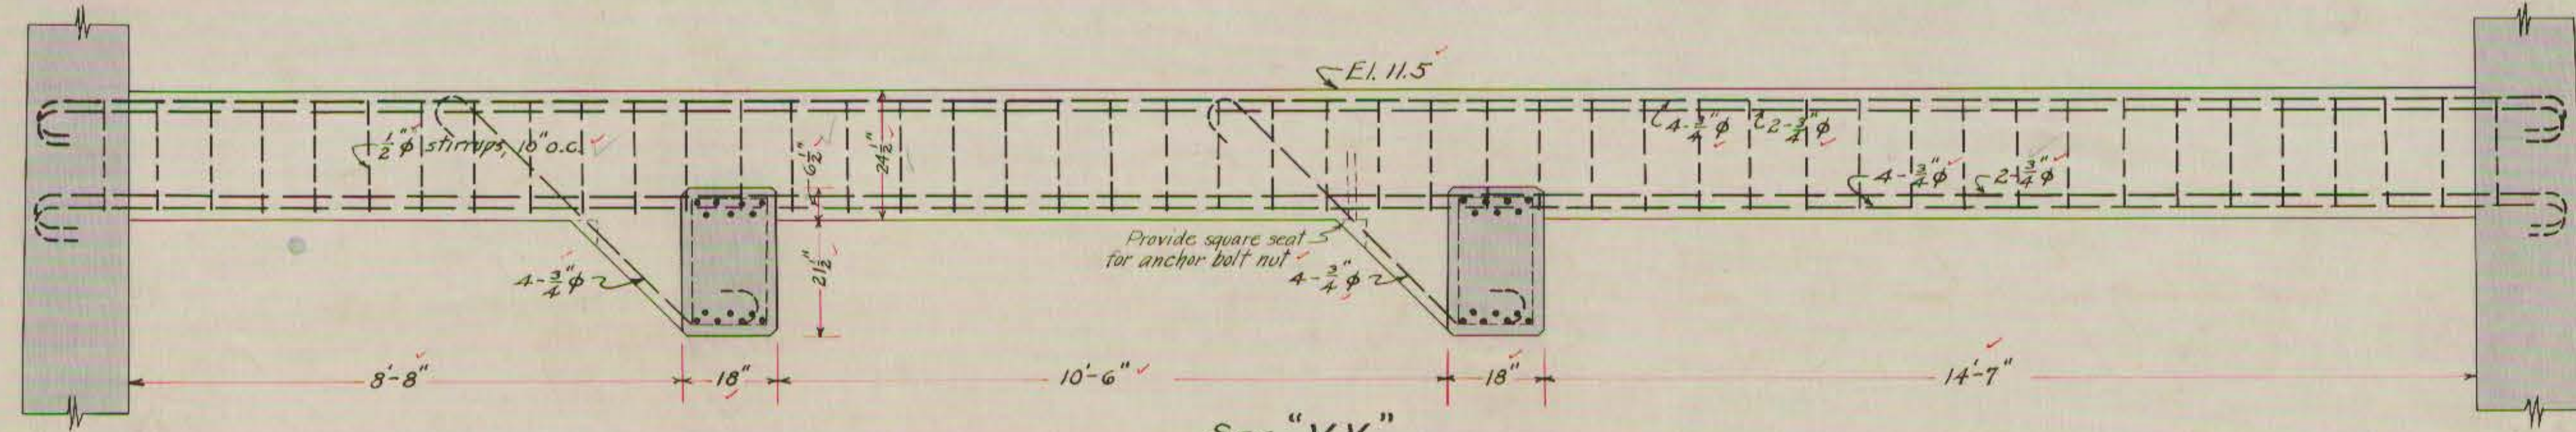


SEC. "VV"  
Scale:  $\frac{1}{2}'' = 1'-0''$   
For "steady-bearing" anchor-bolt locations, see mfgs. dirigs.

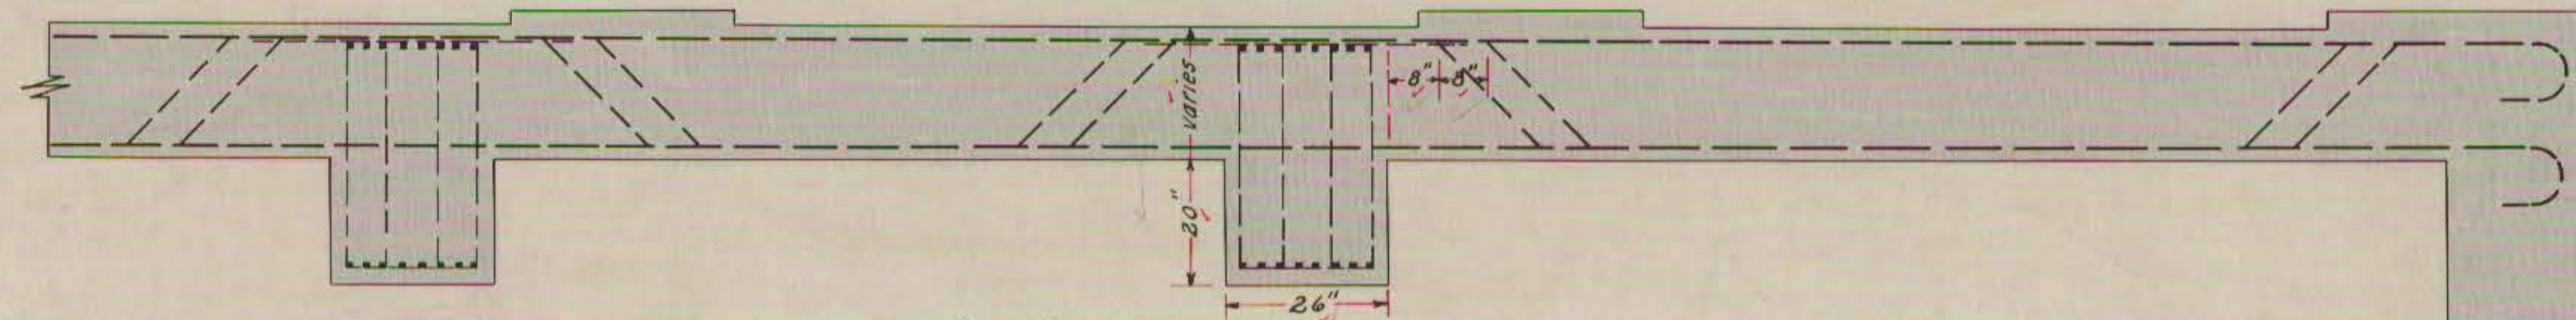


SEC. "ZZ" ALSO TYPICAL WALL PLAN  
Showing how horizontal rods are bent when so indicated  
in wall sections. Vertical steel not shown (except in pilasters)  
Scale:  $\frac{1}{2}'' = 1'-0''$

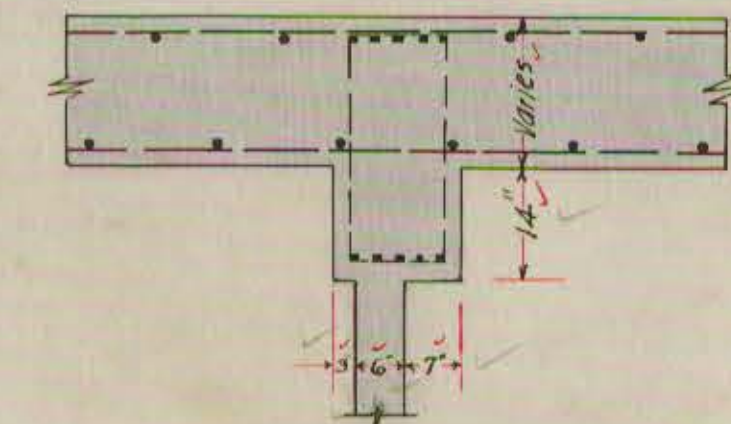


SEC. "WW"  
Scale:  $\frac{1}{2}'' = 1'-0''$

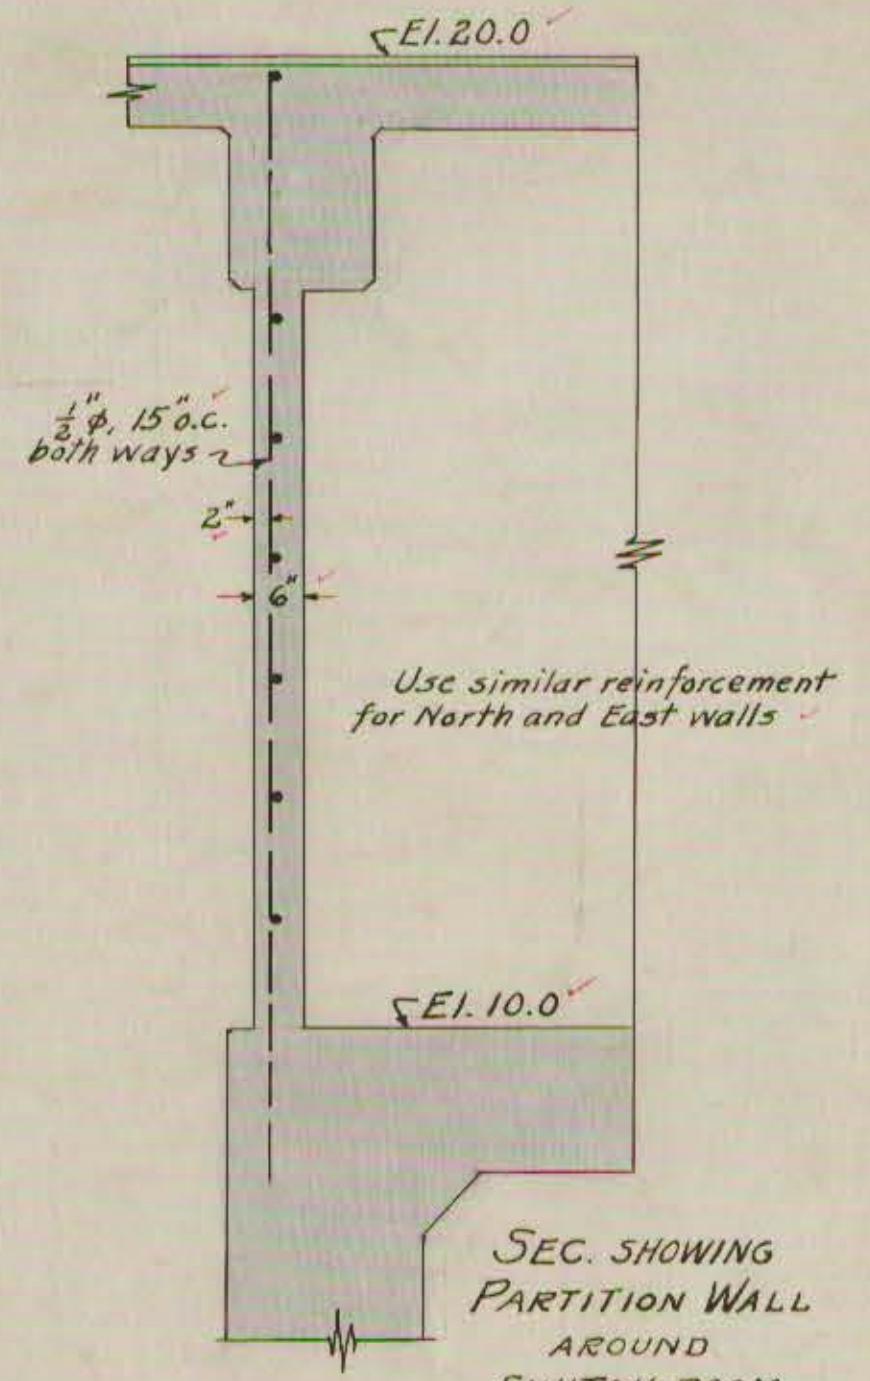

SEC. SHOWING  
PARTITION WALL  
AROUND  
SWITCH-ROOM  
Scale:  $\frac{1}{2}'' = 1'-0''$

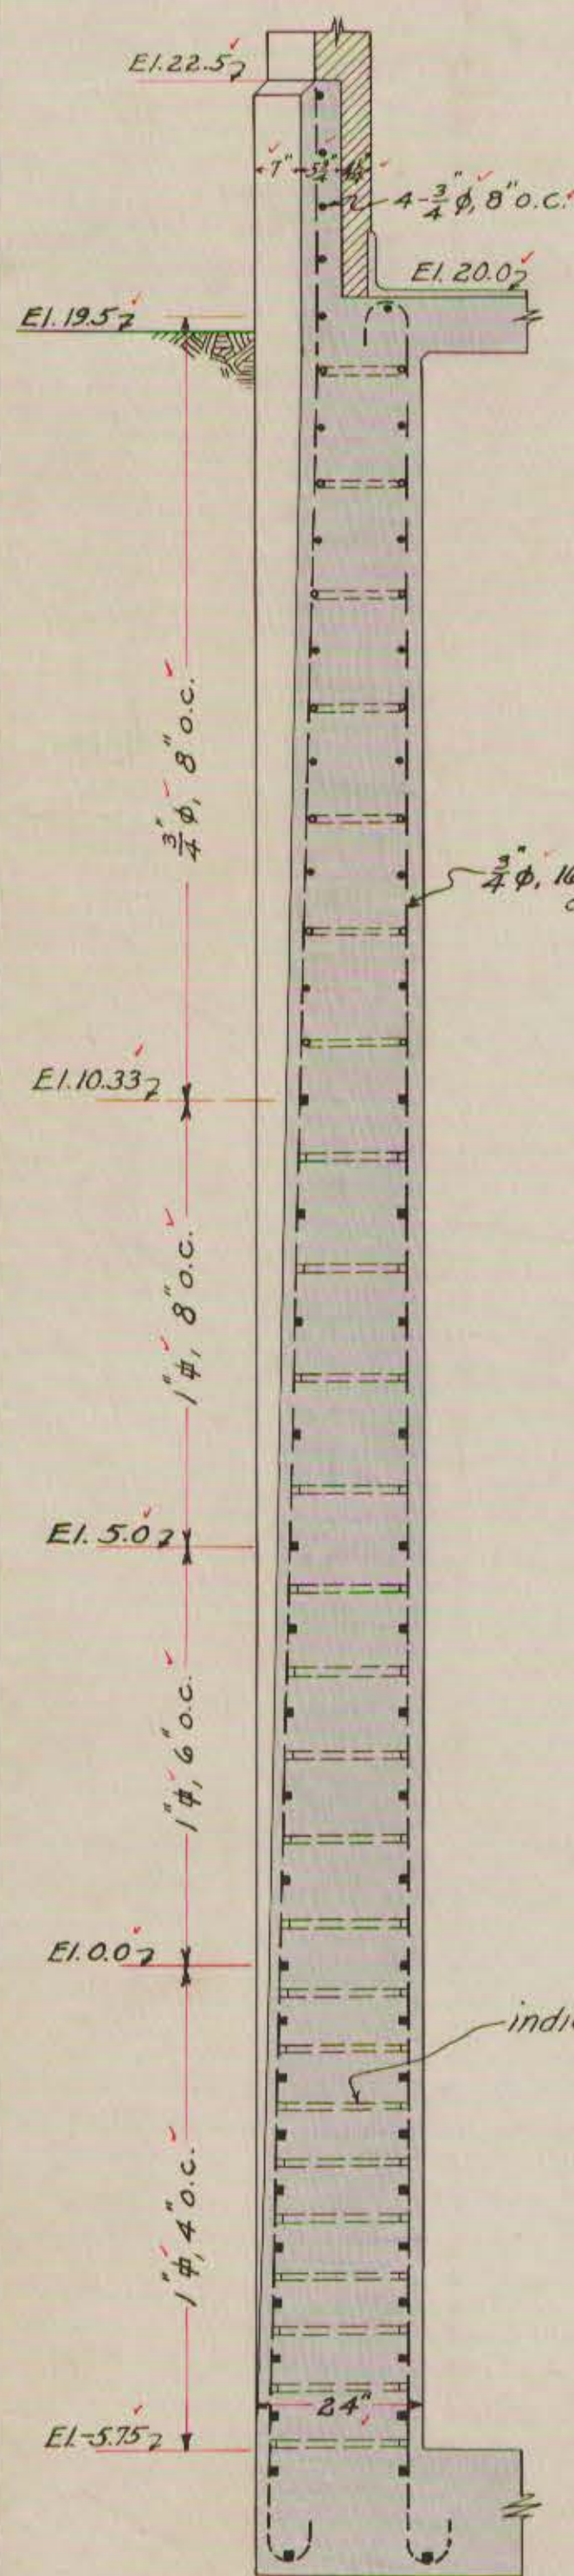


SEC. "OO"  
Scale:  $\frac{1}{2}'' = 1'-0''$

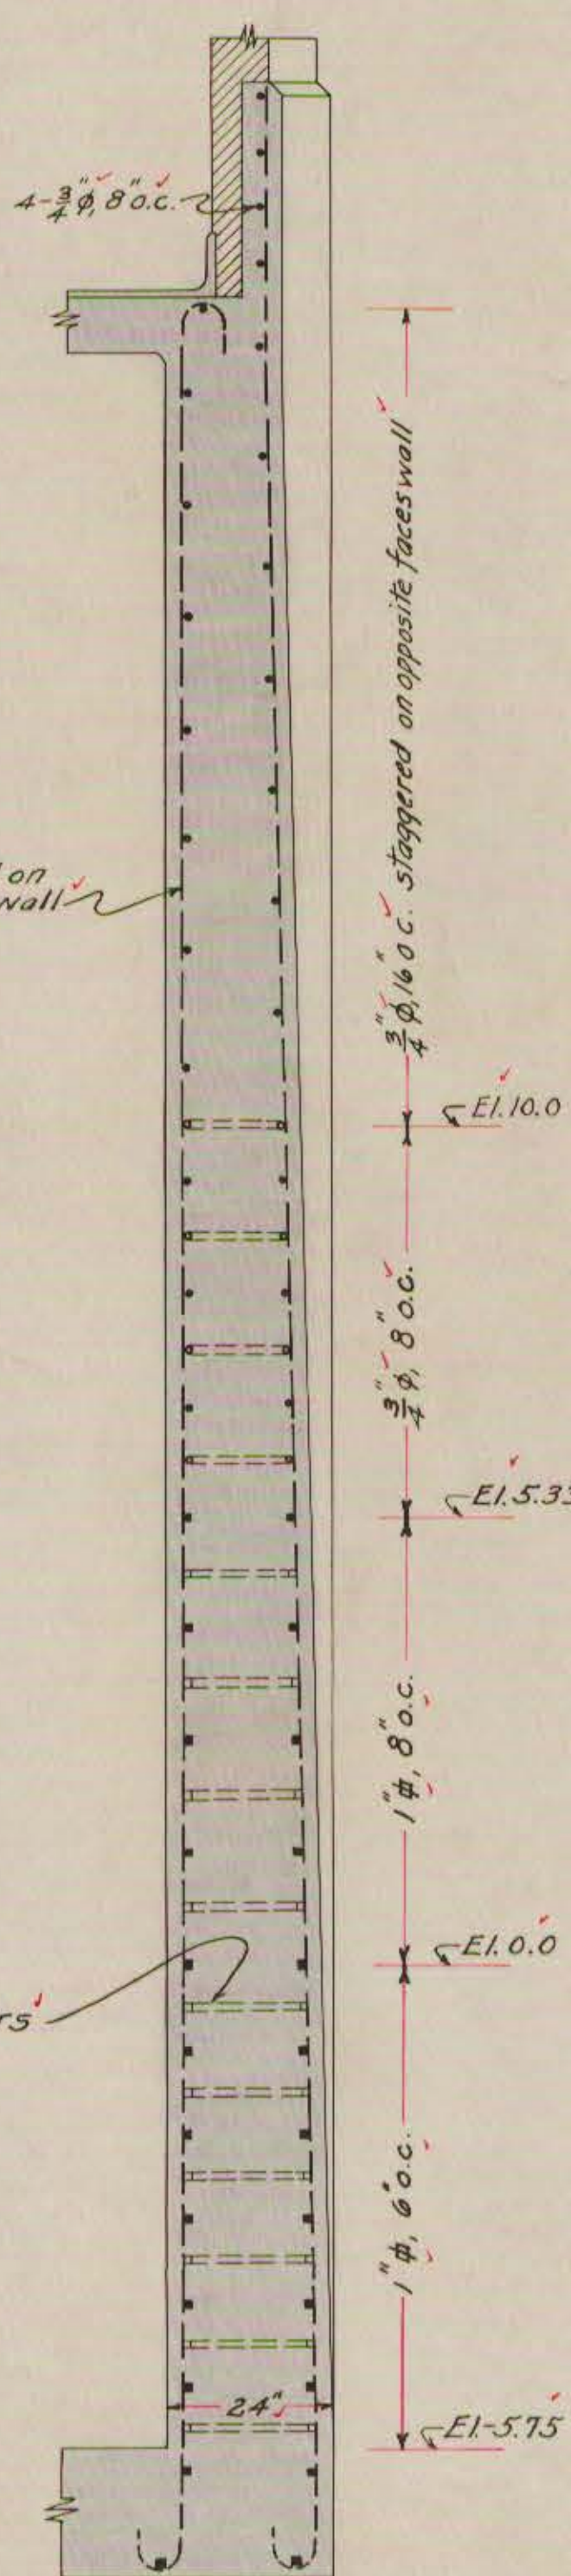


SEC. "PP"  
Scale:  $\frac{1}{2}'' = 1'-0''$


See dirig. no. 4 for exterior  
stair brackets.

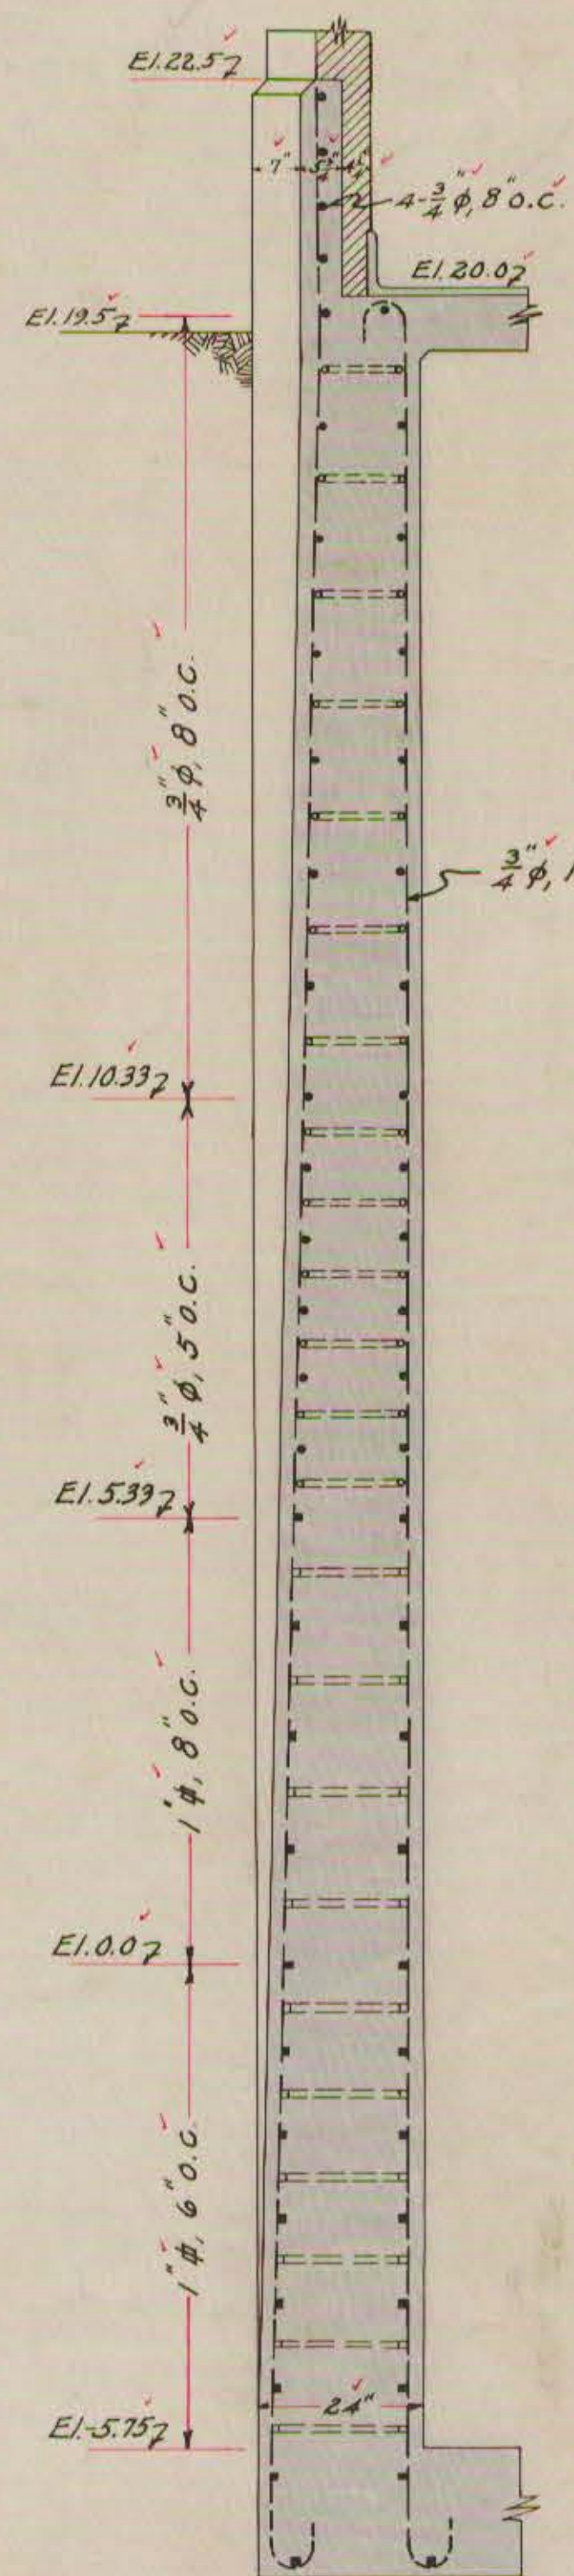


SEC. "QQ"  
Scale:  $\frac{1}{2}'' = 1'-0''$

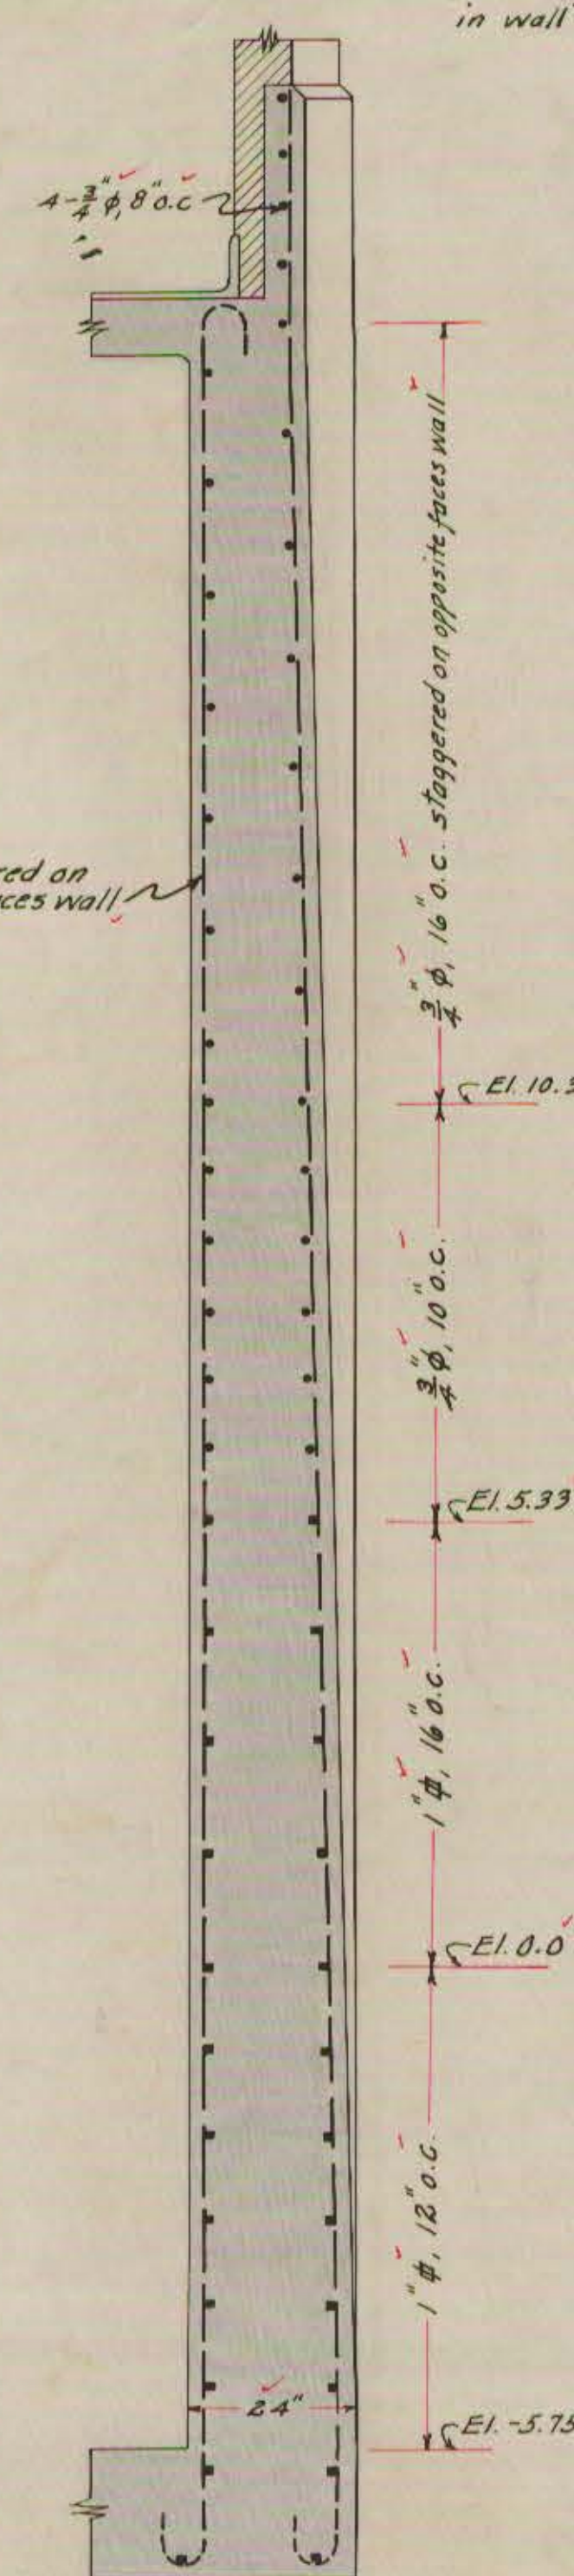



SEC. "RR"  
Scale:  $\frac{1}{2}'' = 1'-0''$

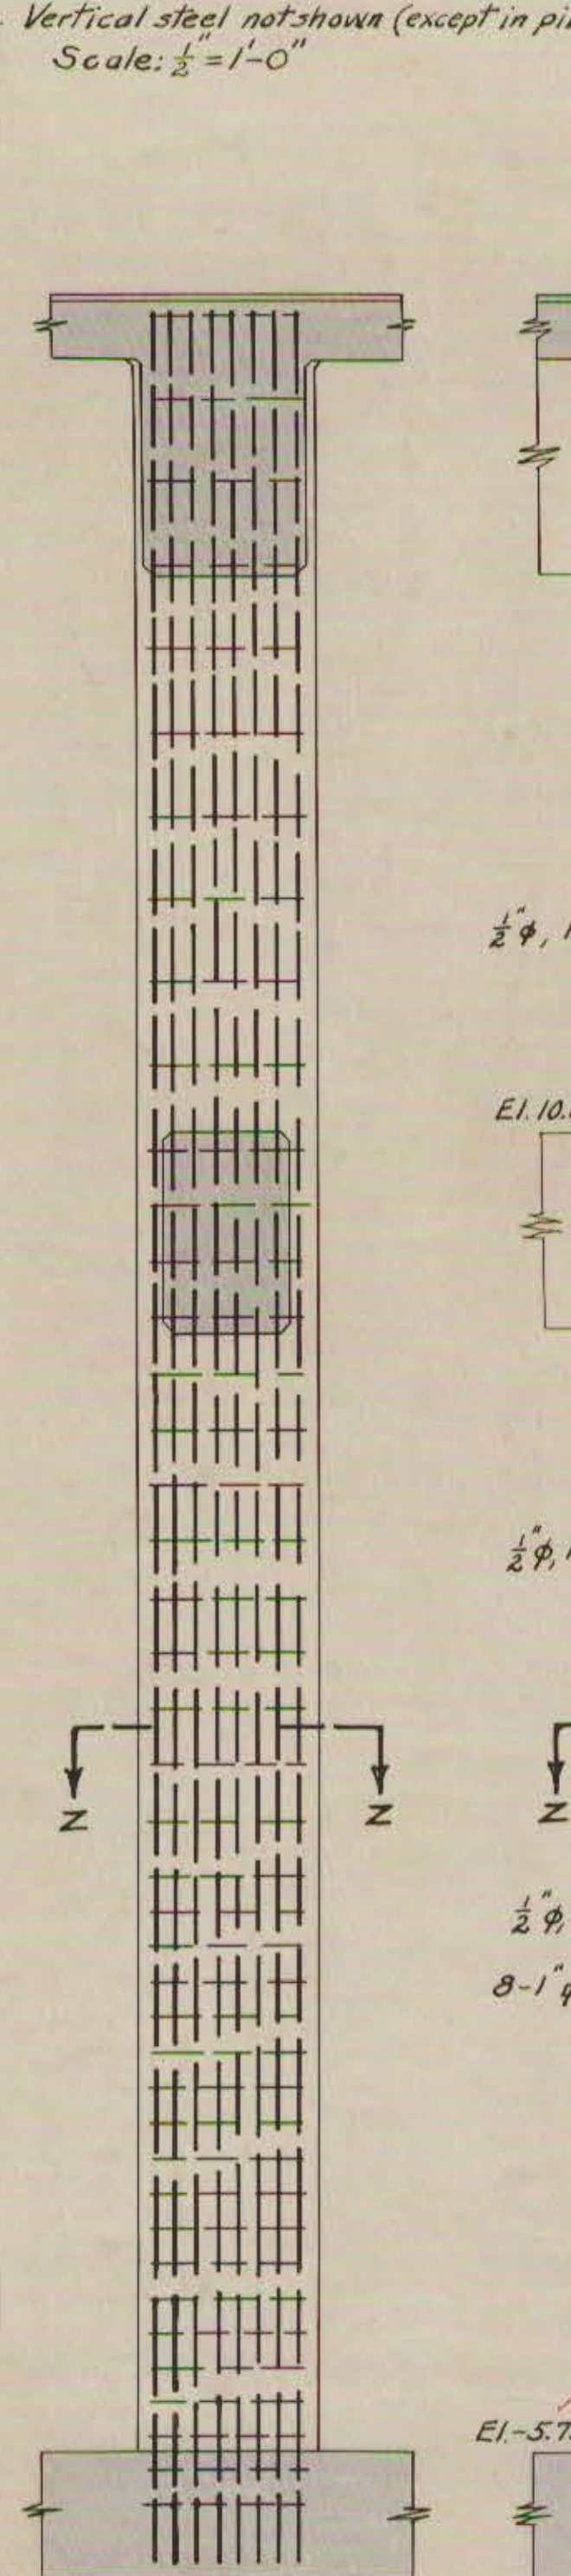

SEC. "SS"  
Scale:  $\frac{1}{2}'' = 1'-0''$   
Wall reinforcement not shown

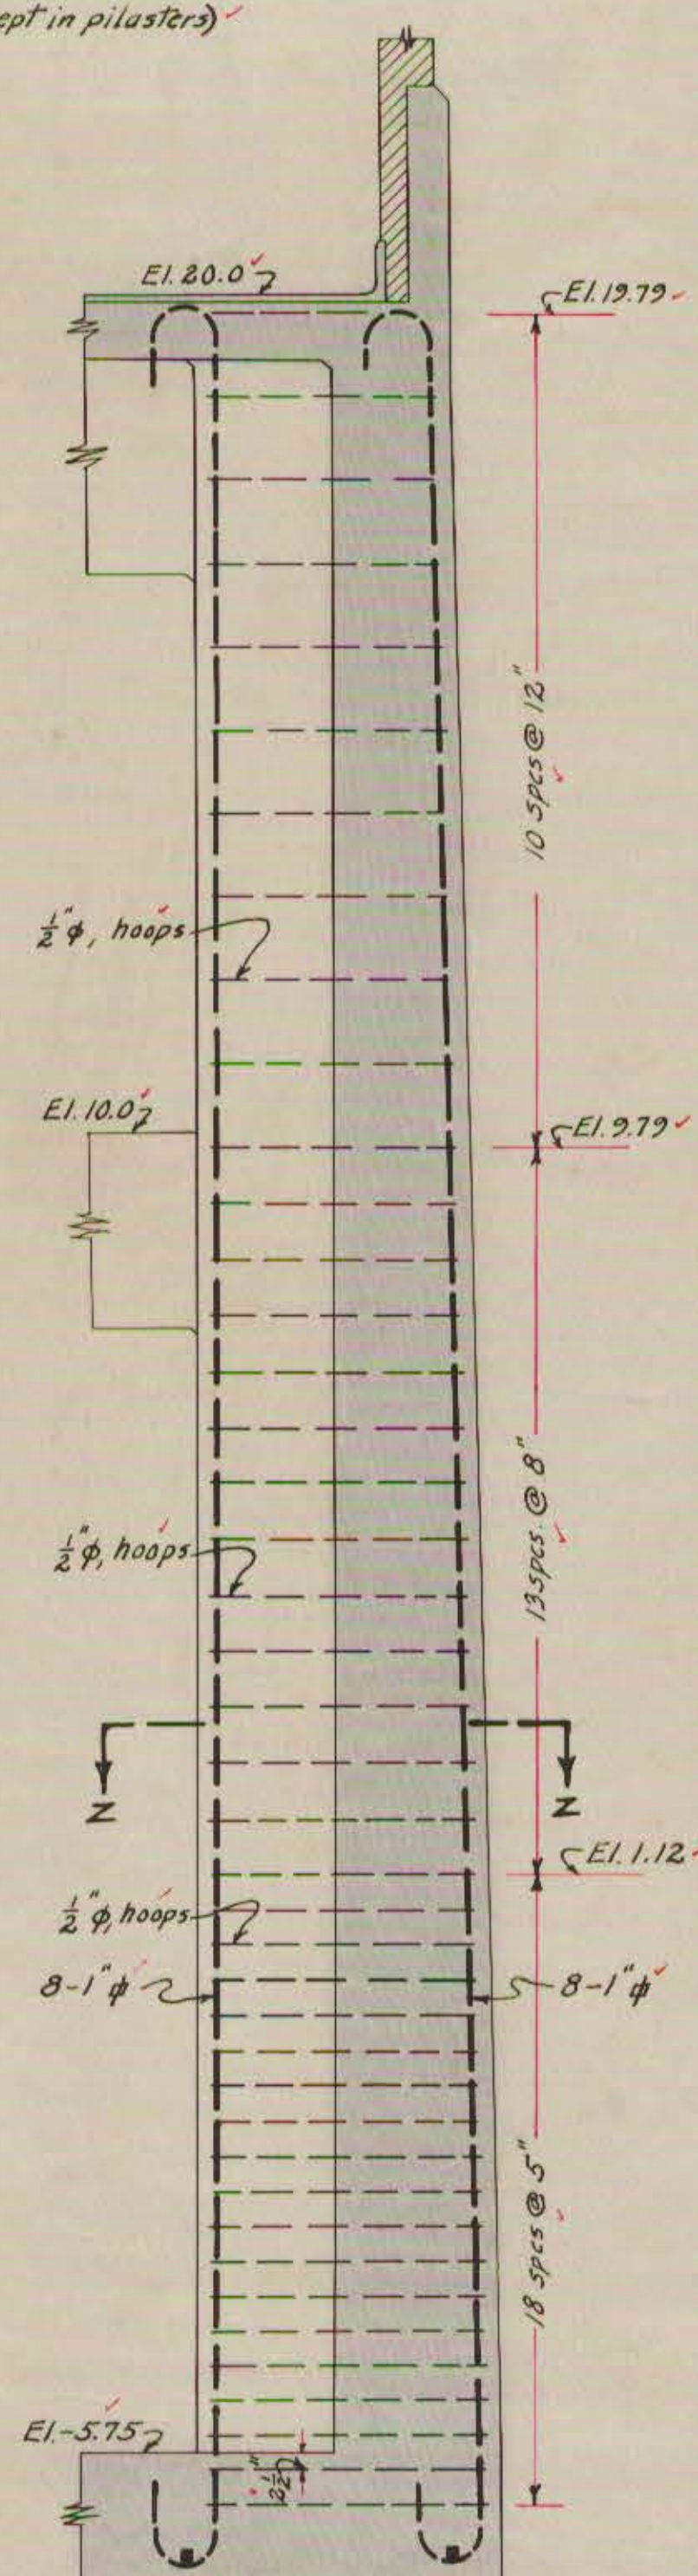

SEC. "TT"  
SEC. "TT" similar but opposite-hand  
Scale:  $\frac{1}{2}'' = 1'-0''$   
Conduit reinforcement not shown.

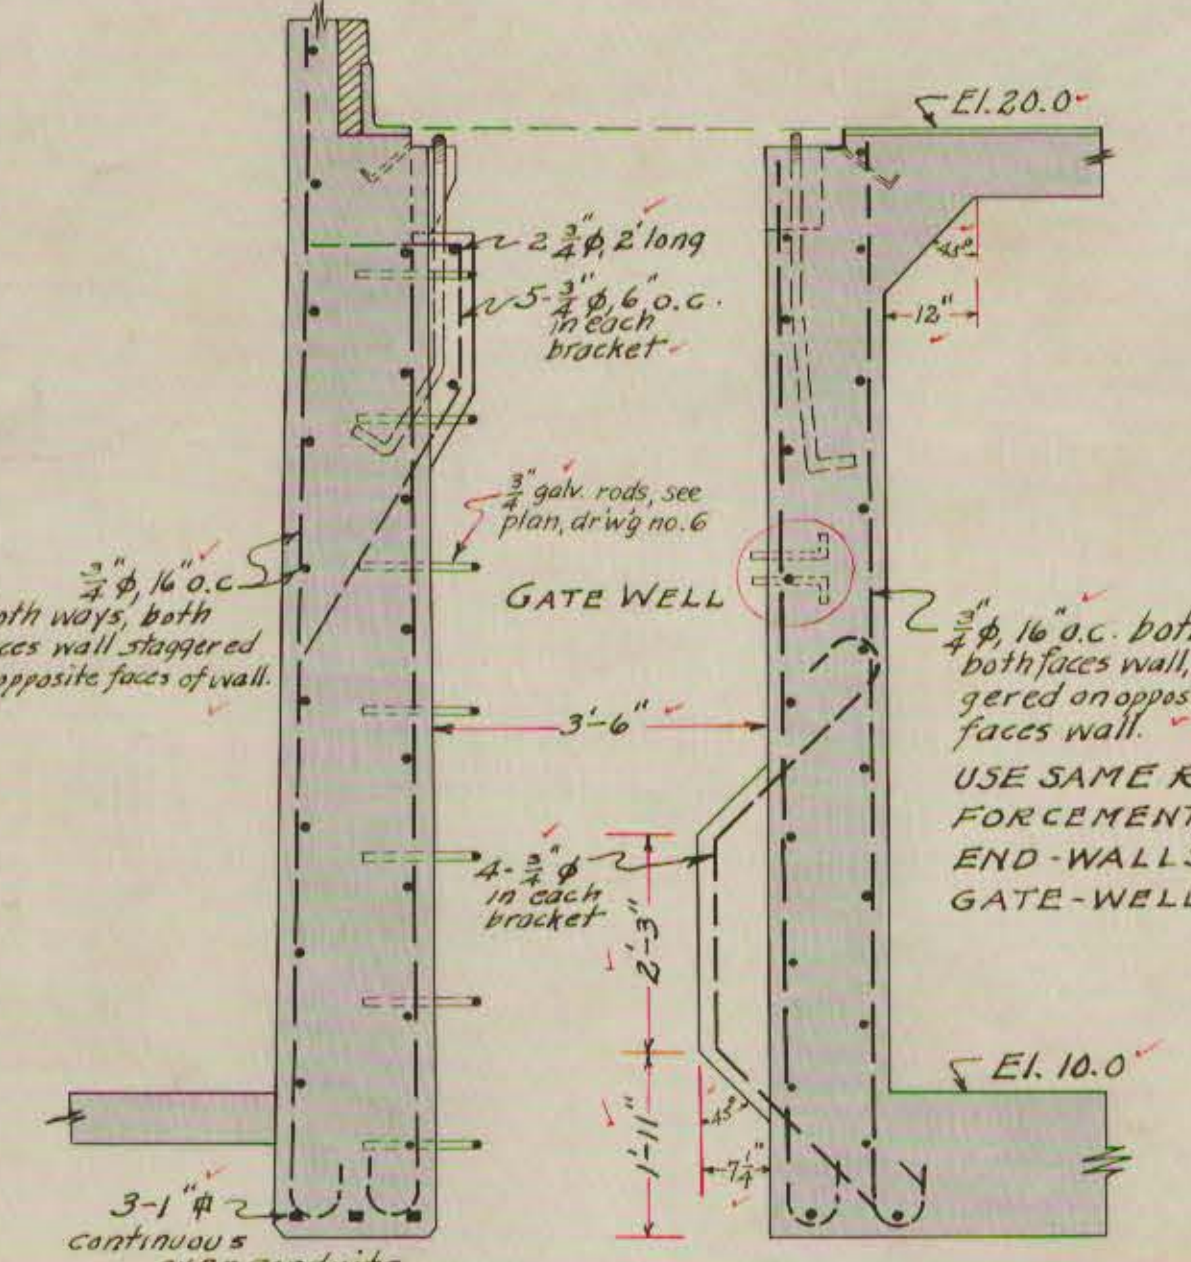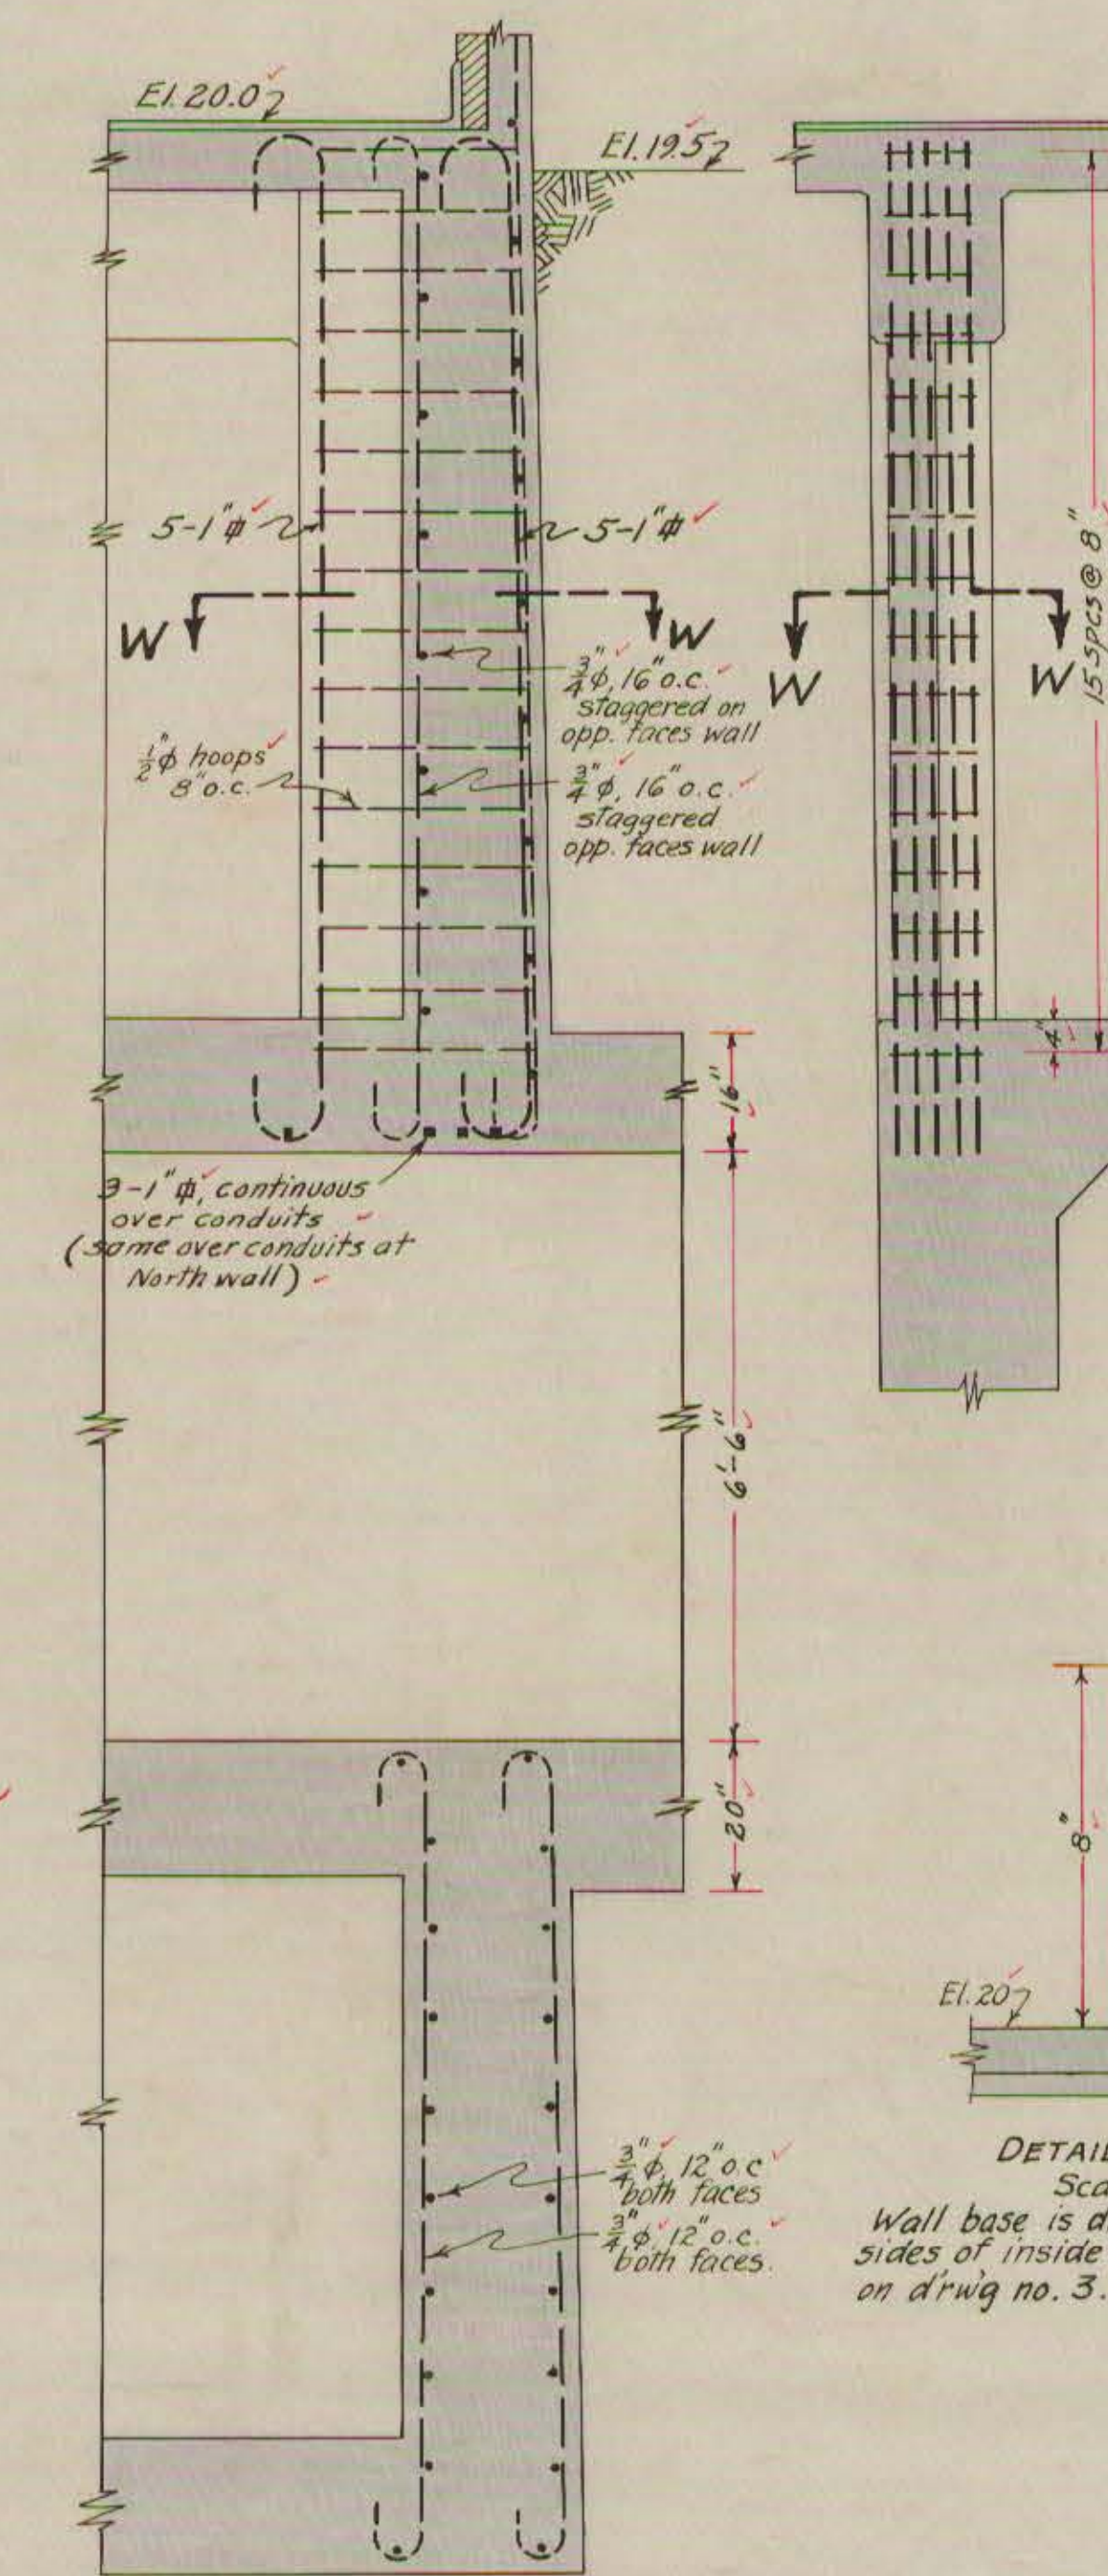

SEC. "UU"  
Scale:  $\frac{1}{2}'' = 1'-0''$

NOTES:  
Location of sections shown on dirig. no. 6.  
For anchor-bolt locations, see mfgs. dirigs.  
Center of rods to be not less than 2" from surface.  
Ends of 1" rods to be bent into standard hook, 6" diam.  
Laps for splicing to be not less than 40 diameters.  
Concrete mix, 1:2:4 unless otherwise specified.  
All rods to be deformed.  
Corners of concrete to be beveled 3/4".  
All construction joints shall be approved by the  
Engineer before concrete may be poured.

| DATE   | REVISION                                          | BY     | APPR.  |
|--------|---------------------------------------------------|--------|--------|
| 7-3-31 | Anchor bolts for stair guide bracket added.       | W.S.P. | W.S.P. |
| 7-3-31 | Sec. "PP" note added for exterior stair brackets. | W.S.P. | W.S.P. |

5

CITY OF HARTFORD  
DEPARTMENT OF ENGINEERING  
**SOUTH MEADOWS  
PUMPING STATION**  
CONCRETE WALL SECTIONS

MAY 29, 1931 SCALE: AS NOTED  
MADE: W.S.P. APPROVED: DAYBOOK NO.  
CHECKED: G.R.W. W.S.P. 06955