
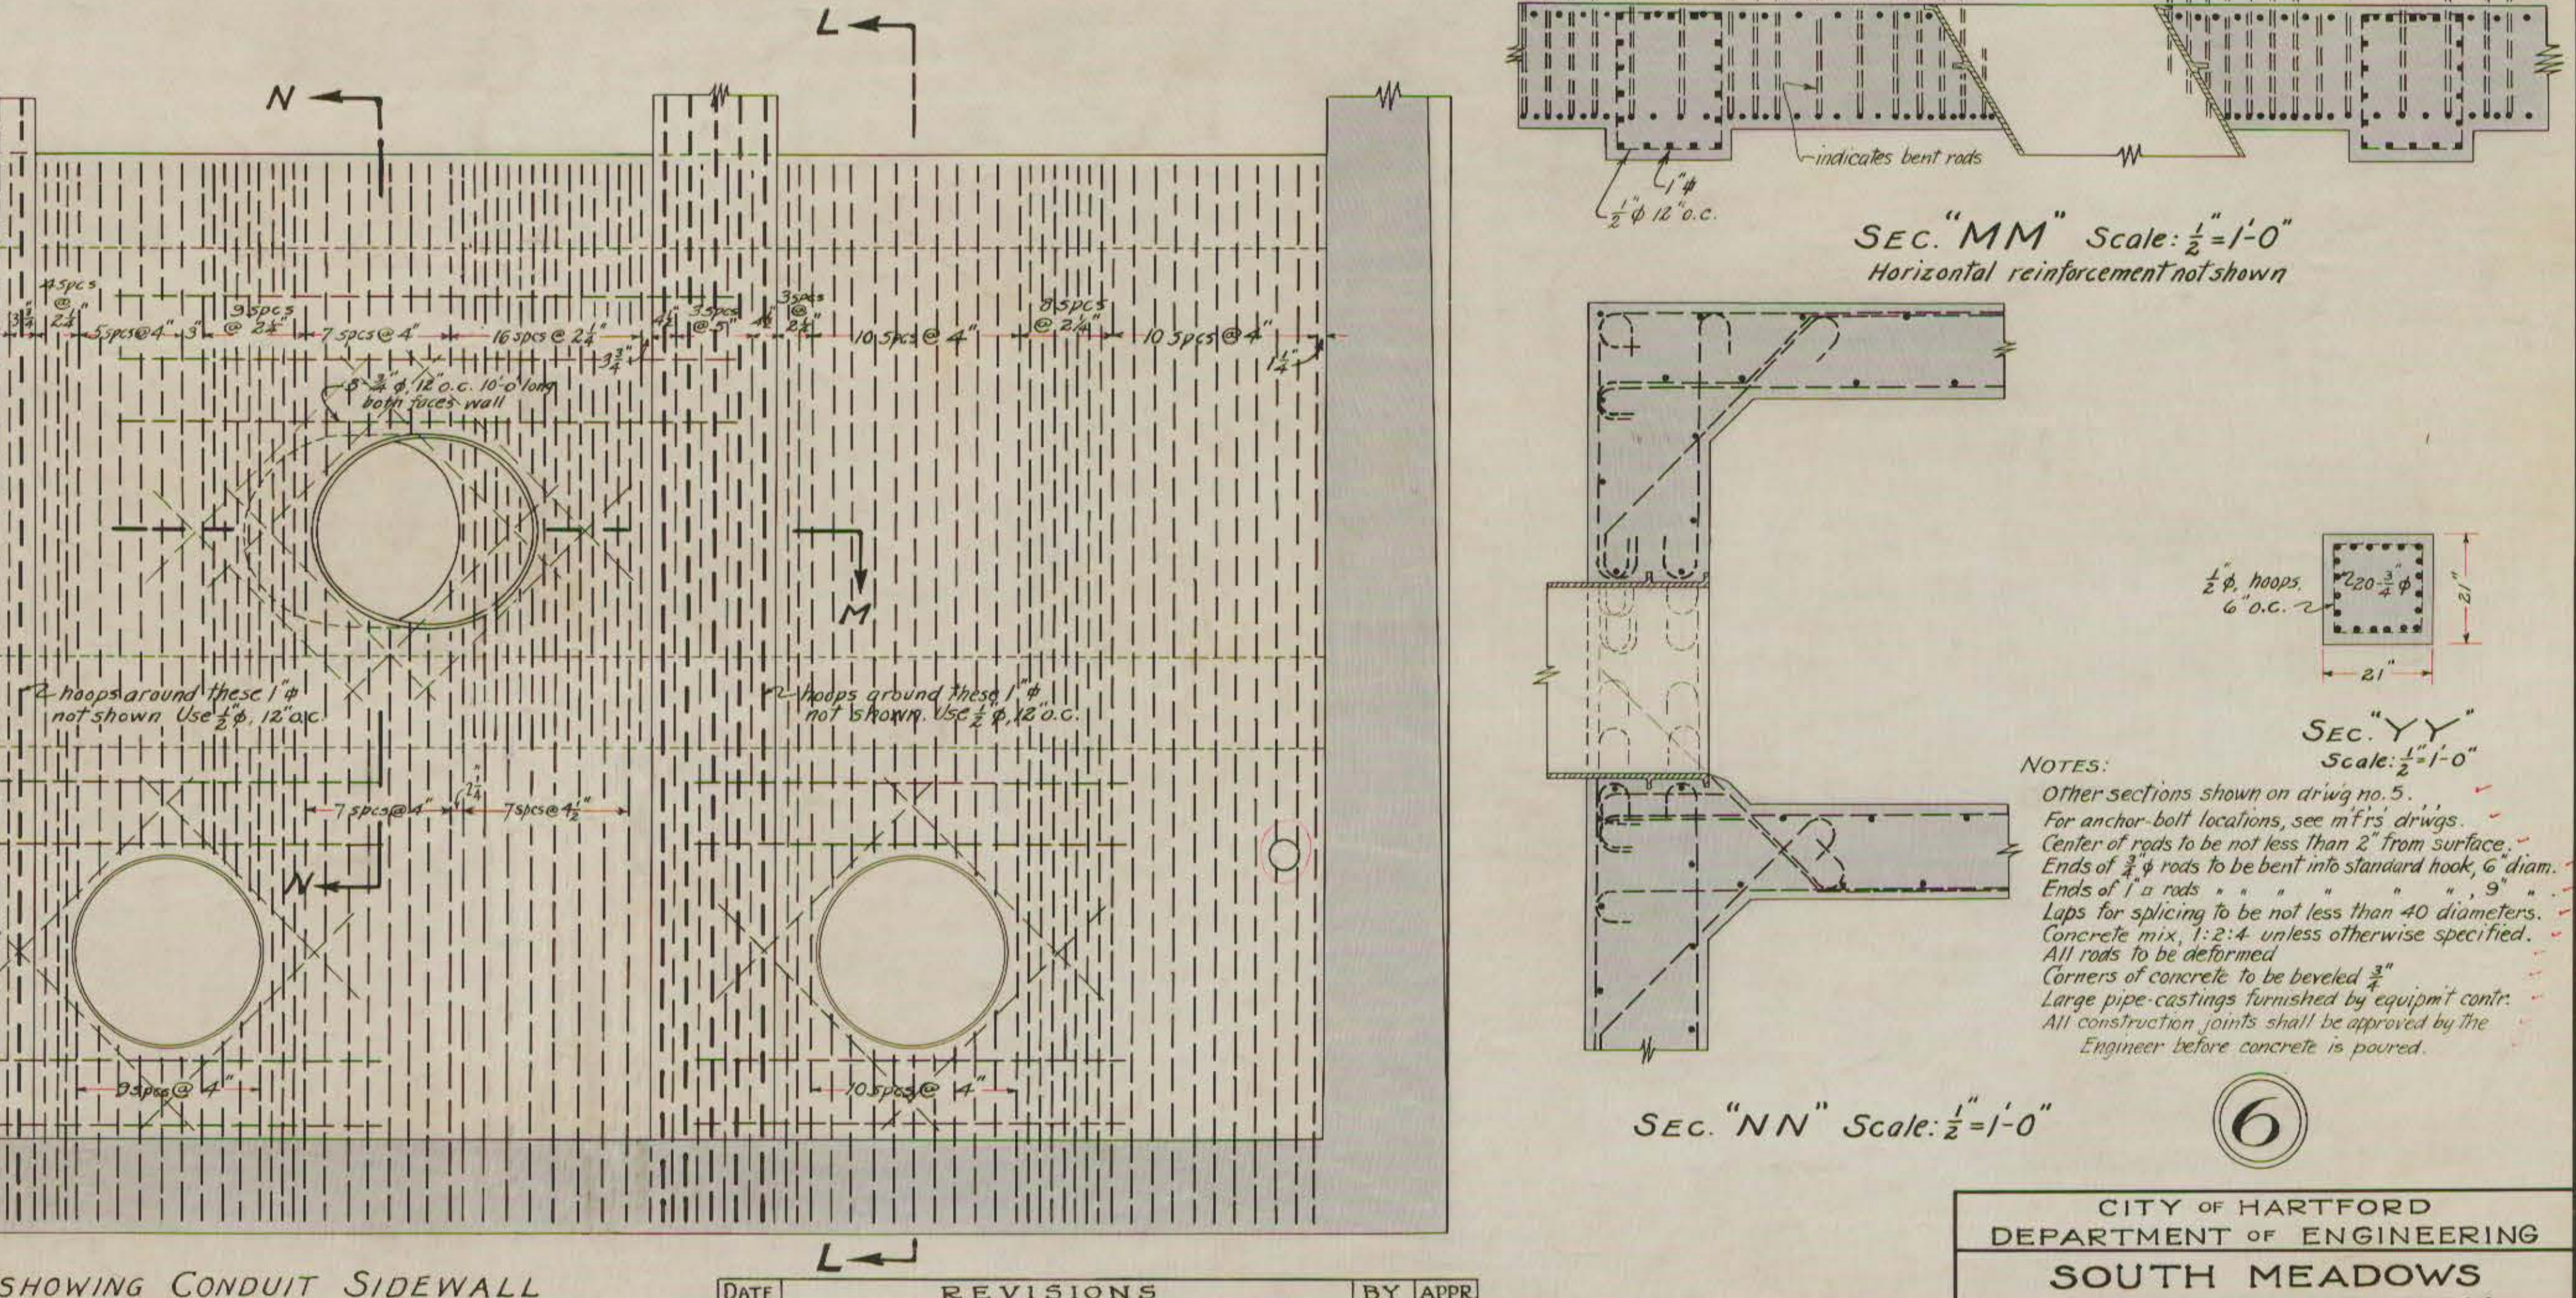
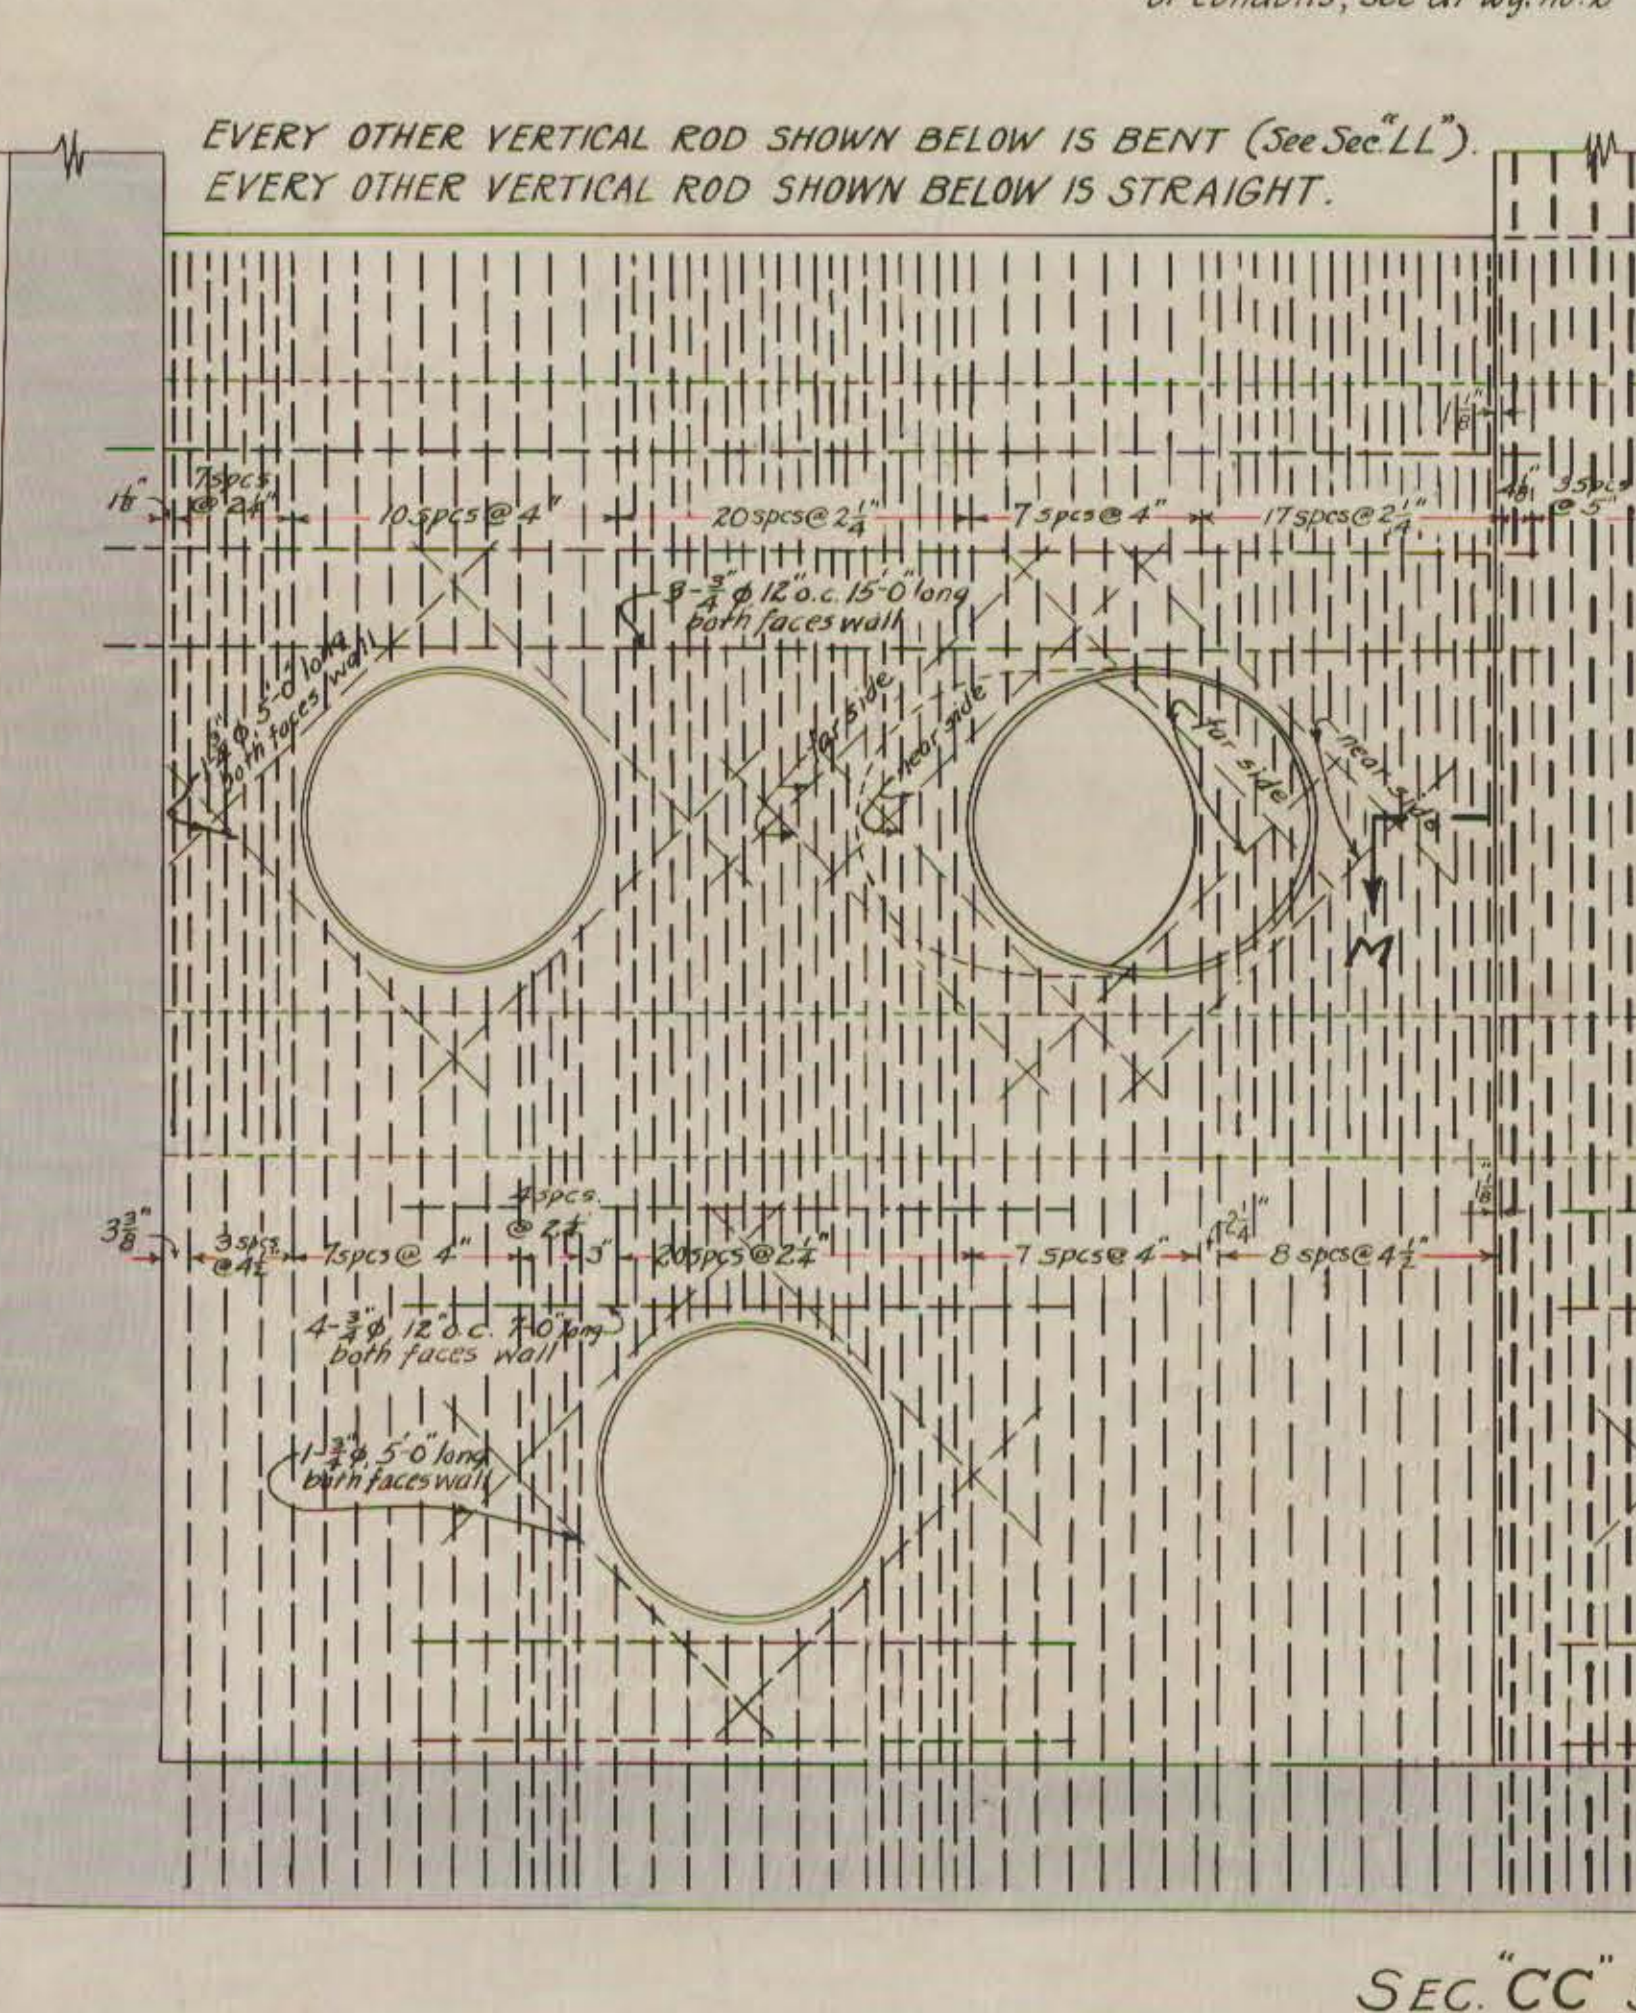
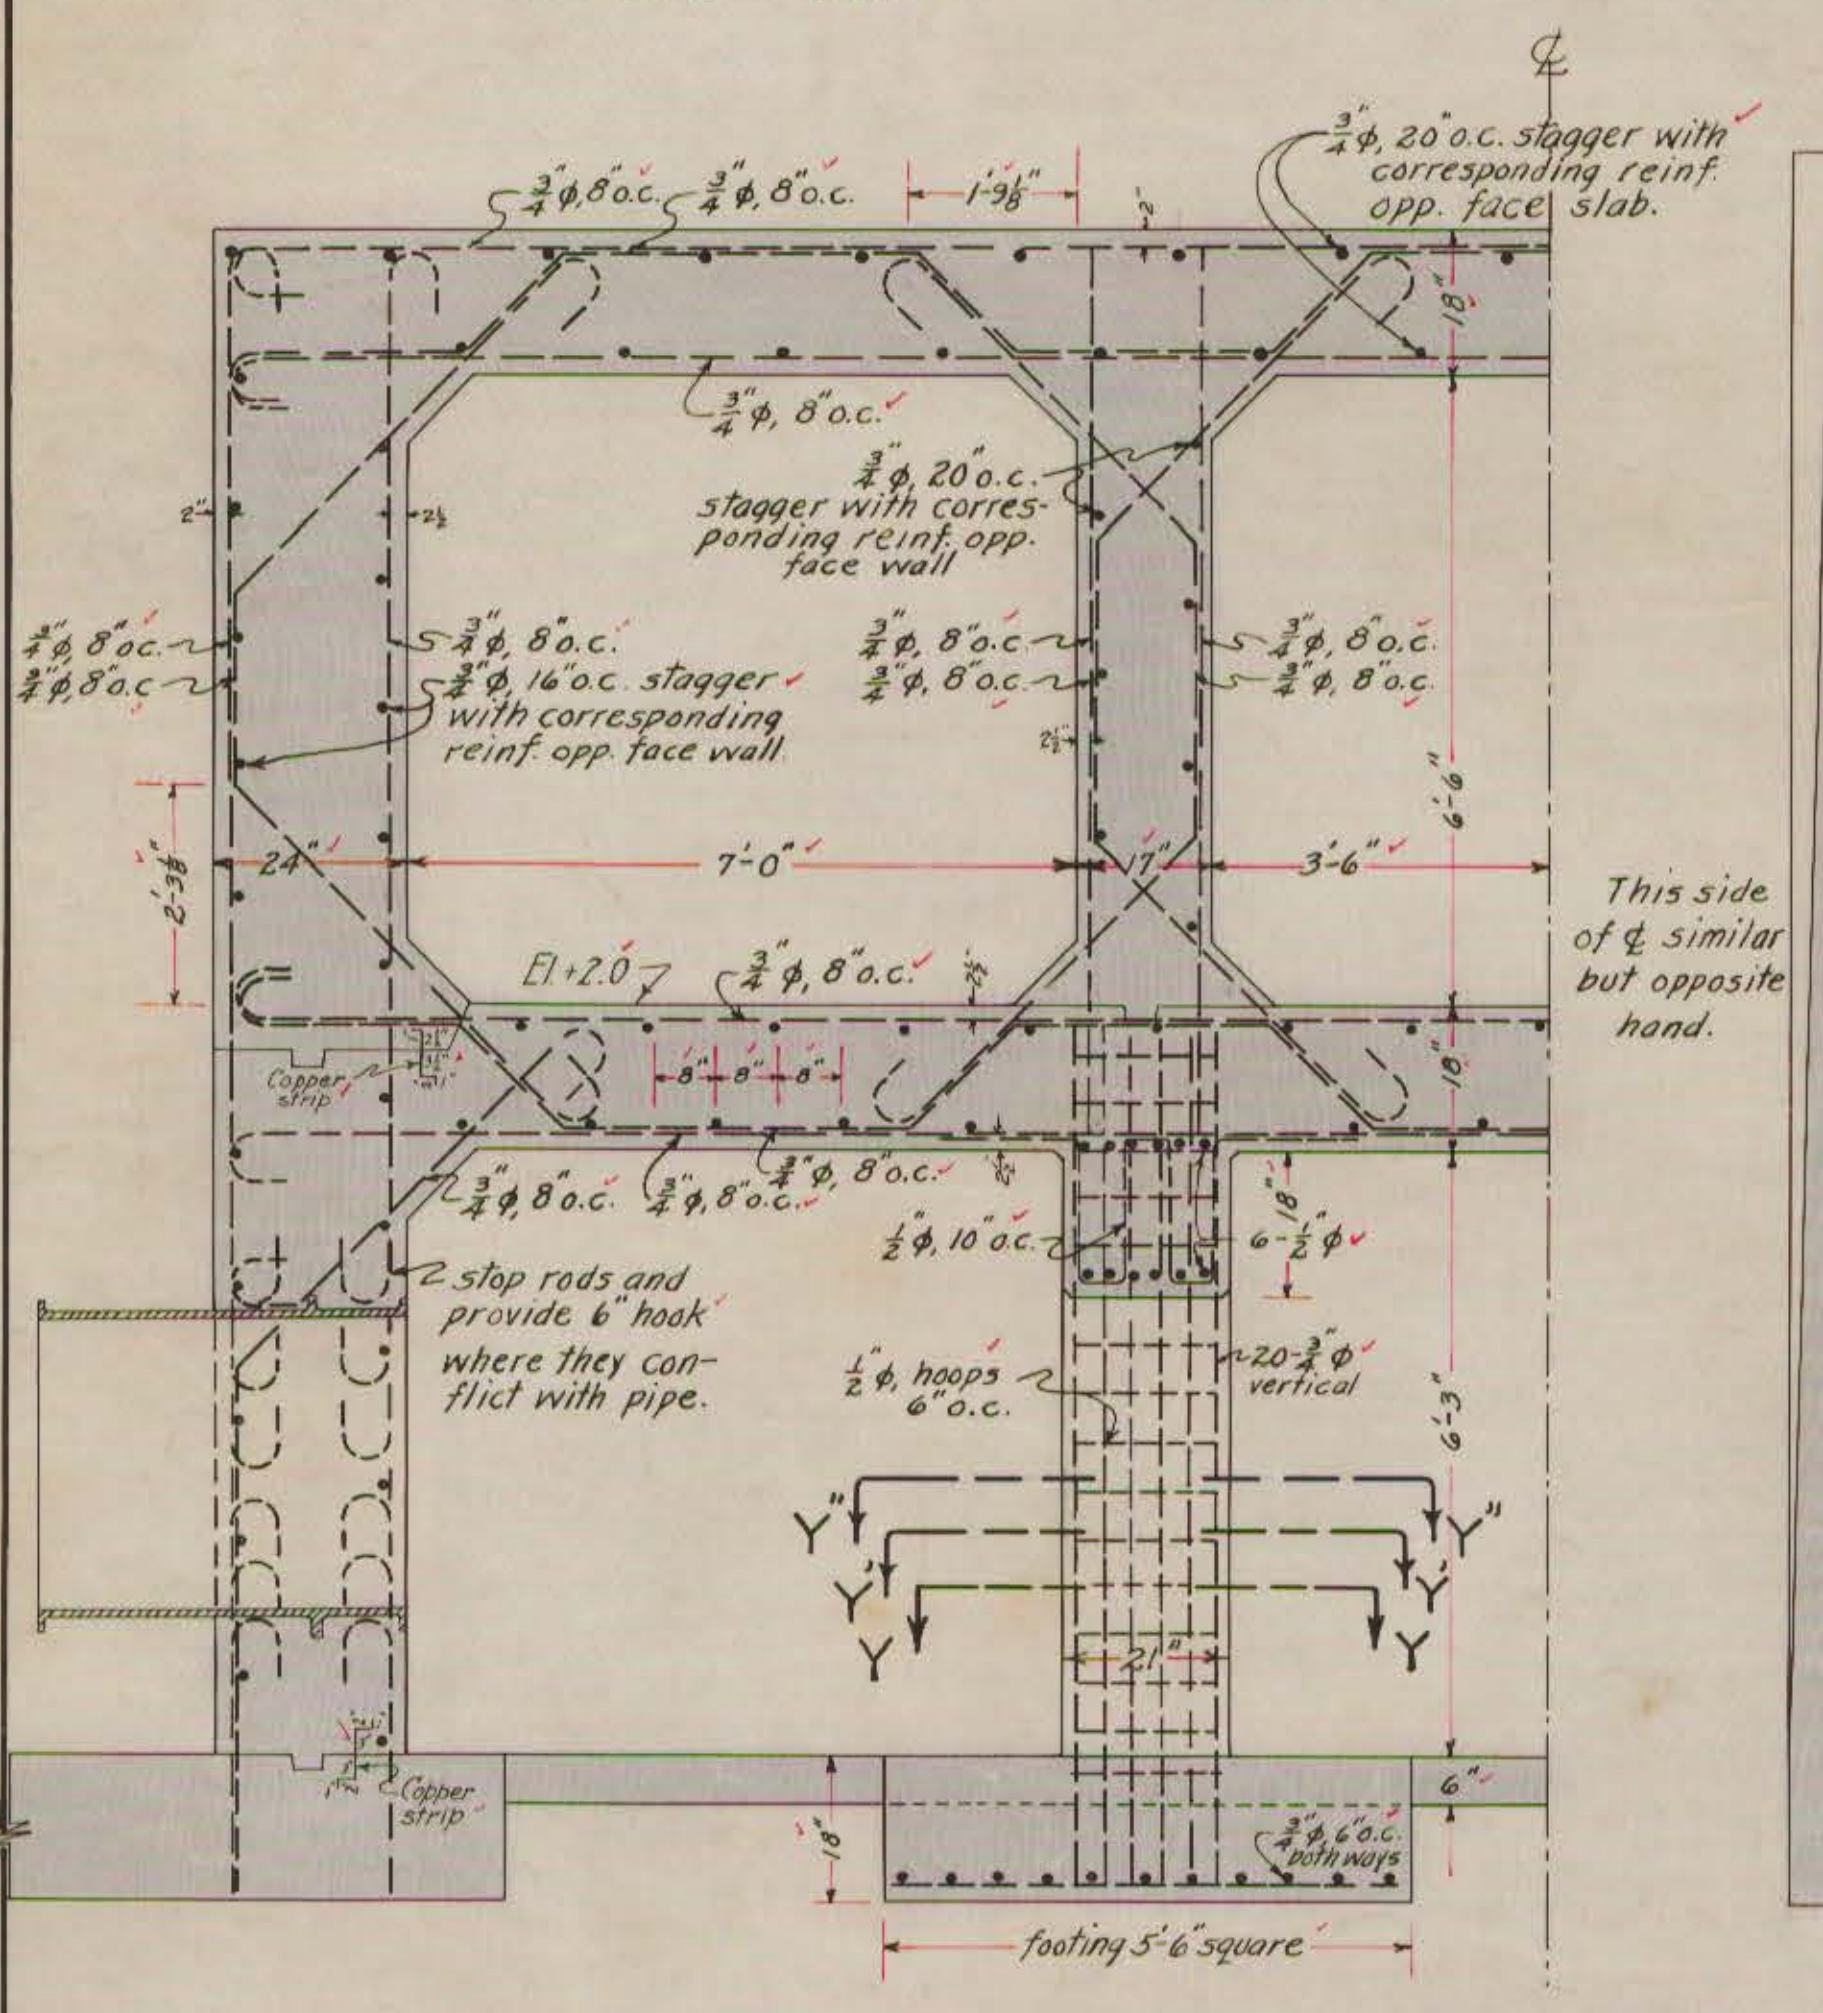
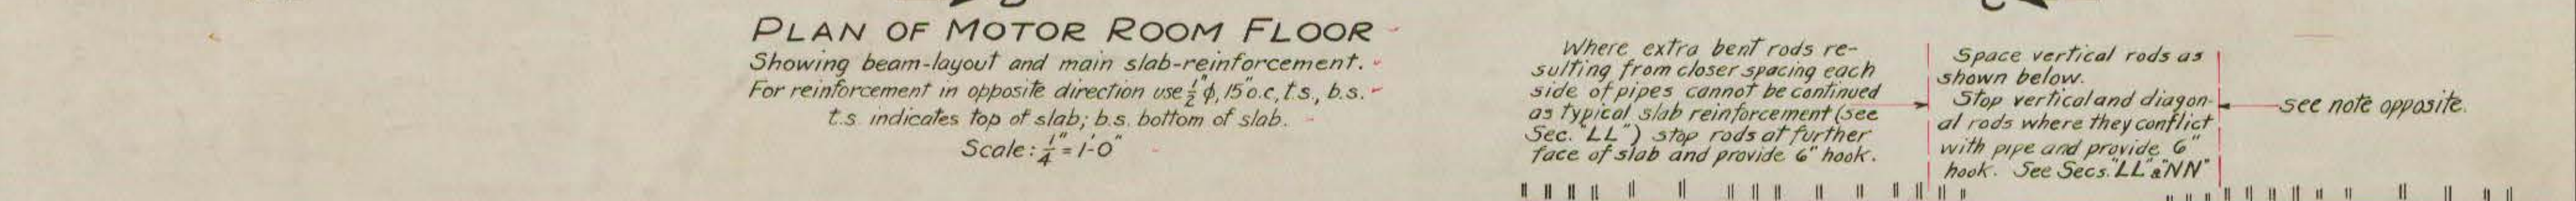
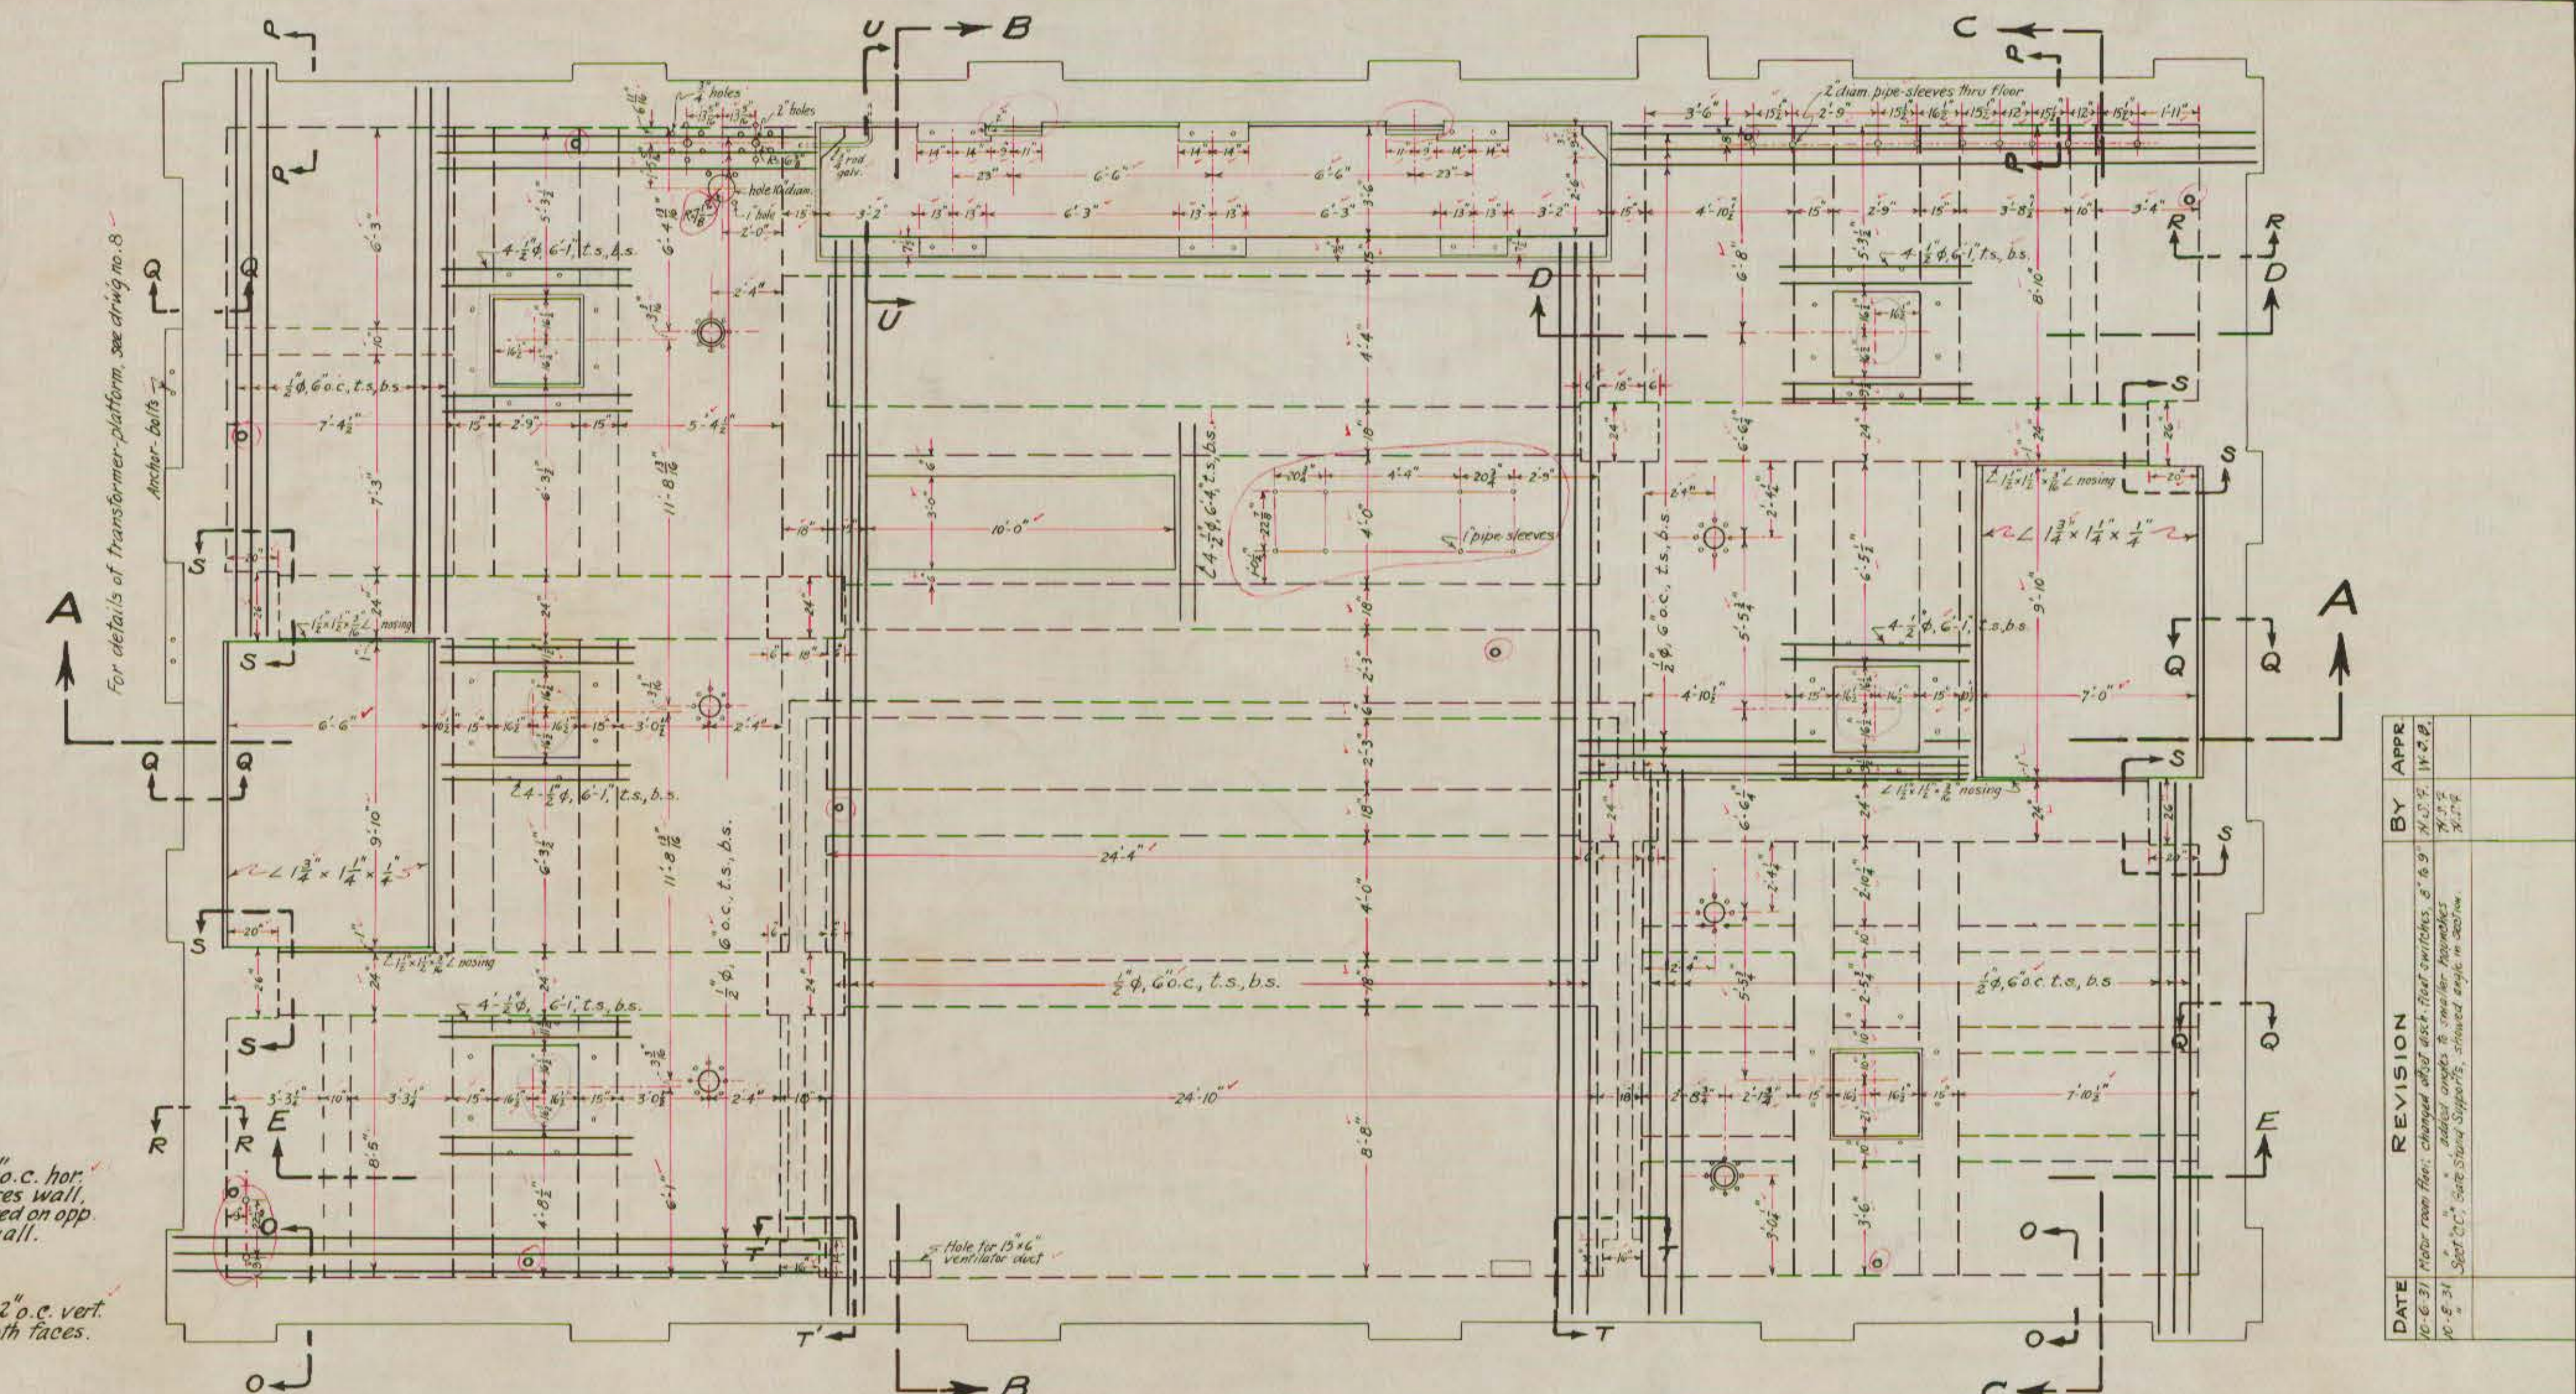
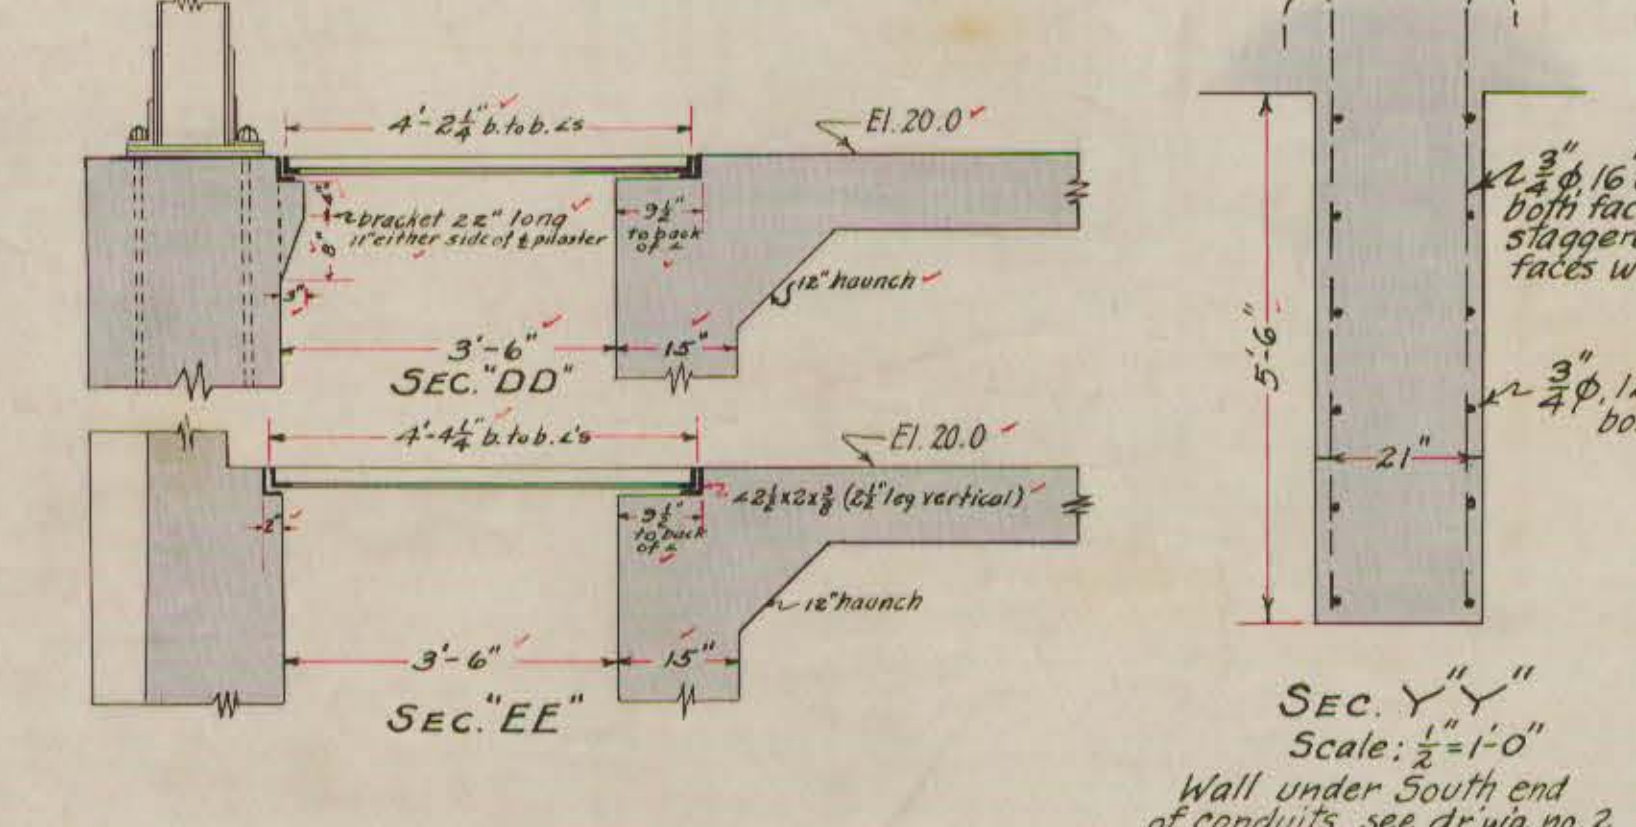
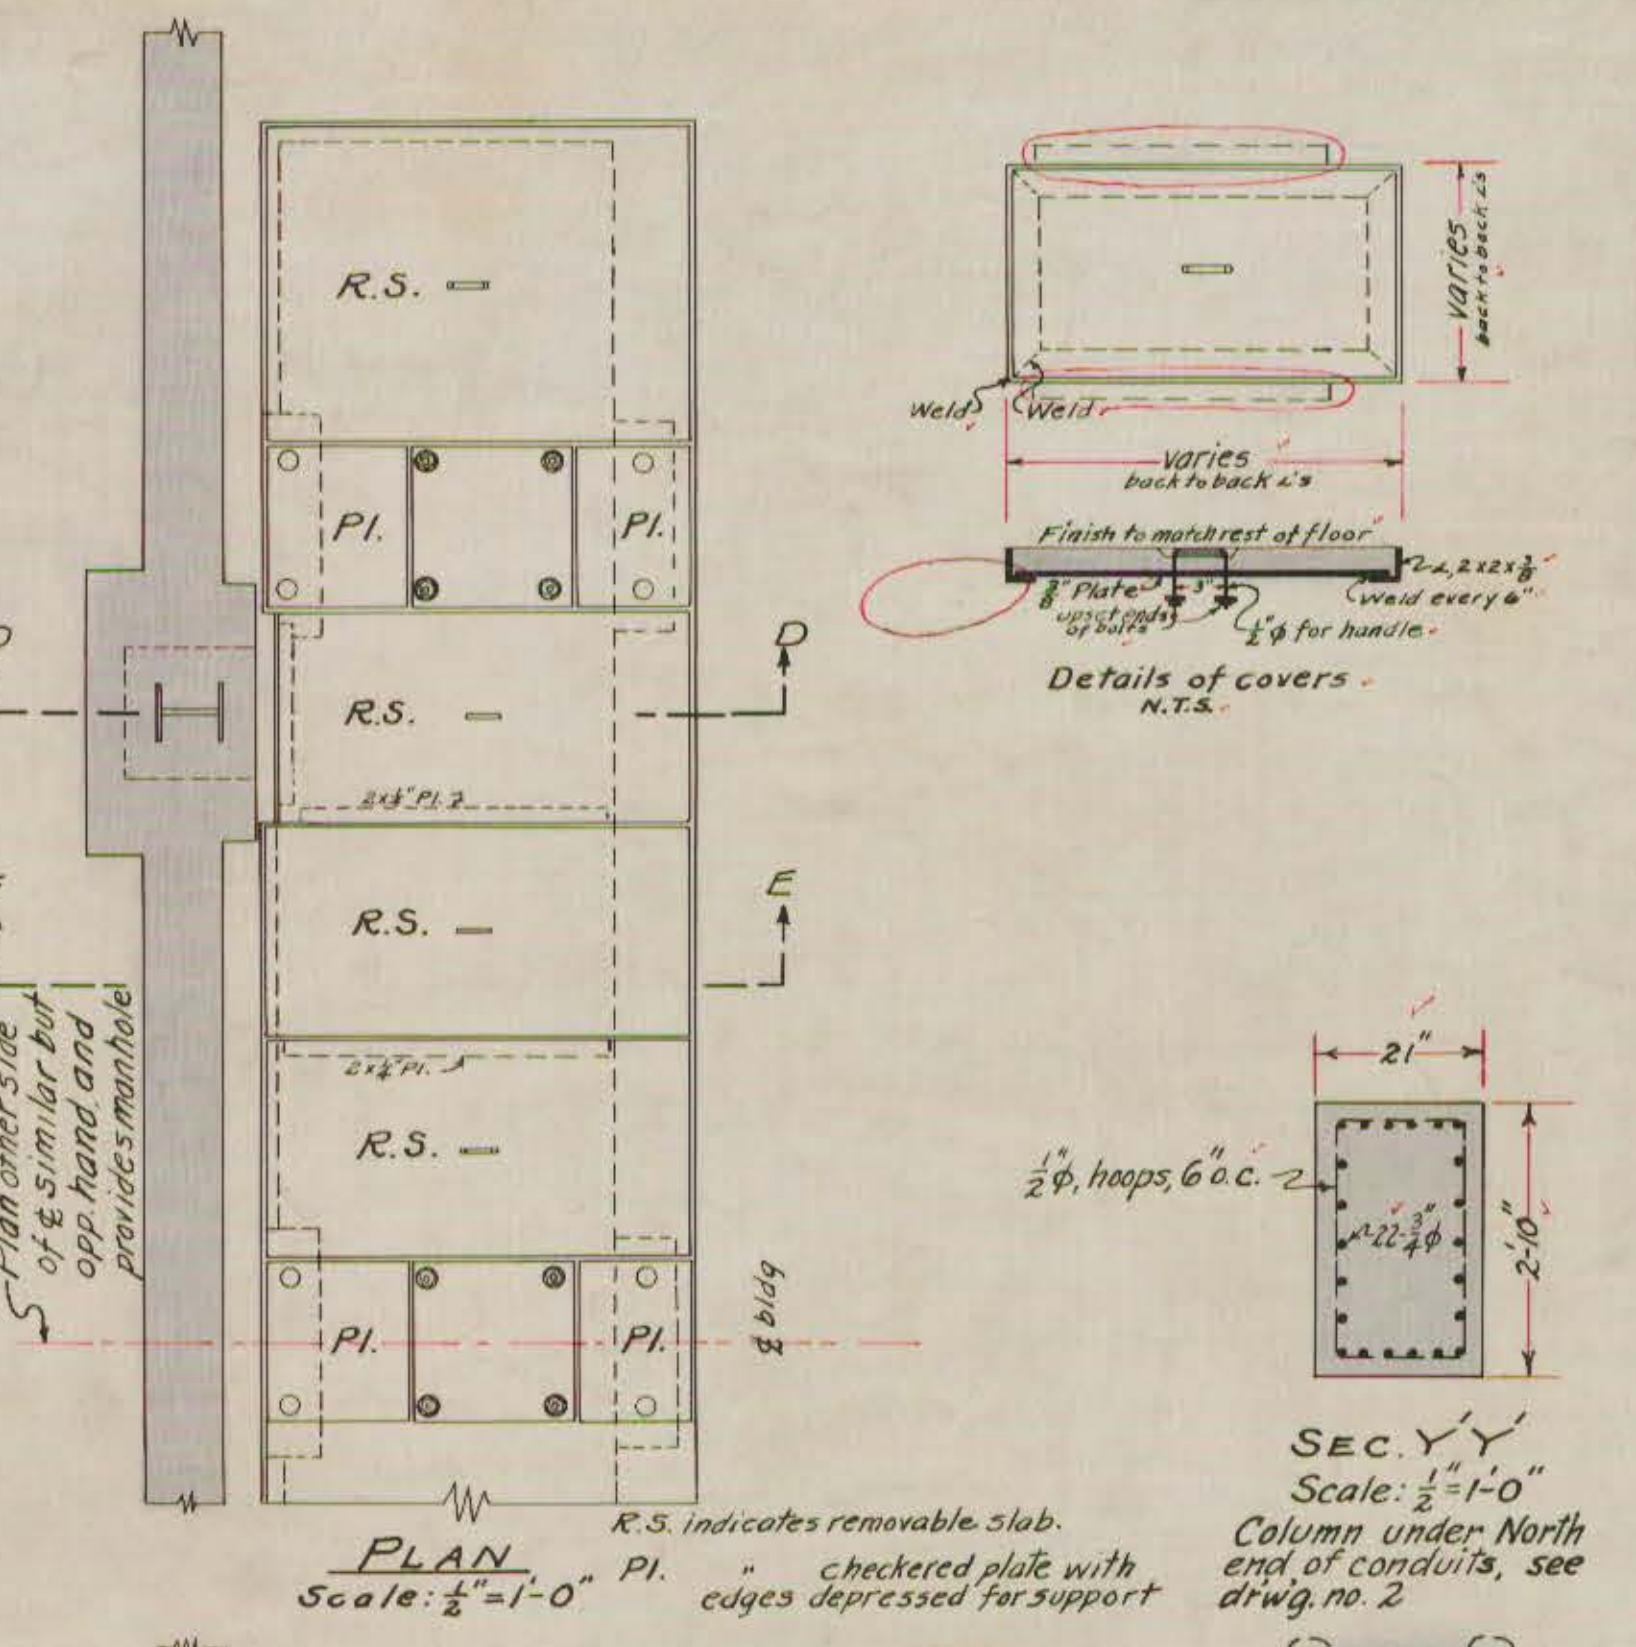
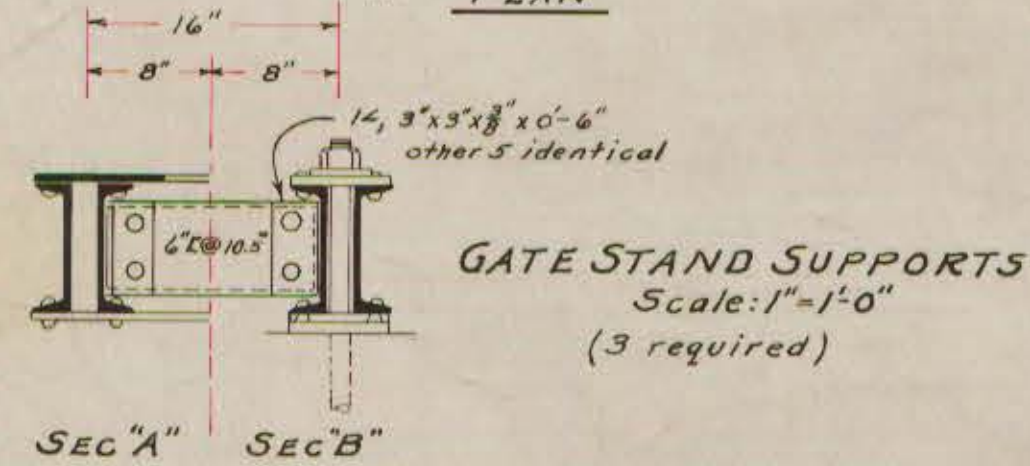
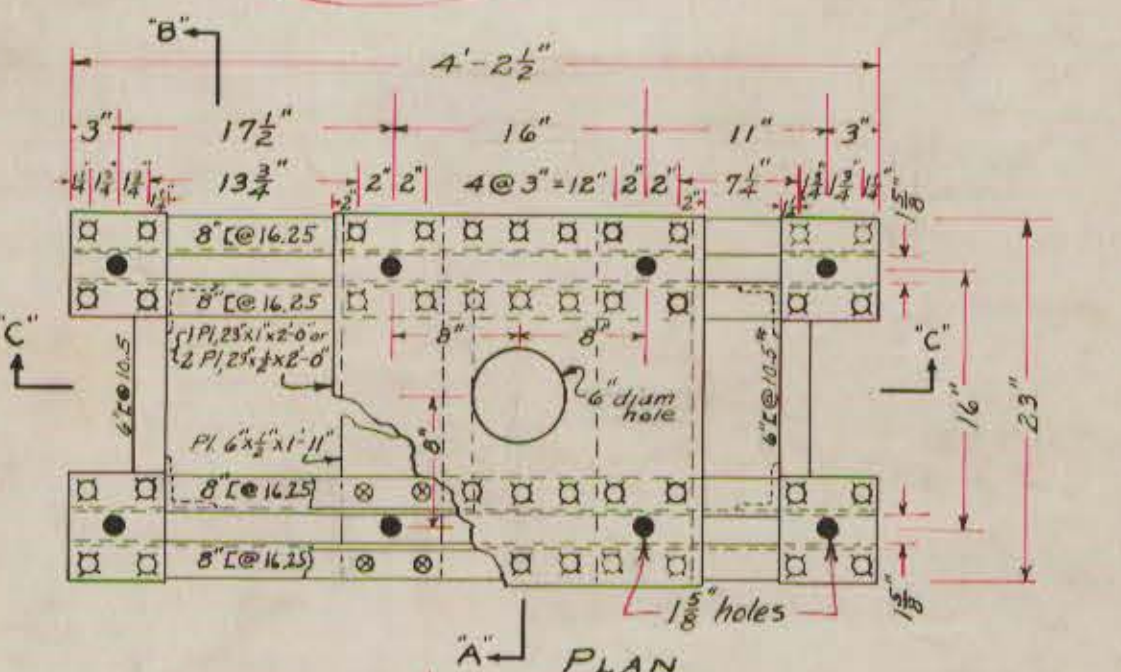


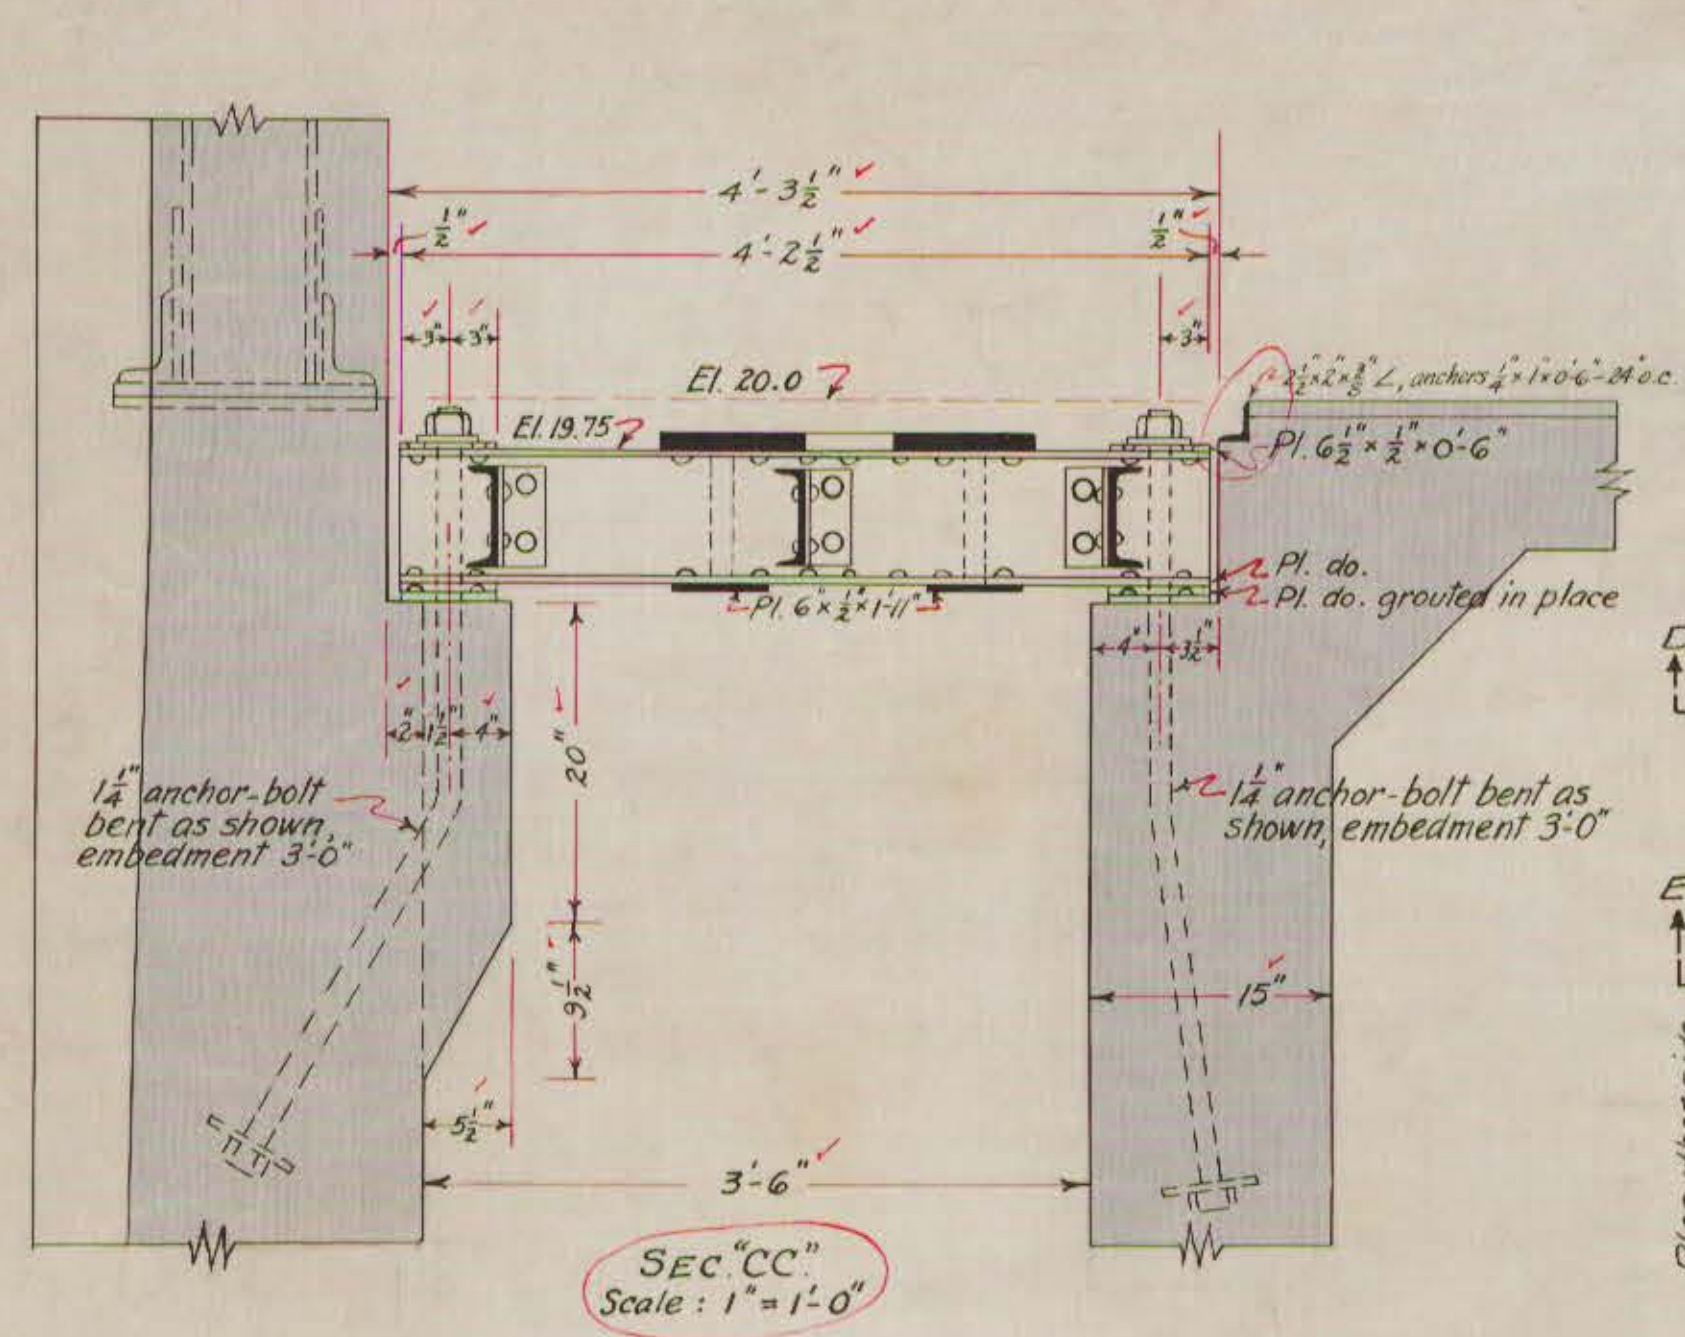

REVISIONS

DATE	REVISIONS	BY	APPR
7-1-31	Plan of Motor Room Floor, added sleeves for float switches, S.W. cor.	N.S.P.	N.S.P.
7-2-31	Gate Stand Supports, added rebar, see CC, scale 1/4"=1'-0" section.	N.S.P.	N.S.P.
7-3-31	Details of Covers, corrected position of 2 1/2" P.I.	N.S.P.	N.S.P.
7-4-31	Plan of Motor Room Floor, changed radius ball circle pump motor base	N.S.P.	N.S.P.
7-5-31	SEC. CC' added section that switch pipe	N.S.P.	N.S.P.
7-6-31	Plan of Motor Room Floor, added radii for pipe sleeves, set and pipe sleeves	N.S.P.	N.S.P.
7-7-31	Plan of Motor Room Floor, added dimensions to exciter anchor bolt pipe sleeve	N.S.P.	N.S.P.
8-19-31	Plan of Motor Room Floor, changed radius ball circle pump motor base & 7 1/2"	N.S.P.	N.S.P.

See tabulation on right-hand border of this drawing.

CITY OF HARTFORD
DEPARTMENT OF ENGINEERING
SOUTH MEADOWS
PUMPING STATION
MOTOR ROOM FLOOR AND
INTERIOR CONDUIT DETAILS
MAY 29, 1931
SCALE: AS NOTED
MADE: W.B.M. N.S.P. APPROVED: DAYBOOK NO.
CHECKED: W.B.M. N.S.P. 06956