
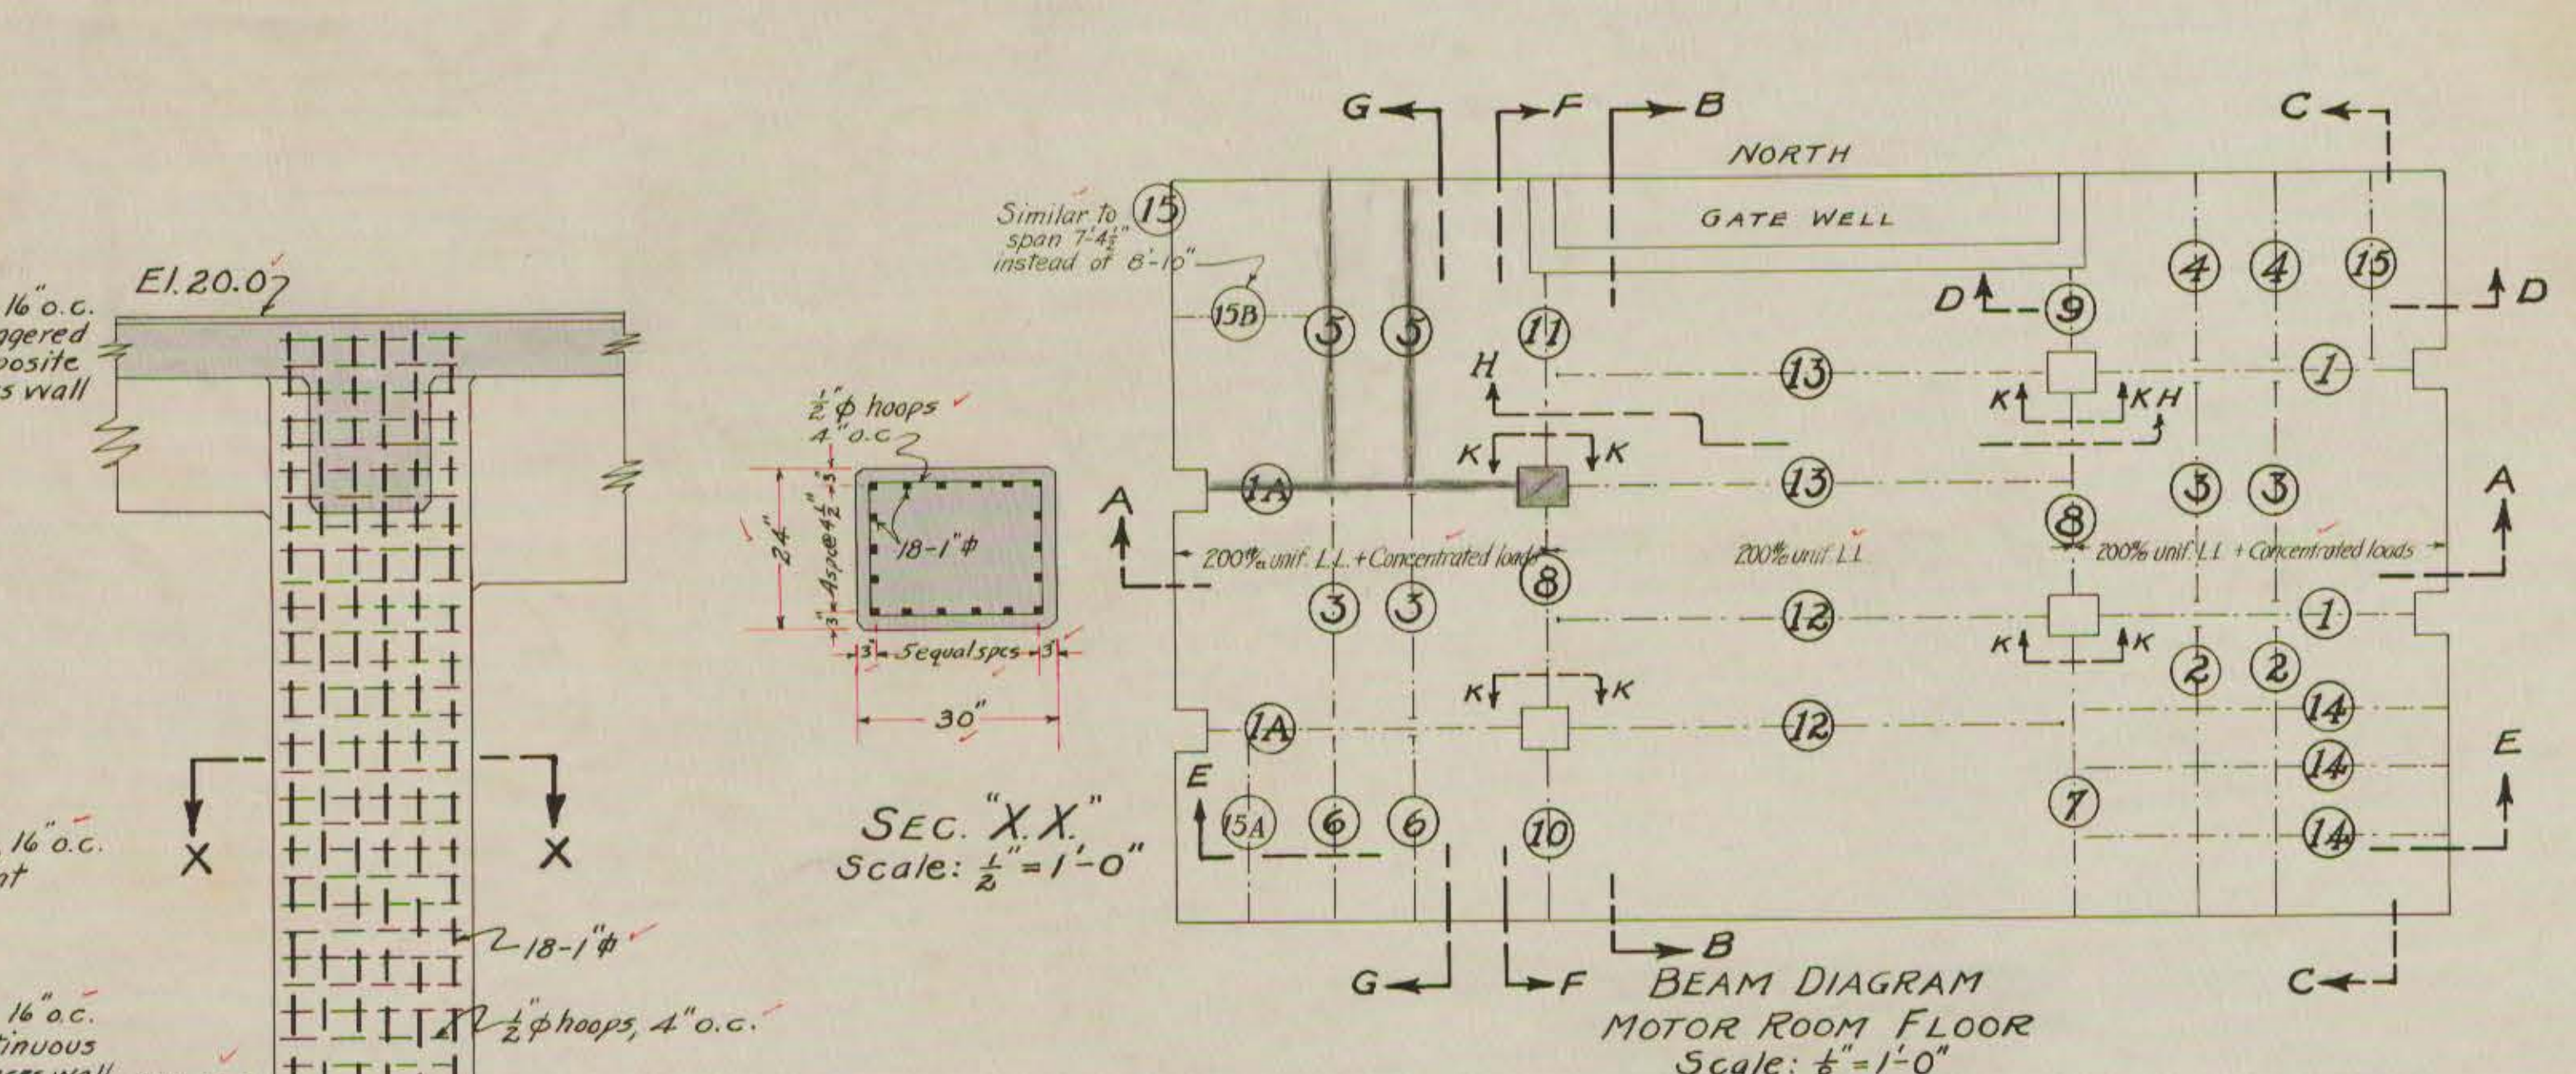
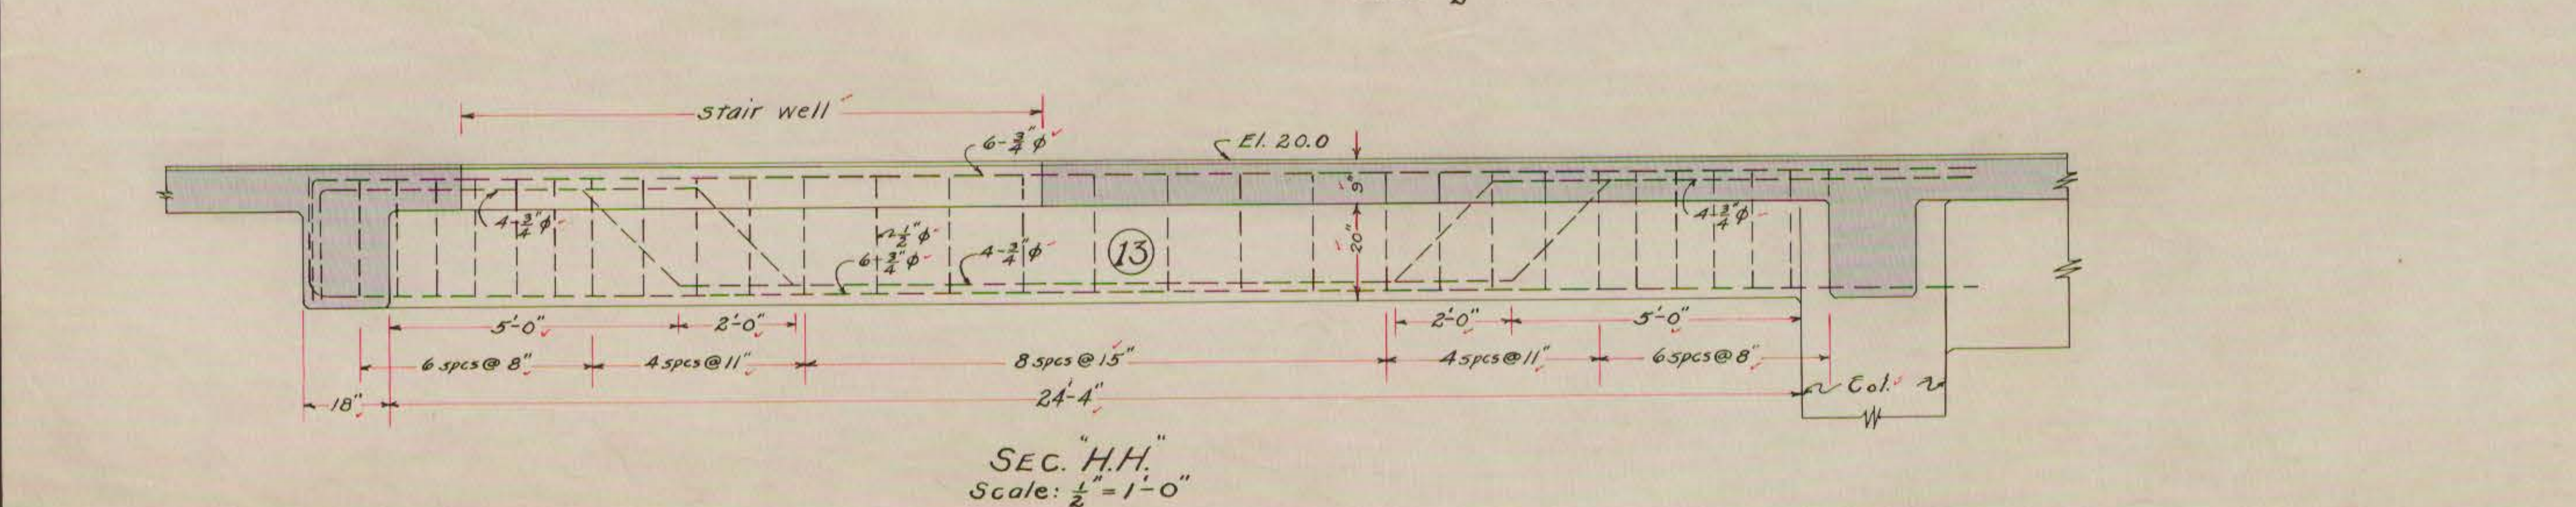
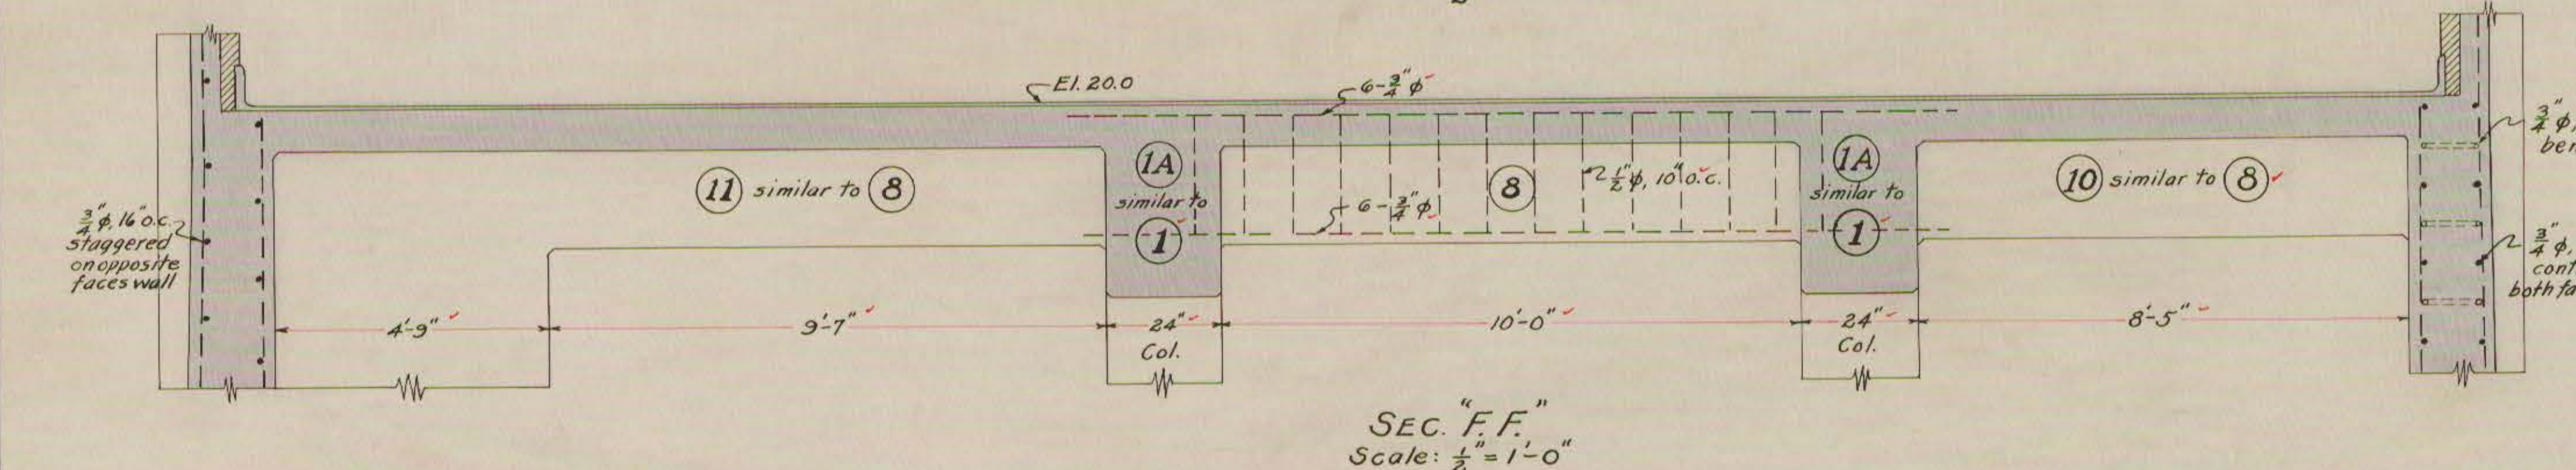
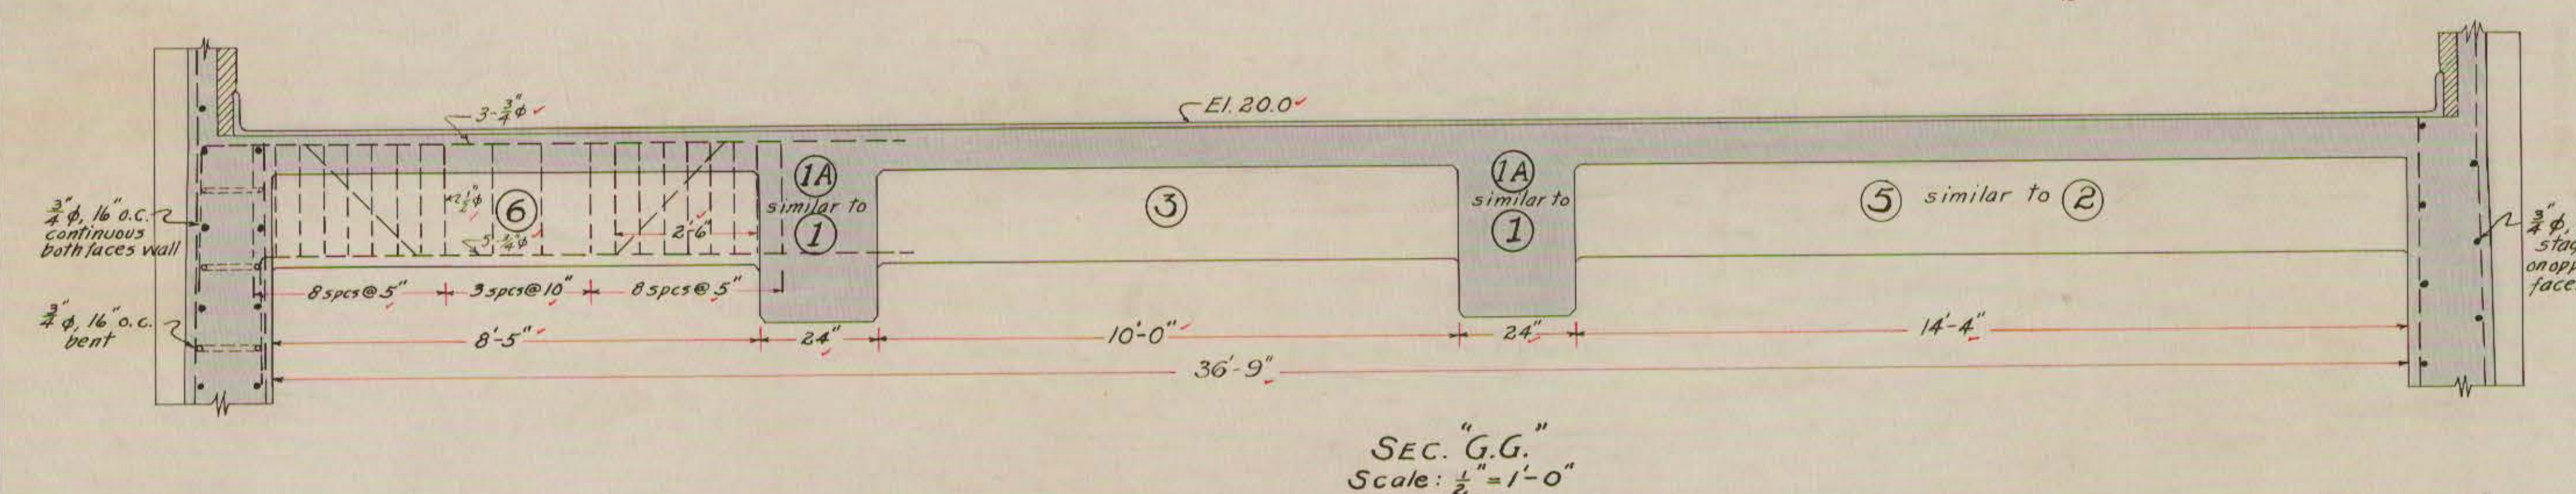
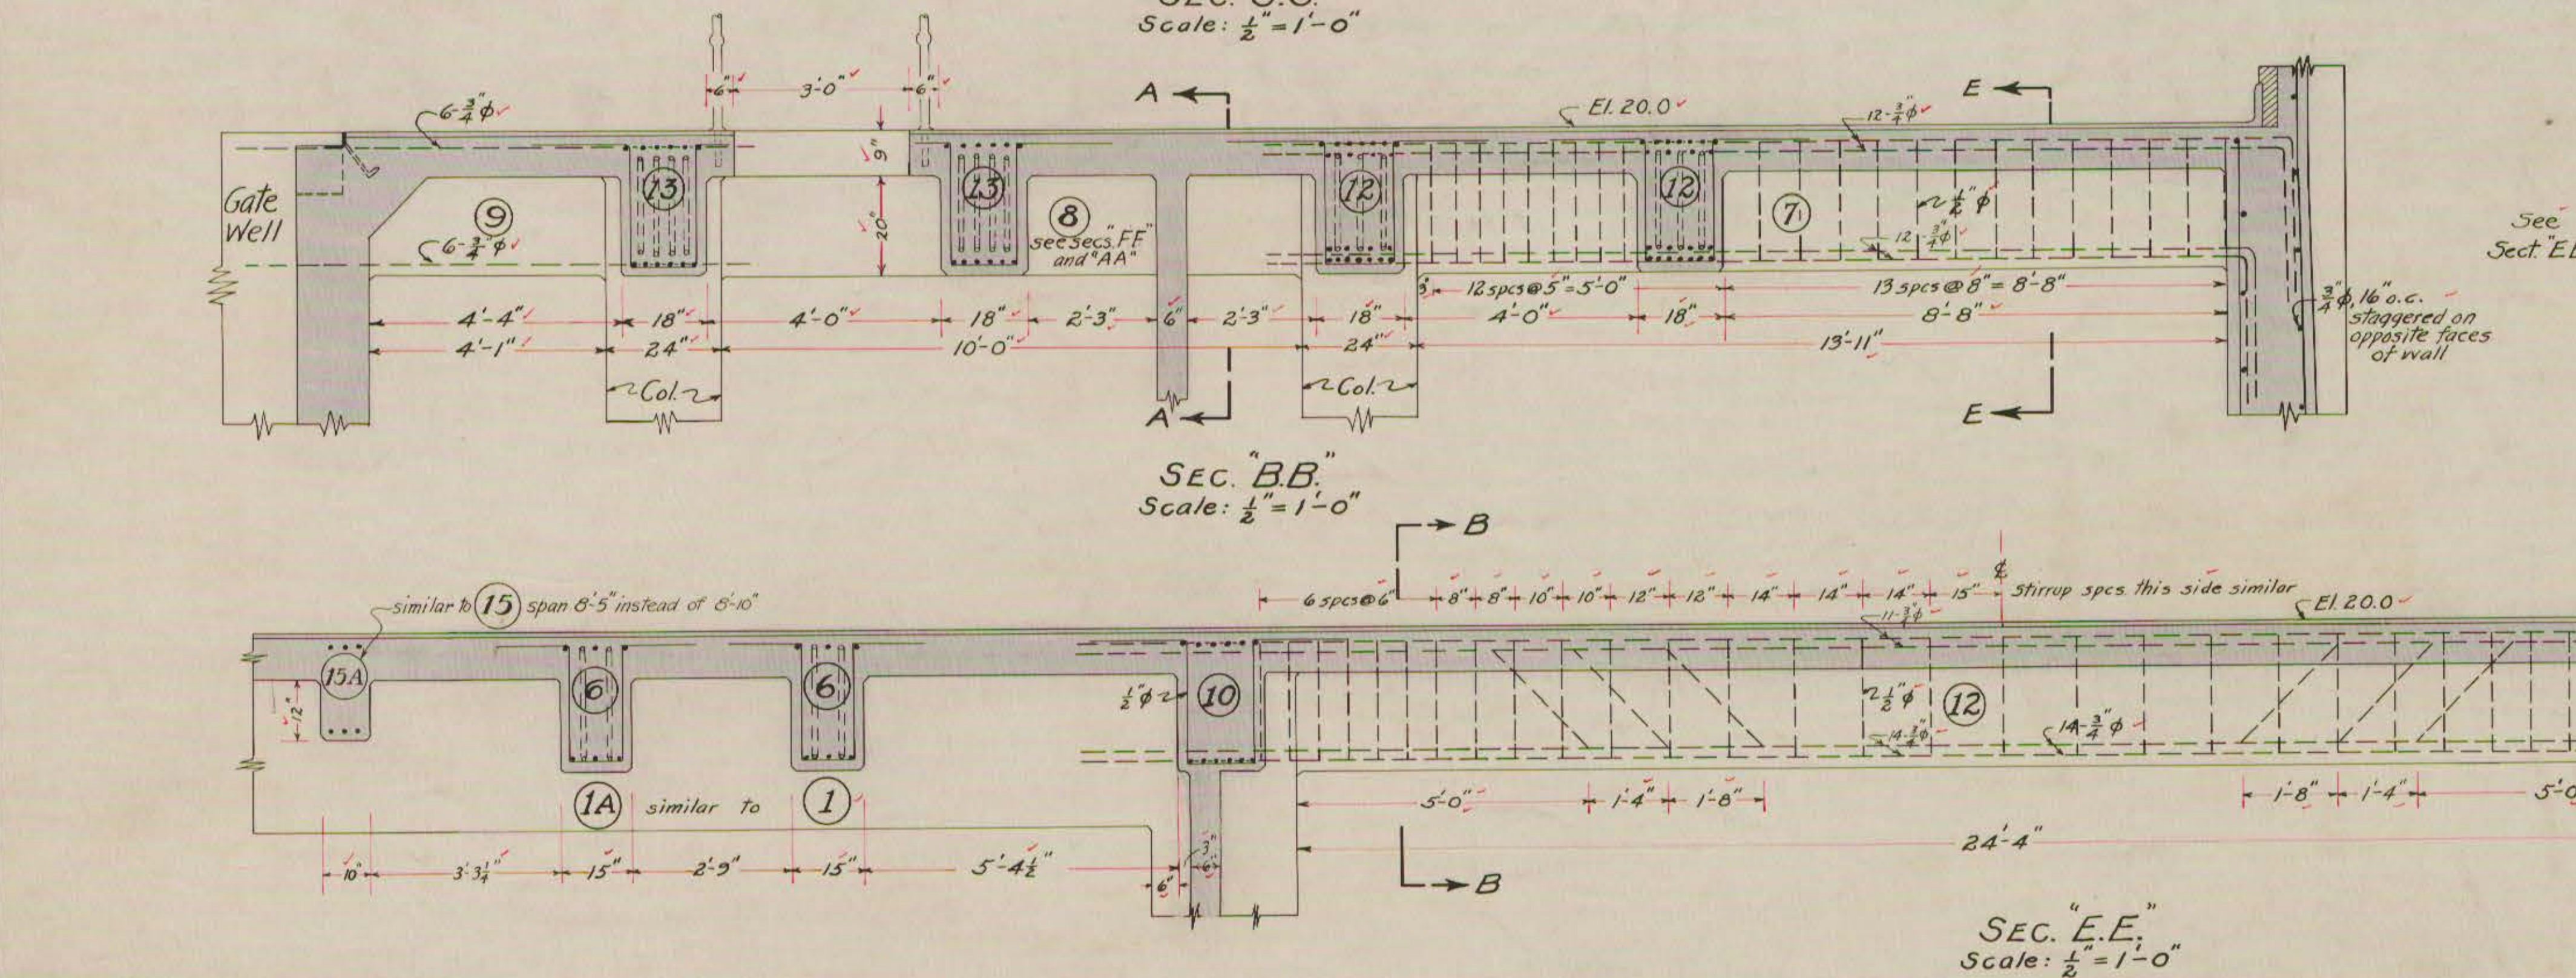
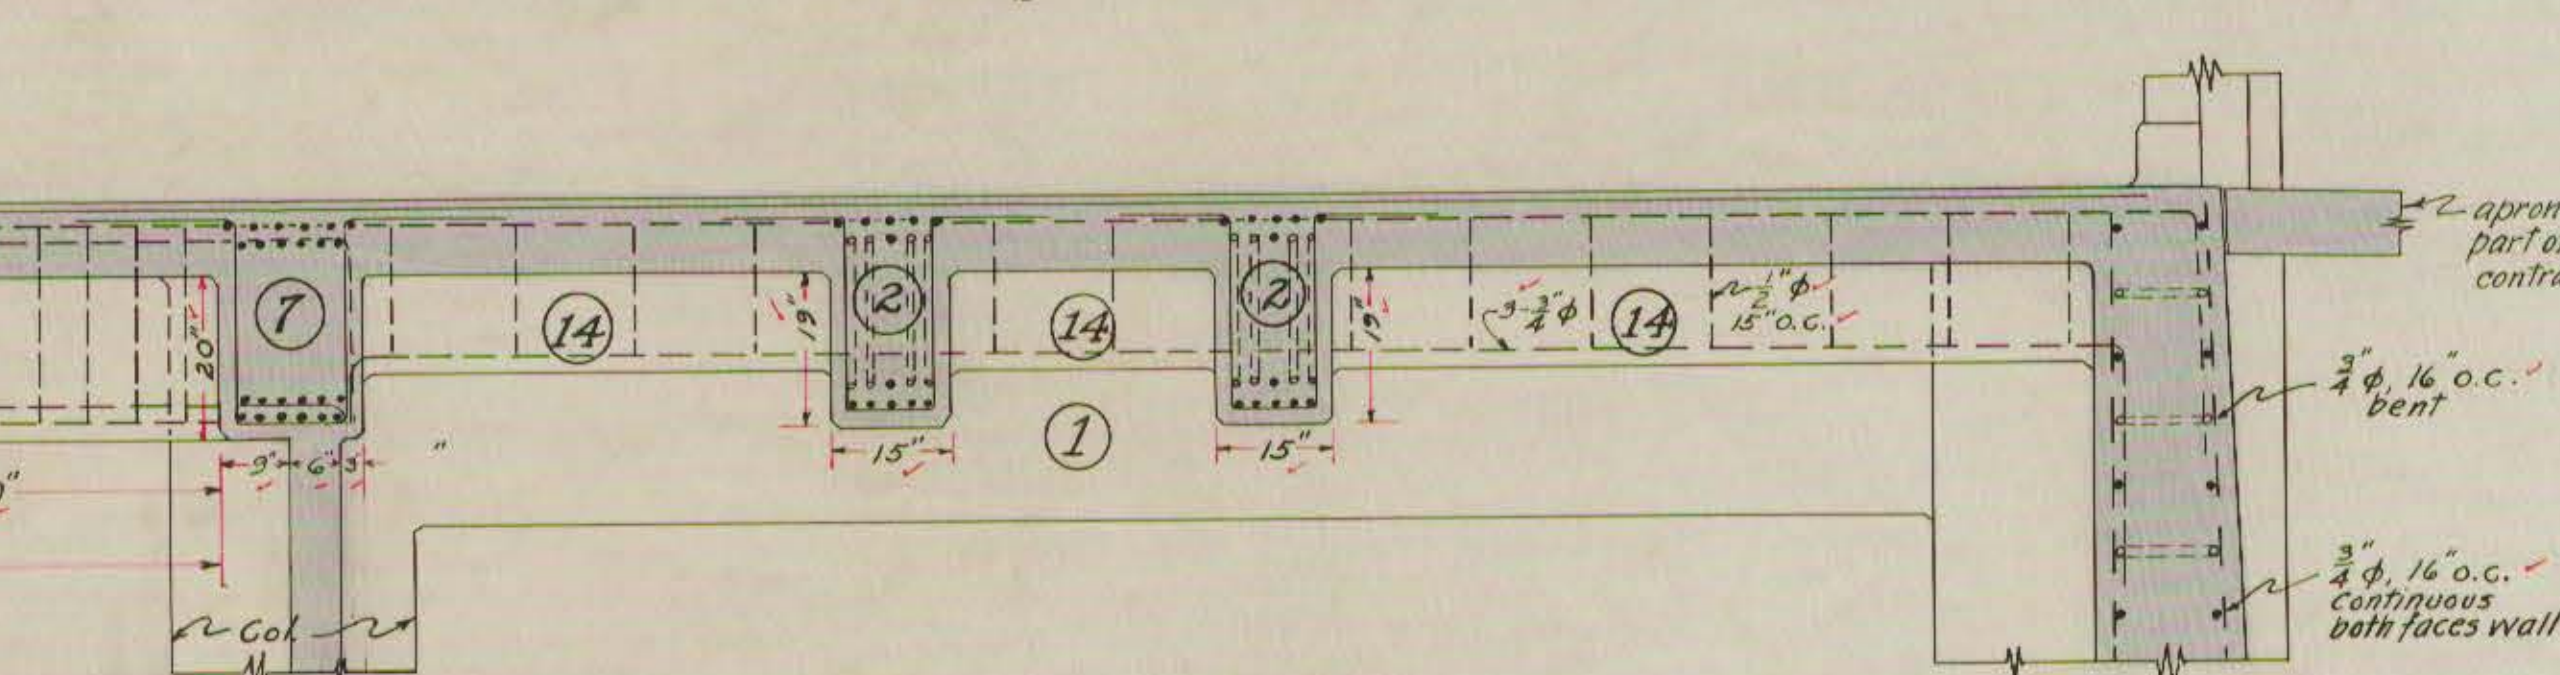
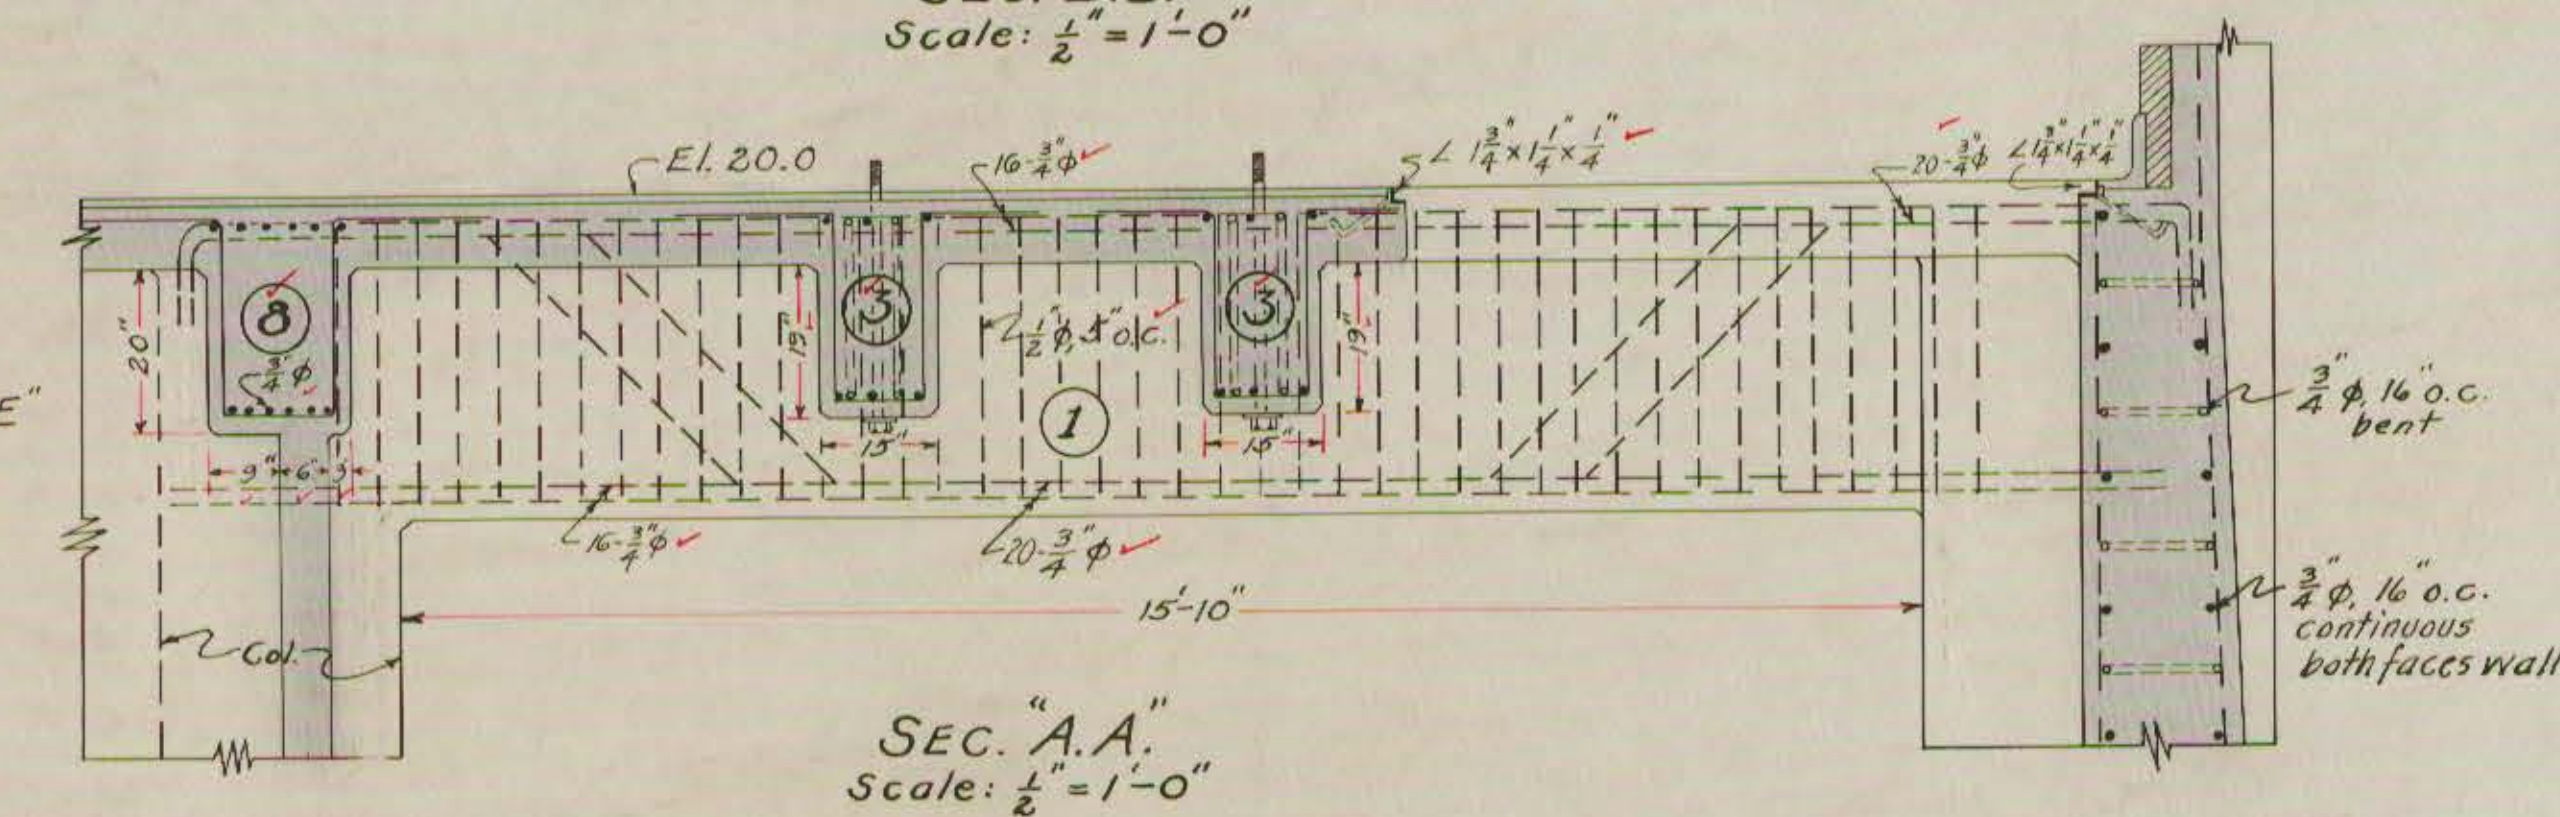


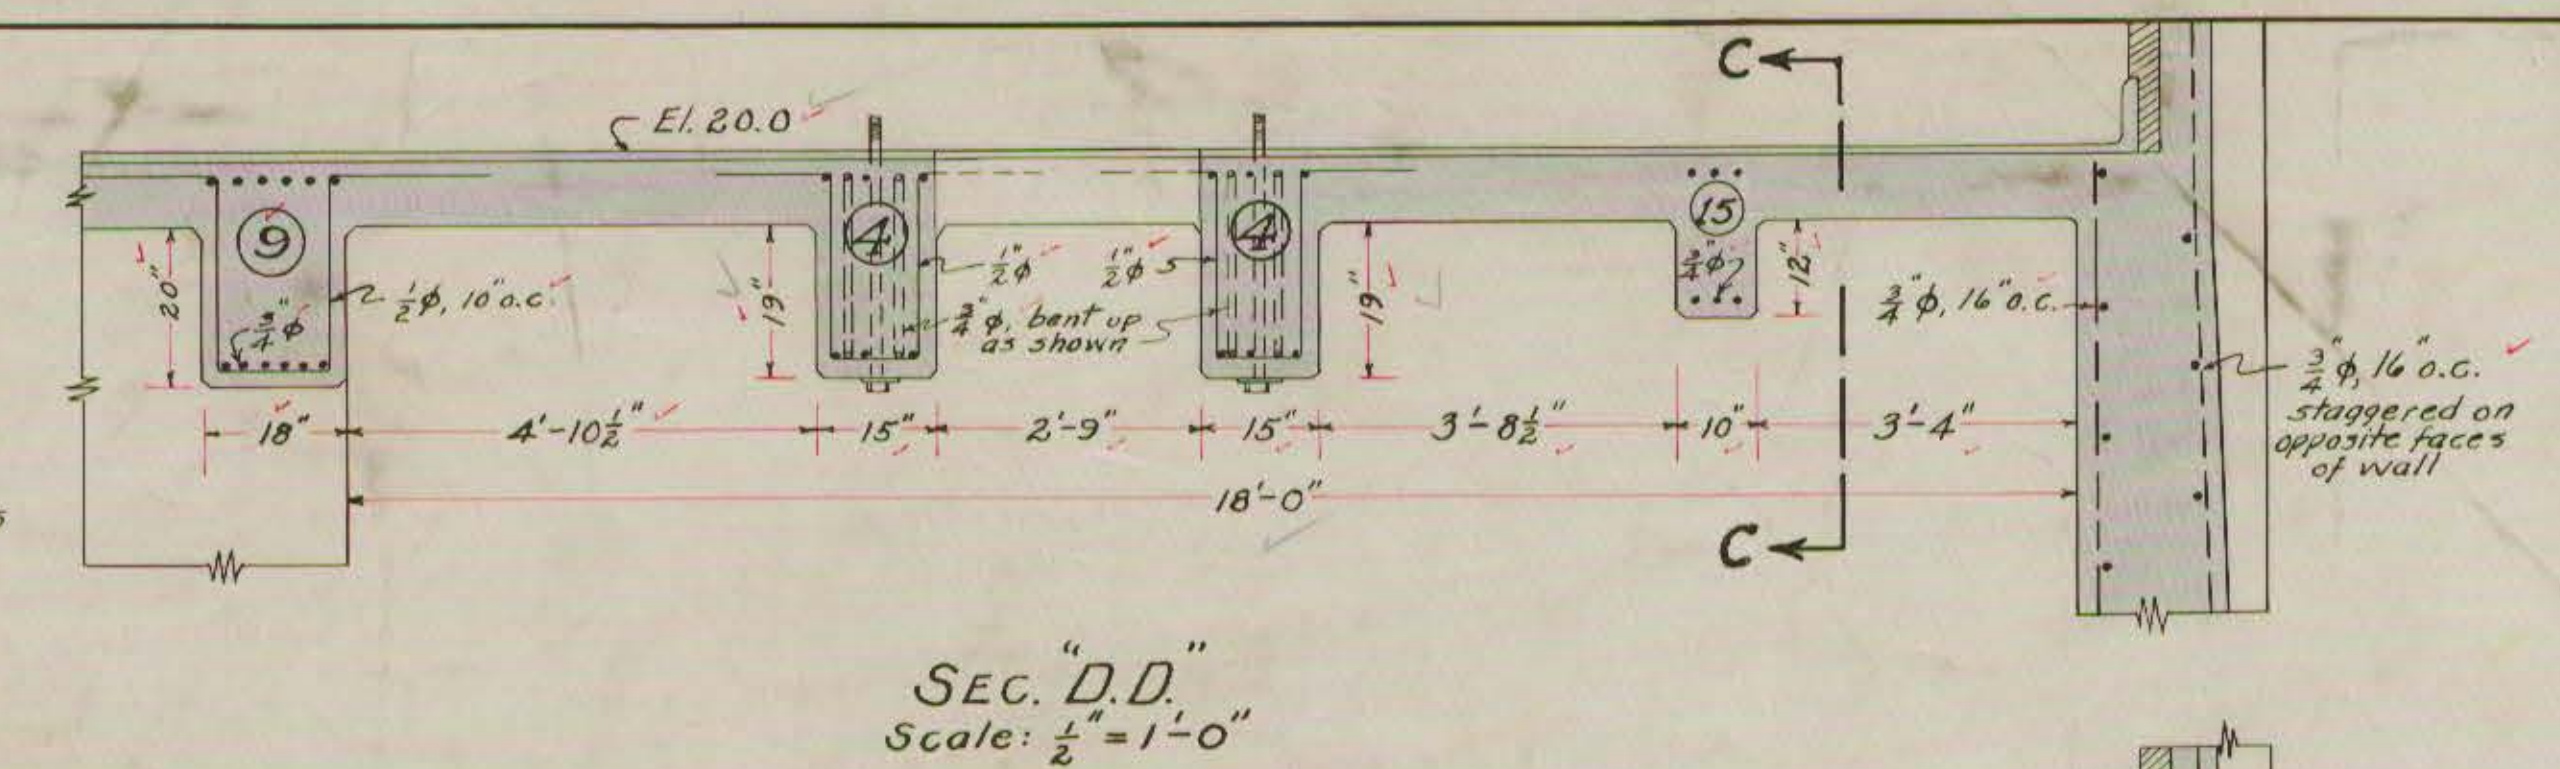

NOTE:
 Floor slab consists of 5" concrete plus 1" granolithic finish.
 For slab reinforcing see dw'g no. 6
 For anchor bolt and insert layout see mfr's dw'gs.
 Center of rads to be not less than 2" from surface.
 Splices to be lapped not less than 40 diameters
 All corners to be beveled $\frac{3}{4}$ "
 Concrete mix 1:2:4 unless otherwise specified
 Upper ends of all stirrups to extend 1'-8" horizontally
 No. 4 shall extend across top of beam if no main slab reinf. present
 No construction joints permitted unless approved by the Engineer.