

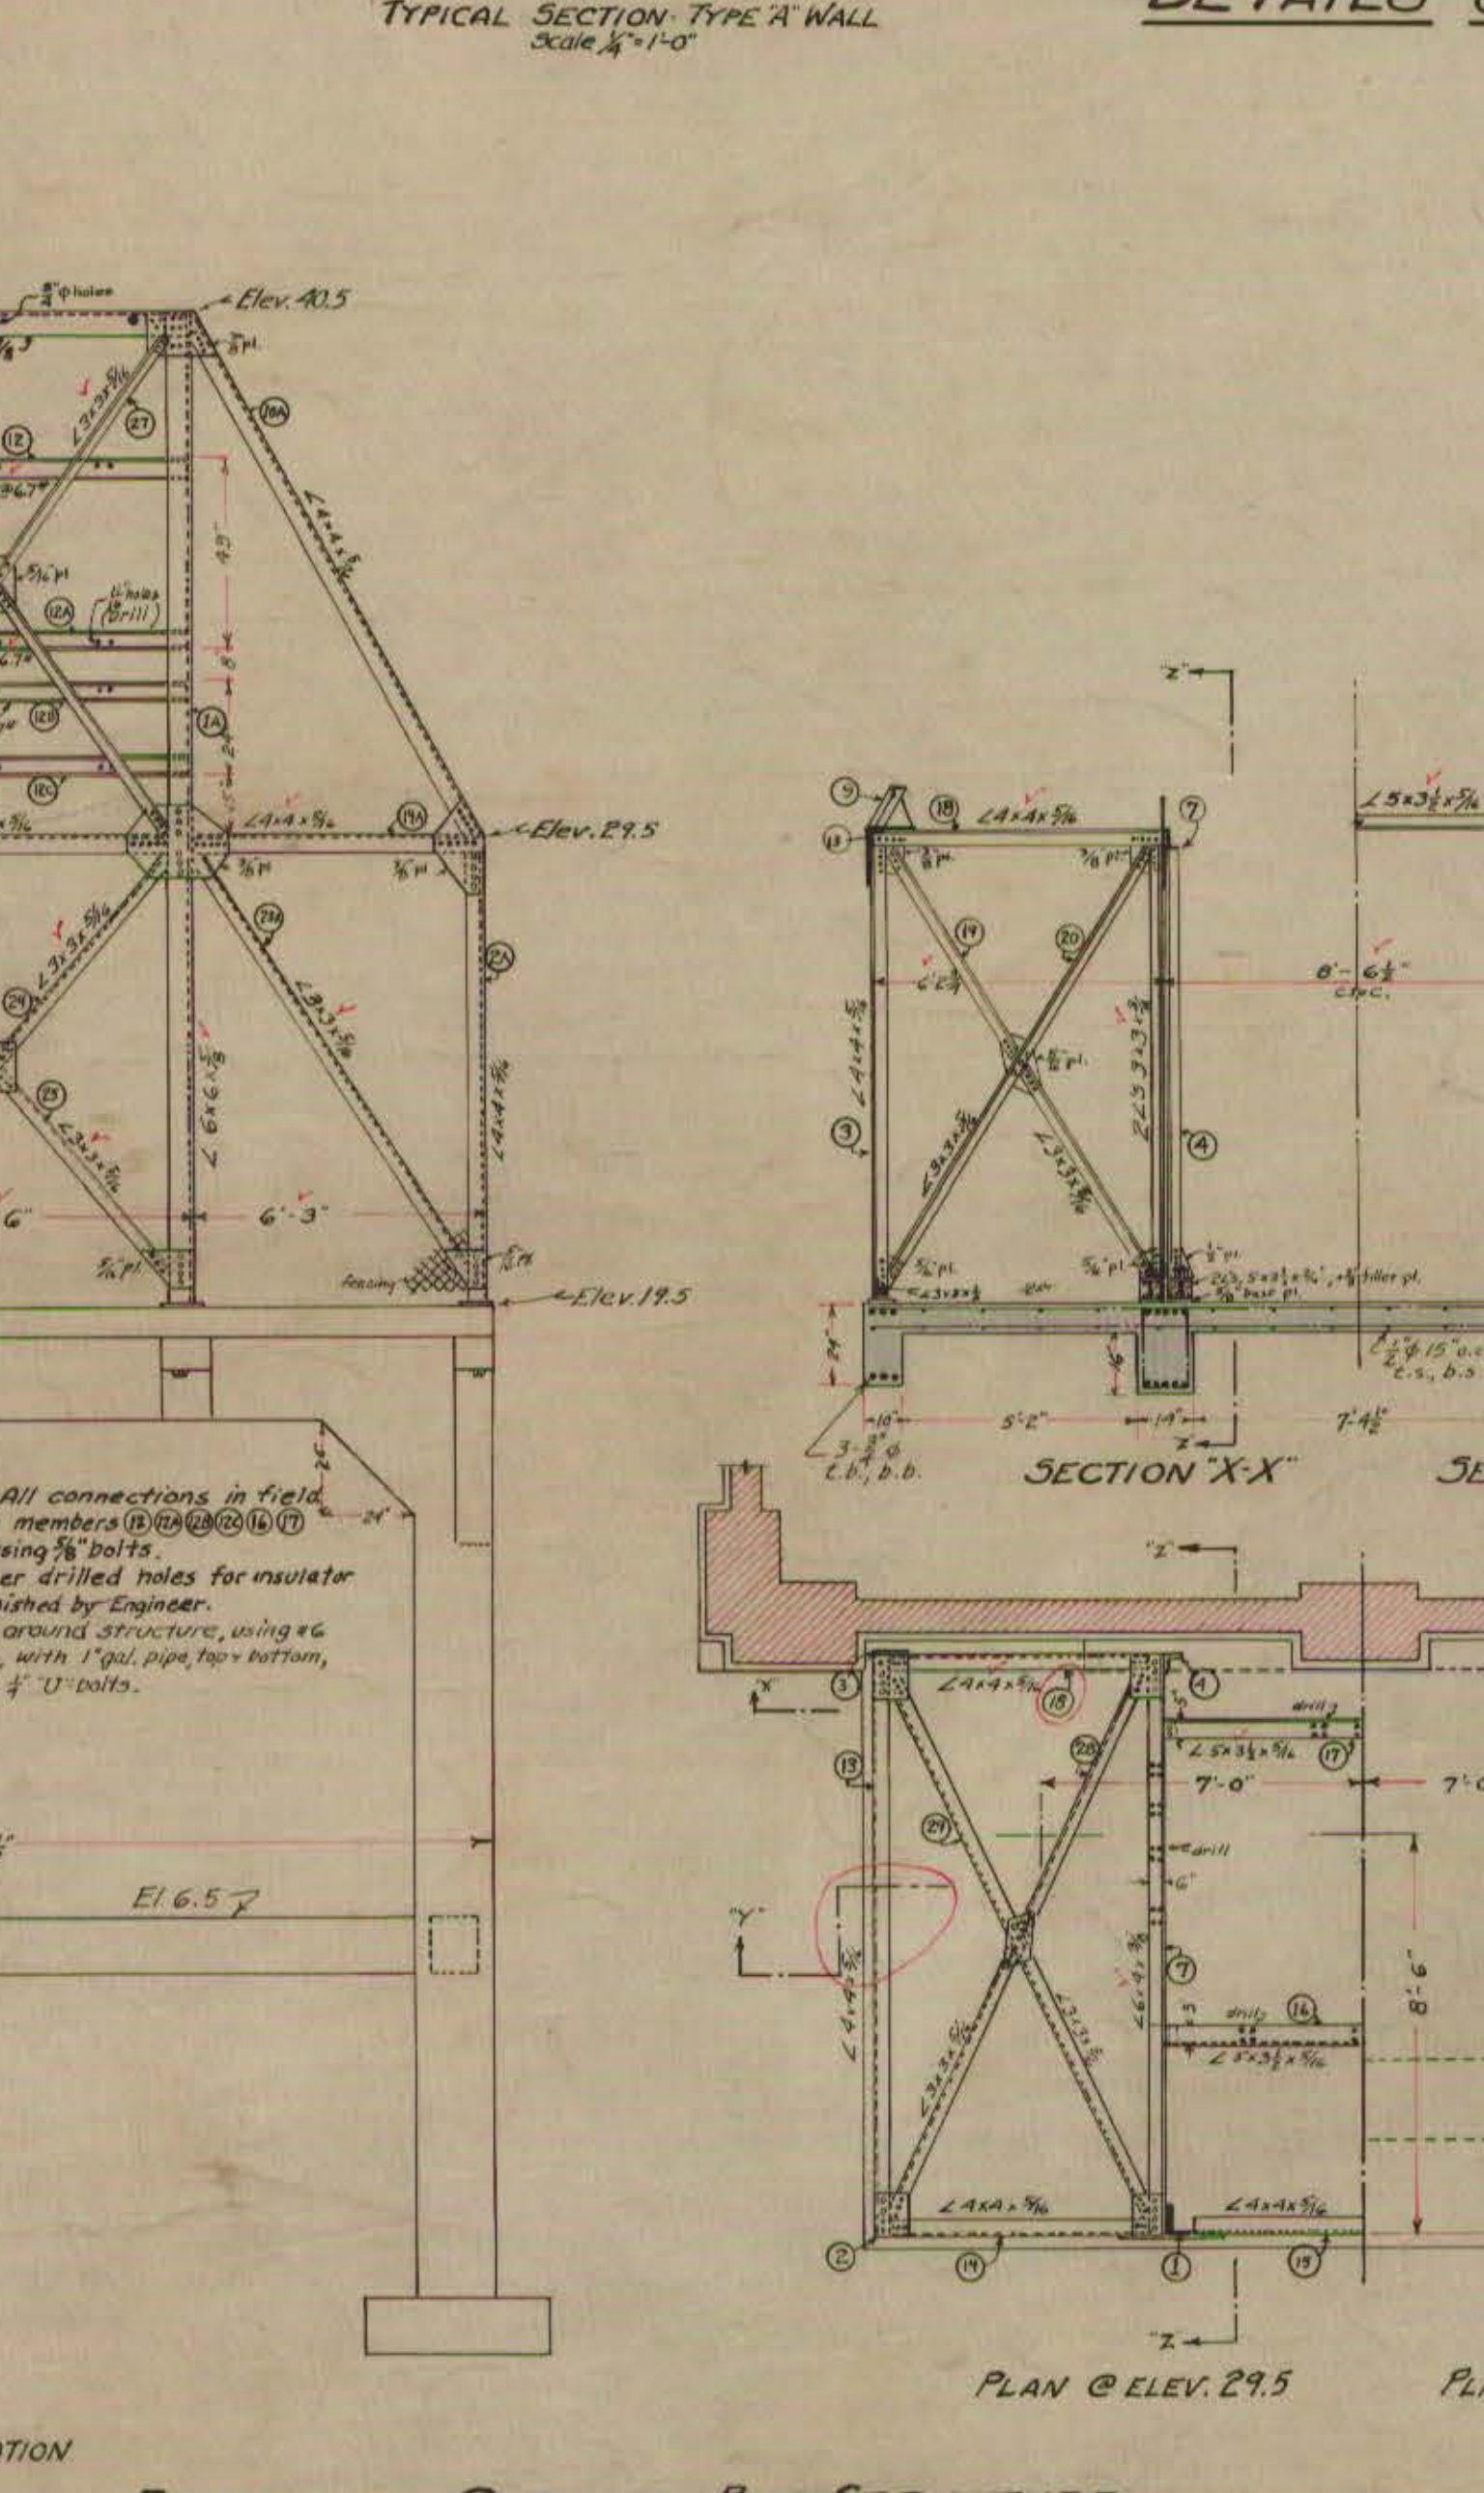
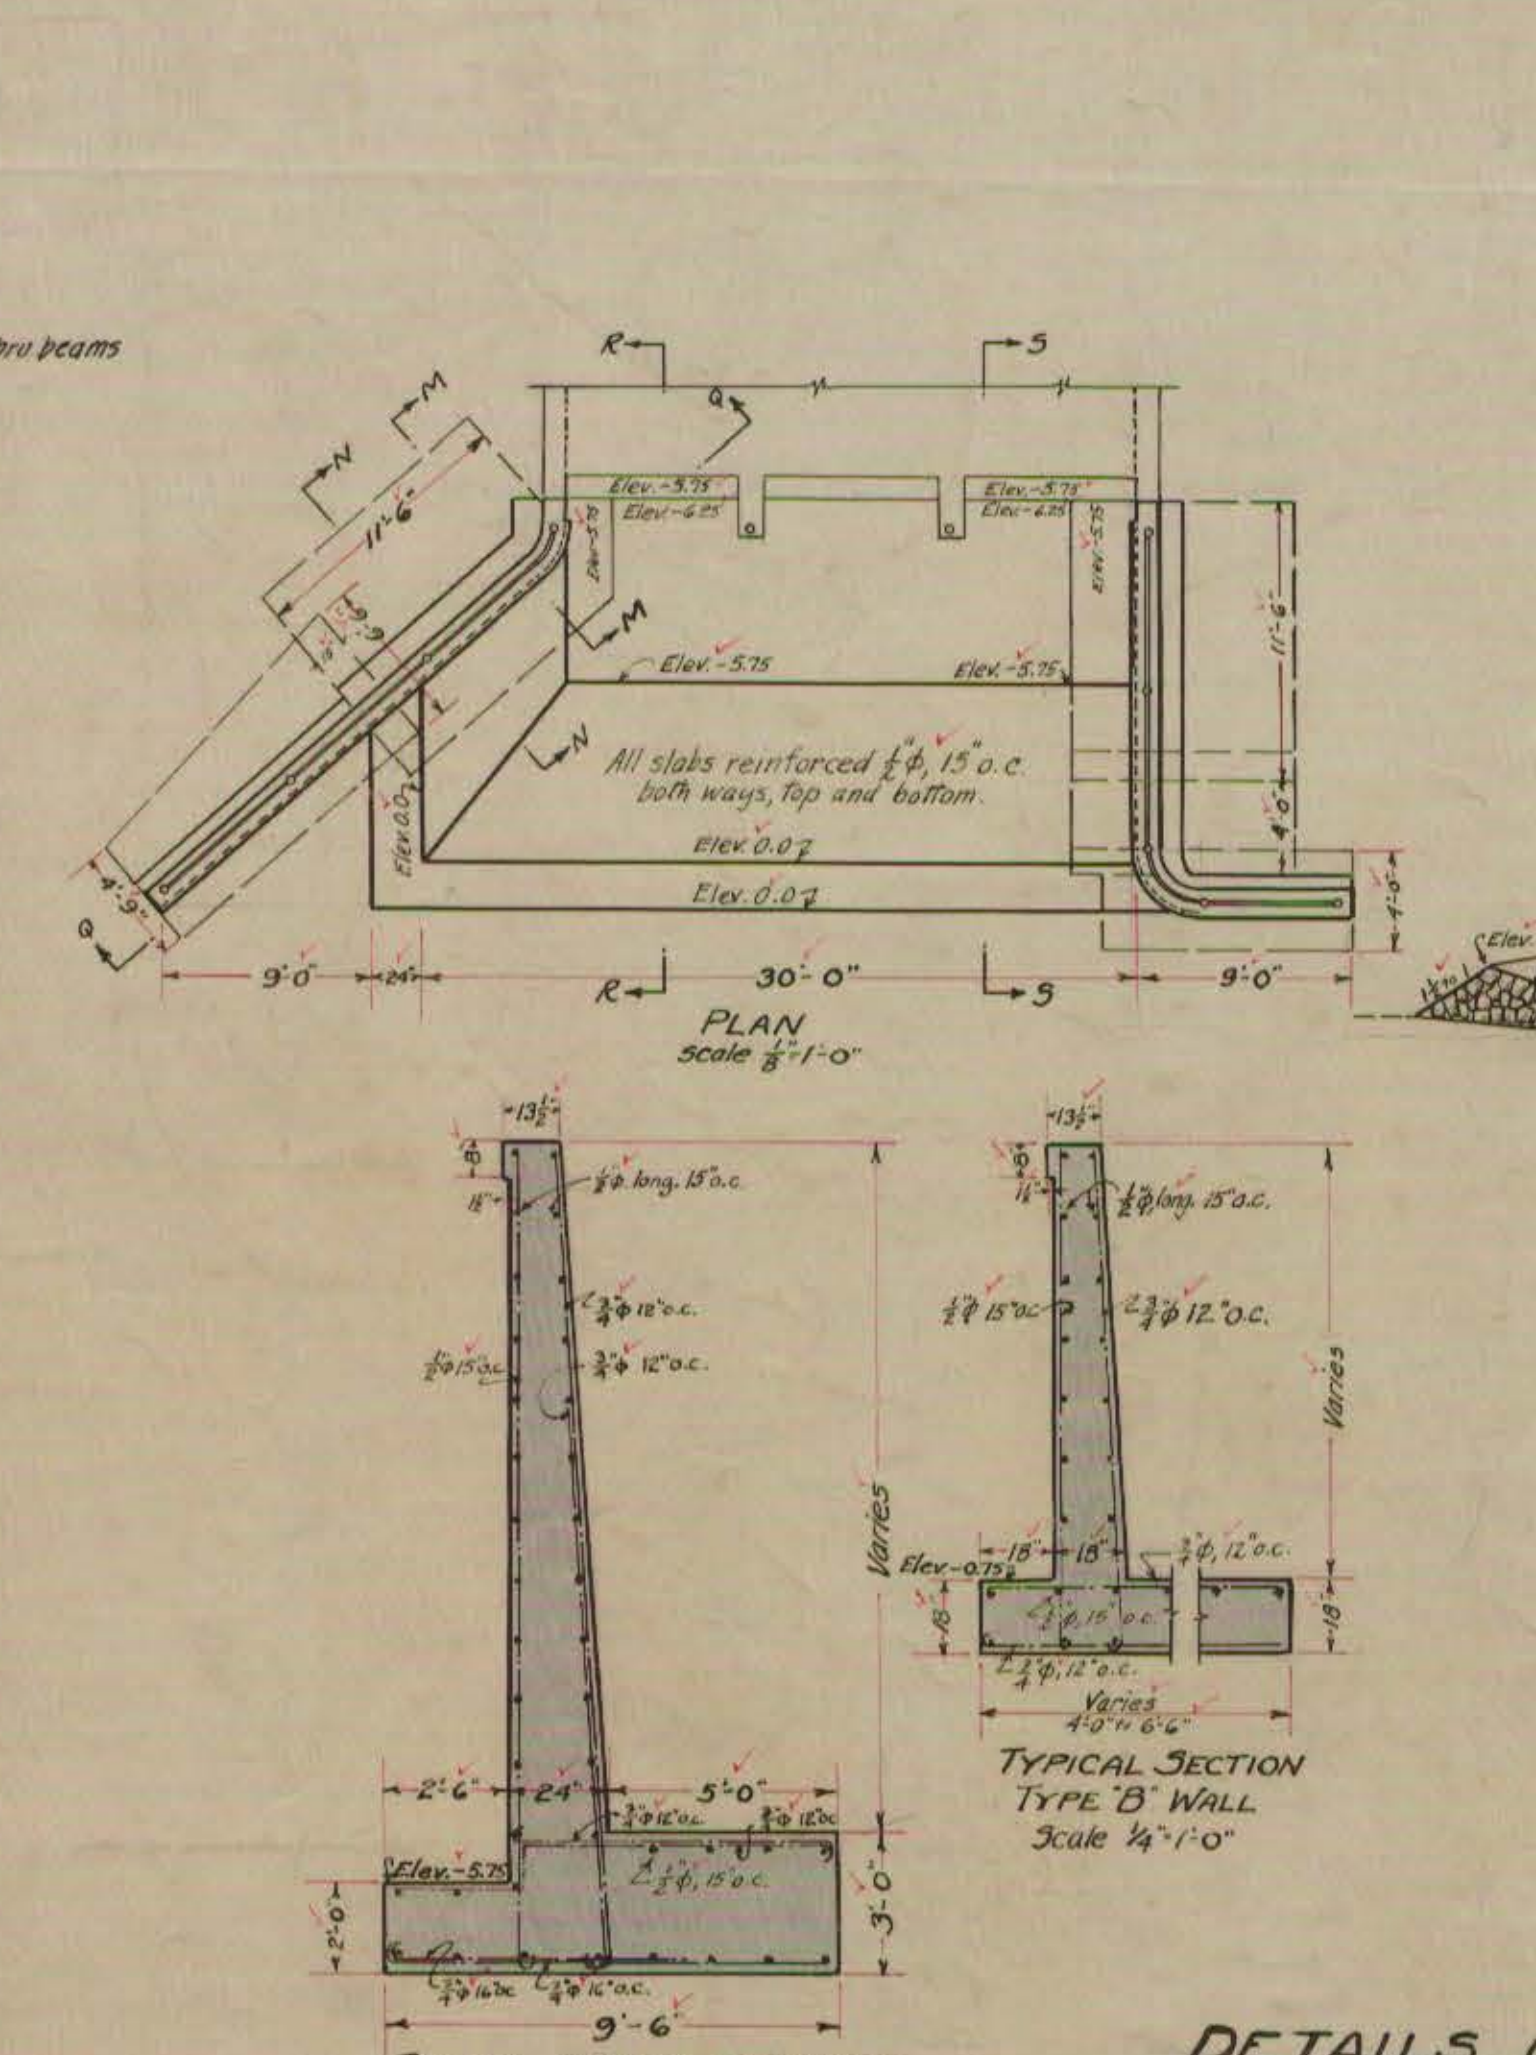
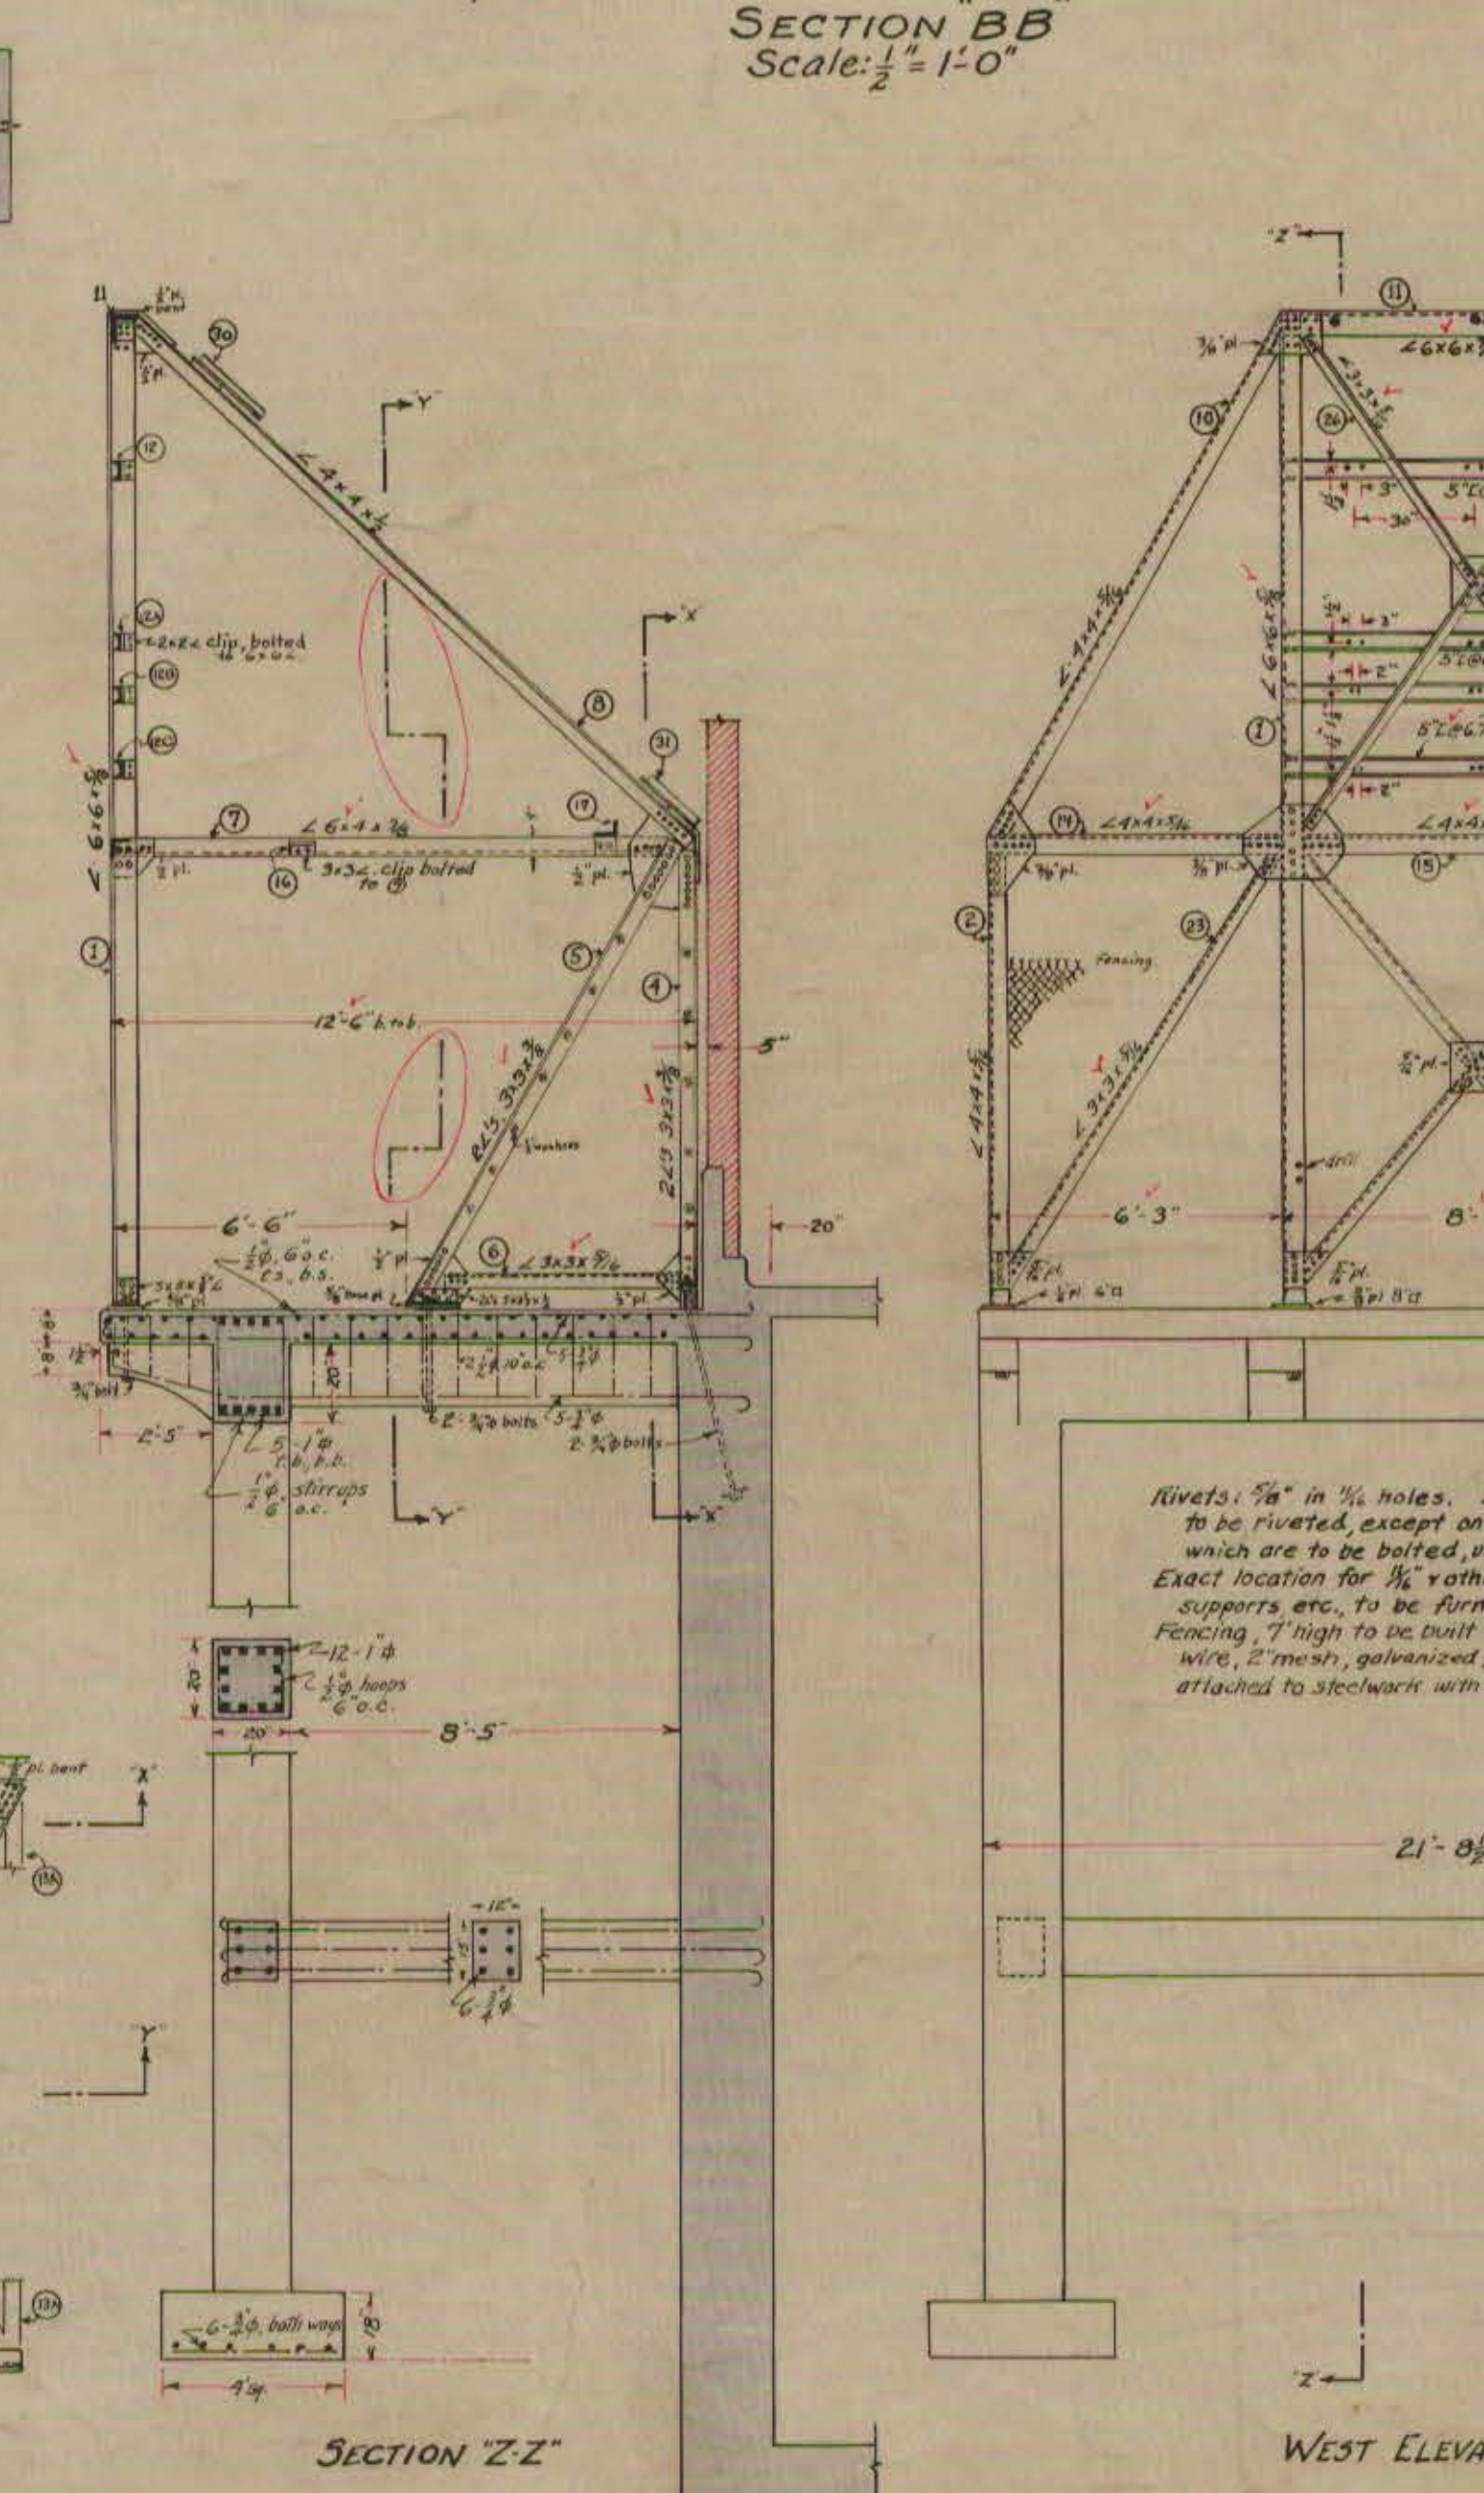
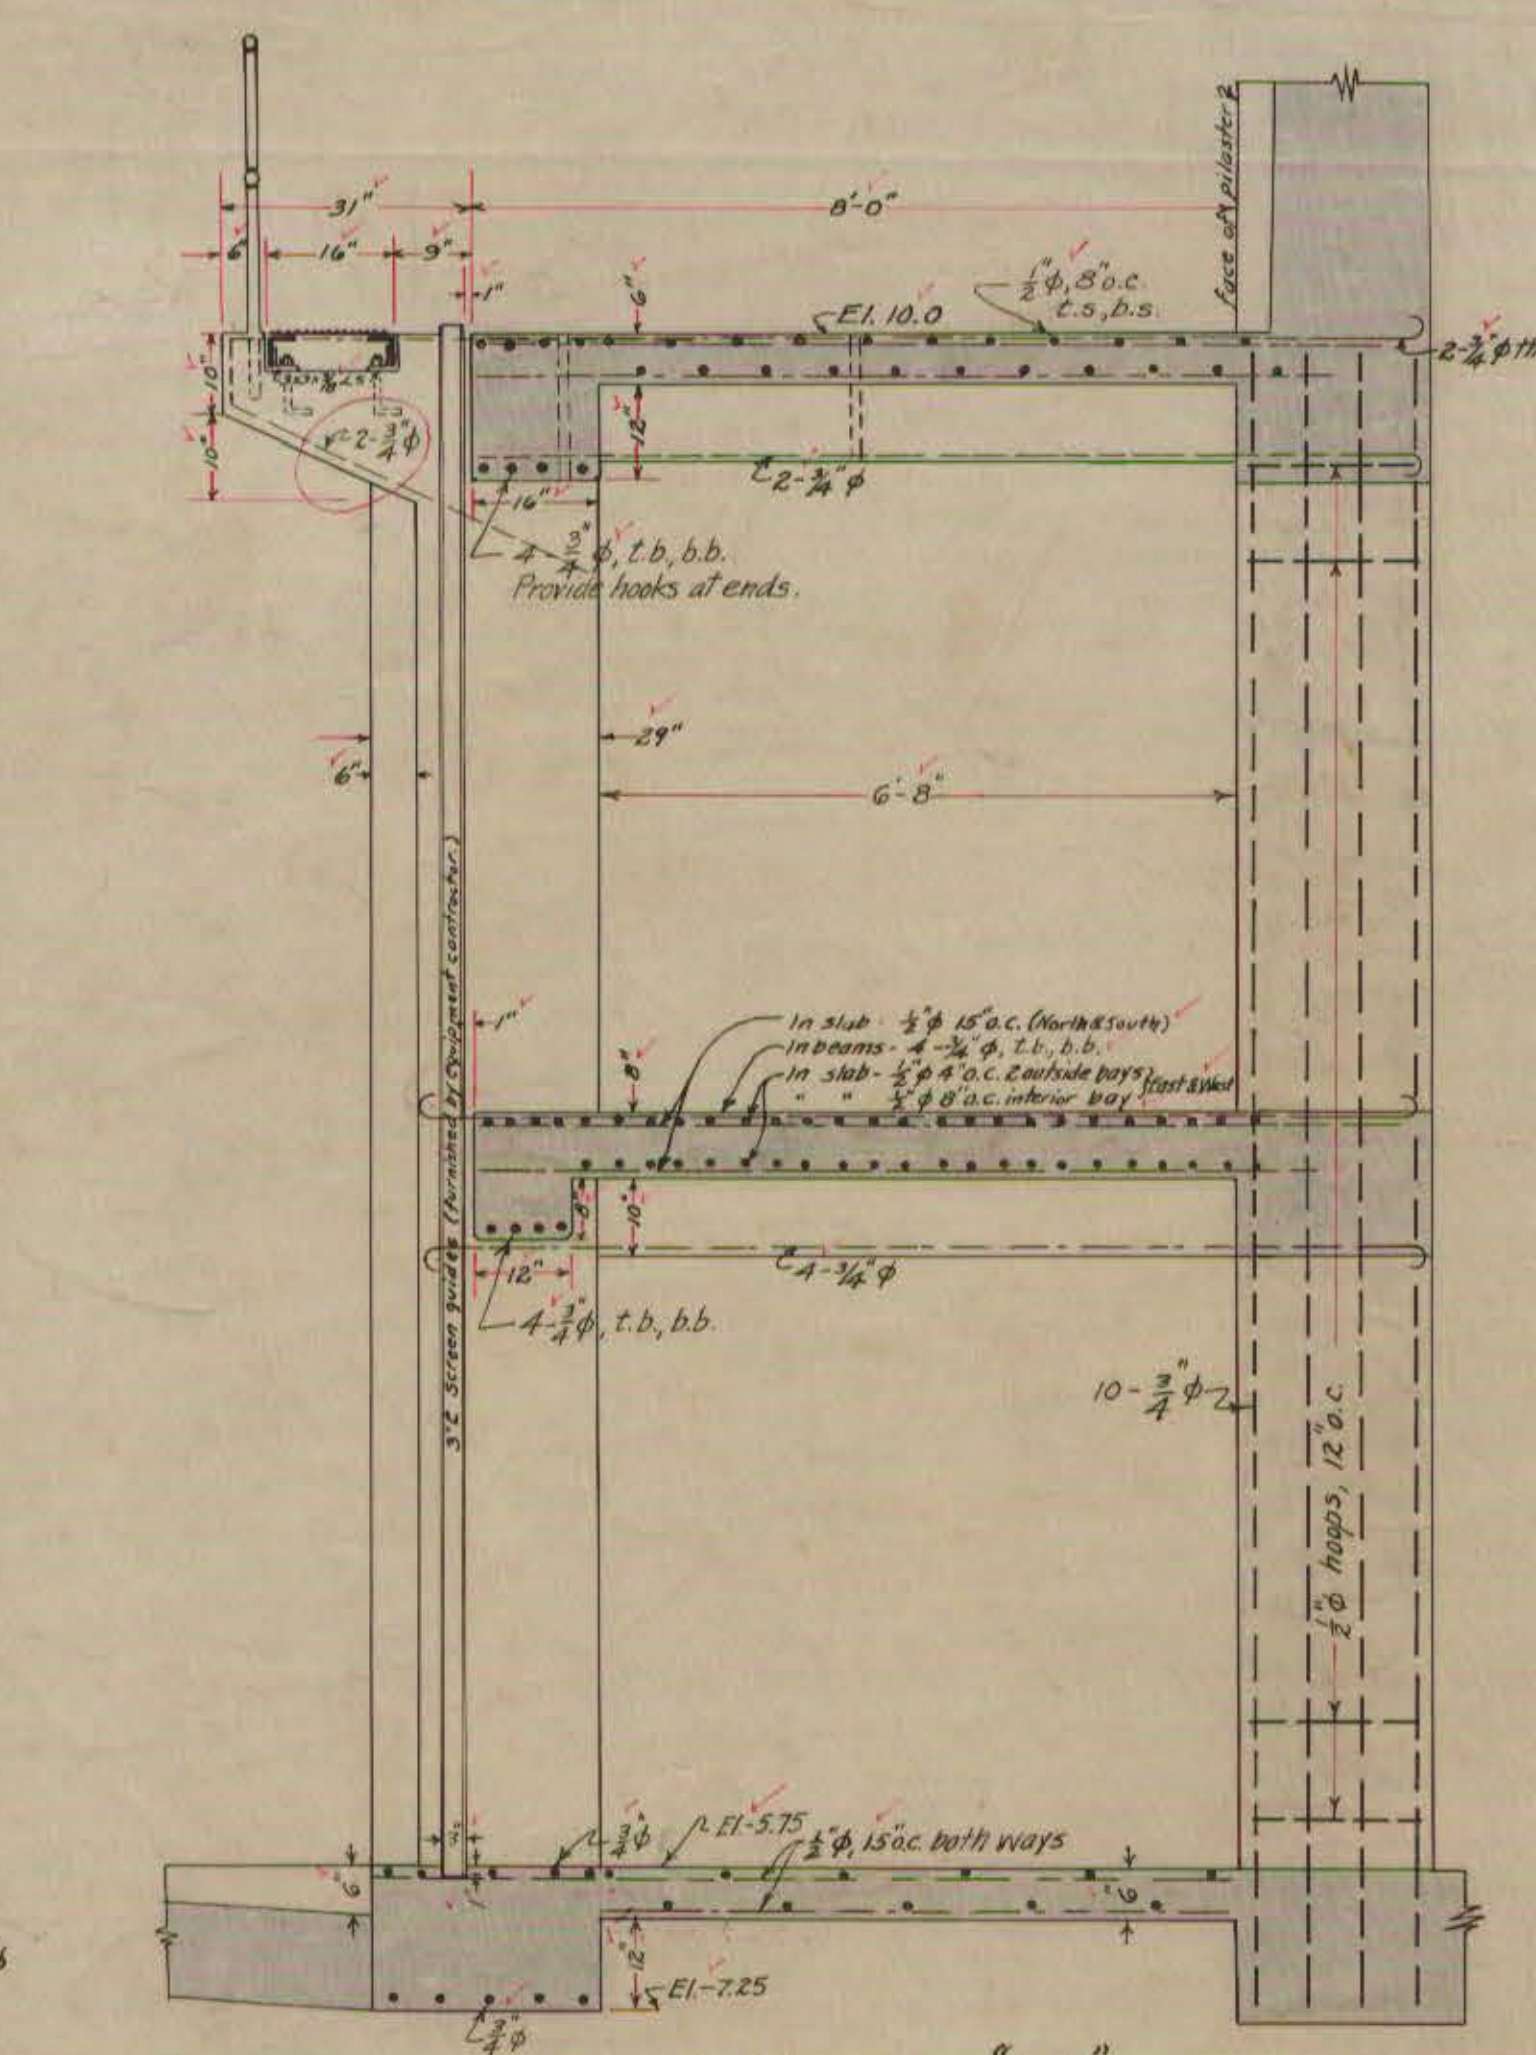
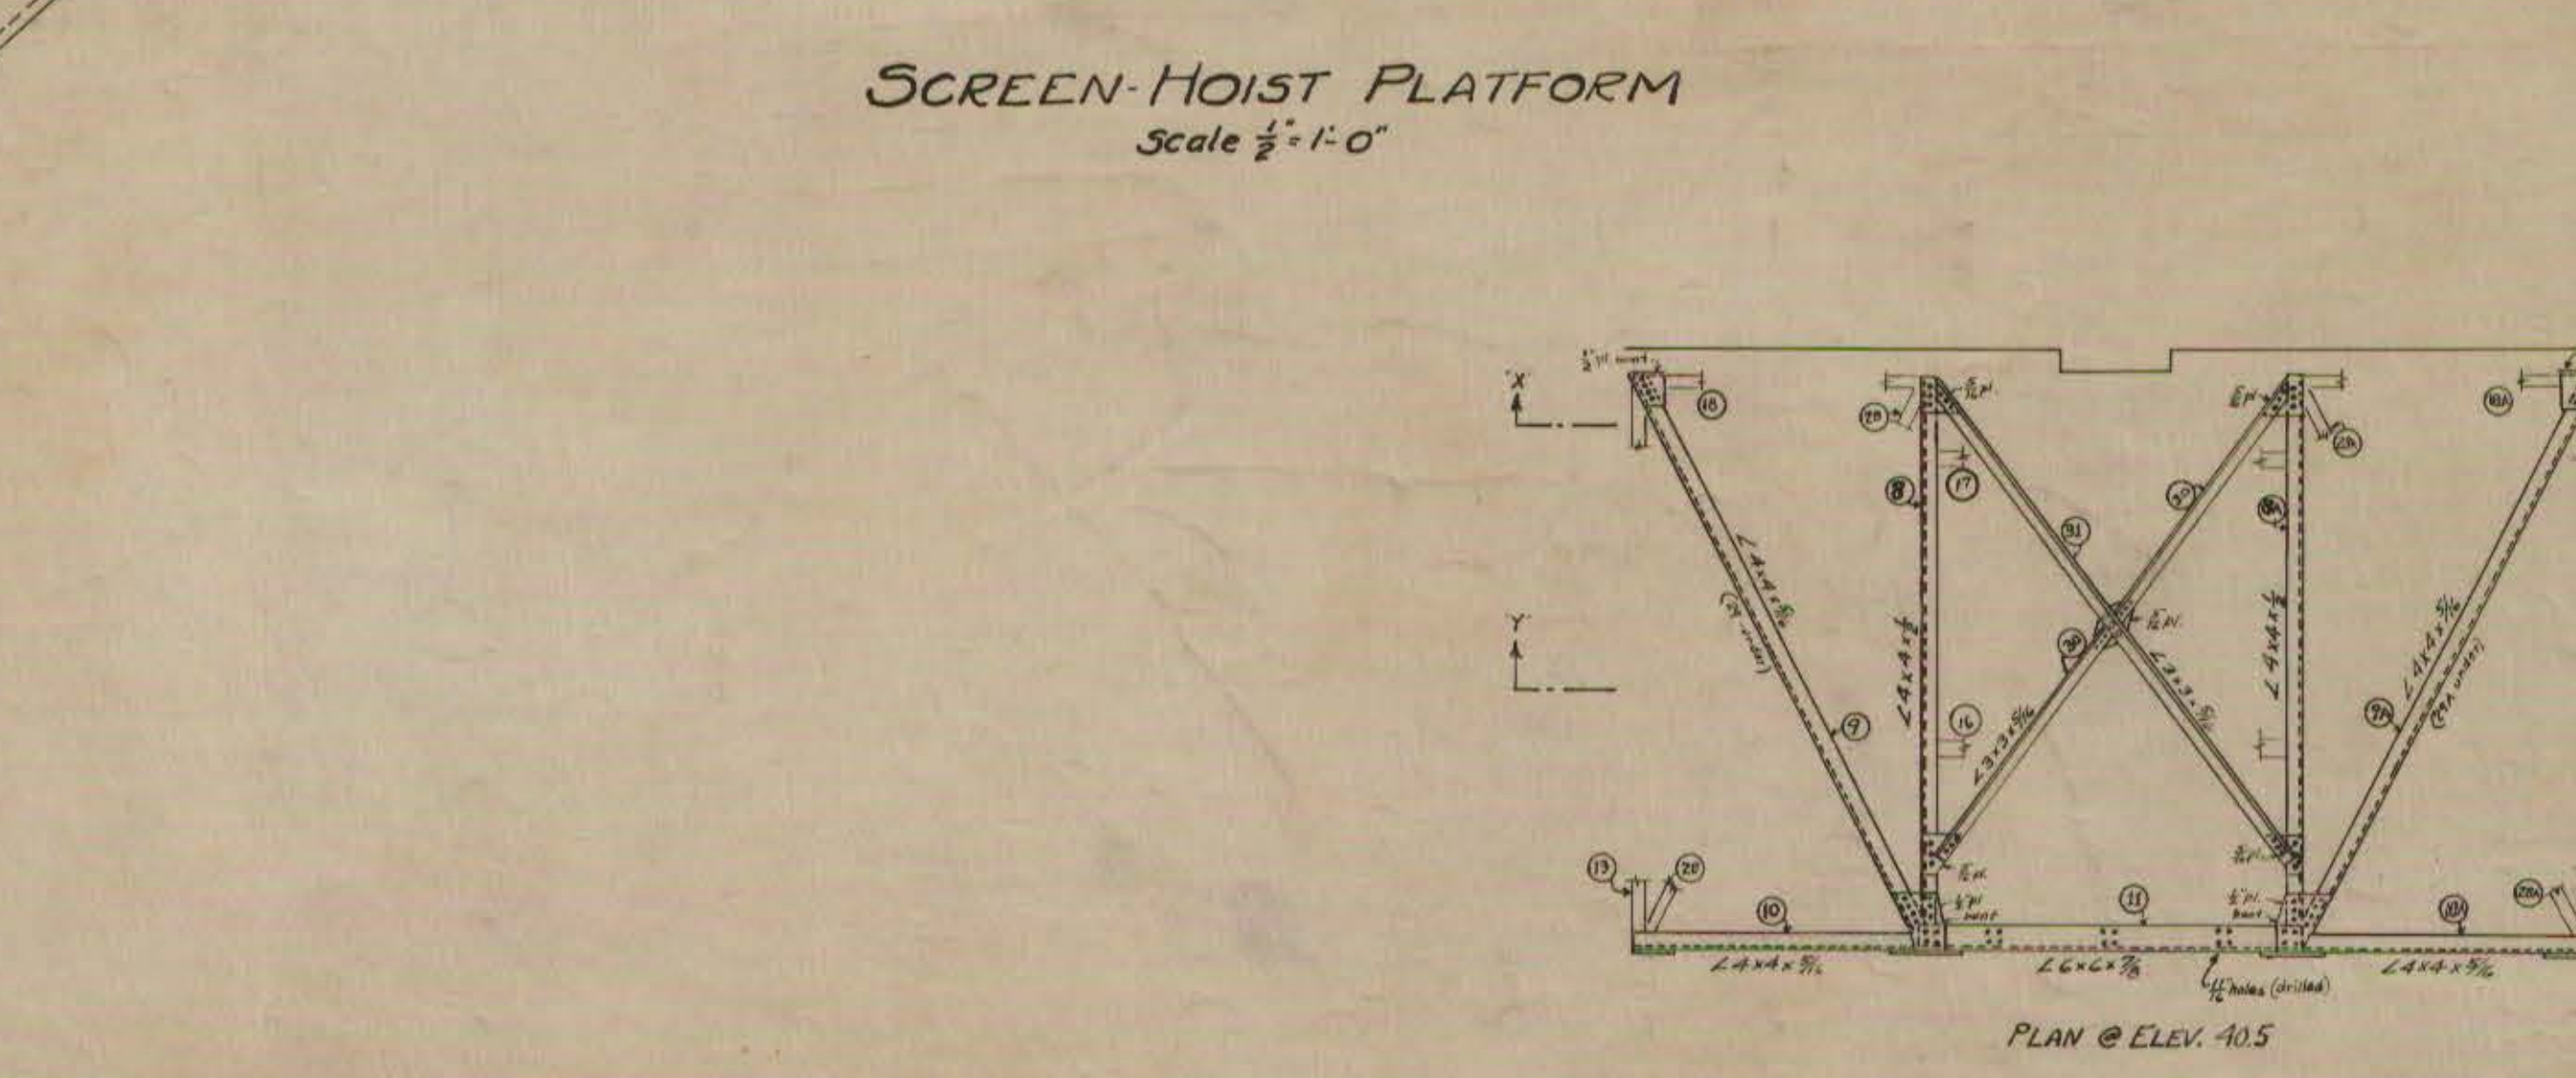
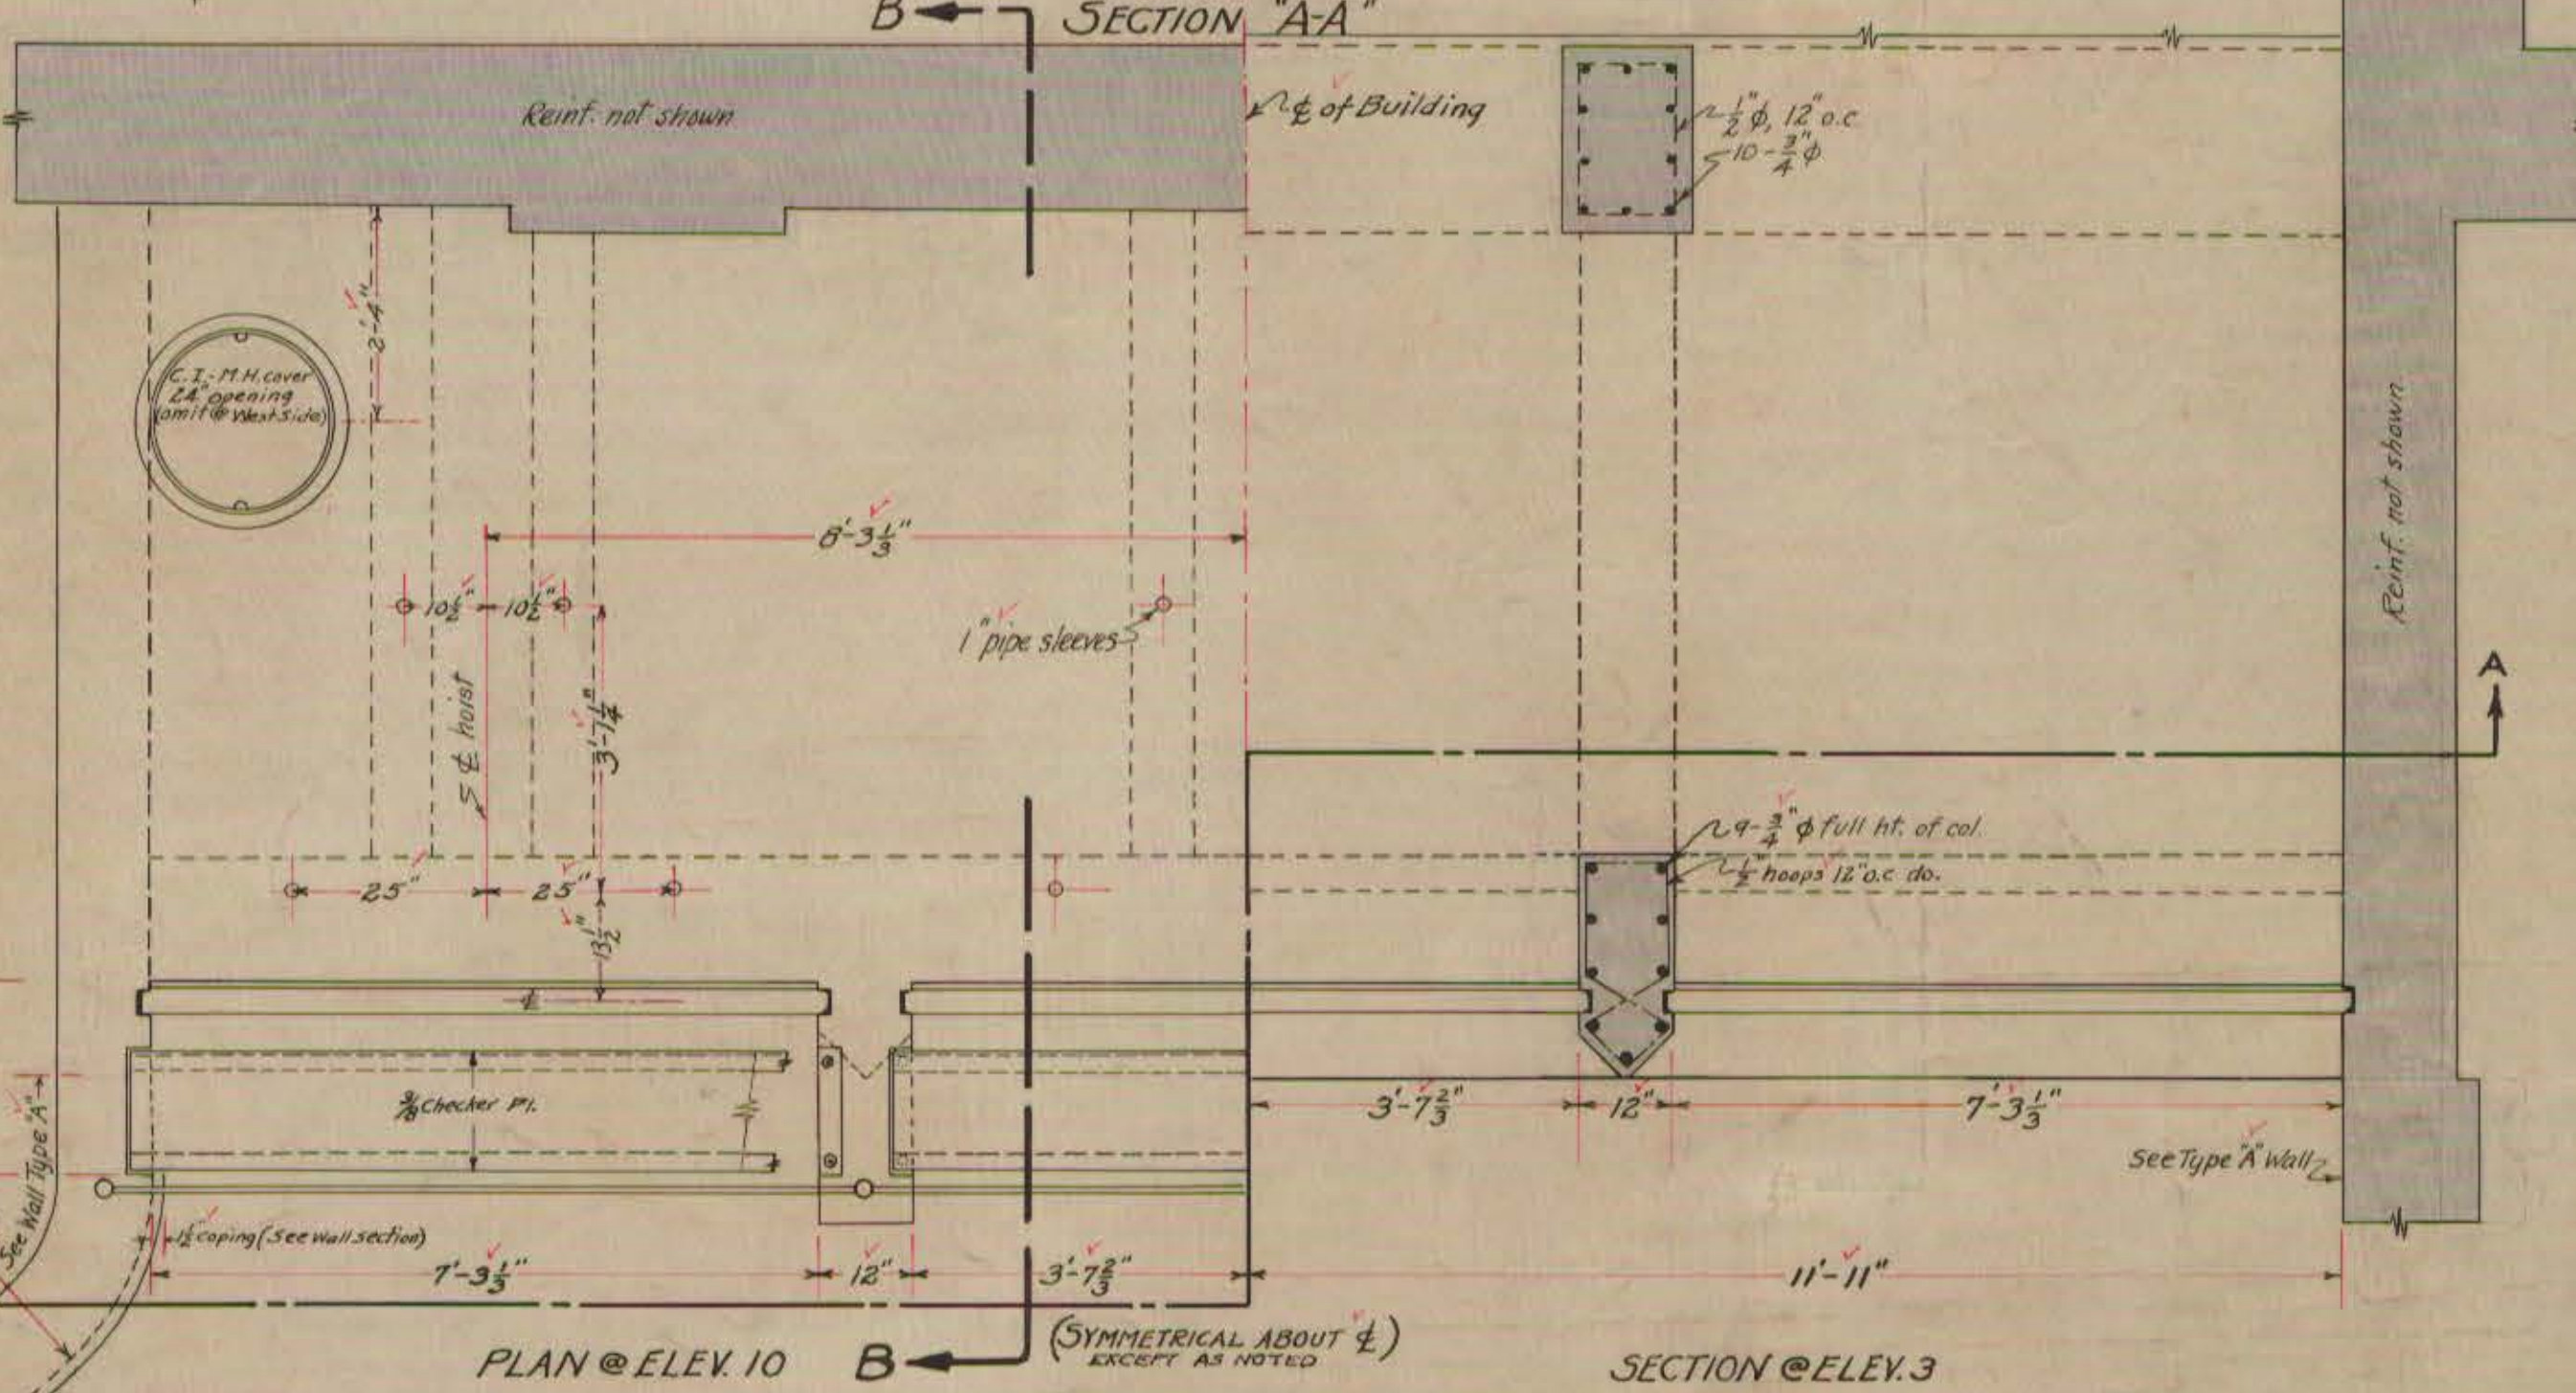
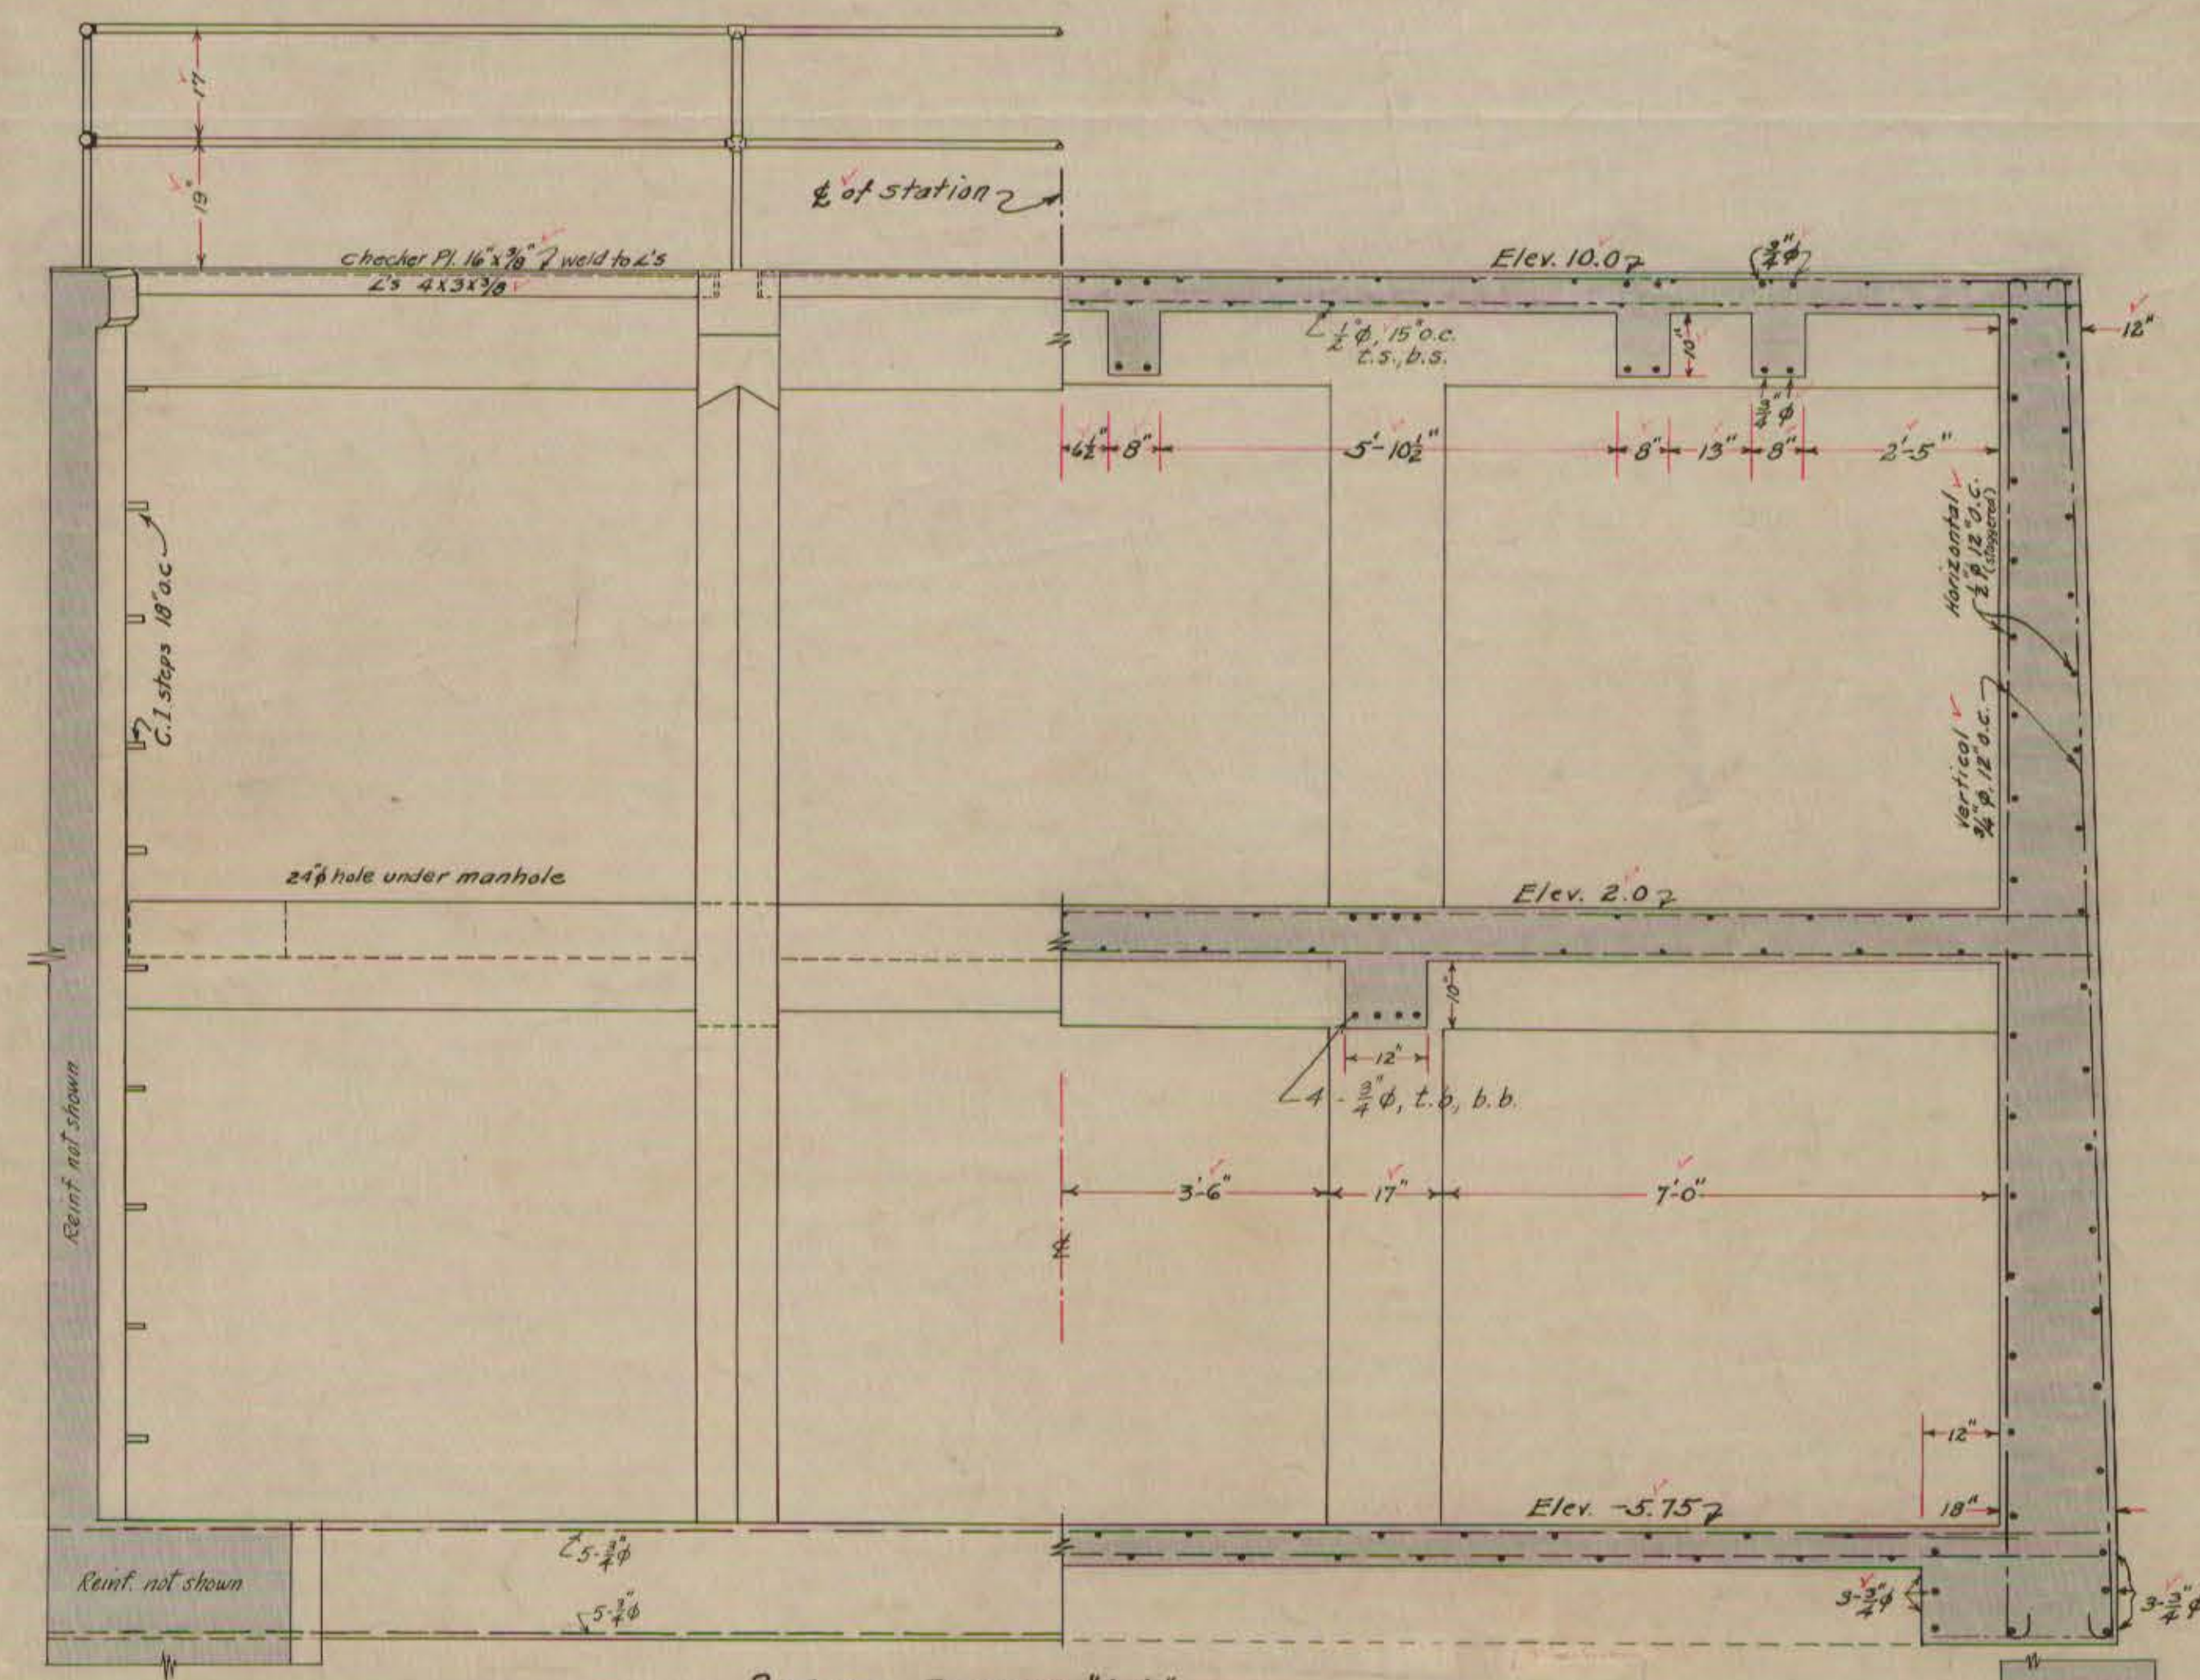


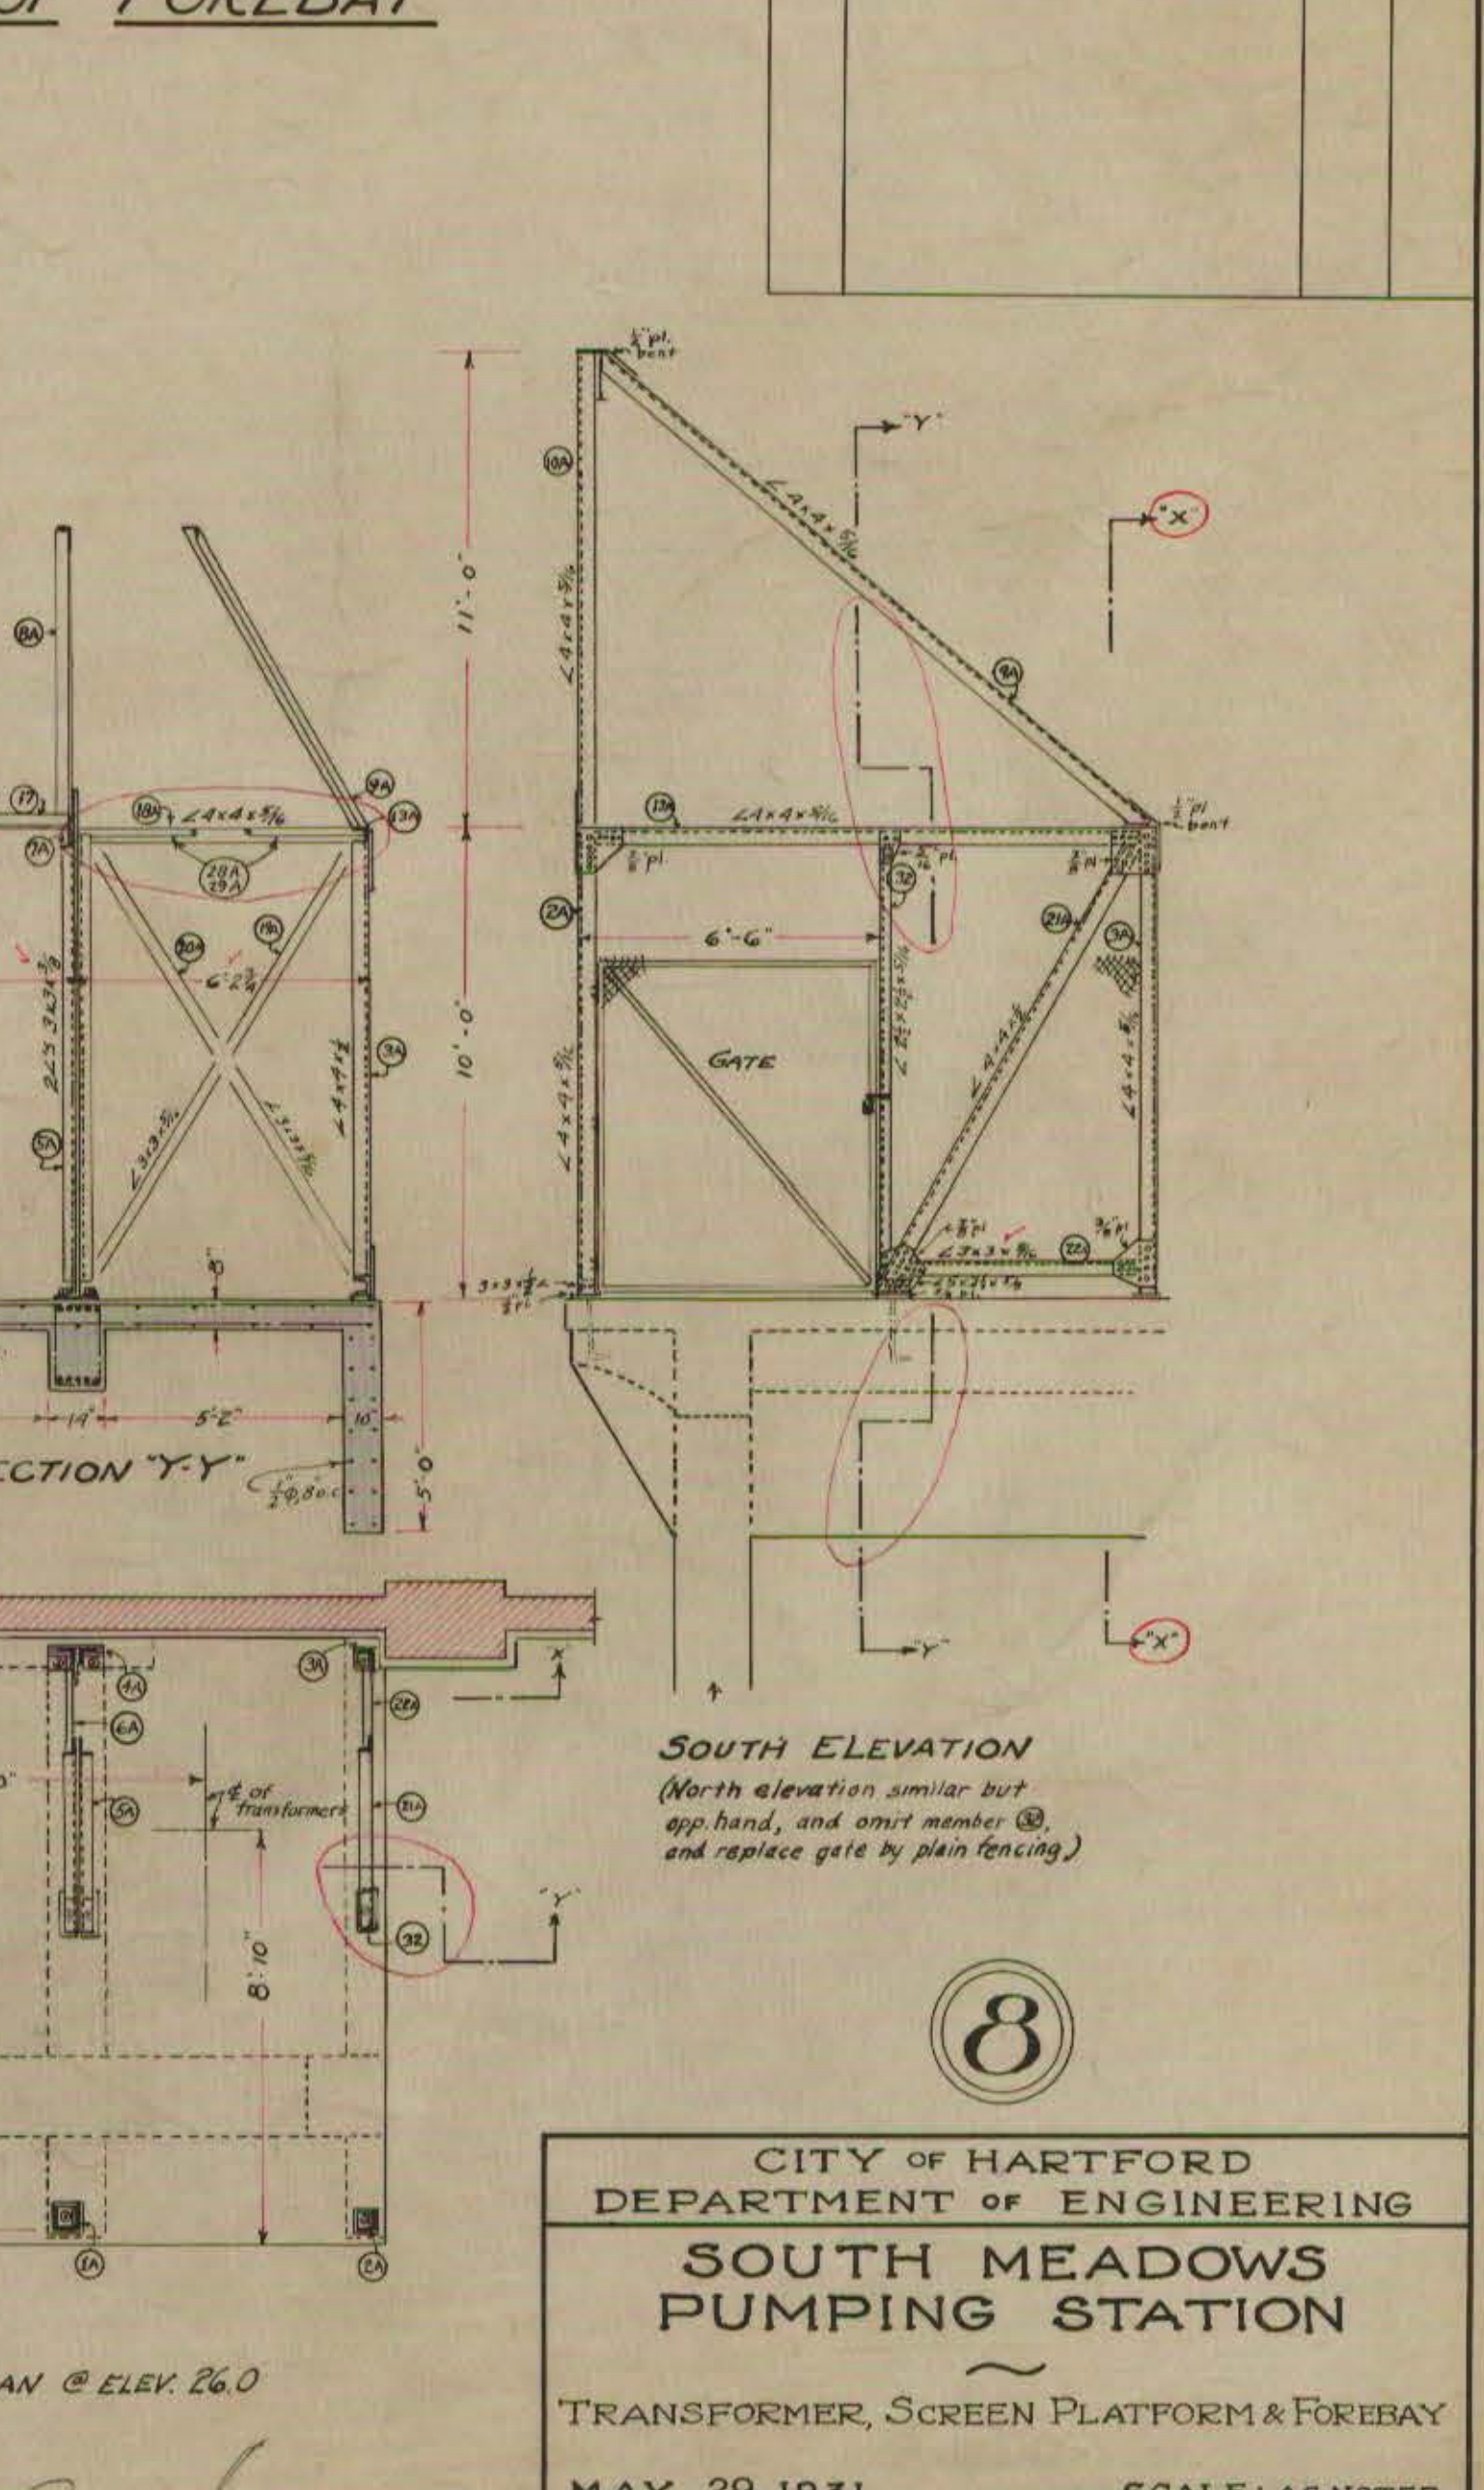

DETAILS OF OUTDOOR BUS STRUCTURE AND TRANSFORMER PLATFORM Scale 1/4" = 1'-0"

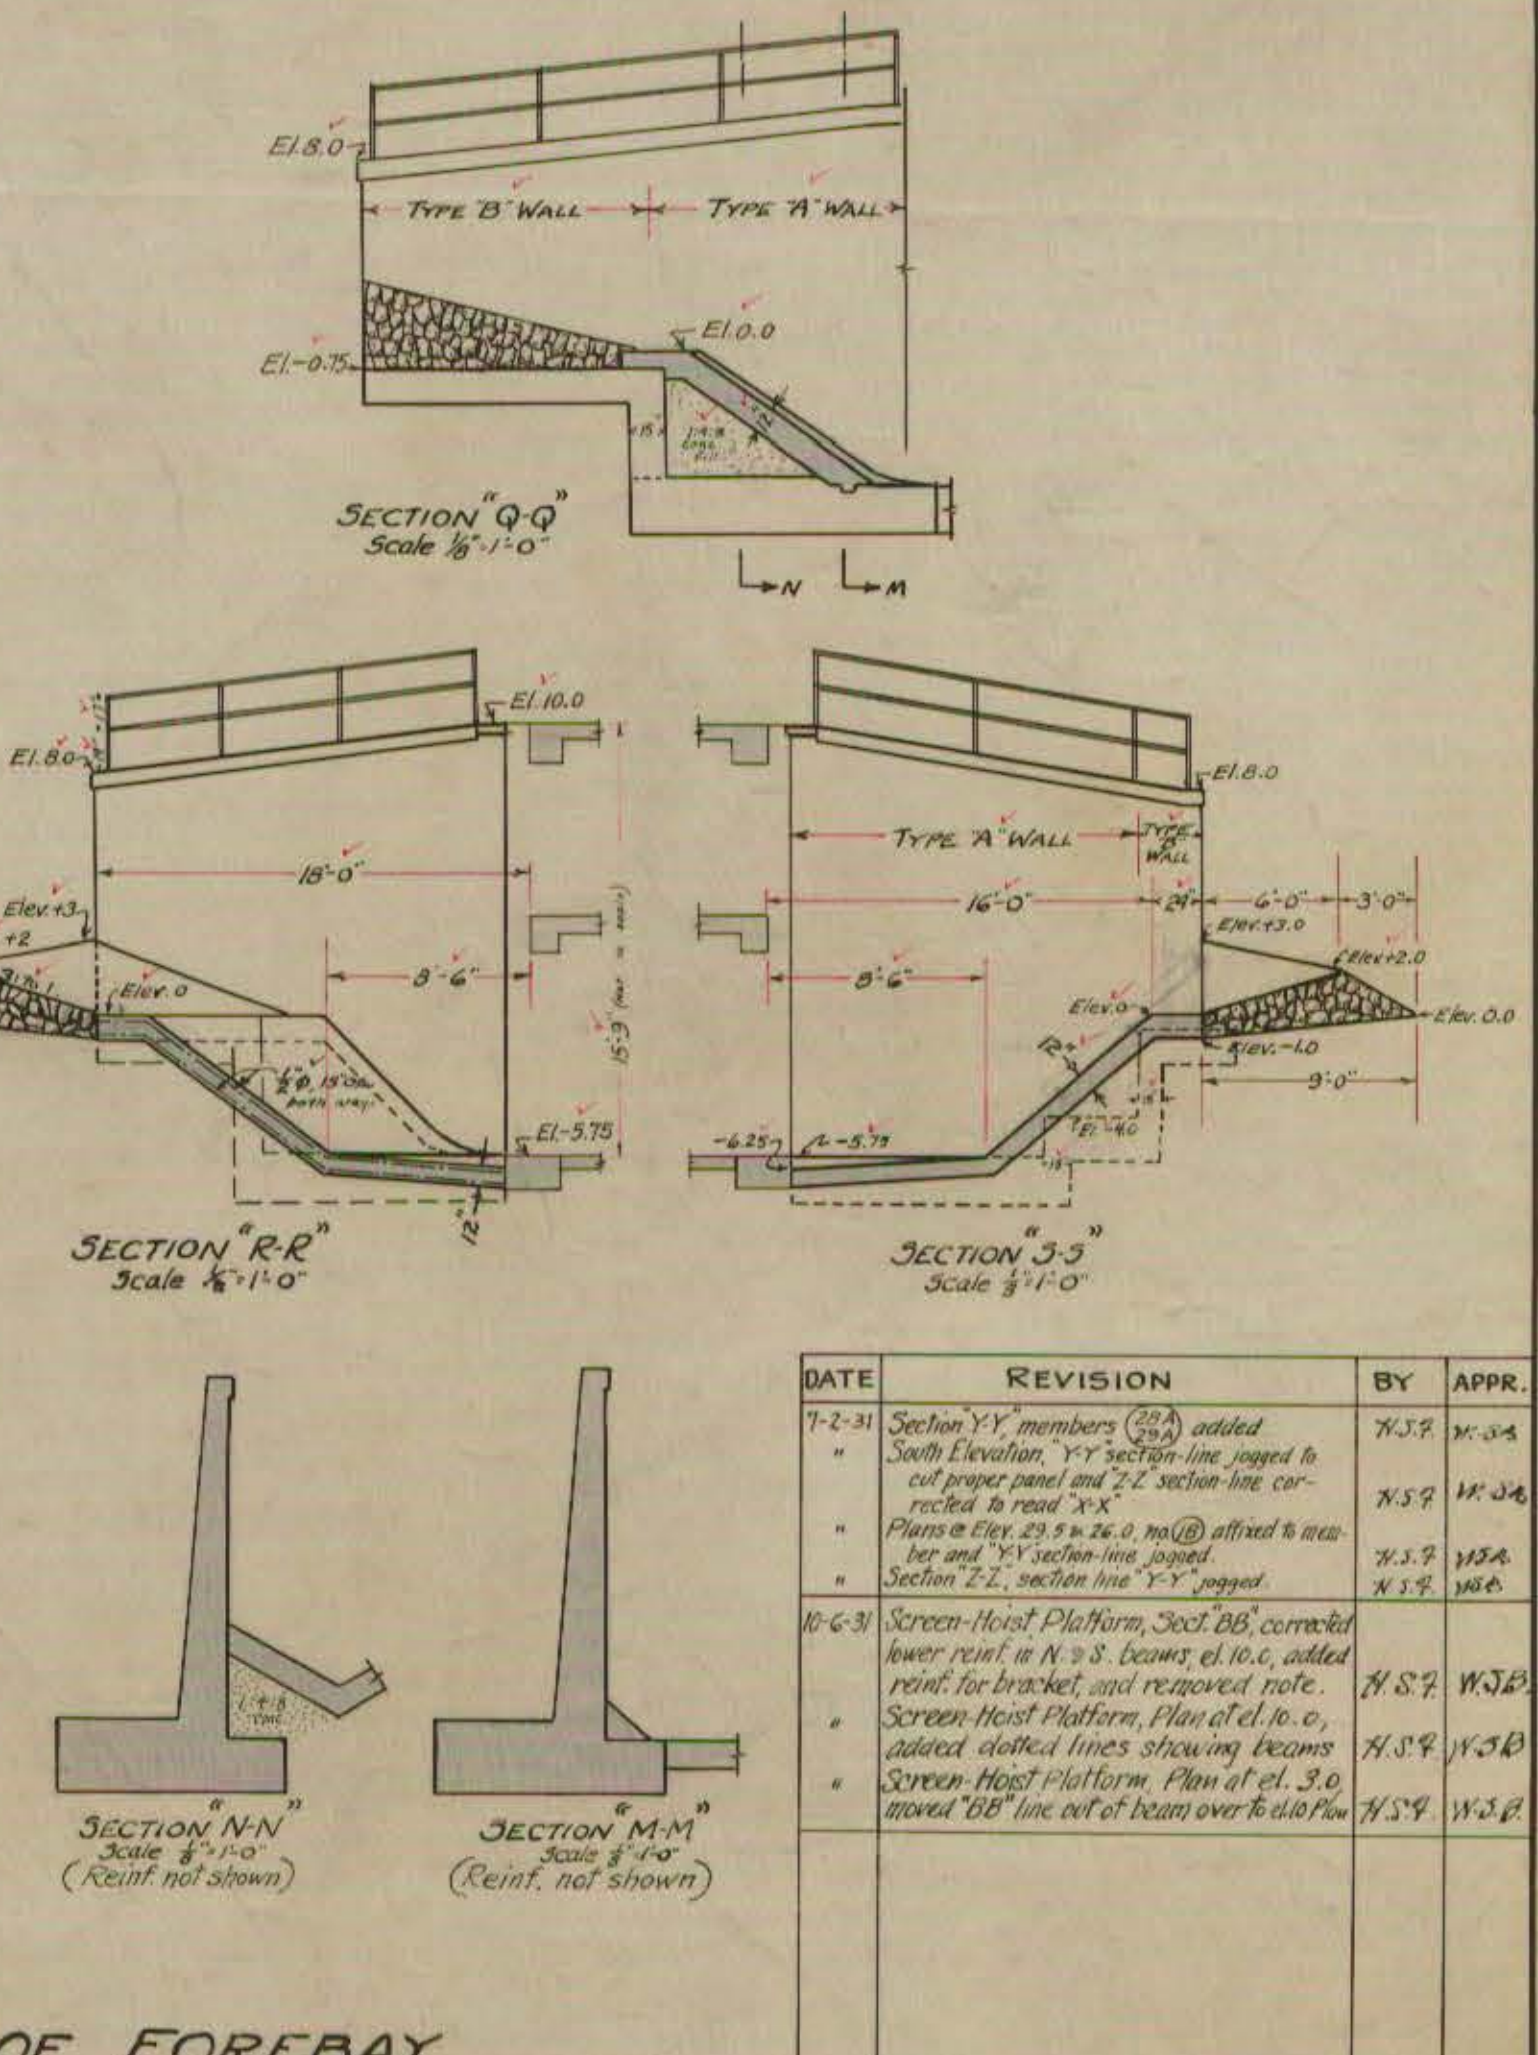

DETAILS OF FOREBAY

DATE	REVISION	BY	APPR.
7-2-31	Section Y-Y members (28A) added	N.S.P.	N.S.P.
	Section Z-Z, section line Y-Y, moved	N.S.P.	N.S.P.
	Screen-Hoist Platform, Plan at 10.0, added dotted lines showing beams	N.S.P.	N.S.P.

SOUTH ELEVATION (North elevation similar but app. hand, and omit member 28 and replace gate by plain fencing)