
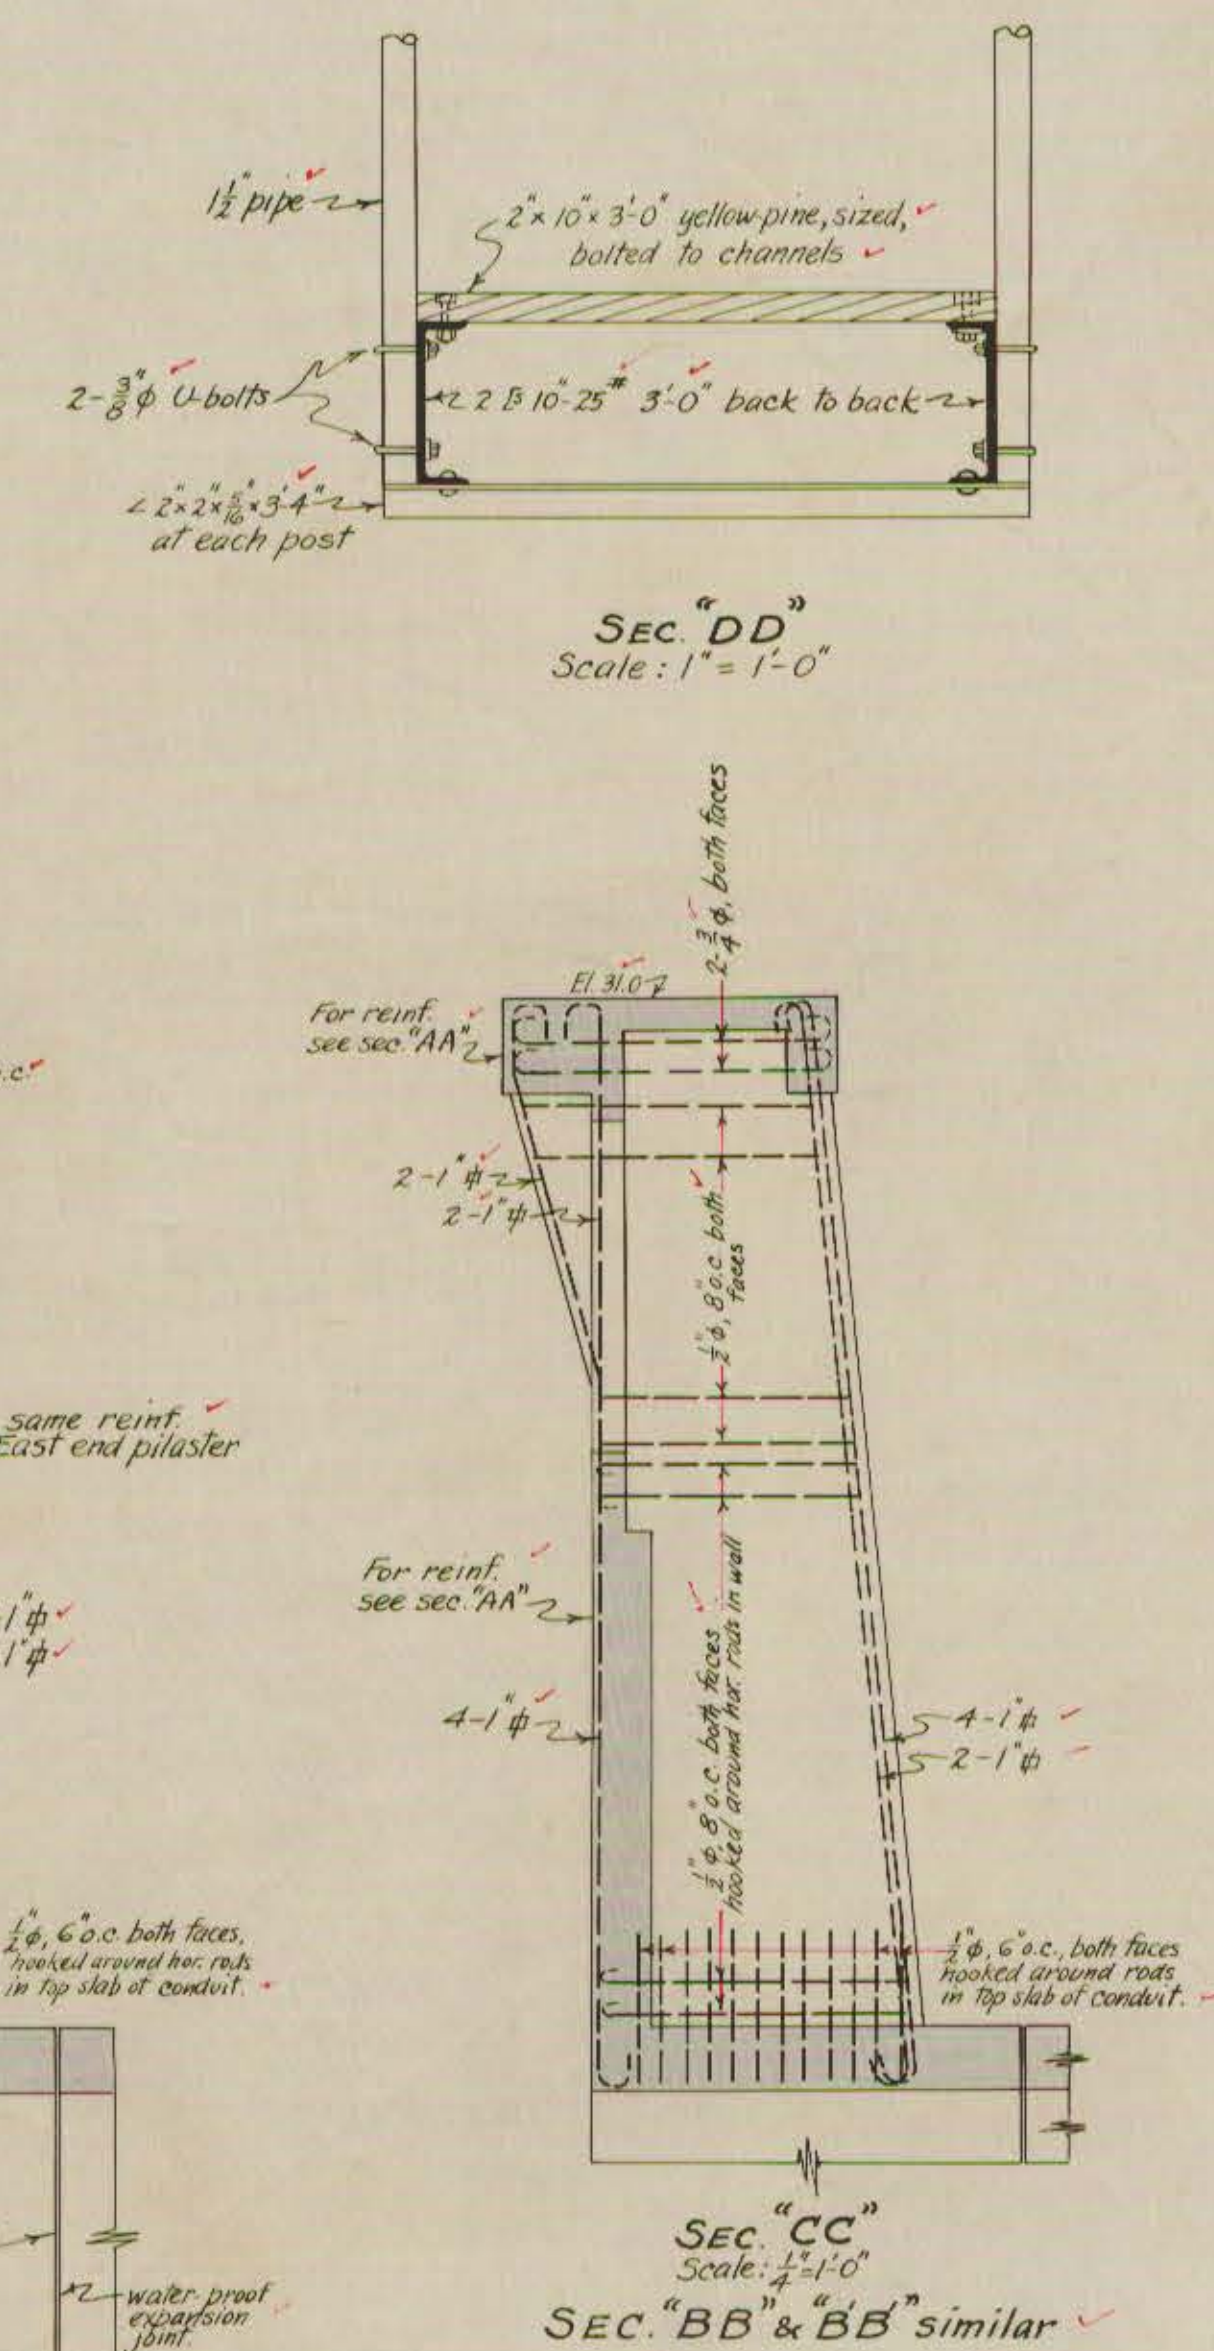
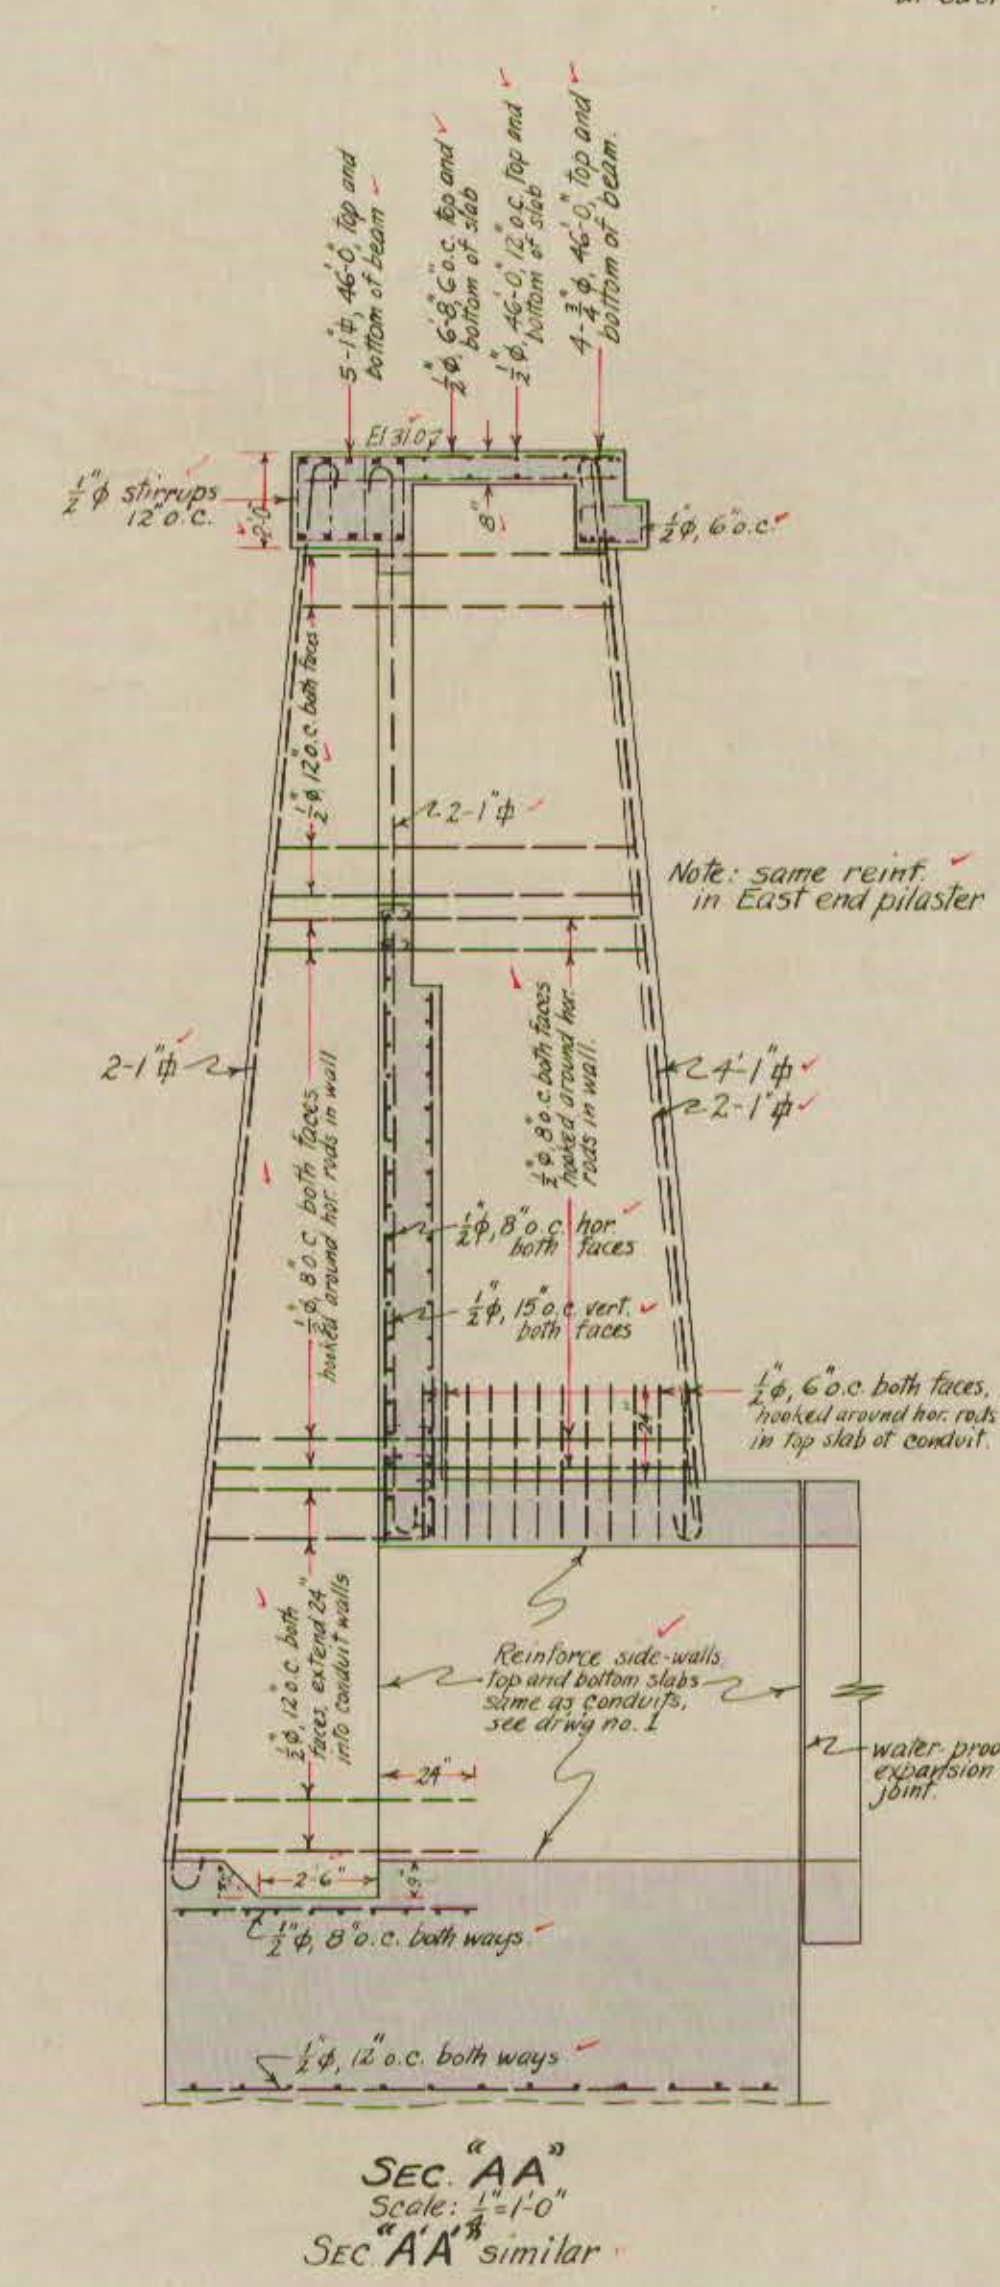


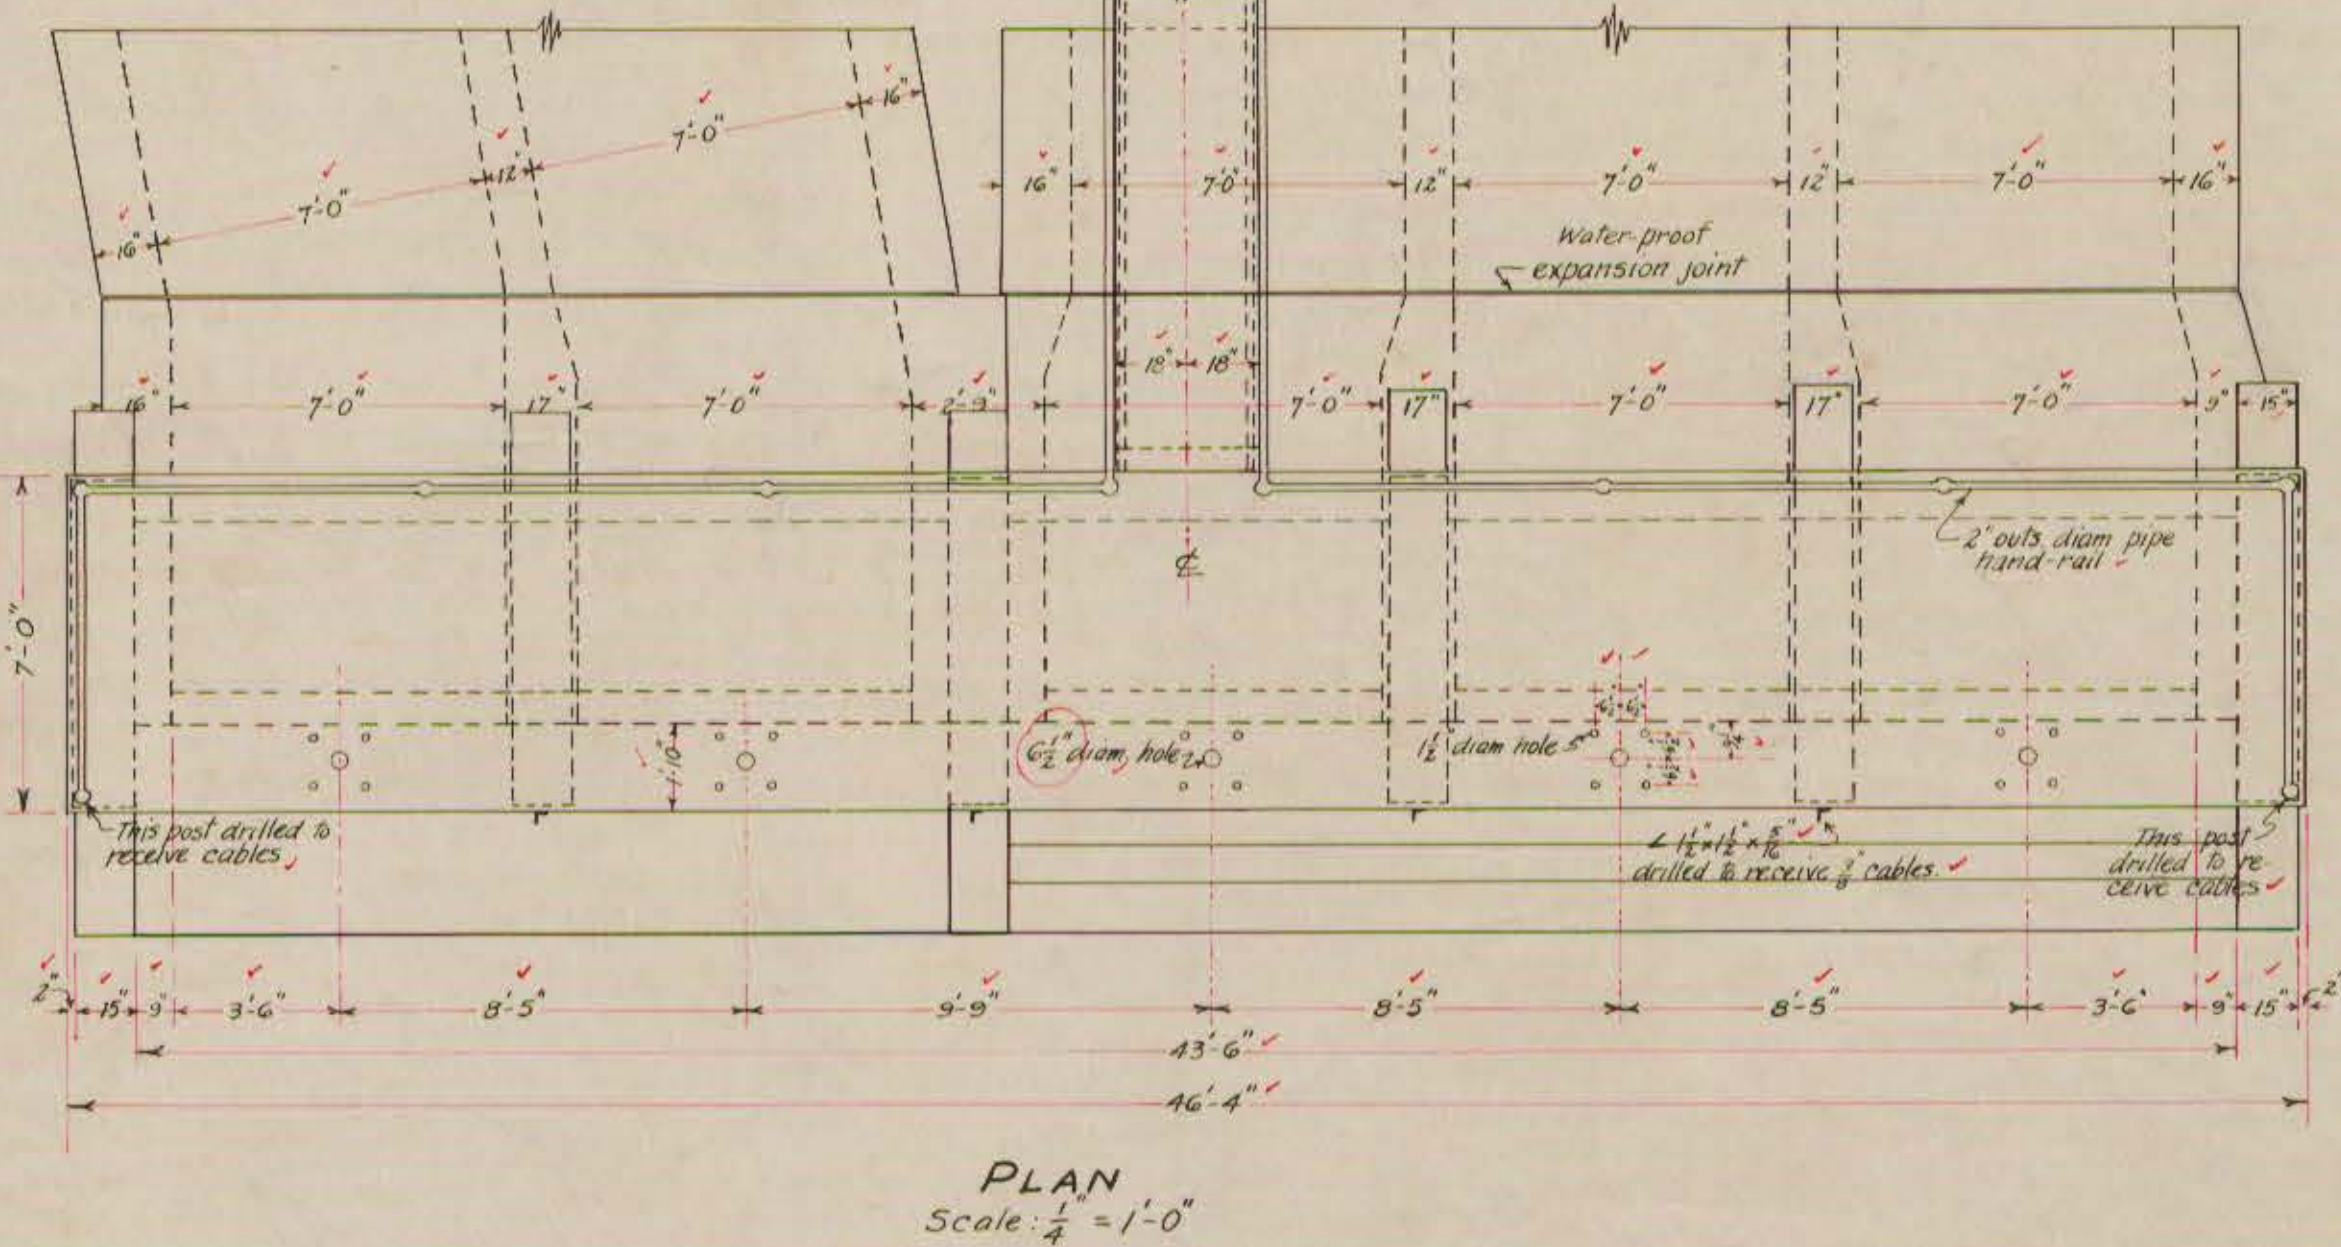

Elevations - Hartford City Datum

Note:-

- For general layout see d.w'g no. 1.
- For anchor/bolt layout use template according to m'fcs drawings.
- For projections of anchor-bolts from wall, see m'fcs drawings.
- All corners of concrete to be beveled $\frac{3}{4}$ "
- 1:2:4 concrete unless otherwise specified.
- Deformed reinf. min. distance from surface $2\frac{1}{2}$ "
- All construction joints shall be approved by the Engineer before concrete may be poured.

DATE	REVISION	BY	APPROVED BY
7-22-31	East Elevation, added 5 dimensions and changed slope of N. pilasters.	N.S.F.	M.D.
8-19-34	Plan, changed holes for stems, from 4" diam. to 6 $\frac{1}{2}$ "	N.S.F.	M.D.

CITY OF HARTFORD
DEPARTMENT OF ENGINEERING

**SOUTH MEADOWS
PUMPING STATION**

DETAILS OF OUTLET STRUCTURE

MAY 29, 1931

SCALE: AS NOTED

MADE BY: H.S.D.
CHECKED: (signature)

APPROVED: (signature)
DAY BOOK NO. 66259